Utility Assessment Report

US 41/SR 45 at CSX Grade Separation From S of SR 676 to N of SR 676

Project Development & Environment (PD&E) Study
Design Change Reevaluation



Florida Department of Transportation District 7

Work Program Item Segment No. 440749-1-32-01

ETDM Project No. 14345

Hillsborough County, Florida

February 2023

The environmental review, consultation, and other actions required by applicable federal environmental laws for this project are being, or have been, carried out by the Florida Department of Transportation (FDOT) pursuant to 23 U.S.C. § 327 and a Memorandum of Understanding dated May 26, 2022, and executed by the Federal Highway Administration and FDOT.

Utility Assessment Report

US 41/SR 45 at CSX Grade Separation From S of SR 676 to N of SR 676

Project Development & Environment (PD&E) Study
Design Change Re-evaluation



Florida Department of Transportation District 7

Work Program Item Segment No. 440749-1-32-01 ETDM Project No. 14345 Hillsborough County, Florida

February 2023

Prepared by:

ECHO UES 4803 George Rd., Suite 350 Tampa, Florida 33634

EXECUTIVE SUMMARY

This Utility Assessment Report was prepared to evaluate the utilities within the project corridor. The data collected from the Utility Agency Owners (UAO's) includes their green lines/as-Builts of the project area describing what facilities they have on the project.

Table of Contents

SECTION 1	INTRODUCTION	
1.1 1.1.1	Project Description Purpose & Need	
2.0 UTILITY 2.1	INFORMATIONGeneral	
2.2	Utility Coordination	1-4
3.1 (3.2 (3.3 (3.4) 3.5) H 3.6 (3.7) 3.8 (3.9) 3.10	EXISTING FACILITIES DESCRIPTIONS	
List of Fig	gures	
Figure 1-1	Project Location Map	1-3
List of Ta	ibles	
Figure 1-2	Utility Contact Information	1-4
Appendi	ces	
Appendix A Appendix B Appendix C	Utility Marked Plans/As-Builts and Information	

SECTION 1 INTRODUCTION

1.1 PROJECT DESCRIPTION

The Florida Department of Transportation (FDOT) is conducting a Design Change and Right of Way (ROW) Authorization Reevaluation of a previous Environmental Assessment (EA) (Work Program Item Segment (WPIS) No. 255598-1) with a Finding of No Significant Impact (FONSI) approved by the Federal Highway Administration on May 24, 1994. **Figure 1-1** shows the limits of the previous PD&E study completed along 22nd Street Causeway/Causeway Boulevard (State Road 676) from State Road (SR) 60 to US 301, in Hillsborough County, Florida. The segment currently being evaluated/advanced is shown as Segment 3 on **Figure 1-1.**

The previous study evaluated anticipated conditions for a 2015 Design Year. The FONSI documented the construction of a six-lane roadway to replace the existing 2- to 4-lane roadway beginning at SR 60 and extending approximately 7 miles east at US 301. Since the completion of the 1994 PD&E Study, Causeway Boulevard has been widened to four-lanes.

The project included a new interchange at US 41/Causeway Boulevard intersection for which the approved concept was a "compressed diamond" interchange with US 41 elevated over Causeway Boulevard. This interchange is also known as a Single Point Urban Interchange (SPUI) or a Tight Urban Diamond Interchange (TUDI). The study identified that the US 41 interchange bridge would carry three lanes of traffic in each direction with a barrier wall separating opposing traffic. The study recommended an additional grade separation of US 41 over the CSX railroad crossing south of Causeway Boulevard while the CSX railroad crossing east of US 41 would remain at-grade with Causeway Boulevard. The concept showed the SPUI ramps oriented along US 41 and one-way, one-lane frontage roads were provided in the southeast and northeast quadrants to provide local property access. Five-foot sidewalks and 4-foot bicycle lanes were proposed along both sides of Causeway Boulevard.

The current study effort being conducted under WPIS# 440749-1 is evaluating various intersection and operational improvements along Causeway Boulevard east and west of US 41 (SR 45/SR 599) along US 41 from south of the Causeway Boulevard intersection to north of the Causeway Boulevard intersection. These improvements include the construction of a grade separation of US 41/SR 45 at the CSX railroad crossing located approximately 1,400' south of the Causeway Boulevard intersection. Bicycle and pedestrian facility improvements along US 41 and Causeway Boulevard are also provided..

1.1.1 Purpose & Need

<u>Purpose</u>

The purpose of this project is to reduce traffic delays associated with the CSX railroad crossing, adequately support the safe movement of vehicle traffic, including trucks and freight, and enhance connectivity and safety for bicyclists and pedestrians.

Need

As expressed in the original 1994 EA/FONSI, the need for the 22nd Street Causeway/Causeway Boulevard improvements was based on the following criteria: System Linkage; Capacity; Transportation Demand; Federal, State, or Local Government Authority; Socioeconomic Demand; Modal Interrelationships; Safety; and Navigation.

For the current segment, US 41 and Causeway Boulevard are vital arterial highways which serve the City of Tampa located in Hillsborough County. The US 41/SR 45 and Causeway Boulevard intersection experiences traffic delays during the AM and PM peak periods with heavy truck traffic (approximately 13% of the daily volume) traversing through the intersection. The presence of CSX railroad crossings to the south and east of the intersection also further contribute to these traffic delays. The CSX railroad crossing located to the south of the intersection causes traffic delays particularly during the AM peak period. This project will address traffic delays associated with the CSX railroad crossing to the south of the US 41 and Causeway Boulevard intersection and will facilitate the safe movement of vehicle traffic through the project corridor.

In addition, this project will also address multimodal connectivity and safety within the area. Although there sidewalks and dedicated bicycle lanes along both sides of Causeway Boulevard within the project limits, there are only sidewalks and no dedicated bicycle facilities along US 41 within the project limits. Between 2017 and 2021, there were 10 crashes involving bicyclists or pedestrians. These 10 crashes resulted in 1 fatality as well as a total of 8 injuries.

The proposed improvements have been identified in the Hillsborough County Transportation Planning Organization's (TPO) 2045 Adopted Long Range Transportation Plan (under the Hillsborough County Freight Hot Spots), the TPO's Fiscal Year 2022/23-2026/27 Transportation Improvement Program, as well as the FDOT's Statewide Transportation Improvement Plan and Strategic Intermodal System (SIS) Adopted 1st 5-Year Program. US 41 has also been identified as a Goods Movement Roadway Corridor from I-4 to the Manatee County Line and is a priority project for the National Highway Freight Program.

BEGIN Segment 1 Segment 3 Segment 4 Segment 2 EA/FONSI 255734-1 440749-1 US 41/SR 45/S 50th Street at CSX Grade Separation South of Causeway Blvd. 0.584 mi. (Causeway)/1.346 mi. (US 41) SR 676 (Causeway Blvd.) from US 41 to US 301 22nd Street / 20th Street SR 676 (Causeway Blvd.) Maritime Boulevard to SR 60 from US 41 to Licata Bridge 1.263 miles 1.916 miles 3.414 miles Add Lanes and Reconstruct New Bridge Construction
Status: ROW Programmed FYs 23/24
SUBJECT OF THIS REEVALUATION 60 Add Lanes and Reconstruct 4 to 6-Lane Reconstruction Status: Unfunded
SUBJECT OF THIS REEVALUATION Status: Construction Complete Status: Construction Complete SUBJECT OF THIS REEVALUATION No further widening will occur in No further widening will occur in ADAMO DRIVE 618 60 this segment due to constraints

SELMON this segment due to constraints EXPRESSWAY CHANNELSIDE STUART ST. Palmetto Beach S. 22TH ST. 301 S. 20TH ST. N. 50TH ST. PALM ROAD Palm McKay 41 River Bay 618 Clair-Mel S. 16TH AVE. City S. 20TH AVE. . 78TH ST. MAYDELL DR 70TH ST. S. 86TH ST S. 90TH ST. S. 45TH ST. S. 24TH AVE. Port of Tampa Bay 676 ST, PAUL ST. East S. 54TH ST. Bay 301 Tampa 36TH AVE S. **END** Brandon **EA/FONSI** HARTFORD ST. CSX Rail Yard DENVER ST. Riverview Reevaluation Phases from 1994 EA/FONSI Work Program Item Segment No. 255598-1 22nd Street Causeway/Causeway Boulevard/State Road 676 **PROJECT LOCATION / SEGMENTS MAP**

Figure 1-1: Project Location Map

From State Road 60 to US 301 Hillsborough County, Florida

2.0 UTILITY INFORMATION

2.1 General

The intent of this report is to furnish pertinent information concerning the location, size and characteristics of major utilities found within the proposed study limits (See Figure 1-1).

2.2 Utility Coordination

The preliminary utility coordination and investigation effort was conducted through written and verbal communications with the existing utility owners. A Sunshine State 811 of the Florida Design Ticket System listing of existing utility owners was acquired on April 15, 2019. (Appendix A).

Initially, verbal communication was made to all utility's owners outlining the investigation effort along with the project limits. The list of utility agencies owners (UAO) known to operate utilities within the project corridor include:

Figure 1-2: Utility Contact Information

Figure 1-2. Othicy Contact information						
Utility Agency	Utility Contact Name	Utility Contact Phone	Utility Contact Email			
CenturyLink	Bradley Morseth	612-805-9479	bradley.morseth@centurylink.com			
City of Tampa Water	Kimani Thomas	813-460-3731	kimani.thomas@tampagov.net			
City of Tampa Wastewater	Richard Rivera	813-274-8957	richard.rivera@tampagov.net			
Hillsborough County Traffic	Darryle Norton	813-627-1326	nortond@hillsboroughcounty.org			
Hillsborough County Water Resources	Warren Gilbreath	813-209-3075	GilbreathW@HillsboroughCounty.org			
Tampa Bay Pipeline	Greg Lipscomb	813-623-2431	greg.lipscomb@panamericanpipelines.com			
TECO Peoples Gas	James Hamilton	813-309-8531	jkhamilton@tecoenergy.com			
Verizon	Andrew Cole	813-847-4037	andrew.cole2@verizon.com			
Zayo	Bruce Herrington	252-207-2400	Bruce.Herrington@Cobbfendley.com			
Bright House Networks dba Charter/Spectrum	Paul Bustamante	813-538-2924	Paul.Bustamante@charter.com			
Frontier	Randy Thomas	813-892-9692	randall.james@ftr.com			

For the report's preparation, utility owners were provided aerial based utility plans depicting US 41/SR 45 at the planned project location. Using these aerial plans as a base map, each utility owner was asked to indicate their existing and proposed utilities as well as any easements that may affect their reimbursement rights for potential relocations of their facilities. In response, most utility owners replied via written communications. There was no response from the contacted utilities where they mentioned any easements or reimbursable on this project. The utility owners provided the requested information concerning their facilities using either the utility plans or reference documentation (i.e., "As Built" or GIS maps). "Marked" Plans or reference documentation was received from the following Utility Agency Owners.

3.0 UTILITY EXISTING FACILITIES DESCRIPTIONS

3.1 CenturyLink

Marked plans were received from Bradley Morseth on 5/18/2021 via e-mail. In the project vicinity CenturyLink has 12-1/5" high-density polyethylene (HDPE) conduits containing 72FOC and 216FOC (fiberoptic cables).

<u>12-1/5" HDPE conduit</u> runs along the eastern US 41 ROW throughout the project extent. Proposed project work that may come in conflict includes sidewalk installation, bridge construction, changes to roadway elevation and to MSE, ROW change, roadway milling and resurfacing.

3.2 City of Tampa Water

Marked plans were received from Kimani Thomas on 5/18/2021 via e-mail. The markups show the City of Tampa Water has cast iron pipe (CAS), cast iron-mechanical joint pipe (EMJ), cast iron-caulked joint pipe (ECJ), ductile metal pipe (DIP), and polyvinyl chloride (PVC) water mains within the project vicinity.

<u>B1-2-07</u>: 24" EMJ and ECJ mains are located under US 41 south-bound lane from the southern project terminus to sta. 1044. North of sta. 1044 it runs along the approximate centerline US 41 to the northern project terminus. Proposed project work that may come in conflict includes changes to roadway elevation and to MSE, bridge construction, and profile changes, sidewalk installation, roadway milling and resurfacing.

<u>C76-20-1:</u> As a 2" EMJ, this main is located along the US 41 western ROW from sta. 1005+60 to 1006+40. As a 6" DIP, it extends west from US 41 southbound lane at sta. 1006+45. Proposed project work that may come in conflict includes changes to roadway elevation, sidewalk installation, and ROW changes.

<u>FC22-70:</u> A 6" ECJ main runs along the east ROW and under the north-bound lane of US 41 from sta. 1007 to 1017+40, and then again along the US 41 north-bound lane from sta. 1040+20 to 10444. It crosses US 41 as an 8" ECJ at sta. 1002+25, 1007+30, and 1033+40, and as a 6" ECJ at sta. 1011 and 1017+20. A 6" DIP extends east from the US 41 eastern ROW at sta. 2011+15. Proposed project work that may come in conflict includes changes to roadway elevations and to MSE, bridge construction, sidewalk installation, ROW changes, roadway milling and resurfacing.

<u>F13-4-72</u>: 4" DIP runs along the US 41 eastern ROW from sta. 1019+60 to 1022. Proposed project work that may come in conflict includes sidewalk installation and roadway change to MSE.

<u>A14-4-69</u>: 6" DIP runs along the US 41 eastern ROW from sta. 1022 to 1023+20. Proposed project work that may come in conflict includes sidewalk installation, changes to roadway elevations, and bridge construction.

<u>A14-3-52</u>: 6" DIP extends east from the US 41 north-bound lane, along the north side of Trenton St. Proposed project work that may come in conflict includes change to roadway elevations, sidewalk installation, and ROW changes.

<u>FC36-54</u>: 6" ECJ is located along the US 41 eastern ROW from sta. 1023+20 to 1028. Proposed project work that may come in conflict includes new roadways to properties, sidewalk installation, and roadway change to on MSE.

<u>FC23-83/A15-1-04</u>: 6" ECJ runs along the US 41 eastern ROW from sta. 2060+500 to 2065. Proposed project work that may come in conflict includes ROW changes, sidewalk installation, change toroadway elevation, roadway milling and resurfacing.

<u>FC33-29:</u> 12" ECJ crosses US 41 at sta. 1007+5. Proposed project work that may come in conflict includes roadway changes to at-grade, sidewalk installation, and ROW changes.

<u>C5-1-29</u>: 14-16" steel casing crosses US 41 at sta. 1020+80 in a contaminated area. Proposed project work that may come in conflict includes roadway changes to at-grade and to MSE, sidewalk installation, ROW change, and curb returns increased for WB-62FL.

<u>FC23-34:</u> 2" ECJ extends west from the US 41 south-bound lane main at sta. 1010+60. Proposed project work that may come in conflict includes ROW changes, sidewalk installation, and roadway change to at-grade.

<u>A15-1-04</u>: 6" DIP main extends west from the US 41 south-bound lane at sta. 1014+80, 1035+80, and 1039+80. It crosses US 41 at sta. 1023+20. Proposed project work that may come in conflict includes sidewalk installation, changes to roadway eleevations, roadway milling and resurfacing, and ROW change.

<u>E9-2-48</u>: 6" DIP extends west from the US 41 south-bound lane at sta. 1039+80. Proposed project work that may come in conflict includes ROW change, sidewalk installation, roadway elevation change, roadway milling and resurfacing.

<u>C7-1-33</u>: An 8" ECJ crosses US 41 at sta. 1033+40. Proposed project work that may come in conflict includes ROW change, sidewalk installation, roadway elevation change, bridge construction.

<u>FC39-100:</u> 8" ECJ extends west from the US 41 south-bound lane at sta. 1019. Proposed project work that may come in conflict includes changes to roadway elevation and to MSE, sidewalk installation, ROW changes, and curb returns increase for WB-62FL.

<u>FC24-61</u>: 2" ECJ extends west from the US 41 south-bound lane at sta. 1027+50. Proposed project work that may come in conflict includes changes to roadway elevations, roadway milling and resurfacing.

<u>C3-3-09:</u> 6" PVC extends west from the US 41 south-bound lane at sta. 1044. Proposed project work that may come in conflict includes ROW changes, sidewalk installation, changes to roadway elevation, roadway milling and resurfacing.

<u>FC41-3:</u> 8" ECJ crosses US 41 at sta. 1046+65. Proposed project work that may come in conflict includes sidewalk installation and change to roadway elevation.

<u>E14-4-17</u>: 12" DIP extends east from the US 41 north-bound lane at sta. 1060+15. Proposed project work that may come in conflict includes, changes to roadway elevation, roadway milling and resurfacing, and sidewalk installation.

<u>FC42-41:</u> 6" ECJ extends west from the approximate US 41 centerline at sta. 1064+30. Proposed project work that may come in conflict includes sidewalk installation, ROW changes, changes to roadway elevation, roadway milling and resurfacing.

<u>E14-4-21/FC26-56:</u> An abandoned 2" ECJ is located along the US 41 south-bound lane from sta. 1060+40 to 1064+20. Proposed project work that may come in conflict includes changes to roadway elevations, ROW change, and sidewalk installation.

<u>FC27-95:</u> 6" ECJ runs along the US 41 western ROW from sta. 1050 to 1055. Proposed project work that may come in conflict includes changes to roadway elevations, ROW change, and sidewalk installation.

<u>FC29-28:</u> 2" ECJ runs along the US 41 eastern ROW from sta. 1051+50 to 11054+40. Proposed project work that may come in conflict includes changes to roadway elevations, ROW change, and sidewalk installation.

<u>FC22-35:</u> 8" CAS runs along the southern SR 676 ROW from the western project terminus to sta. 3019+20. Proposed project work that may come in conflict includes sidewalk installation, ROW change, and changes to roadway elevation.

<u>J0346</u>: 12" PVC extends south from the SR 676 southern ROW at sta. 3004. Proposed project work that may come in conflict includes changes to roadway elevation and sidewalk installation.

<u>FC22-34:</u> 8" ECJ runs along the SR 676 southern ROW from sta. 3019+20 to 3029. Proposed project work that may come in conflict includes changes to roadway elevations, sidewalk installation, and ROW changes.

<u>C3-3-10:</u> An abandoned 8" DIP runs along the SR 676 southern ROW from sta. 3029 to 3039+80. Proposed project work that may come in conflict includes changes to roadway elevation, sidewalk installation, and ROW change.

<u>FC84-212-02/03/04/05/06</u>: 12" DIP runs along the SR 676 east-bound lane from sta. 3039+80 to the eastern project terminus. Unnamed extensions cross SR 676 at sta. 3041+40, 3043+20, and 3044+10, and 3054+50. From sta. 3060+20 to 3061+60 the pipe is in steel casing. Proposed project work that may come in conflict includes sidewalk installation and changes to roadwayelevation.

<u>FC48-32:</u> 6" ECJ extends south from the SR 676 east-bound lane at 3040+80. Proposed project work that may come in conflict includes changes to roadway elevation, ROW changes, and sidewalk installation.

<u>FC55-01:</u> 8" DIP crosses SR 676 at sta. 3057+60. Proposed project work that may come in conflict includes changes to roadway elevation, sidewalk installation, and ROW change.

3.3 City of Tampa Wastewater

Marked plans were received from Richard Rivera on 5/18/2021 via e-mail. The City of Tampa Wastewater has 10" PVC pressurized mains and 8" PVC gravity mains in the project vicinity.

<u>10" PVC pressurized main</u> that crosses SR 676 at Sagasta St. and continues east along the northern ROW, ending outside the project's eastern terminus. Proposed project work that may come in conflict includes ROW change, sidewalk installation, and changes to roadway elevation.

<u>8" PVC gravity main</u> crosses US 41 at the CSX railroad intersection and runs along the north side of the tracks, with casings at the US 41 crossing. Proposed project work that may come in conflict includes bridge construction, ROW change, sidewalk installation, changes to roadway elevation, roadway milling and resurfacing.

3.4 Frontier

Marked plans were received from Randy Thomas on 4/13/2021 via e-mail. In the project vicinity Frontier has 100, 200, 600 buried cables, FOC, 3-4", 6-4", 2-4", 4-4" and 8-4" conduits. At two road crossings conduits are in 10" and 24" steel casing. There are also (1), (3), and (4) aerial cables and overhead guy wires.

<u>3 buried cables (600,200,100)</u> are located along the US 41 eastern ROW from the southern project terminus to sta. 1010+70 (Trenton St.). Proposed project work that may come in conflict includes sidewalk installation, change to roadway elevation, and roadway change to on MSE.

<u>3 buried cables (600,600,600)</u> are located along the US 41 eastern ROW from sta. 1018 to 1022+80. Proposed project work that may come in conflict includes sidewalk installation, changes to roadway elevation, and ROW change.

<u>3 buried cables (600,600,FOC)</u> are located along the US 41 eastern ROW from sta. 1032+20 to 1039+50. This type of line extends west from the US 41 western ROW at S 31st Ave (sta. 1039+50). Proposed project work that may come in conflict includes sidewalk installation, bridge construction, roadway change to on MSE, ROW change, new roadways to properties, roadway milling and resurfacing.

<u>5 buried cables (600,600,600,200,100)</u> run along the US 41 eastern ROW from sta. 1010+70 to 1018. Proposed project work that may come in conflict includes sidewalk installation and changes to roadway elevation.

<u>5 buried cables (100,200,600,600,FOC)</u> are located along the eastern US 41 ROW from sta. 1022+80 to 1032+20. Proposed project work that may come in conflict includes sidewalk installation, bridge construction, roadway change to on MSE, ROW change, and new roadways to properties.

<u>1 buried cable (unknown size or type)</u> crosses SR 676 at sta. 3009+90 and runs along the US 41 western ROW from sta. 1002+40 to 1006. Proposed project work that may come in conflict includes sidewalk installation, changes to roadway elevation, and ROW change.

<u>10"</u> steel casing with copper and fiber cables cross US 41 at sta. 1039+50. Proposed project work that may come in conflict includes sidewalk installation, roadway change to on MSE, ROW change, roadway milling and resurfacing.

<u>3-4" conduits</u> are located along the US 41 eastern ROW from sta. 1043+60 to 1046+60, 1050+50 to 1060+20 and along the western US 41 ROW from sta. 1050+50 to 1067+40. They cross US 41 at sta. 1046+60 (SR 676). They also run along the southern SR 676 ROW from sta. 3034+20 to 3040+60. Proposed project work that may come in conflict includes sidewalk installation, changes to roadway elevation, ROW change, roadway milling and resurfacing.

<u>6-4" conduits</u> run along the eastern US 41 ROW from sta. 1046+60 to 1050+50 and along the SR 676 southern ROW from sta. 3047+50 to 3057+50. They cross SR 676 at sta. 3057+50. Proposed project work that may come in conflict includes sidewalk installation, changes to roadway elevation, ROW change, roadway milling and resurfacing.

<u>2-4" conduits</u> are located along the northern SR 676 ROW from sta. 3049+20 to 3051+80. They also extend west from the western US 41 ROW at sta. 1050+50. Proposed project work that may come in conflict includes sidewalk installation, changes to roadway elevation, and ROW change.

<u>4-4" conduits</u> run along the southern SR 676 ROW from the western project terminus to sta. 3034+20. They cross SR 676 at sta. 3050+30. Proposed project work that may come in conflict includes sidewalk installation, changes to roadway elevation, and ROW change.

<u>Buried FOC</u> cross SR 676 at sta. 3017+60 and extend east from the eastern US 41 ROW at sta. 1051+50. Proposed project work that may come in conflict includes sidewalk installation, changes to roadway elevation, and ROW change.

<u>24"</u> steel casing with 16-4" conduits cross SR 676 at sta. 3034+20. Proposed project work that may come in conflict includes sidewalk installation, changes to roadway elevation, and ROW change.

<u>8-4" conduits</u> extend west from the US 41 western ROW at sta. 1050+50. Proposed project work that may come in conflict includes sidewalk installation, changes to roadway elevation, and ROW change.

(1) Aerial cables extend east from the US 41 eastern ROW at sta. 1010+70 (Trenton St.), 1060+70 (S 24th Ave.) and 1064+70 (S 23rd Ave.). They extend west from the US 41 western ROW at sta. 1018+60 (Raleigh St.). They cross US 41 at sta. 1022+80 (Towaway Ave.), 2053+70, and 1064+70 (S 23rd Ave.). They are located along the US 41 western ROW from sta. 1050+50 (El Camino Blanco Blvd.) to 1053+70 and from sta. 1060+70 (S 24th Ave.) to 1064+70 (S 23rd Ave.). They cross S 24th Ave. at the US 41 intersection (east side of US 41). They cross SR 676 at sta. 3009+80, 3022+60, 3027+30 (S 45th St.), 3034+20 (S 47th St.), and 3037. They are located along the SR 676 northern ROW from 3009+80 to 3013+30 and from 3020+60 to 3022+60. They run along the SR 676 southern ROW from sta. 3022+60 to 3042+90.

(3) Aerial cables cross US 41 at sta. 1053+70. They run along the eastern US 41 ROW from sta. 1053+70 to 1060+70 (S 24^{th} Ave.).

(4) Aerial cables are located along the US 41 eastern ROW from sta. 1060+70 (S 24th Ave.) to the northern project terminus.

Overhead guy wires run along the western US 41 ROW from sta. 1017+40 (Raleigh St.) to 1022+80 (Towaway Ave.) and on SR 676 southern ROW at 3040+40.

3.5 Hillsborough County Traffic

Marked plans were received from Darryle Norton on 1/23/2023 via e-mail. In the project vicinity Hillsborough County Traffic has 2" and 4" traffic system conduits, along with buried fiber bundle and copper cables.

<u>4" traffic system conduits</u> are located along the SR 676 northern ROW from sta. 3046 (US 41, west side) through the eastern project terminus.

<u>2" traffic system conduits</u> run along the US 41 western ROW from sta. 1049 (SR 676, north side) through the northern project terminus.

<u>Buried fiber bundle cables</u> are located along the SR 676 northern ROW from the US 41 intersection (east side) through the eastern project terminus.

Buried copper cables cross US 41 at the SR 676 intersection (north side).

3.6 Hillsborough County Water Resources

On 5/10/2021 Warren Gilbreath reported via email that there isn't any County-owned water, wastewater, or reclaimed infrastructure within the limits of this project.

3.7 Tampa Bay Pipeline

Marked plans were received from Greg Lipscomb on 5/11/2021 via e-mail. The plans show Tampa Bay Pipeline has anhydrous ammonia (AA) 6" carbon steel (CS) pipes in the project vicinity.

<u>AA 6" CS</u> pipes crosses US 41 at sta. 1033+70k, along the north side of St. Paul St. This type of pipe also runs along the SR 676 southern ROW, beginning at the wester project terminus and turning south at sta. 4042. Proposed project work that may come in conflict includes bridge construction, ROW change, sidewalk installation, roadway change to at-grade, roadway milling and resurfacing.

3.8 Spectrum

Marked plans were received from Paul Bustamante on 1/24/2023 via e-mail. In the project vicinity Spectrum has buried and aerial FOC and CATV lines.

<u>Buried FOC</u> cross US 41 at sta. 1007+50 (near Hartford St.) and 1051+30 (S 27th Ave.). Proposed project work that may come in conflict includes sidewalk installation, changes to roadway elevation, and ROW change.

<u>Buried CATV</u> cross US 41 at sta. 1017+15 (near Delaney Creek) and 1035+80 (between St. Paul St. and S 31st Ave.). They cross SR 676 at sta. 3027 (S 45th St.) and run along the SR 676 northern ROW from sta. 3027 (S 45th St.) to 3039 (near Sagasta St.). Proposed project work that may come in conflict includes sidewalk installation, changes to roadway elevation, roadway change to on MSE, ROW change, roadway milling and resurfacing, and new roadway to properties.

<u>Aerial CATV and FOC</u> are located along the northern US 41 ROW from the southern project terminus through the northern project terminus. They cross US 41 at sta. 1052 (S 27th Ave.) They run along the SR 676 northern ROW from sta. 3046+60 (US 41, west side) to 3049+20.

3.9 TECO Peoples Gas

Marked plans were received 6/15/2021 from James Hamilton via e-mail. TECO Peoples Gas has 2", 4" and 6" carbon steel (CS) gas mains (GM) in the project area. Some of these are retired mains.

<u>6" CS GM</u> runs along the US 41 eastern ROW from past the southern project terminus to sta. 1007 where it turns east and out of the project area. Proposed project work that may come in conflict includes sidewalk installation, changes to roadway elevation, and ROW change.

<u>4" CS GM/retired OSS</u> cross US 41 at sta. 1010+80, continues north along the western ROW, and terminates at sta. 1023+20. Proposed project work that may come in conflict includes sidewalk installation, changes to roadway elevation, ROW change, bridge construction, roadway change to on MSE.

<u>2" CS GM/retired OSS</u> extends west from the US 41 western ROW at sta. 1023+20 (north side of Towaway Ave.). Proposed project work that may come in conflict includes changes to roadway elevation and sidewalk installation.

<u>2" CS GM</u> are located along the SR 676 southern ROW from sta. 3014 through the project's eastern terminus. Extensions running south from this main exist at sta. 3015+40 and 3041. Proposed project work that may come in conflict includes ROW change, changes to roadway elevation and sidewalk installation.

3.10 Verizon

Marked plans were received from Andrew Cole on 1/24/2023 via e-mail.

(2) 2" HDPE conduit with FOC are located along the US 41 eastern ROW from the southern project terminus to the northern project terminus and along the SR 676 northern ROW from sta. 3047+80 (US 41, east side) to the eastern project terminus. Proposed project work that may come in conflict

includes sidewalk installation, bridge construction, changes to roadway elevation, roadway change to on MSE, ROW change, new roadways to properties, roadway milling and resurfacing.

3.11 Zayo

Marked plans were received from Bruce Herrington on 6/9/2021 via e-mail. In the project area, Zayo has 1-1/4" HDPE ducts 144ct FOC.

(3) 1-1/4" HDPE ducts 144ct FOC are located along the northern SR 676 ROW from the eastern project terminus to US 41, and along the eastern US 41 ROW from SR 676 through the northern project terminus. Proposed project work that may come in conflict includes sidewalk installation, changes to roadway elevation, ROW change, roadway milling and resurfacing.

APPENDICES

Appendix A Sunshine 811 Design Ticket

Appendix B Utility Marked Plans/As-Builts and Information

Appendix C Utility Impact Table

APPENDIX A

Sunshine 811 Design Ticket

1/31/23, 4:12 PM Ticket

DESIGN TICKET 1 OF 2

Ticket: 031307965 Rev:000 Taken: 01/31/23 16:12ET

State: FL Cnty: HILLSBOROUGH GeoPlace: PALM RIVER-CLAIR MEL

CallerPlace: PALM RIVER-CLAIR MEL

Subdivision:

Address:

Street : S 50TH ST Cross 1 : DENVER ST Within 1/4 mile: Y

Locat: DESIGN TICKET BEGINS FROM THE INTERSECTION OF S 50TH ST & DENVER ST, GOING NORTH FROM ROW TO ROW ON BOTH SIDES OF THE ROAD TO S 23RD AVE FOR A TOTAL APPROX DISTANCE OF 1.31 MI

:

Remarks : DESIGN ONLY, NO LOCATES

IN RESPONSE TO RECEIPT OF A DESIGN TICKET, SSOCOF PROVIDES THE ORIGINATOR OF THE DESIGN TICKET WITH A LIST OF SSOCOF MEMBERS IN THE VICINITY OF THE DESIGN PROJECT. SSOCOF DOES NOT NOTIFY SSOCOF MEMBERS OF THE RECEIPT BY SSOCOF OF A DESIGN TICKET. IT IS THE SOLE RESPONSIBILITY OF THE DESIGN ENGINEER TO CONTACT SSOCOF MEMBERS TO REQUEST INFORMATION ABOUT THE LOCATION OF SSOCOF MEMBERS' UNDERGROUND FACILITIES. SUBMISSION OF A DESIGN TICKET WILL NOT SATISFY THE REQUIREMENT OF CHAPTER 556, FLORIDA STATUTES, TO NOTIFY SSOCOF OF AN INTENT TO EXCAVATE OR DEMOLISH. THAT INTENT MUST BE MADE KNOWN SPECIFICALLY TO SSOCOF IN THE MANNER REQUIRED BY LAW. IN AN EFFORT TO SAVE TIME ON FUTURE CALLS, SAVE YOUR DESIGN TICKET NUMBER IF YOU INTEND TO BEGIN EXCAVATION WITHIN 90 DAYS OF YOUR DESIGN REQUEST. THE DESIGN TICKET CAN BE REFERENCED, AND THE INFORMATION ON IT CAN BE USED TO SAVE TIME WHEN YOU CALL IN THE EXCAVATION REQUEST.

*** LOOKUP BY MANUAL ***

:

Grids : 2754A8224D 2754B8224D 2755B8224D 2755C8224D 2755D8224D

Work date: 01/31/23 Time: 16:06ET Hrs notc: 000 Category: 6 Duration: UNKNOWN

Due Date : 02/02/23 Time: 23:59ET Exp Date : 03/02/23 Time: 23:59ET

Work type: DESIGN Boring: N White-lined: N

Ug/Oh/Both: U Machinery: N Depth: UNK Permits: N N/A

Done for : DESIGN

Company: ECHO U.E.S INC Type: OTHR

Co addr : 400 SR 434

City : OVIEDO State: FL Zip: 32765

Caller : CHRISTINA BYRAM Phone: 888-778-3246 Ext: 712

BestTime: 7AM-5PM

Email : CHRISTINA.BYRAM@ECHOUES.COM

Submitted: 01/31/23 16:12ET Oper: CHR Chan: WEB

Mbrs: AL2029 FLW941 GT1722 HCR409 L3C900 MCIU01 PGSTAM TAMP04 TAMP06 TAMPPL

Mbrs : TAMPS1 TECO01 TP1415 TW1059


1/31/23, 4:12 PM Ticket

* Responses are current as of 01/31/2023 04:12 PM

Ex. Circum	Service Area	<u>Utility Type(s)</u>	Contact	Alternate Contact	Emergency Contact	Positive Response
No	AMERICAN LIGHTING AND SIGNALIZATION INC AL2029 * New	LIGHTING	CLIFF DOBSON (813) 267-2186	CLIFF DOBSON (813) 267-2186	CLIFF DOBSON (813) 267-2186	
No	ZAYO GROUP / FORMERLY LIGHTWAVE, LLC FLW941	FIBER	HENRY KLOBUCAR (406) 496-6510	STAKE CENTER / LOUIS SIMONE (772) 579-8956	JON RAY (813) 417-2184	
No	FRONTIER COMMUNICATIONS GT1722	CATV, COMMUNICATION LINES	TONI CANNON (813) 875-1014		AFTER HOURS CRAIG ELLISON, USIC. (800) 575-5594	
No	HILLSBOROUGH COUNTY TRAFFIC SERVICE UNIT HCR409	STREET LIGHTS, TRAFFIC SIGNALS	DARRYLE NORTON	GEORGE AUBEL (813) 927-6751	HILLSBOROUGH COUNTY CUSTOMER SERVICE (813) 744-9650	
No	CENTURYLINK L3C900	FIBER	NETWORK RELATIONS (877) 366-8344 x2	TECH ON DUTY (877) 366-8344 x3	TECH ON DUTY (877) 366-8344 x3	
No	MCI MCIU01	COMMUNICATION LINES, FIBER	ASG INVESTIGATIONS TEAM (800) 624-9675 x2	NATIONAL FIBER SECURITY DEPARTMENT (800) 624-9675	NATIONAL FIBER SECURITY DEPARTMENT (800) 624-9675	
No	TECO PEOPLES GAS- TAMPA PGSTAM	GAS	JOAN DOMNING (813) 275-3783	ROGER ROSELLO (813) 422-2805	TECO PEOPLES GAS CUSTOMER SERVICE** (877) 832-6747	
No	CITY OF TAMPA TRANSPORT TAMP04	TRAFFIC SIGNALS	VIK BHIDE (TRANSPORTATION) (813) 274-8066		ANYONE DISPATCH (813) 274-3101	
No	CITY OF TAMPA WATER TAMP06	WATER	WATER MAPS AND AS-BUILTS INFORMATION (813) 274-7109		WATER DEPARTMENT TRIAGE (813) 274-7400	
No	TAMPA BAY PIPELINE CORPORATION TAMPPL	AMMONIA PIPELINE	RANDY HERRON (813) 623-2431	TBPL OPERATOR (813) 623-5815	MARTIN GOODE (813) 623-2431	
No	CITY OF TAMPA SEWER TAMPS1	SEWER	JACK FERRAS (SEWER) (813) 274-8095	DANIEL HITTLE (813) 898-1384	CITY OF TAMPA WASTEWATER COLLECTION (813) 898-1420	
No	TAMPA ELECTRIC COMPANY TECO01	ELECTRIC	ENGINEERING GROUP CSADMIN@TECOENI	LORENZO JONES (813) 275-3427	SYSTEM SERVICE (813) 223-0800	
No	TAMPA PORT AUTHORITY TP1415	ELECTRIC, FIBER, SEWER, TELEPHONE, WATER	ISMAEL ARROYO (813) 241-1706	MARISOL MARTINEZ (813) 241-1701	NORBERTO SANCHEZ (813) 241-1700	
No	SPECTRUM SUNSHINE STATE, LLC	CATV	GENE GREGORY (863) 333-4763	USIC DISPATCH OFFICE (CLS) (800) 778-9140	USIC DISPATCH OFFICE (CLS) (800) 778-9140	

1/31/23, 4:12 PM Ticket

TW1059

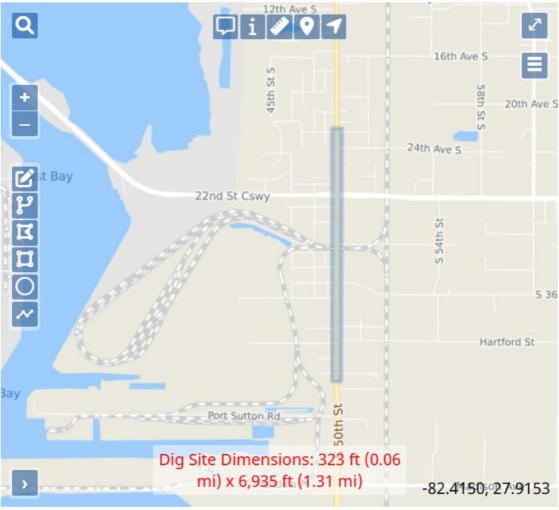

1/31/23, 4:21 PM Ticket

DESIGN TICKET 2 OF 2

Ticket: 031308102 Rev:000 Taken: 01/31/23 16:21ET

State: FL Cnty: HILLSBOROUGH GeoPlace: PALM RIVER-CLAIR MEL

CallerPlace: PALM RIVER-CLAIR MEL

Subdivision:

Address:

Street : CAUSEWAY BLVD Cross 1 : S 45TH ST Within 1/4 mile: Y

Locat: DESIGN BEGINS FROM THE INTERSECTION OF CAUSEWAY BLVD & S 45TH ST, GOING EAST FROM ROW TO ROW ON BOTH SIDES OF THE ROAD TO S GELMAN PL FOR A TOTAL APPROX DISTANCE OF .59 MI

:

Remarks : DESIGN ONLY, NO LOCATES

IN RESPONSE TO RECEIPT OF A DESIGN TICKET, SSOCOF PROVIDES THE ORIGINATOR OF THE DESIGN TICKET WITH A LIST OF SSOCOF MEMBERS IN THE VICINITY OF THE DESIGN PROJECT. SSOCOF DOES NOT NOTIFY SSOCOF MEMBERS OF THE RECEIPT BY SSOCOF OF A DESIGN TICKET. IT IS THE SOLE RESPONSIBILITY OF THE DESIGN ENGINEER TO CONTACT SSOCOF MEMBERS TO REQUEST INFORMATION ABOUT THE LOCATION OF SSOCOF MEMBERS' UNDERGROUND FACILITIES. SUBMISSION OF A DESIGN TICKET WILL NOT SATISFY THE REQUIREMENT OF CHAPTER 556, FLORIDA STATUTES, TO NOTIFY SSOCOF OF AN INTENT TO EXCAVATE OR DEMOLISH. THAT INTENT MUST BE MADE KNOWN SPECIFICALLY TO SSOCOF IN THE MANNER REQUIRED BY LAW. IN AN EFFORT TO SAVE TIME ON FUTURE CALLS, SAVE YOUR DESIGN TICKET NUMBER IF YOU INTEND TO BEGIN EXCAVATION WITHIN 90 DAYS OF YOUR DESIGN REQUEST. THE DESIGN TICKET CAN BE REFERENCED, AND THE INFORMATION ON IT CAN BE USED TO SAVE TIME WHEN YOU CALL IN THE EXCAVATION REQUEST.

*** LOOKUP BY MANUAL ***

:

Grids : 2755C8223A 2755C8224B 2755C8224C 2755C8224D

Work date: 01/31/23 Time: 16:14ET Hrs notc: 000 Category: 6 Duration: UNKNOWN

Due Date: 02/02/23 Time: 23:59ET Exp Date: 03/02/23 Time: 23:59ET

Work type: DESIGN Boring: N White-lined: N

Ug/Oh/Both: U Machinery: N Depth: UNK Permits: N N/A

Done for : DESIGN

Company: ECHO U.E.S INC Type: OTHR

Co addr : 400 SR 434

City : OVIEDO State: FL Zip: 32765

Caller : CHRISTINA BYRAM Phone: 888-778-3246 Ext: 712

BestTime: 7AM-5PM

Email : CHRISTINA.BYRAM@ECHOUES.COM

Submitted: 01/31/23 16:21ET Oper: CHR Chan: WEB


Mbrs: AL2029 GT1722 HCR409 L3C900 MCIU01 PGSTAM TAMP04 TAMP06 TAMPPL TAMPS1

Mbrs : TEC001 TF1649 TW1059

1/31/23, 4:21 PM Ticket

* Responses are current as of 01/31/2023 04:21 PM

Ex. Circum	Service Area	<u>Utility Type(s)</u>	<u>Contact</u>	Alternate Contact	Emergency Contact	Positive Response
No	AMERICAN LIGHTING AND SIGNALIZATION INC AL2029 * New	LIGHTING	CLIFF DOBSON (813) 267-2186	CLIFF DOBSON (813) 267-2186	CLIFF DOBSON (813) 267-2186	
No	FRONTIER COMMUNICATIONS GT1722	CATV, COMMUNICATION LINES	TONI CANNON (813) 875-1014		AFTER HOURS CRAIG ELLISON, USIC. (800) 575-5594	
No	HILLSBOROUGH COUNTY TRAFFIC SERVICE UNIT HCR409	STREET LIGHTS, TRAFFIC SIGNALS	DARRYLE NORTON	GEORGE AUBEL (813) 927-6751	HILLSBOROUGH COUNTY CUSTOMER SERVICE (813) 744-9650	
No	CENTURYLINK L3C900	FIBER	NETWORK RELATIONS (877) 366-8344 x2	TECH ON DUTY (877) 366-8344 x3	TECH ON DUTY (877) 366-8344 x3	
No	MCI MCIU01	COMMUNICATION LINES, FIBER	ASG INVESTIGATIONS TEAM (800) 624-9675 x2	NATIONAL FIBER SECURITY DEPARTMENT (800) 624-9675	NATIONAL FIBER SECURITY DEPARTMENT (800) 624-9675	
No	TECO PEOPLES GAS- TAMPA PGSTAM	GAS	JOAN DOMNING (813) 275-3783	ROGER ROSELLO (813) 422-2805	TECO PEOPLES GAS CUSTOMER SERVICE** (877) 832-6747	
No	CITY OF TAMPA TRANSPORT TAMP04	TRAFFIC SIGNALS	VIK BHIDE (TRANSPORTATION) (813) 274-8066	ANYONE DISPATCH (813) 274-3101	ANYONE DISPATCH (813) 274-3101	
No	CITY OF TAMPA WATER TAMP06	WATER	WATER MAPS AND AS-BUILTS INFORMATION (813) 274-7109		WATER DEPARTMENT TRIAGE (813) 274-7400	
No	TAMPA BAY PIPELINE CORPORATION TAMPPL	AMMONIA PIPELINE	RANDY HERRON (813) 623-2431	TBPL OPERATOR (813) 623-5815	MARTIN GOODE (813) 623-2431	
No	CITY OF TAMPA SEWER TAMPS1	SEWER	JACK FERRAS (SEWER) (813) 274-8095	DANIEL HITTLE (813) 898-1384	CITY OF TAMPA WASTEWATER COLLECTION (813) 898-1420	
No	TAMPA ELECTRIC COMPANY TECO01	ELECTRIC	ENGINEERING GROUP CSADMIN@TECOENI	LORENZO JONES (813) 275-3427	SYSTEM SERVICE (813) 223-0800	
No	TECO FIBER TF1649	FIBER	ENGINEERING GROUP CSADMIN@TECOENI	PAULETTE BURNETT GASTON E (813) 275-3059	SYSTEM SERVICE (813) 223-0800	
No	SPECTRUM SUNSHINE STATE, LLC TW1059	CATV	GENE GREGORY (863) 333-4763	USIC DISPATCH OFFICE (CLS) (800) 778-9140	USIC DISPATCH OFFICE (CLS) (800) 778-9140	

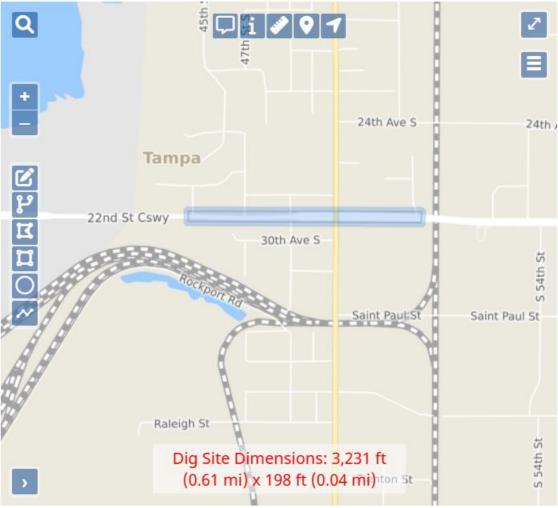

APPENDIX B

Utility Marked Plans/as-Builts and Information




STATE OF FLORIDA DEPARTMENT OF TRANSPORTATION

CONTRACT PLANS

FINANCIAL PROJECT ID 440749-1-52-01

(FEDERAL FUNDS)
HILLSBOROUGH COUNTY (10002)
STATE ROAD NO. US41

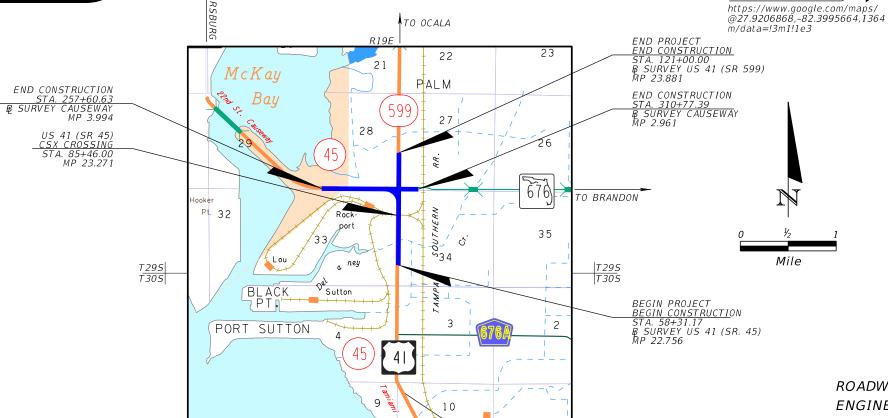

TO BRADENTON

GOVERNING STANDARD PLANS:

Florida Department of Transportation, FY2021-22 Standard Plans for Road and Bridge Construction and applicable Interim Revisions (IRs).

Standard Plans for Road Construction and associated IRs are available at the following website: http://www.fdot.gov/design/standardplans

APPLICABLE IRs: N/A

Standard Plans for Bridge Construction are included in the Structures Plans Component

GOVERNING STANDARD SPECIFICATIONS:

Florida Department of Transportation, July 2022 Standard Specifications for Road and Bridge Construction at the following website: http://www.fdot.gov/programmanagement/Implemented/SpecBooks

ROADWAY PLANS ENGINEER OF RECORD:

NAPLE

BRANAN R. ANDERSON, P.E. NO.: 78438 KISINGER CAMPO AND ASSOCIATES CORP. CONSULTING ENGINEERS & PLANNERS 201 N. FRANKLIN STREET, SUITE 400 TAMPA, FLORIDA 33602 (813) 871-5331 VENDOR NUMBER:: F59-1677145

FDOT PROJECT MANAGER:


TIM O'BRIEN P.E.


LOCATION OF PROJECT


CONSTRUCTION	FISCAL	SHEET
CONTRACT NO.	YEAR	NO.
TBD	21	1


AYTONA BEACH


dgrumbach 4/13/2021 2:47:16 PM Default c:\pwworkingdir\kca-pw.bentle

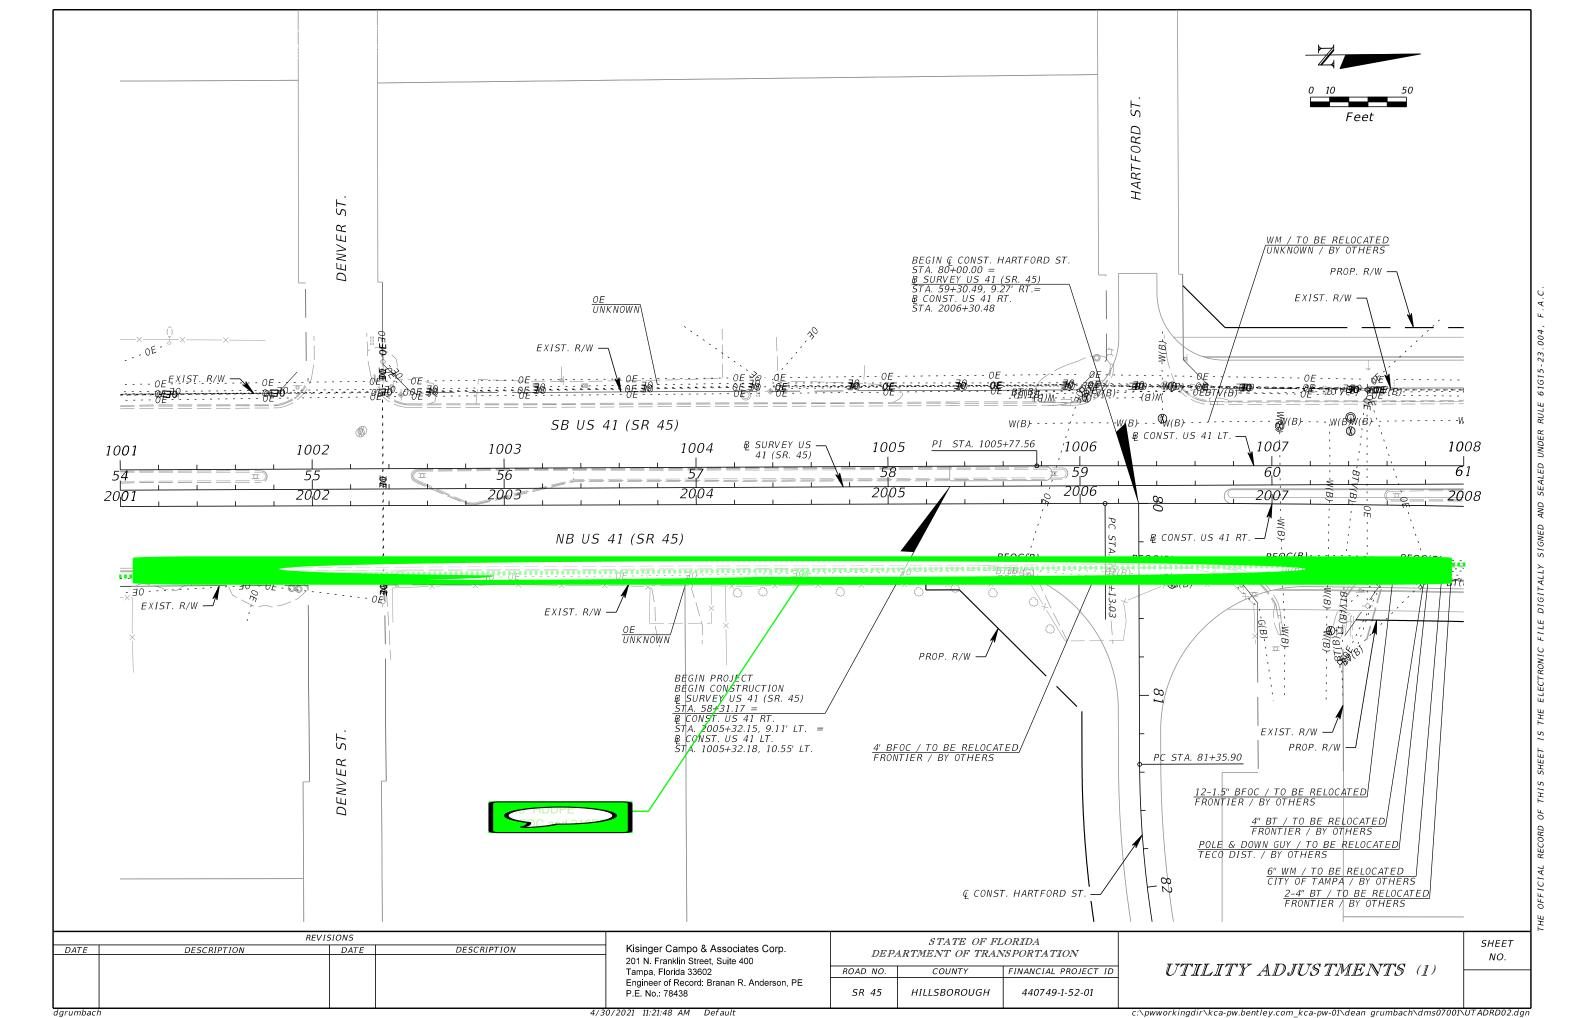


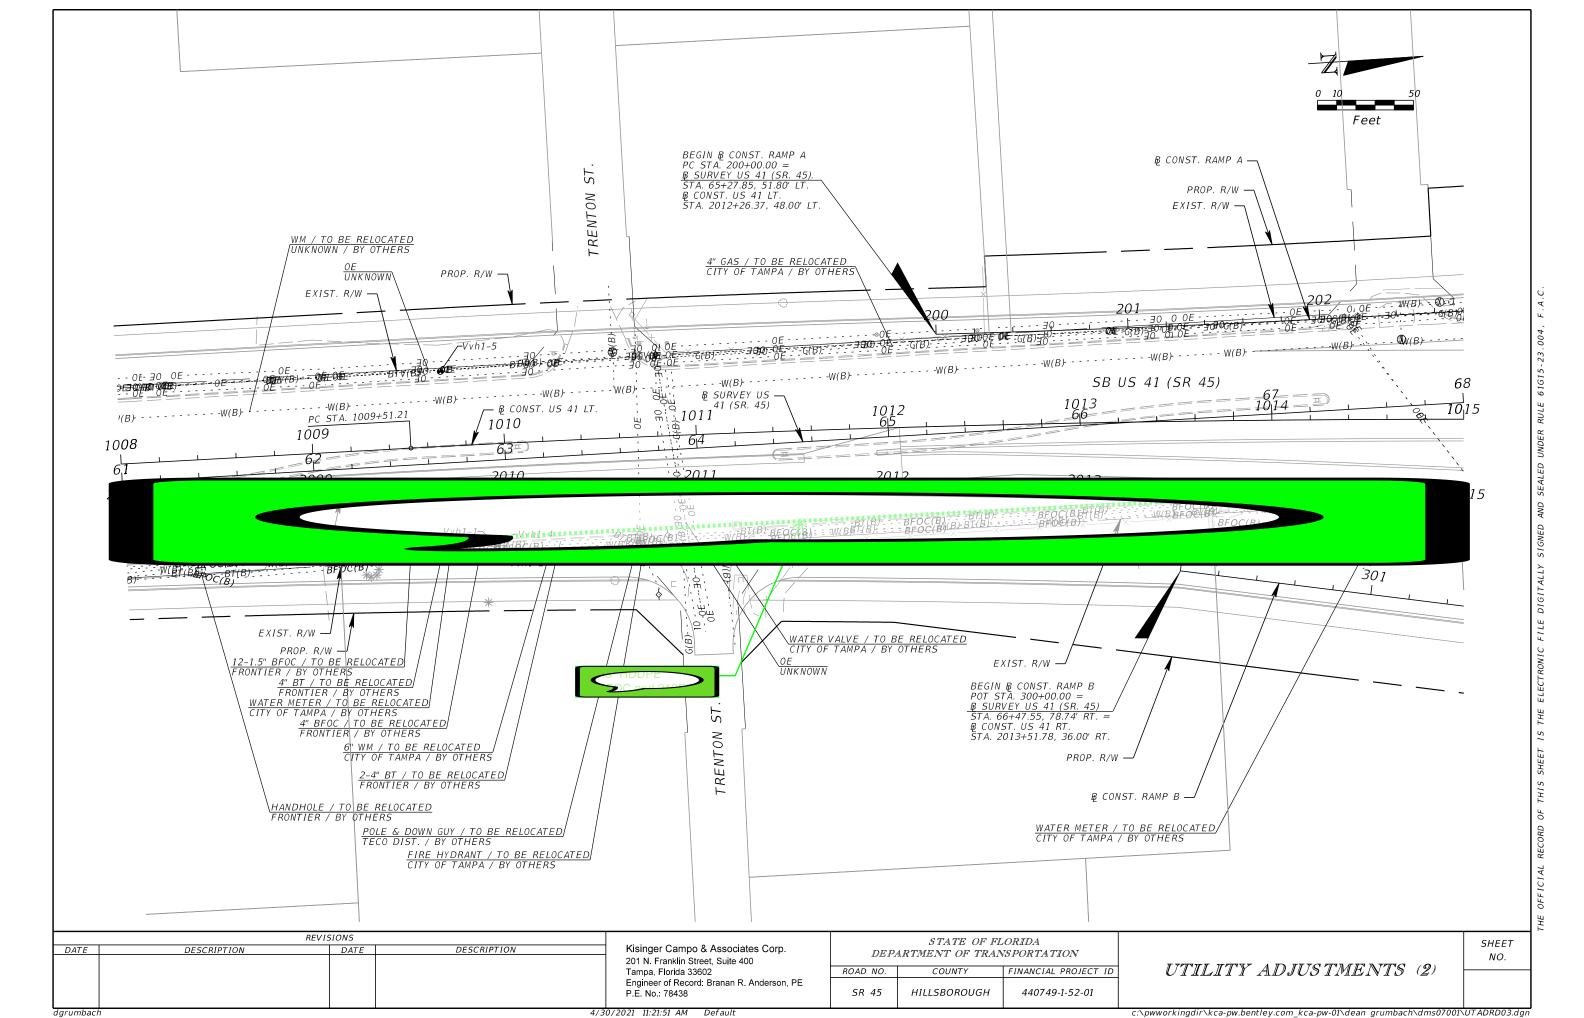


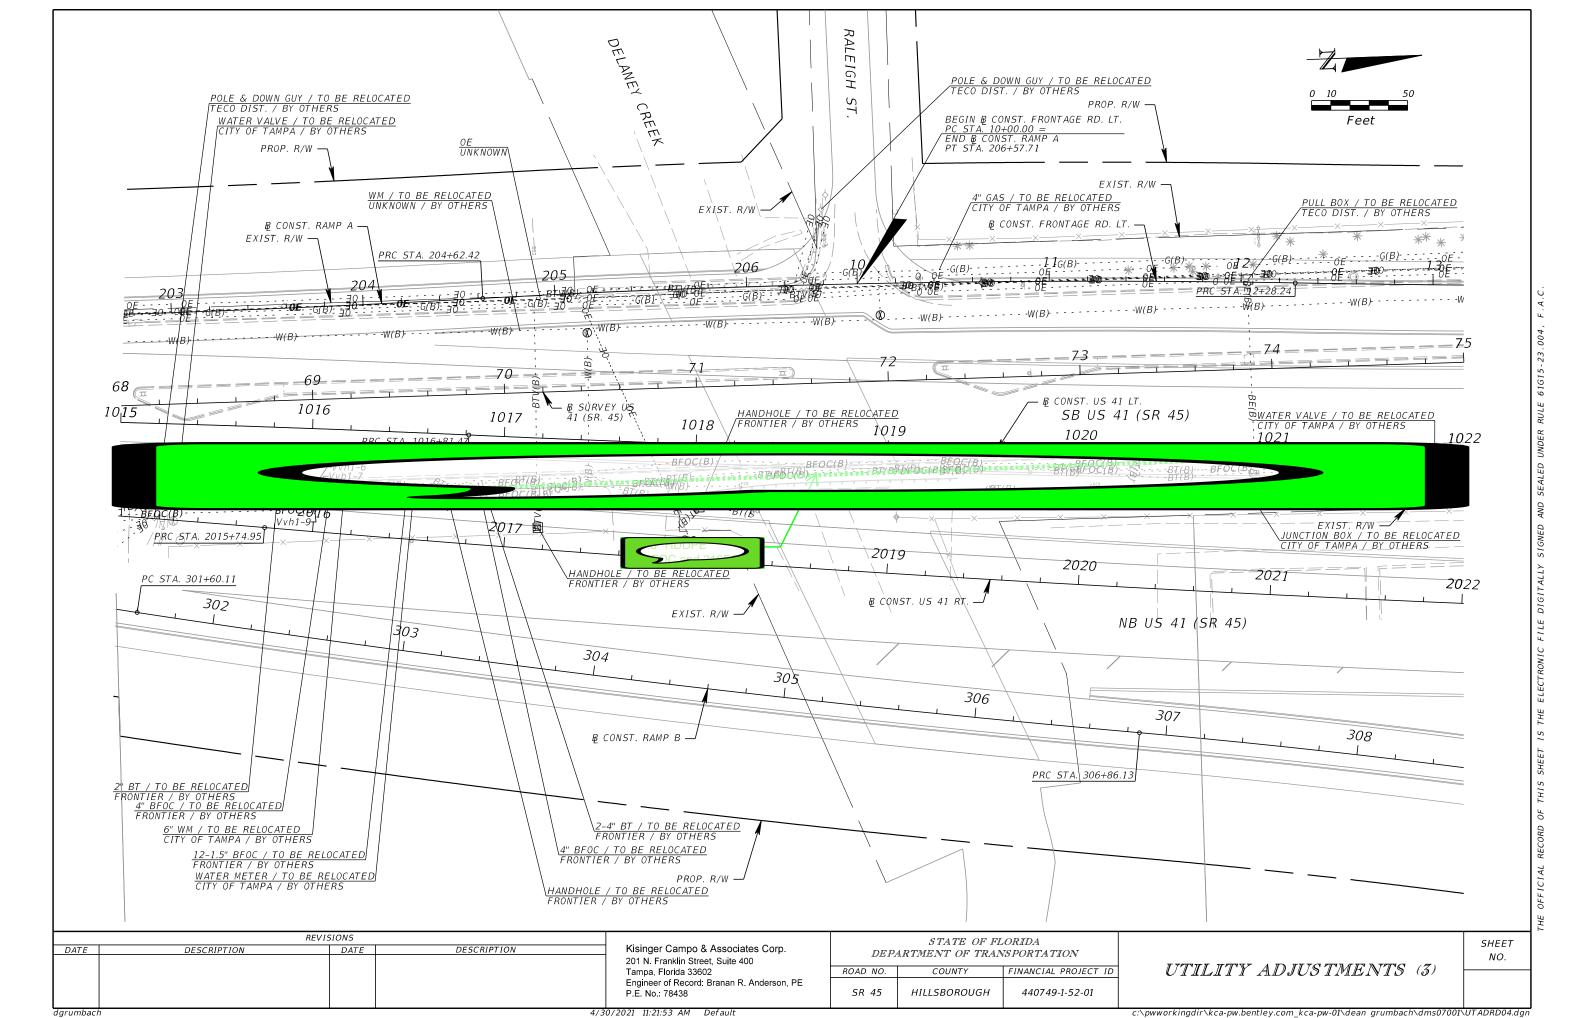


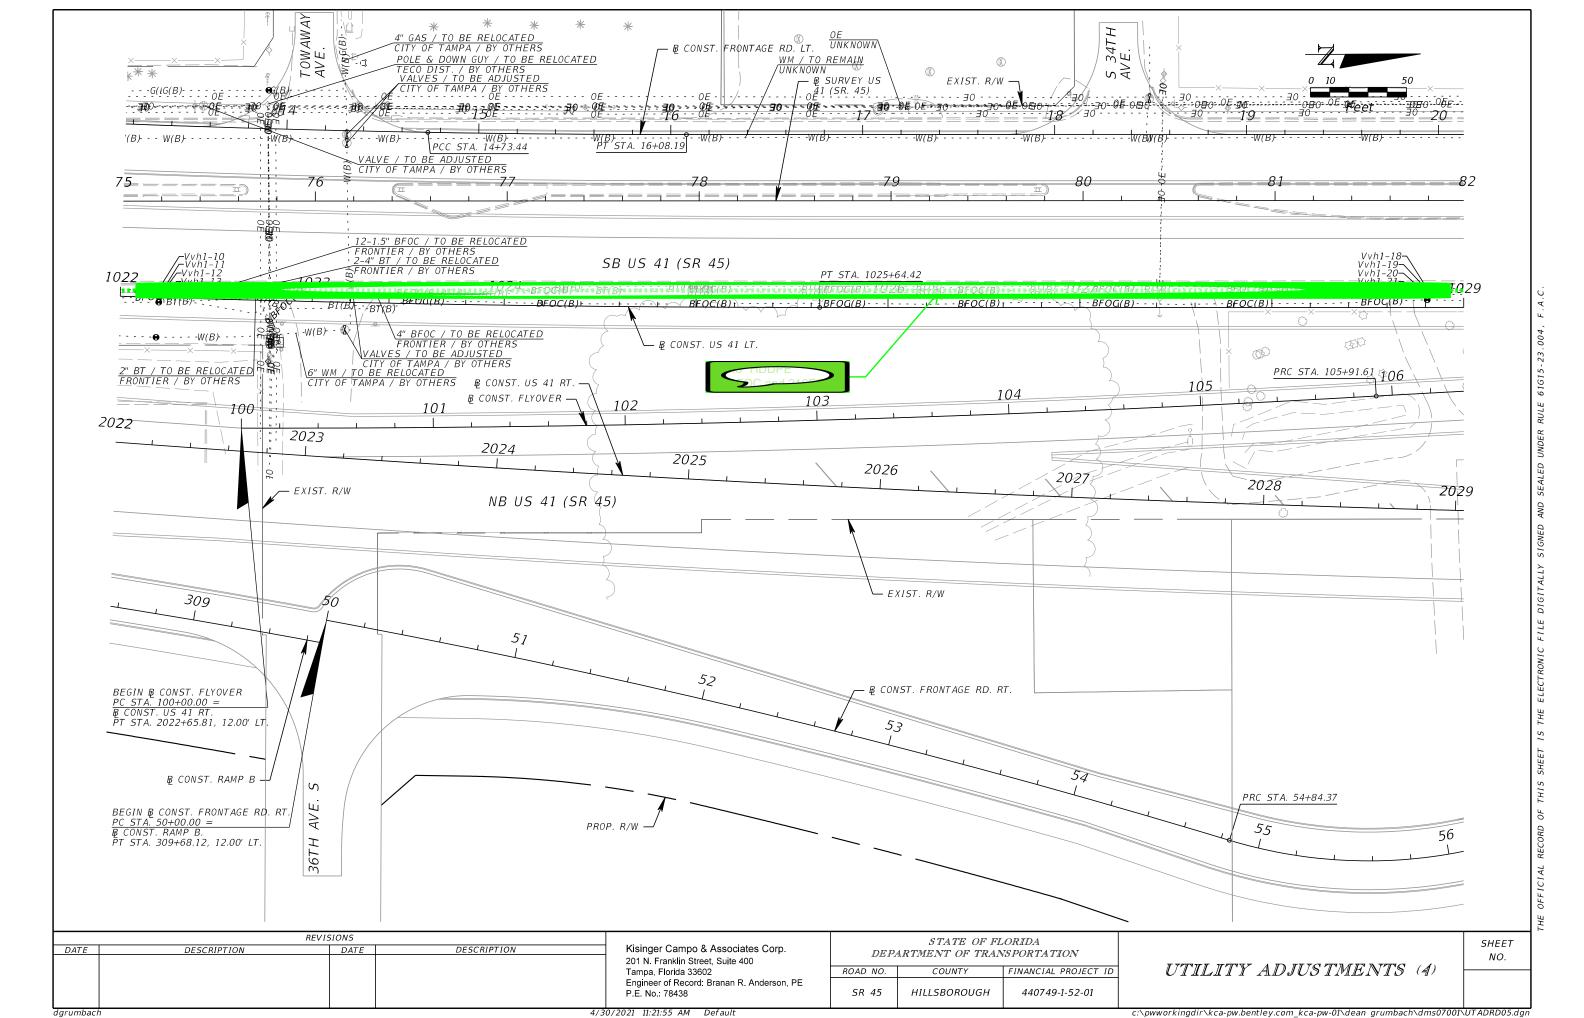


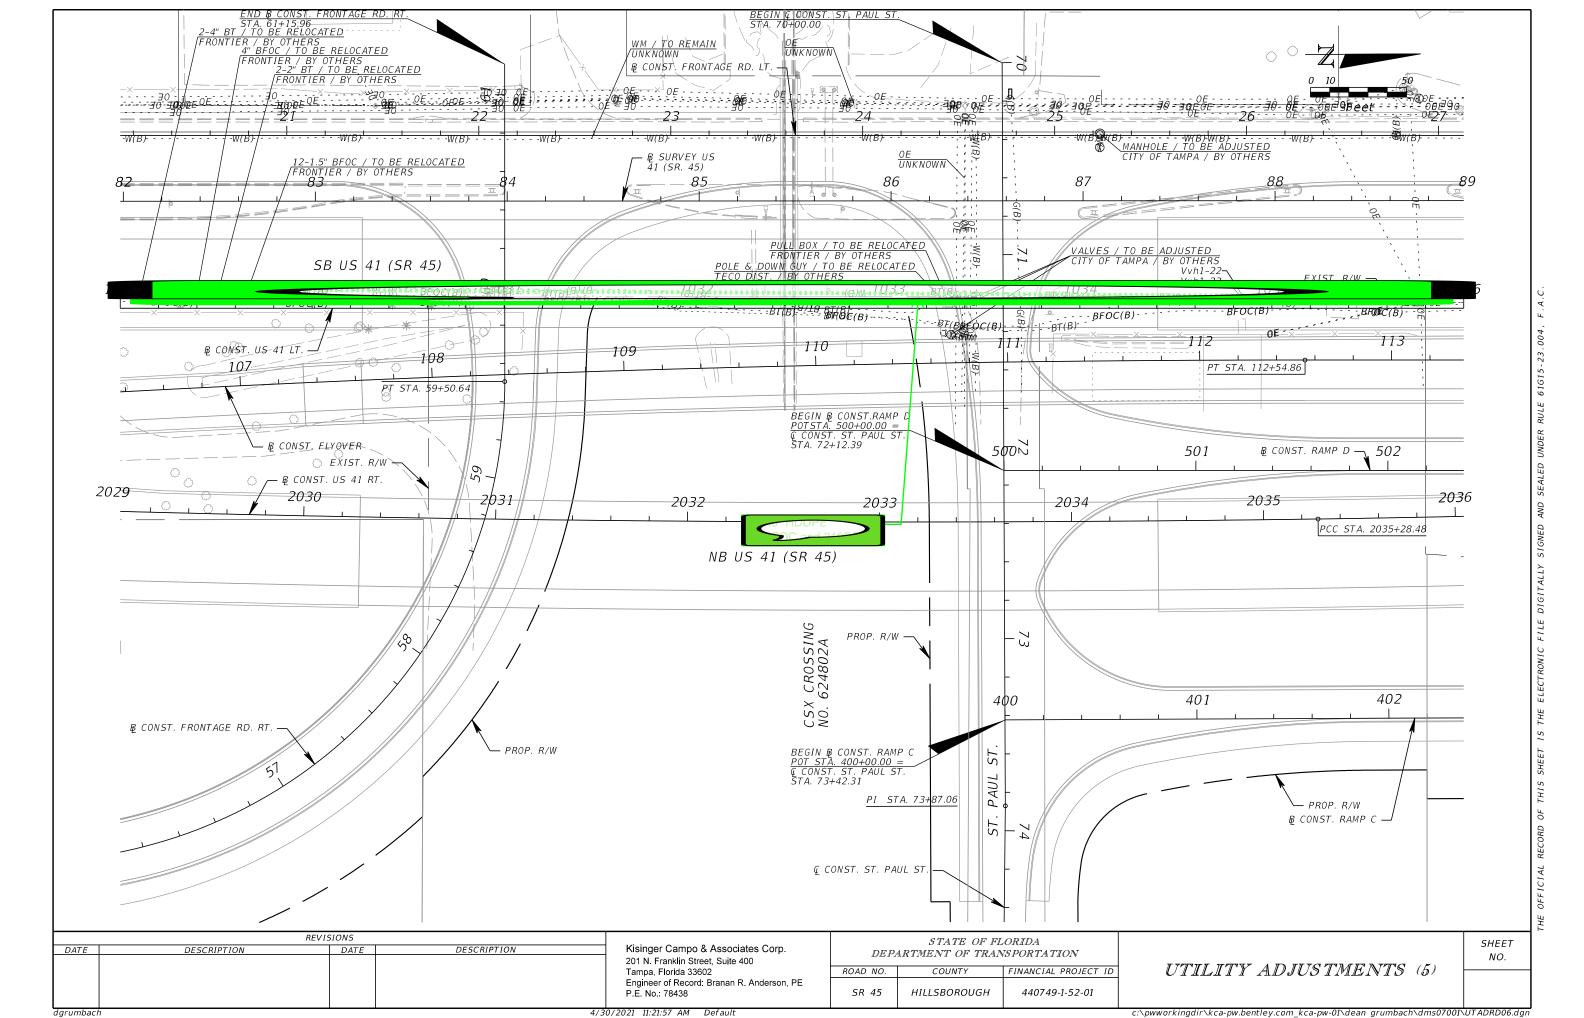


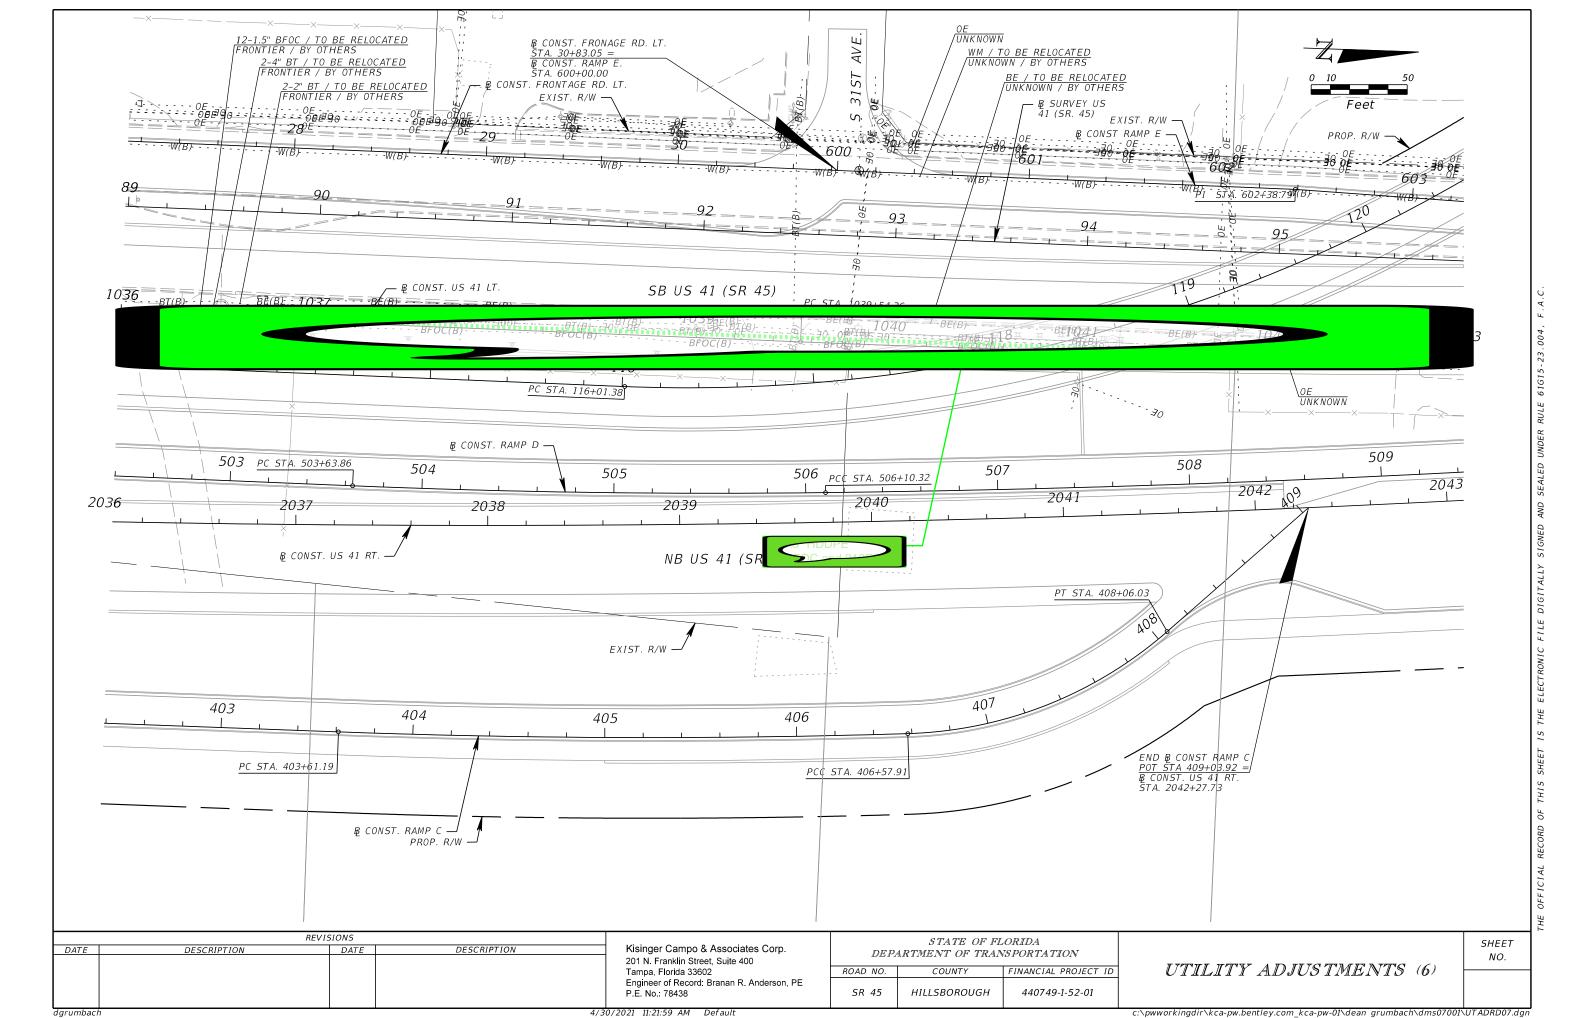


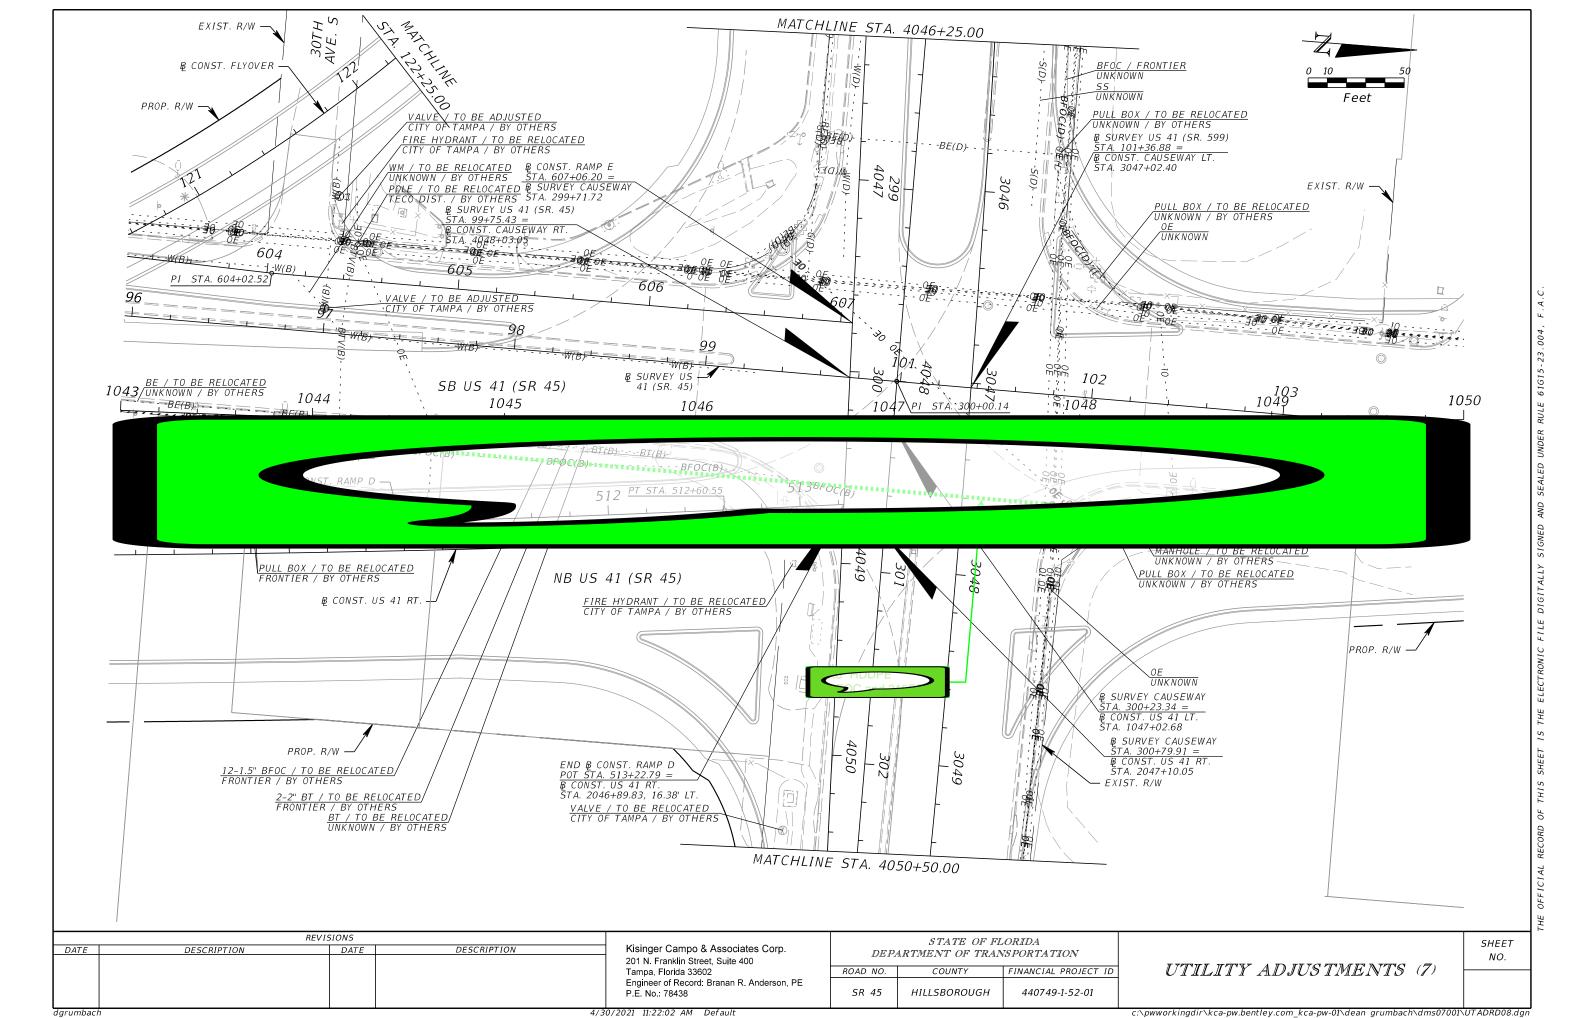


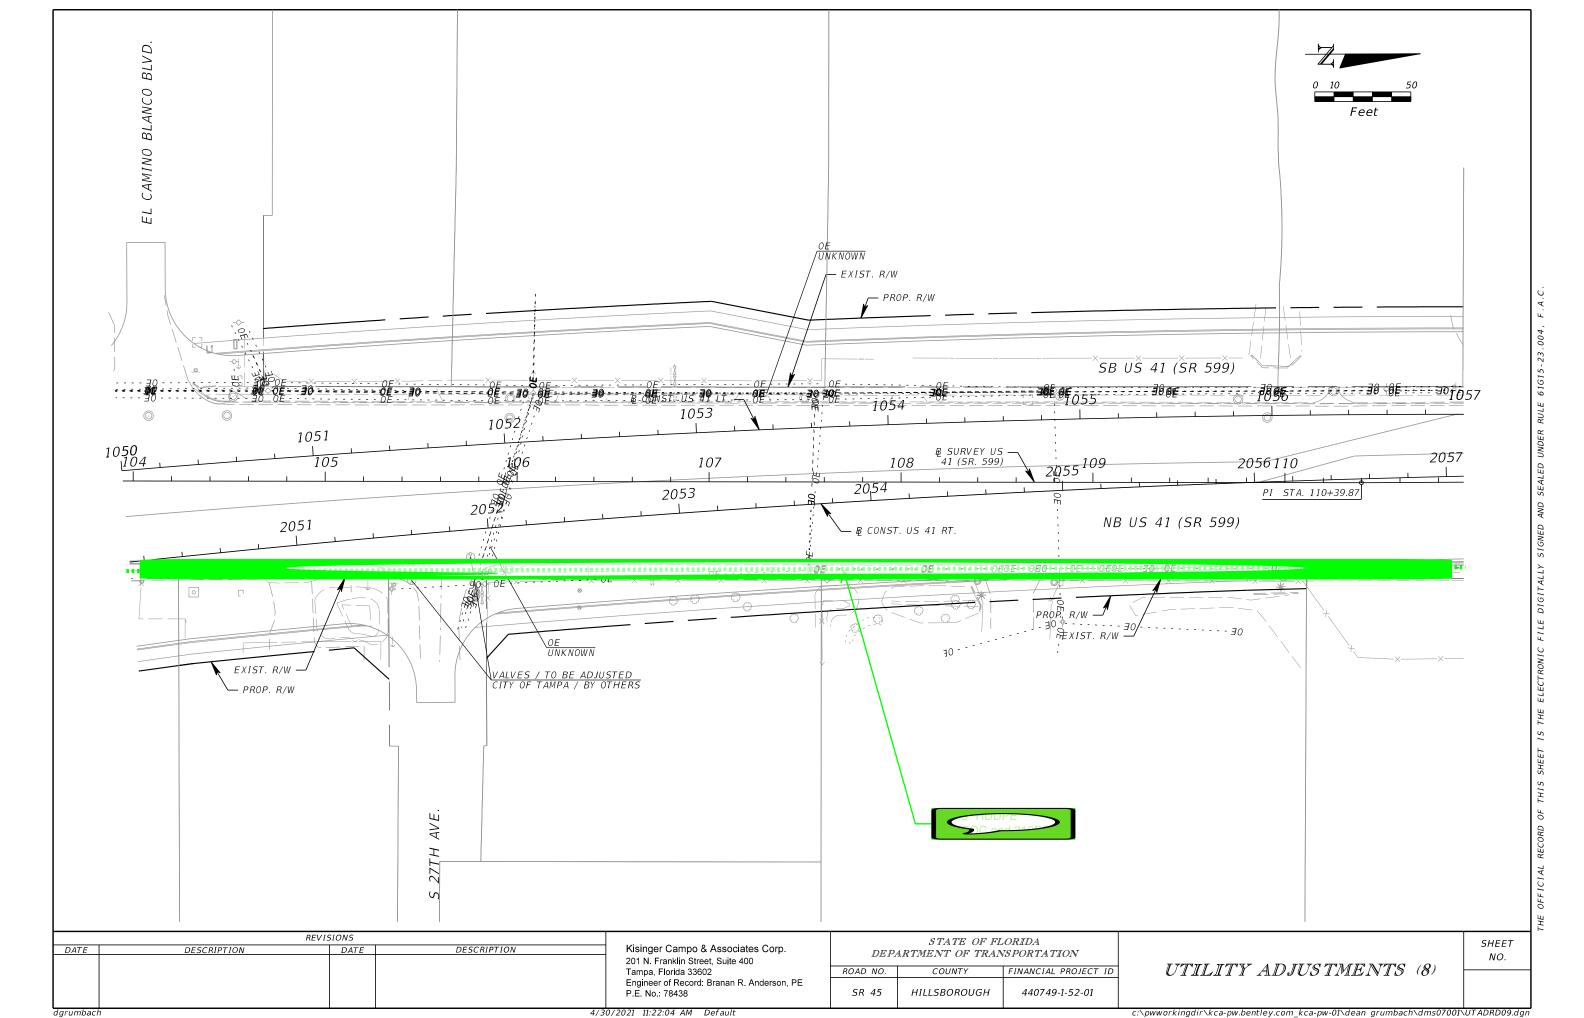


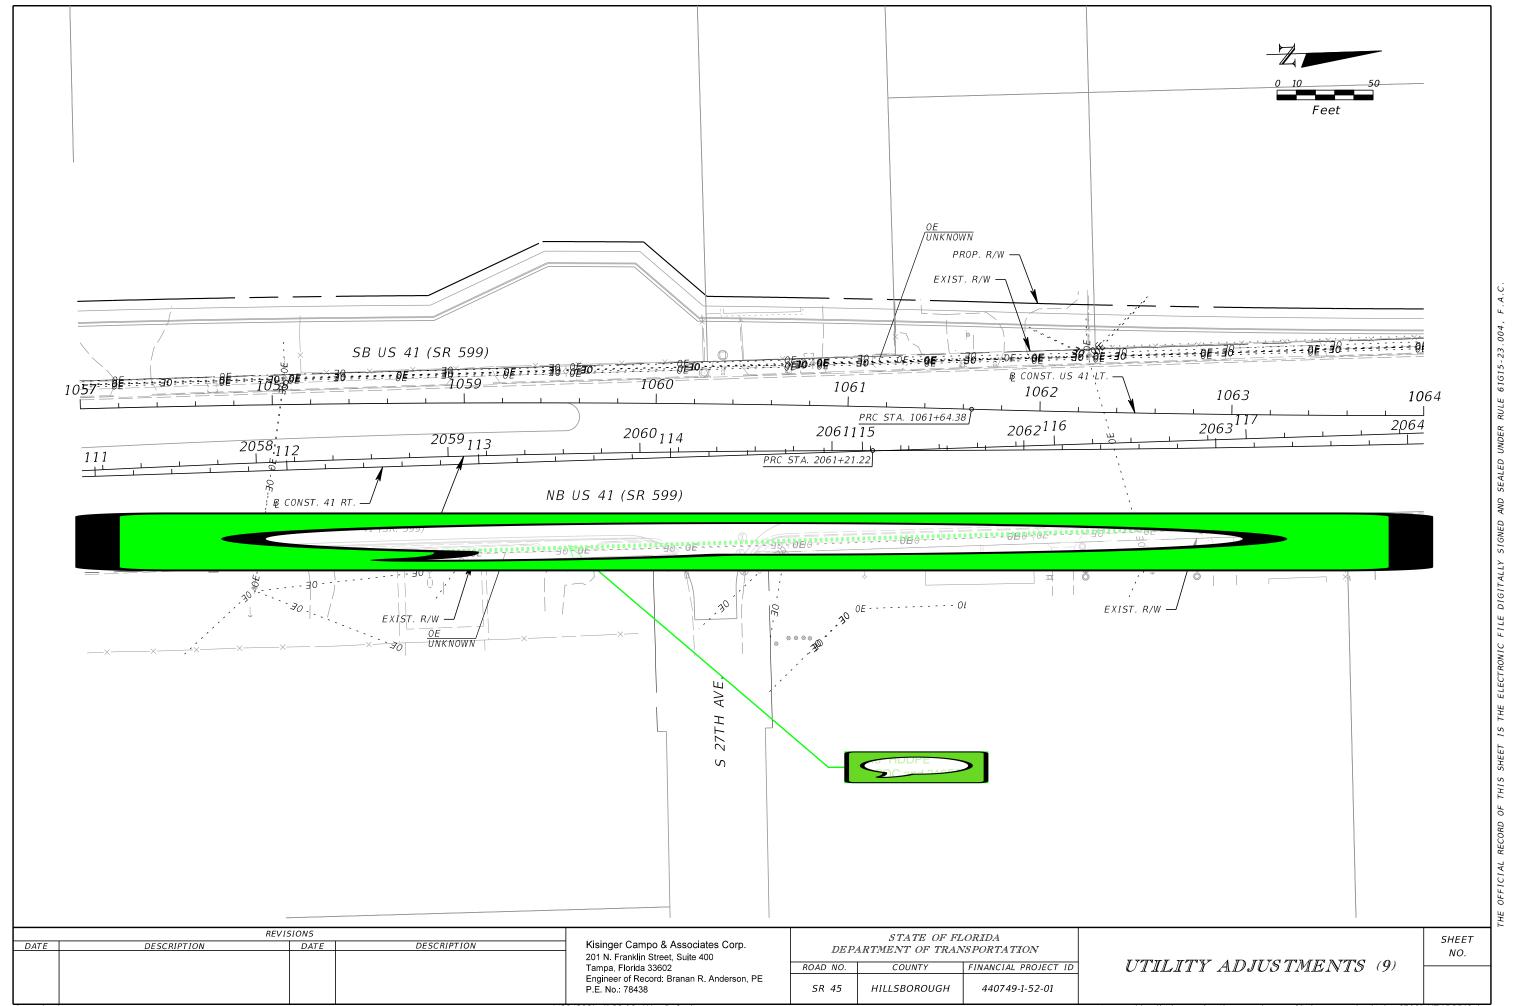


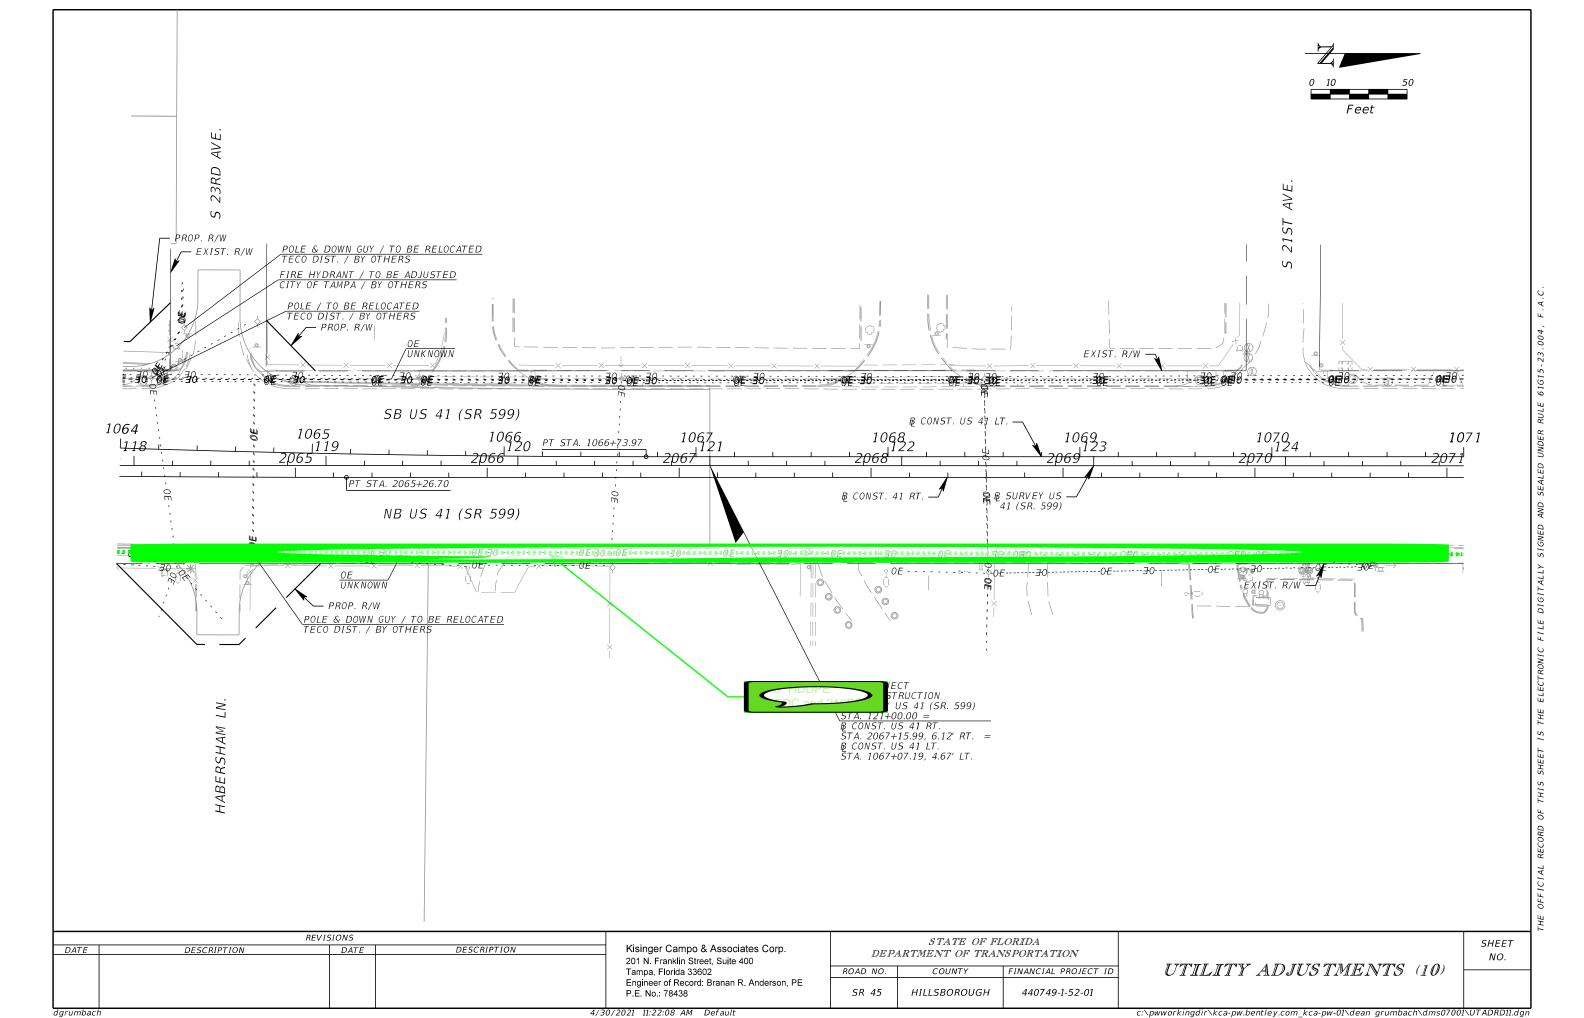


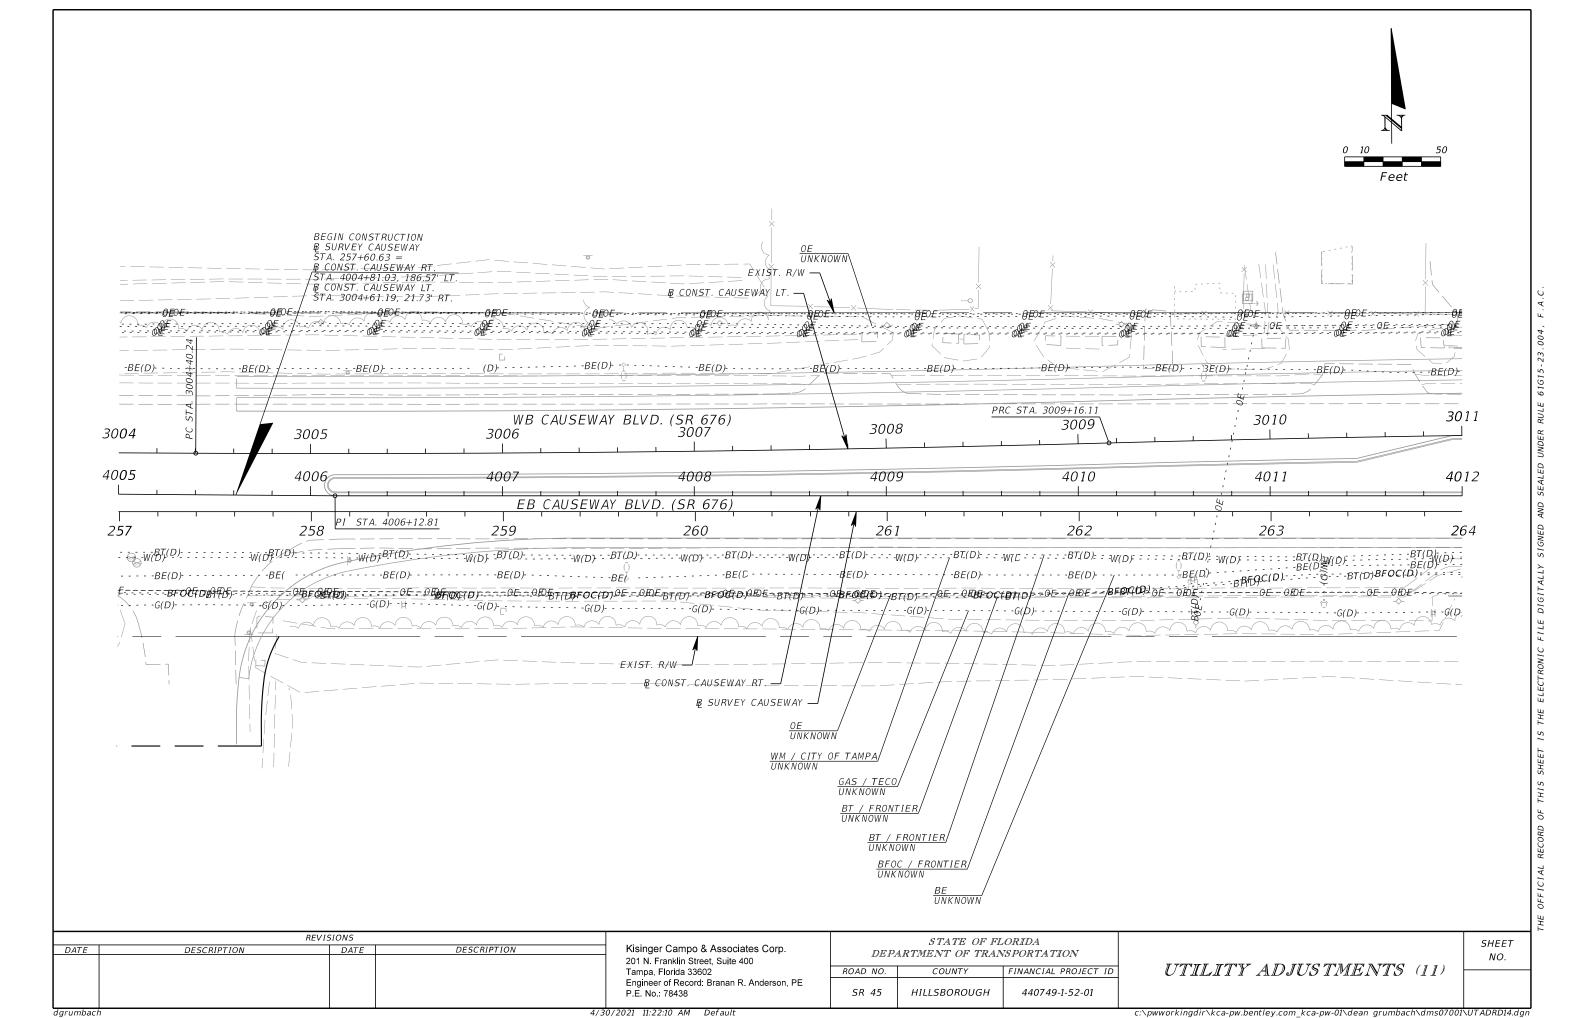


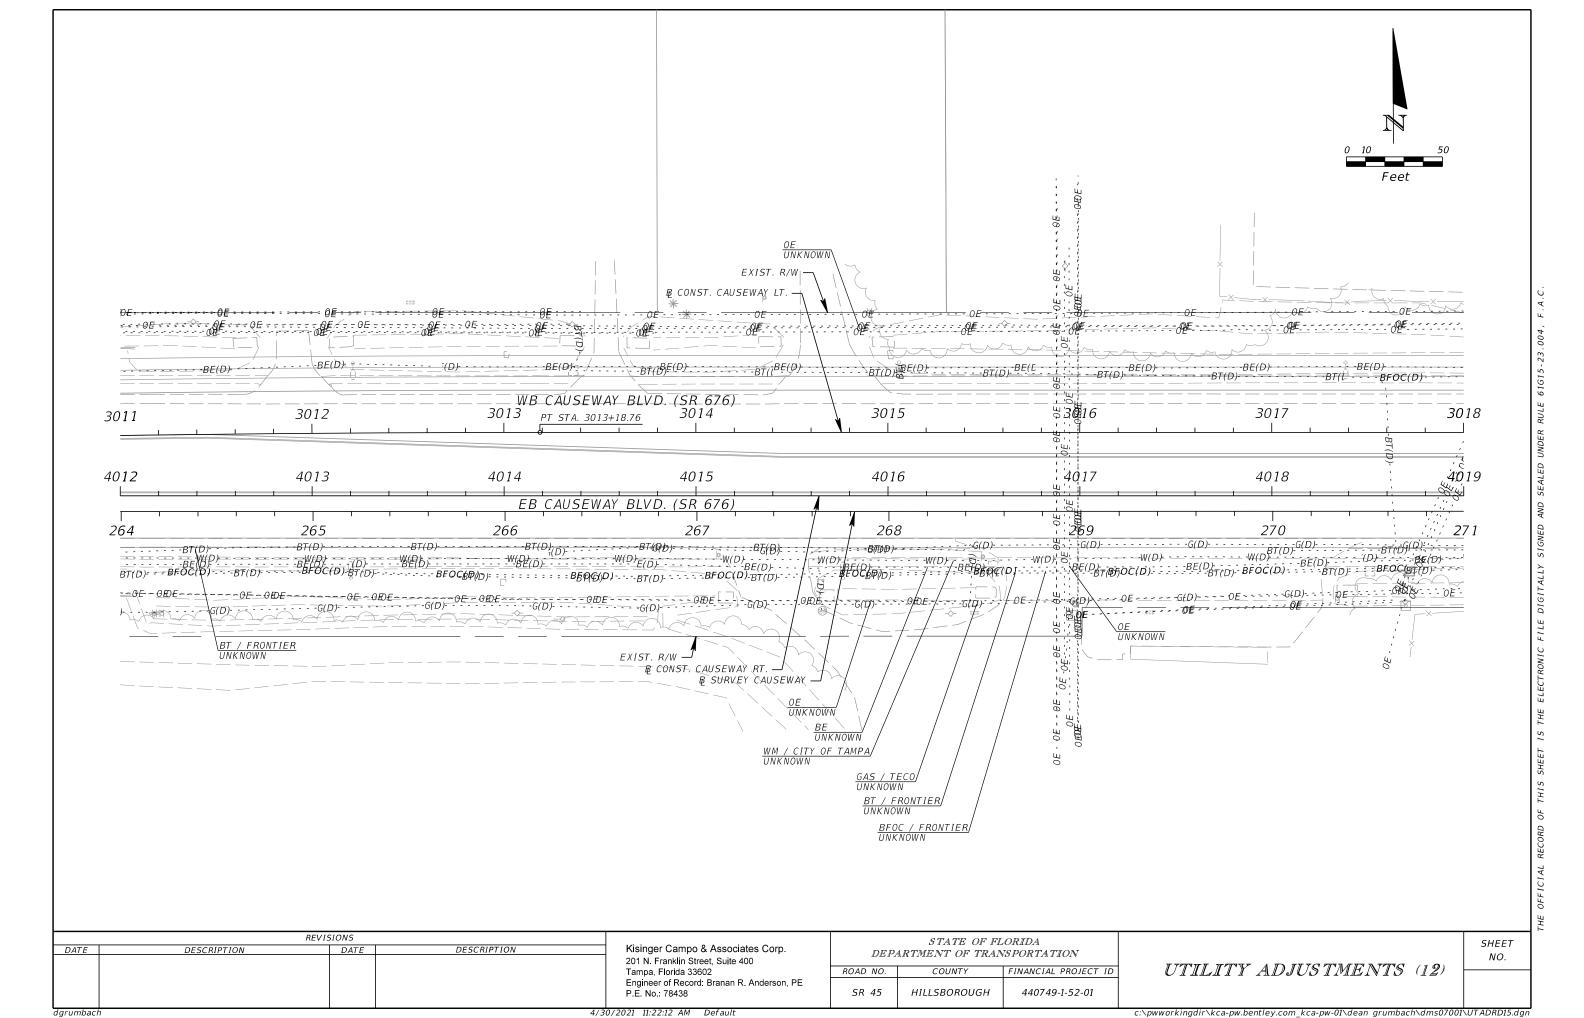


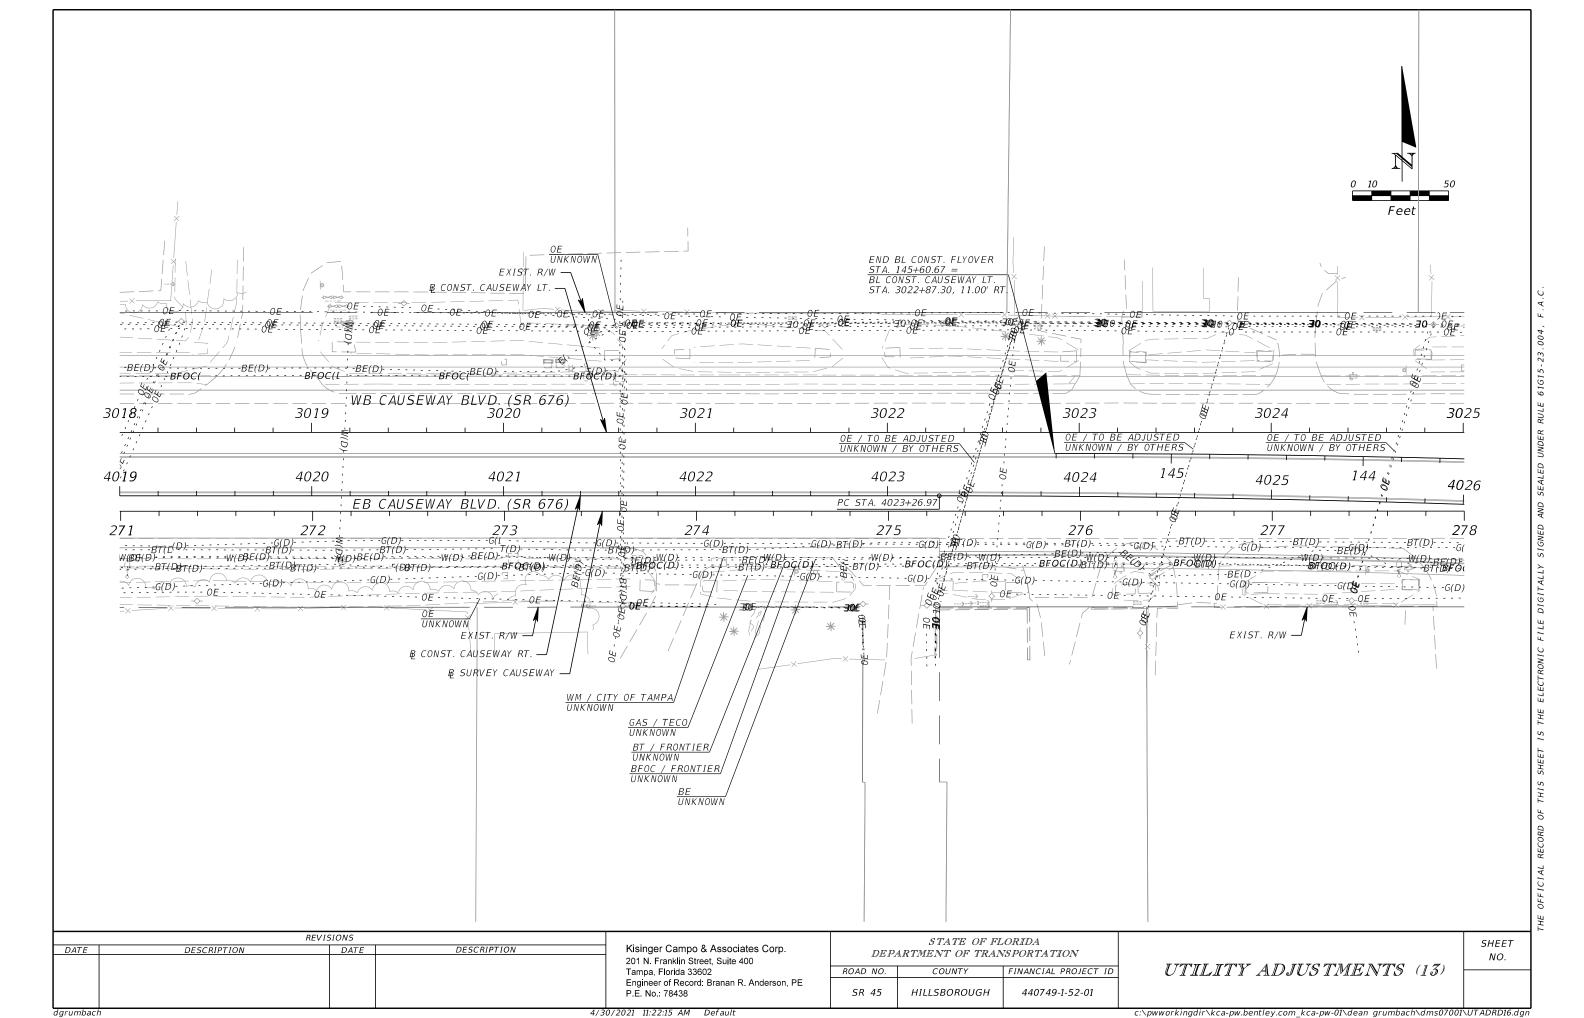


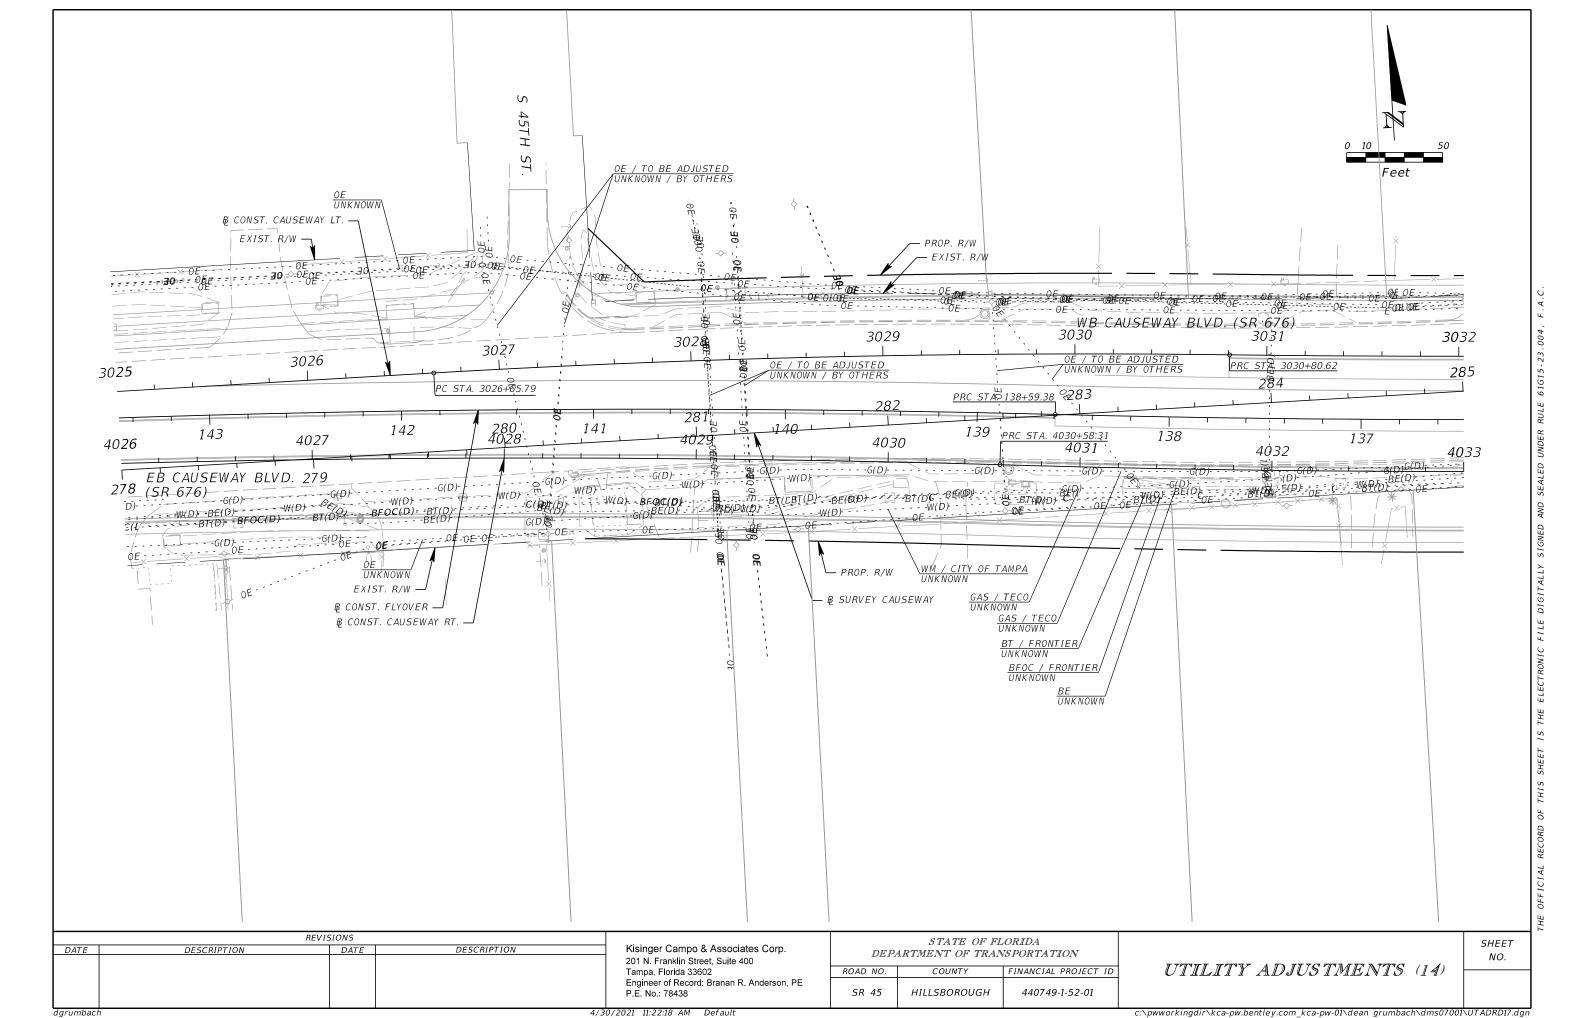

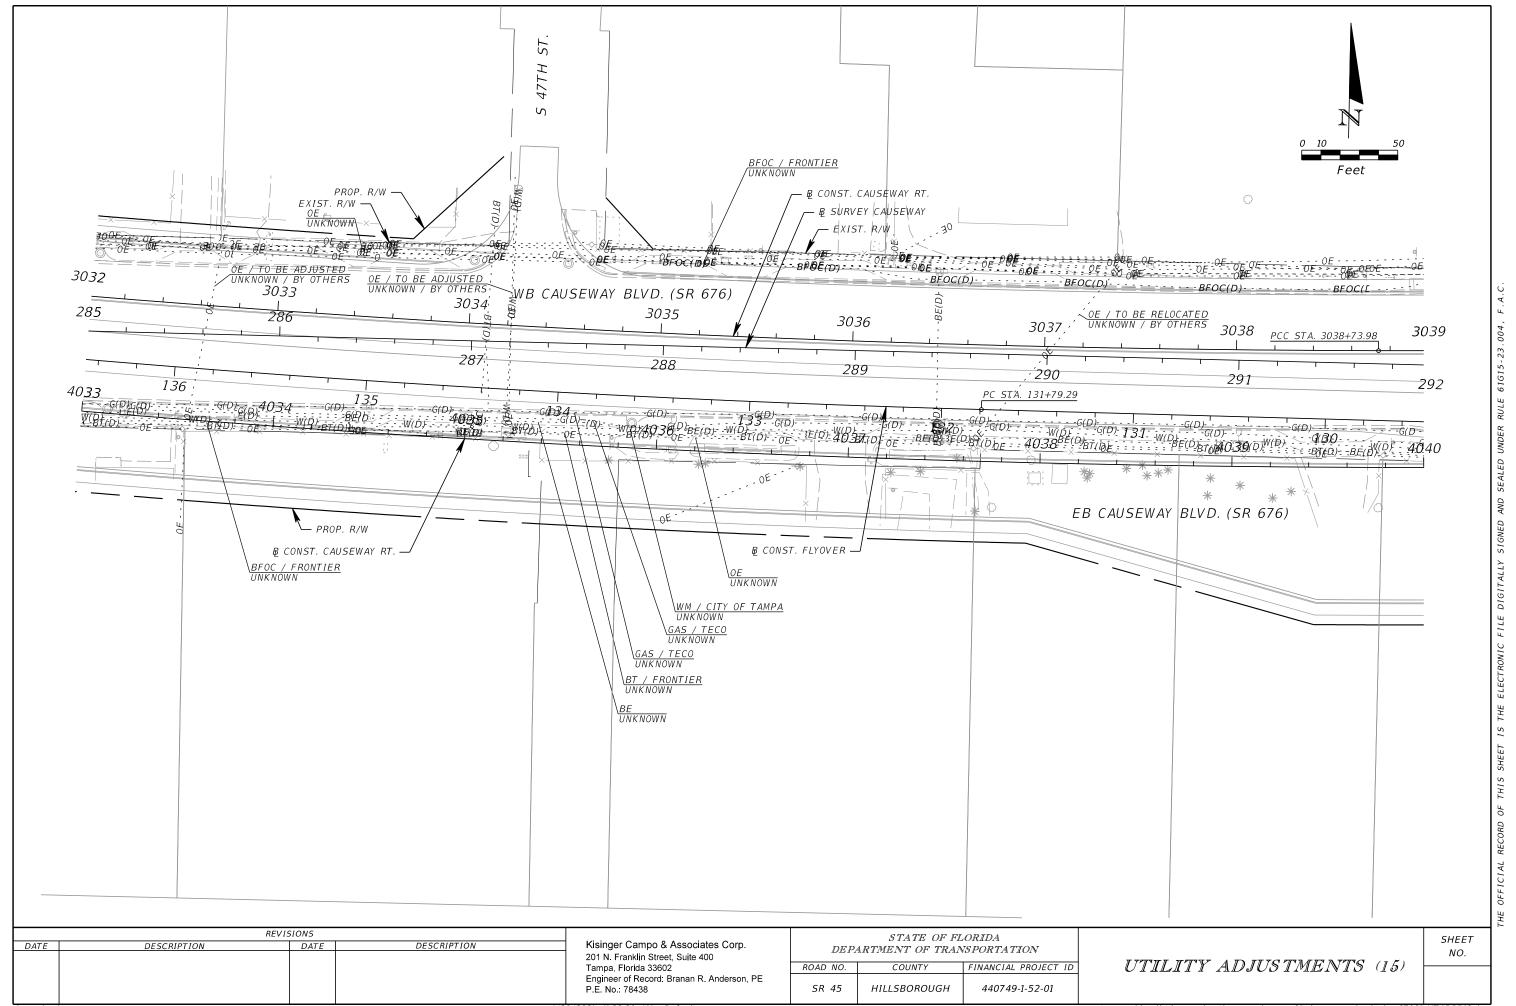

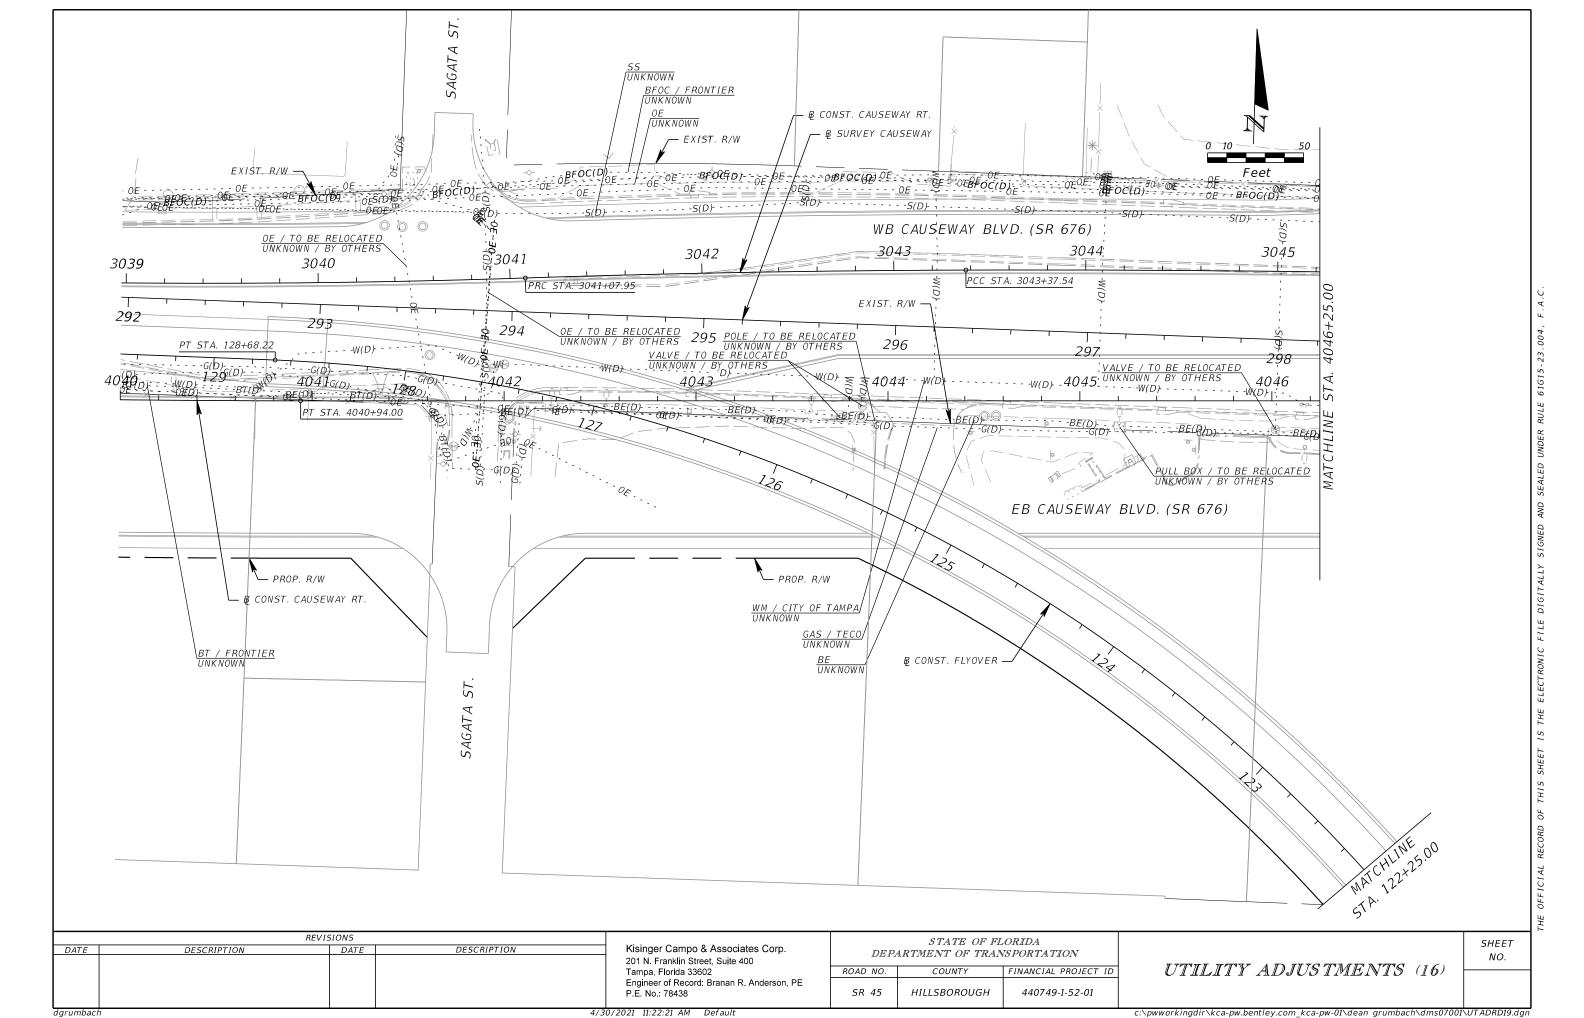

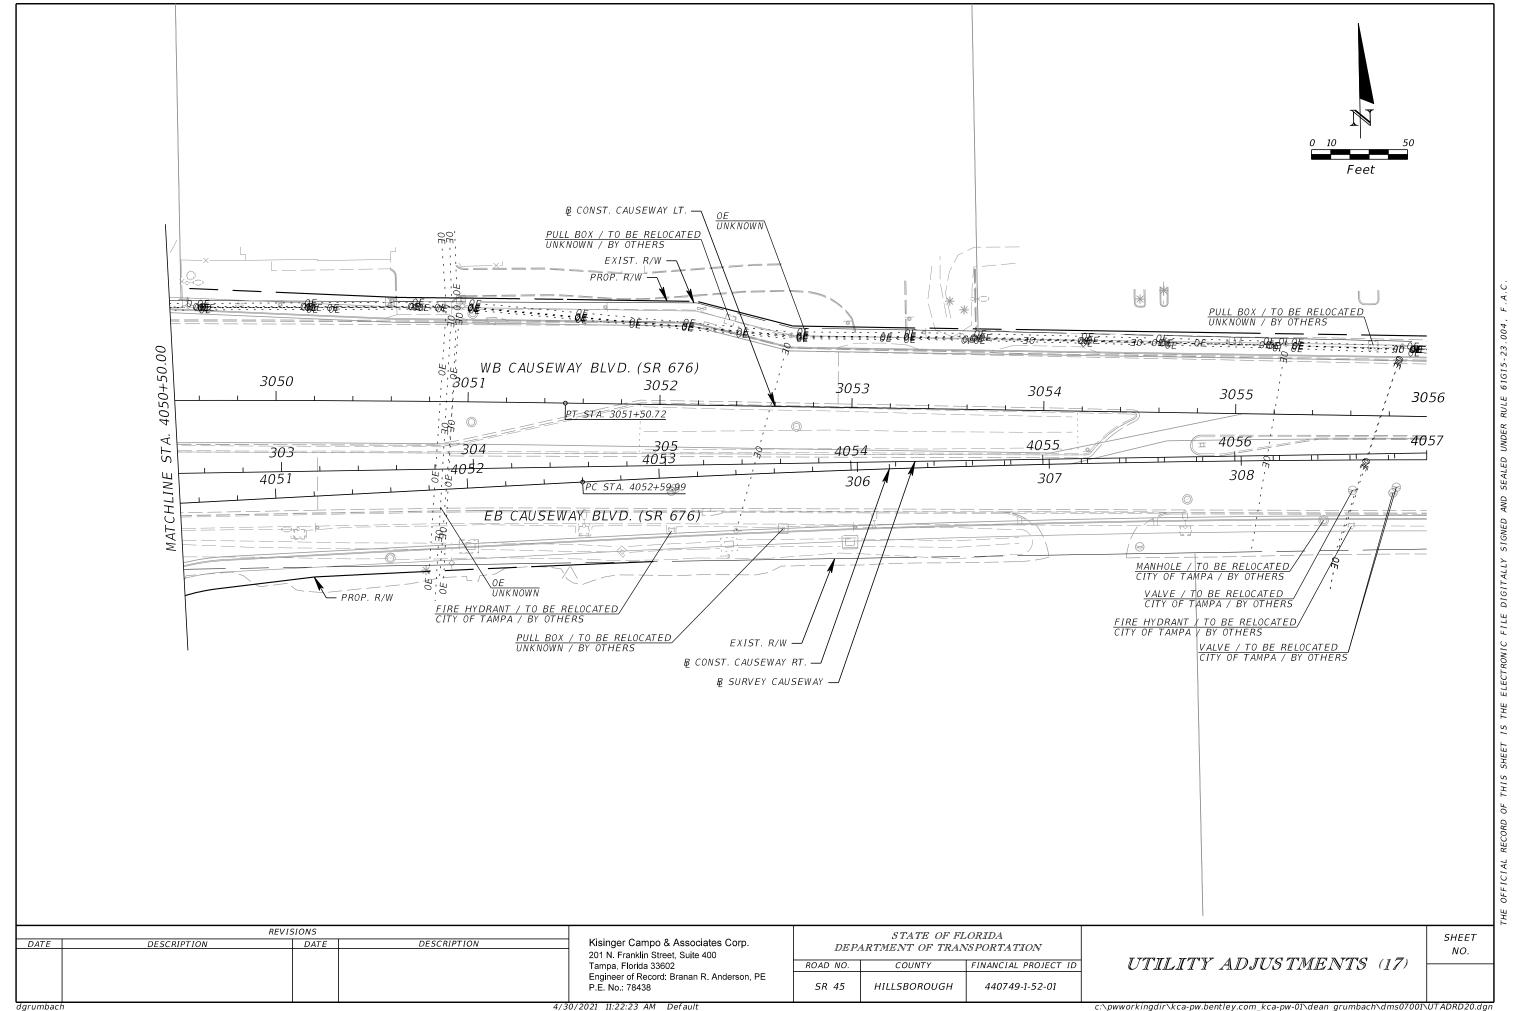

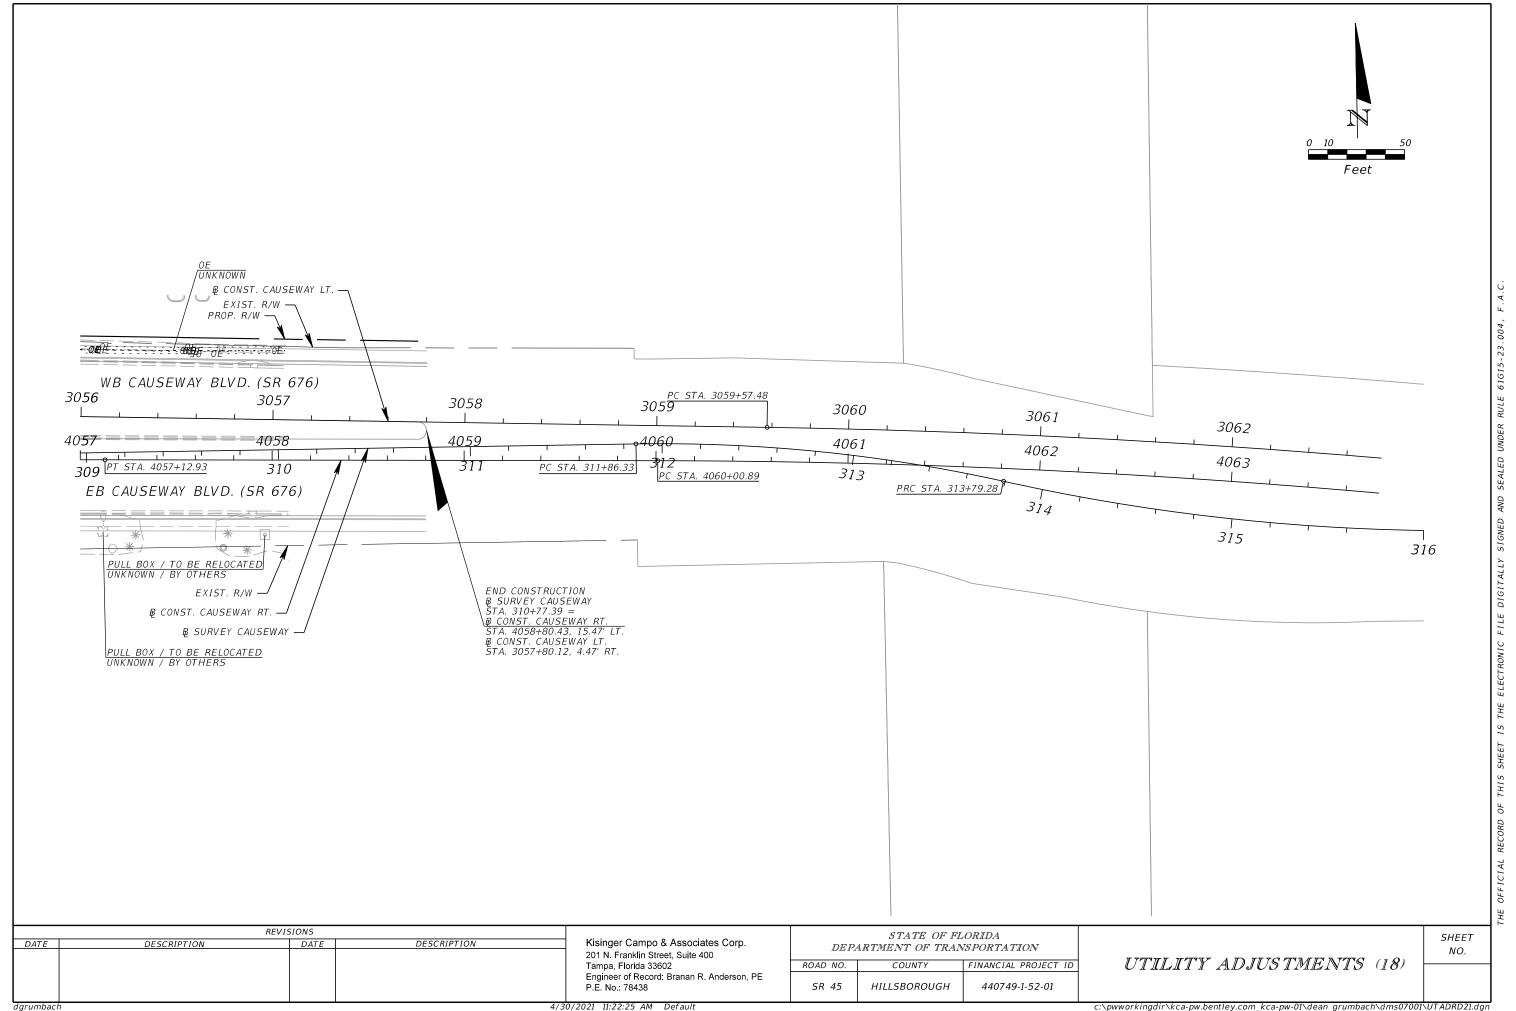

	Cre	w Memb	ers:	DW, TG					
	City	, State:		Tampa, Florida					
	Ger	neral Loca	ation:		US 41				
NCE-	Coc	ordinate (Unit of Meas	ure: U	S Survey Fee				
		Abbrev	riations	Offset Mea	sured From:				
	N/A	= Not Appl	icable	EP= Edge of Pav	vement				
HOLE"	NAD	= North A	merican	BC = Back of Cu	rb				
	Datu	ım		BL = Baseline of	Survey				
	NAV	D = North	American	COORD = Surve	y Coordinates				
	Vert	ical Datum		CL = Centerline					
	UNK	= Unknow	m	HUB = Survey H	ub				
	COT	= City of T	ampa	RW = Right of W	/ay				
				ST = Swing Ties					
				X = "X" in Concr	ete				
	Hori	zontal:	NAD83/11						
	Vert	ical:	NAVD88	Ground	Utility				
ng		Е	asting	Elevation	Elevation				
4.90'			6413.67'	7.51'	4.25'				
5.19'		526	416.74"	7.48'	4.18'				
4.95'		526	415.25'	7.48'	5.01'				
5.12'		526	418.96'	7.36'	-1.44'				
1.11'		526	321.06'	6.85'	1.31'				
1.38'		526	417.02	6.84'	3.40'				
1.47'		526	6418.97"	6.84'	4.42'				
0.12'		526	422.34'	6.83'	-3.23'				
0.56'		526	424.00'	6.49'	3.15'				
		_							
		Prepared L	by: EE	Date: 02/12/20	019				
		i e							

Truck No.:		ול ד/כם			nter Springs, Florida 32708 UTILITY ENGINEERING & SURVEY				- GROW, INSPIRE, MAKE A DIFFERENCE-		Coordinate Unit of Meas	ure: US Survey Fee		
	U	Itility Type	e				y Material			Identif	fied By:	Abbreviations	Offset Mea	sured Fror
BE = Buried Electrical RW = Reclaimed Water			AC = Transite		FIBG = Fiberg	lass		HUB = Survey Hub		N/A = Not Applicable	EP= Edge of Pavement			
GM = Gas Main SL = Street Light (CI= Cast Iron		HDPE = High	HDPE = High Density Polyethylene Pipe			"ECHO TEST HOLE"	NAD = North American	BC = Back of Cu	rb		
BT = Buried	Telephone	TS = Traffic	Signal		CP = Concrete f	Pipe	PE = Polyethy	ylene Pipe		NL = Nail & Disk "EC	HO TEST HOLE"	Datum	BL = Baseline of	Survey
OC = Fiber (Optic Cable	FL = Fuel Lir	ne		DBC = Direct Bu	ıried Cable	PVC = Polyvir	nyl Chloride		SLEEVE = Sleeve		NAVD = North American	COORD = Surve	y Coordinat
VM = Water	r Main	GS = Gas Se	rvice		CMP = Corruga	ted Metal Pipe	STL = Steel			X = "X" in Concrete		Vertical Datum	CL = Centerline	
SAN = Sanita	ıry Sewer	WS = Water	r Service		CONC = Concre	te	VCP = Vitrifie	d Clay Pipe		Surfac	е Туре	UNK = Unknown	HUB = Survey H	ub
TM = Storm	1 Sewer	UNK = Unkr	nown Utility		CPP = Corrugat	ed Plastic Pipe	PCCP = Prest	ressed Cylinde	r Concrete	ASPH = Asphalt		COT = City of Tampa	RW = Right of V	Vay
CATV = Cable	e Television	BED = Burie	d Electrical C	Duct	DCT = Duct		Pipe			CONC = Concrete			ST = Swing Ties	
M = Force N	Main	BTD = Burie	d Telephone	Duct	DIP = Ductile Ire	on Pipe	RCP = Reinfo	rced Concrete	Pipe	NG = Natural Groun	d		X = "X" in Concr	ete
Test Hole	Utility Type	Utility Material	Utility Size Outside Diameter	Utility Manual Depth	Cross Sectional View	***	Identified By	Surface Type	Surface Thickness inches	Apparent Utility Owner	Datums:	Horizontal: NAD83/11 Vertical: NAVD88	Constraint	Utility Elevation
			inches	feet		Utility Direction			IIICIICS		Northing	Easting		
1-1	вт	PVC	2 - 4"	3.26'	00	<u></u>	IRC	NG	N/A	FRONTIER	1301204.90'	526413.67	7.51'	4.25'
1-2	WM	CI	6"	3.30'		<u></u>	IRC	NG	N/A	сот	1301205.19	526416.74'	7.48'	4.18'
1-3	FOC/BT	PVC	4"	2.47'	\circ		IRC	NG	N/A	FRONTIER	1301204.95'	526415.25'	7.48'	5.01'
1-4	FOC	PE	12 - 1.5"	8.80'	08888c	<u></u>	IRC	NG	N/A	FRONTIER	1301205.12'	526418.96'	7.36'	-1.44
1-5	CATV	PVC	2 - 2"	5.54'	00	\$	IRC	NG	N/A	SPECTRUM	1301181.11'	526321.06'	6.85'	1.31
1-6	вт	PVC	2 - 4"	3.44'		‡	IRC	NG	N/A	FRONTIER	1301811.38'	526417.02'	6.84'	3.40'
1-7	FOC/BT	PVC	4"	2.42'			IRC	NG	N/A	FRONTIER	1301811.47	526418.97"	6.84'	4.42'
1-8	WM	UNK	UNK	10.06'		\$	IRC	NG	N/A	сот	1301810.12'	526422.34'	6.83'	-3.23
1-9	FOC/BT	PVC	4"	3.34'	0	‡	IRC	NG	N/A	FRONTIER	1301810.56'	526424.00'	6.49'	3.15
Votes:	1-8 - Unable	to visually ve	erify size and	matterial du	ue to depth and p	groundwater. Possi	ble 6 [™] cast iroi	n.						
												Prepared by: EE	Date: 02/12/2	
												Checked by: AB	Date: 02/12/	2019
												•		
	REVISION:					1						T.		
	KEV ISION	>				1					OF FLORIDA			

Test Hole Data Report

ECHO UES, Inc. www.echoues.com

888.778.ECHO

SHEET

4/30/2021 11:22:27 AM Default

Tampa, Florida 33602
Engineer of Record: Branan R. Anderson, PE
P.E. No.: 78438

ROAD NO.

SR 45

COUNTY

HILLSBOROUGH

FINANCIAL PROJECT ID

440749-1-52-01

UTILITY ADJUSTMENTS (19)

Date:

dgrumbach

ECHO Project #:

Financial Project #:

12/04/2018

18-252

N/A

16514 N. Dale Mabry Hwy.

Tampa, Florida 33618

1511 E. SR434, Ste. 2001, #252

Date:		12/05/2018 Test Hole Data Report							Crew Members: DW, To					
			18-252		5514 N. Dale Ma	ibry Hwy.		FCHO UES, Inc.			City, State: Tampa, Fl			
Financial Project #: N/A			Tampa, Florida	33618	 			www.echoues.com		General Location:		US 41		
•				1511	L E. SR434, Ste.					888.778				
Truck No.:			D-3/T-2	Win	ter Springs, Flo	1108 32700	UTILITY ENG	INEERING &	SURVEY	- GROW, INSPIRE, MA		Coordinate Unit of Meas	•	S Survey Feet
		Itility Type				Utilit	y Material			Identifi	ed By:	Abbreviations		sured From:
BE = Buried		RW = Reclai			AC = Transite		FIBG = Fiberg			HUB = Survey Hub		N/A = Not Applicable	EP= Edge of Pav	
GM = Gas M		SL = Street I	_		CI= Cast Iron		HDPE = High Density Polyethylene Pipe						BC = Back of Cu	
BT = Buried		TS = Traffic			CP = Concrete P					NL = Nail & Disk "ECH	IO TEST HOLE"	Datum	BL = Baseline of	
FOC = Fiber		FL = Fuel Lir GS = Gas Se			DBC = Direct Bu		PVC = Polyvin	iyi Chloride		SLEEVE = Sleeve X = "X" in Concrete		NAVD = North American Vertical Datum	COORD = Surve CL = Centerline	y Coordinates
WM = Wate SAN = Sanita		WS = Water			CMP = Corrugat CONC = Concret		STL = Steel VCP = Vitrifie	d Clay Dina		Surface	Tuno	UNK = Unknown	HUB = Survey H	uh
SAN = Sanita STM = Storn		UNK = Unkr			CPP = Corrugate		1		r Constato	ASPH = Asphalt	: туре	COT = City of Tampa	RW = Right of W	
CATV = Cabl			d Electrical D	ouct	DCT = Duct	ed Flastic Fipe	Pipe Presti	ressed Cylinde	r concrete	CONC = Concrete		cor – city or rampa	ST = Swing Ties	vuy
FM = Force I			d Telephone		DIP = Ductile Iro	on Pipe		rced Concrete	Pipe	NG = Natural Ground			X = "X" in Concr	ete
			Utility Size	Utility		Ņ			Surface			Horizontal: NAD83/11		
Test Hole	Utility Type	Utility	Outside	Manual	Cross	+	Identified By	Surface Type	Thickness	Apparent Utility	Datums:	Vertical: NAVD88	Ground	Utility
reserrore	Culty Type	Material	Diameter	Depth	Sectional View	¥↓¾ Utility Direction	raciiciica by	ouridee Type	inches	Owner	Northing	Easting	Elevation	Elevation
1-10	FOC	PE	inches 12 - 1.5"	feet 3.96'	0000 00000	A A	IRC	NG	N/A	FRONTIER	1302430.03	526421.52'	6.62'	2.66'
1-11	ВТ	PVC	2 - 4"	2.50'	00000	<u> </u>	IRC	NG	N/A	FRONTIER	1302430.50	526424.77'	6.68'	4.18'
1-12	FOC/BT	PVC	4"	1.90'		<u> </u>	IRC	NG	N/A	FRONTIER	1302430.47'	526425.15'	6.69'	4.79'
1-13	ВТ	DBC	2"	1.56'	0	<u> </u>	IRC	NG	N/A	FRONTIER	1302430.15'	526428.11'	6.81'	5.25'
1-14	WM	DIP	6"	3.40'		<u> </u>	IRC	NG	N/A	сот	1302428.62'	526446.38'	8.20'	4.80'
1-15	GM	STL	4"	3.00'		<u> </u>	IRC	NG	N/A	сот	1302488.18'	526318.06'	6.08'	3.08'
						<u> </u>			_					
1-16	ВТ	PVC	4"	3.50'		<u> </u>	IRC	NG	N/A	FRONTIER	1301205.22'	526417.96	7.50'	4.00'
1-17	ВТ	DBC	2"	3.00'	0	↓	IRC	NG	N/A	FRONTIER	1301810.09'	526422.72'	6.80'	3.80'
Notes:														
												Prepared by: EE	Date: 02/12/20	019
												Checked by: AB	Date: 02/12/	2019

REVISIONS STATE OF FLORIDA Kisinger Campo & Associates Corp. 201 N. Franklin Street, Suite 400 DESCRIPTION DATE DESCRIPTION DATE DEPARTMENT OF TRANSPORTATION Tampa, Florida 33602
Engineer of Record: Branan R. Anderson, PE
P.E. No.: 78438 ROAD NO. COUNTY SR 45 HILLSBOROUGH 440749-1-52-01

FINANCIAL PROJECT ID

UTILITY ADJUSTMENTS (20)

SHEET NO.

c:\pwworkingdir\kca-pw.bentley.com_kca-pw-01\dean grumbach\dms07001\UTADRD00.dgn

Date:		12	2/06/2018	Test Hole Data Report C							Crew Members:	Crew Members: DW, TG		
ECHO Project #: 18-252			16	16514 N. Dale Mabry Hwy. Tampa, Florida 33618 11 E. SR434, Ste. 2001, #252					ECHO UES, Inc.		City, State: Tampa		ampa, Florida	
Financial F	•		N/A		Tampa, Florida	33618	≫⊩	\mathbf{H}		www.echoues.com		General Location:	US	
•		D-3/T-2							888.778 - GROW, INSPIRE, M		Coordinate Unit of Meas	uro:	S Survey Feet	
TTUCK NO		IATIDA - Trans	,	Win	ter Springs, Flo	nida SE700		INEERING &	SURVET					· ·
DE D 41.41		Itility Type			A.C. Turnin	Utilit	y Material	l		Identif	iea By:	Abbreviations		sured From:
BE = Buried I		RW = Reclai			AC = Transite		FIBG = Fiberg		hulana Bina	HUB = Survey Hub	PECHO TEST HOLE!	N/A = Not Applicable NAD = North American	EP= Edge of Pay	
GM = Gas M BT = Buried		SL = Street TS = Traffic	ŭ		CI= Cast Iron CP = Concrete P	lino	PE = Polyethy		nylene Pipe	IRC = Iron Rod & Cap NL = Nail & Disk "ECI		Datum	BC = Back of Cu BL = Baseline of	
FOC = Fiber		FL = Fuel Lir			DBC = Direct Bu		PVC = Polyetny			SLEEVE = Sleeve	HO TEST HOLE	NAVD = North American	COORD = Surve	,
WM = Water		GS = Gas Se			CMP = Corrugat		STL = Steel	iyi cilionde		X = "X" in Concrete		Vertical Datum	CL = Centerline	
SAN = Sanita		WS = Water			CONC = Concre		VCP = Vitrifie	d Clay Pino		Surfac	a Tuna	UNK = Unknown	HUB = Survey H	
STM = Storm	•	UNK = Unkr			CPP = Corrugate		1		v Consusta	ASPH = Asphalt	етуре	COT = City of Tampa	RW = Right of V	
CATV = Cable			d Electrical D	huct	DCT = Duct	eu riasuc ripe	Pipe Prest	ressed Cylinde	r Concrete	CONC = Concrete		COT - City of Tampa	ST = Swing Ties	
FM = Force N			d Telephone		DIP = Ductile Iro	n Pine		rced Concrete	Pine	NG = Natural Ground	4		X = "X" in Conci	
rivi – roice	viaiii	BTB - Burie	Utility Size	Utility	DIF - Ductile II C	N N	KCF - Kellilo	rcea concrete		NG - Natural Ground		Horizontal: NAD83/11	X = X III conci	
Took Upla	I IAIlian Tono	Utility	Outside	Manual	Cross	*	uda asida ad no.	Conferentian	Surface	Apparent Utility	Datums:	Vertical: NAVD88	Ground	Utility
lest Hole	Utility Type	Material	Diameter	Depth	Sectional View	▼	identified by	Surface Type	Thickness inches	Owner	Northina		Elevation	Elevation
			inches	feet		Utility Direction			inches		Northing	Easting		
1-18	вт	PVC	2 - 4"	3.82'	00		IRC	NG	N/A	FRONTIER	1303091.15'	526425.13'	7.04'	3.22'
1-19	FOC/BT	PVC	4"	2.54'			IRC	NG	N/A	FRONTIER	1303091.17	526425.73"	6.99'	4.45'
1-20	вт	LEAD	2 - 2"	3.00'	00	\^	IRC	NG	N/A	FRONTIER	1303091.09'	526427.92'	6.86'	3.86'
1-21	FOC	UNK	12 - 1.5"	9.22'	888888	‡	IRC	NG	N/A	FRONTIER	1303091.01	526430.76'	6.58'	-2.64'
1-22	вт	LEAD	2 - 2"	2.00'	00		IRC	NG	N/A	FRONTIER	1303695.15'	526432.46'	6.77'	4.77'
1-23	вт	PVC	2 - 4"	2.76'	00		IRC	NG	N/A	FRONTIER	1303695.20'	526433.46'	6.70'	3.94'
1-24	ВТ	LEAD	2 - 2"	2.74'	00	‡	IRC	NG	N/A	FRONTIER	1304500.45	526435.53'	7.28'	4.54'
Notes:	1-21 - Unable	e to visually v	erify size and	d material du	ue to depth and g	groundwater. Possil	bly 12 - 1.5" p	olyethylene pi	pes.					
												Prepared by: EE	Date: 02/12/2	019
												Checked by: AB	Date: 02/12/	2019


REVISIONS DESCRIPTION DESCRIPTION DATE


Kisinger Campo & Associates Corp. 201 N. Franklin Street, Suite 400 Tampa, Florida 33602 Engineer of Record: Branan R. Anderson, PE P.E. No.: 78438


STATE OF FLORIDA DEPARTMENT OF TRANSPORTATION ROAD NO. COUNTY FINANCIAL PROJECT ID SR 45 HILLSBOROUGH 440749-1-52-01


UTILITY ADJUSTMENTS (21)


SHEET NO.

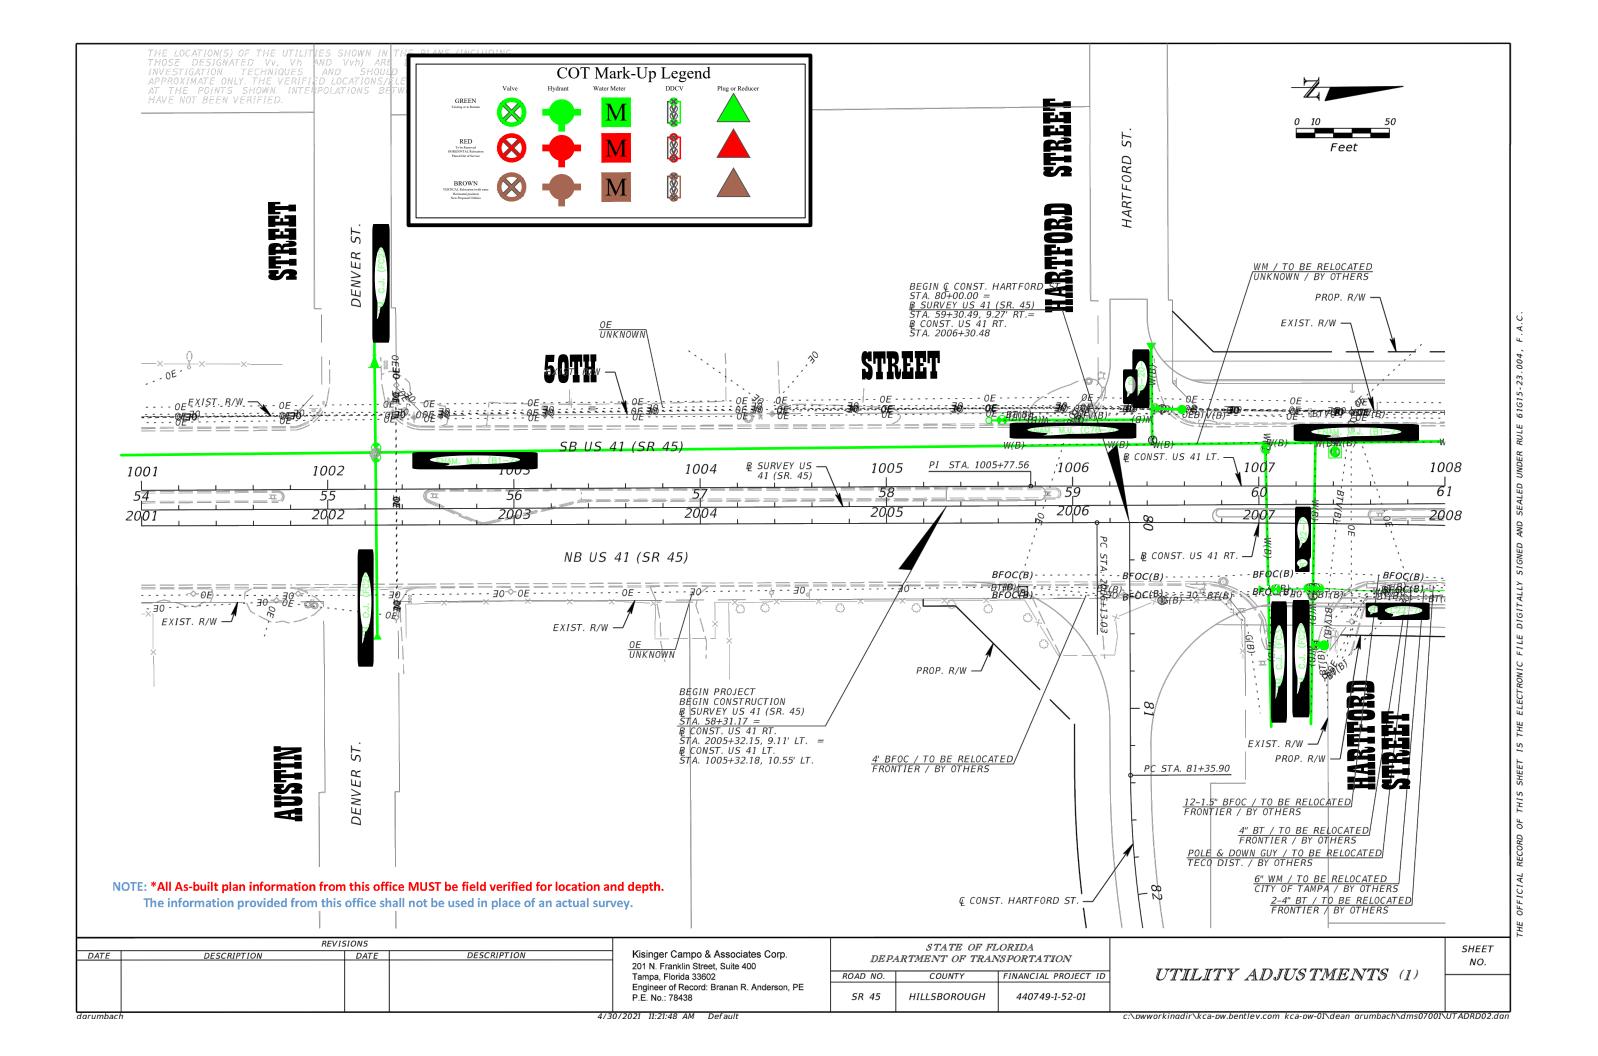


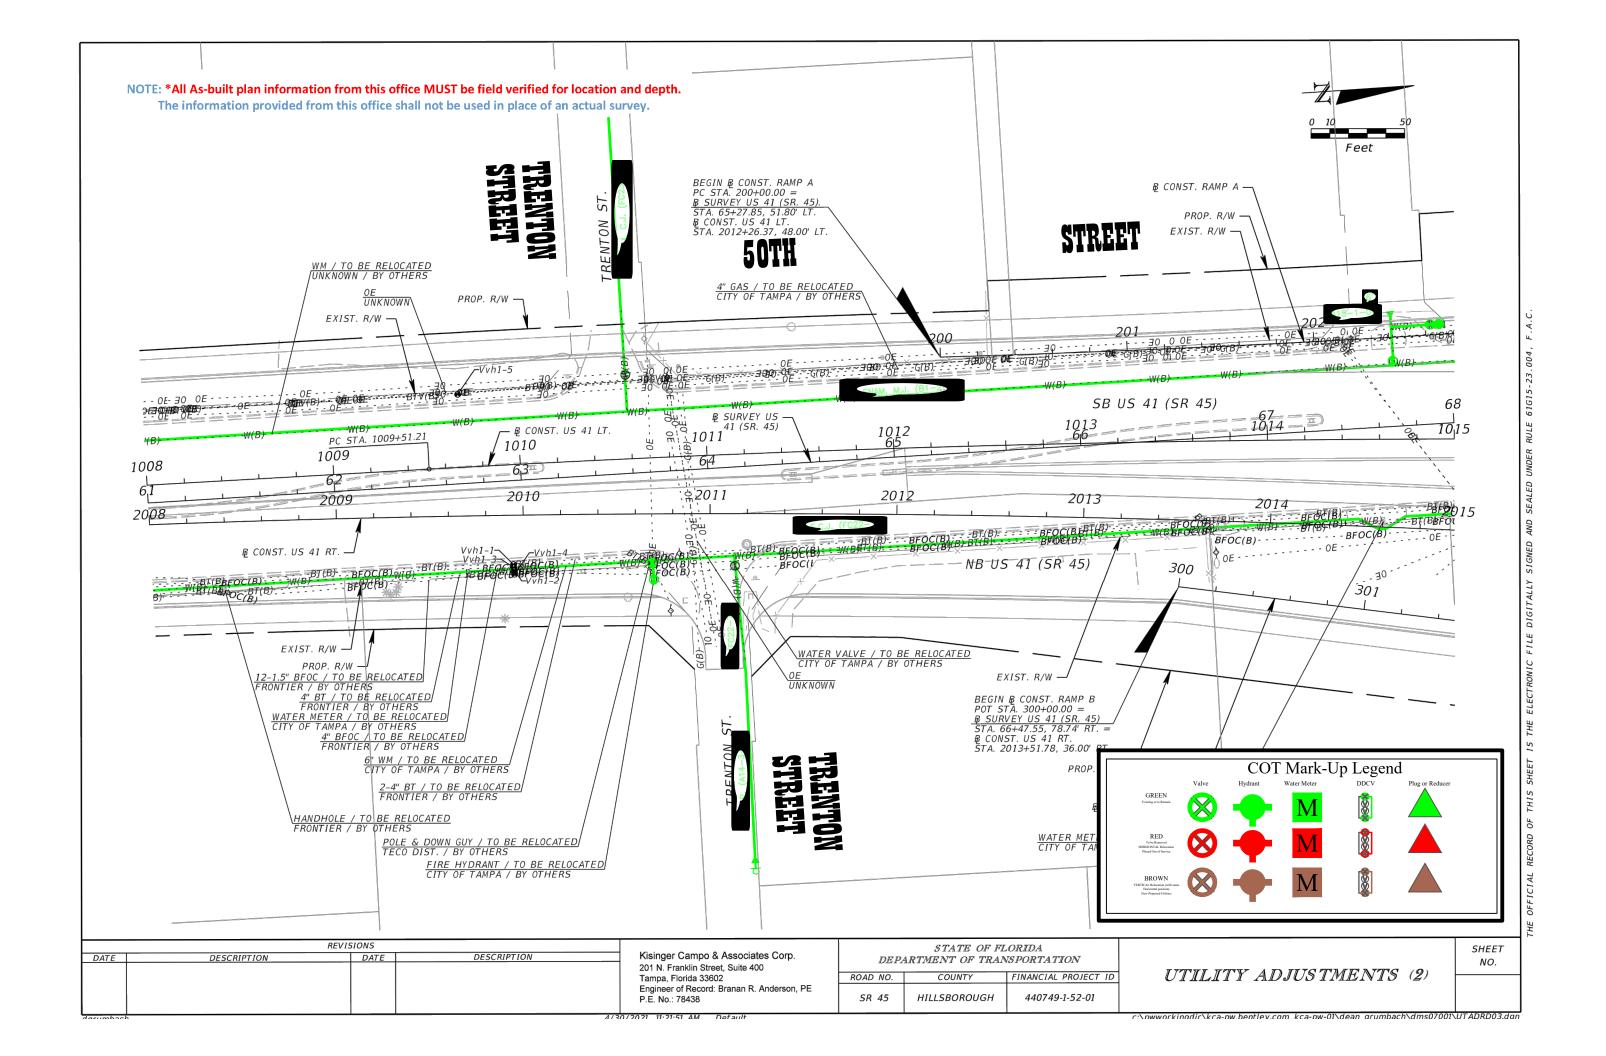


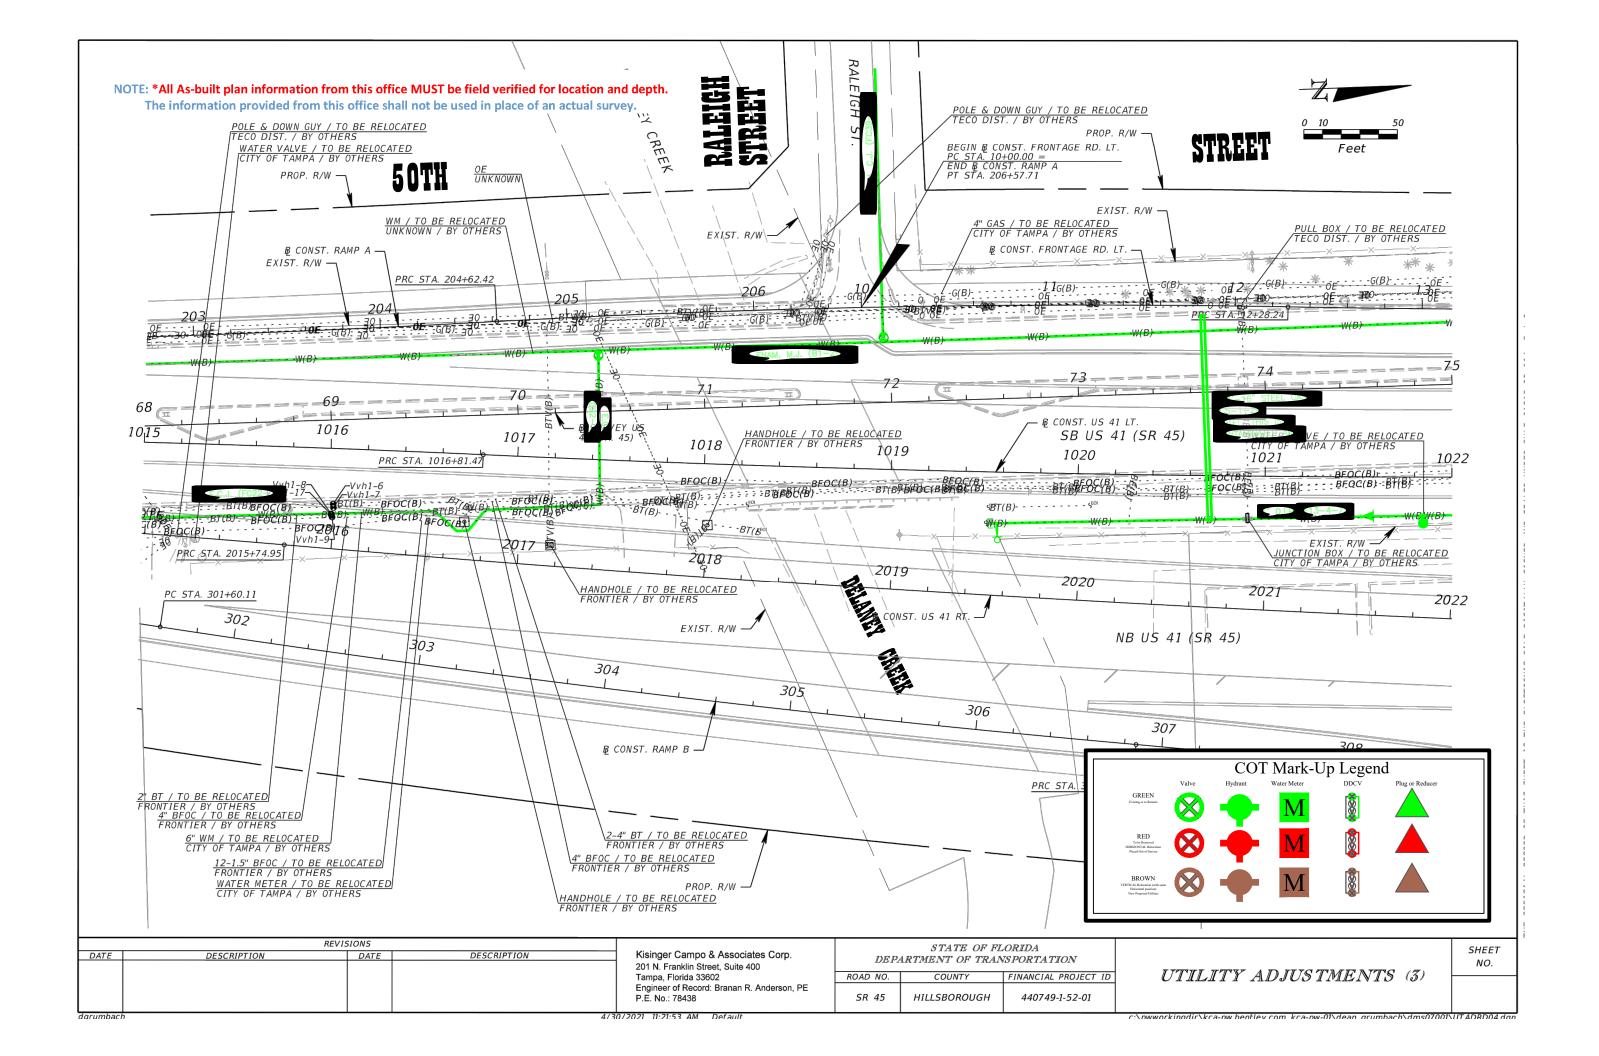


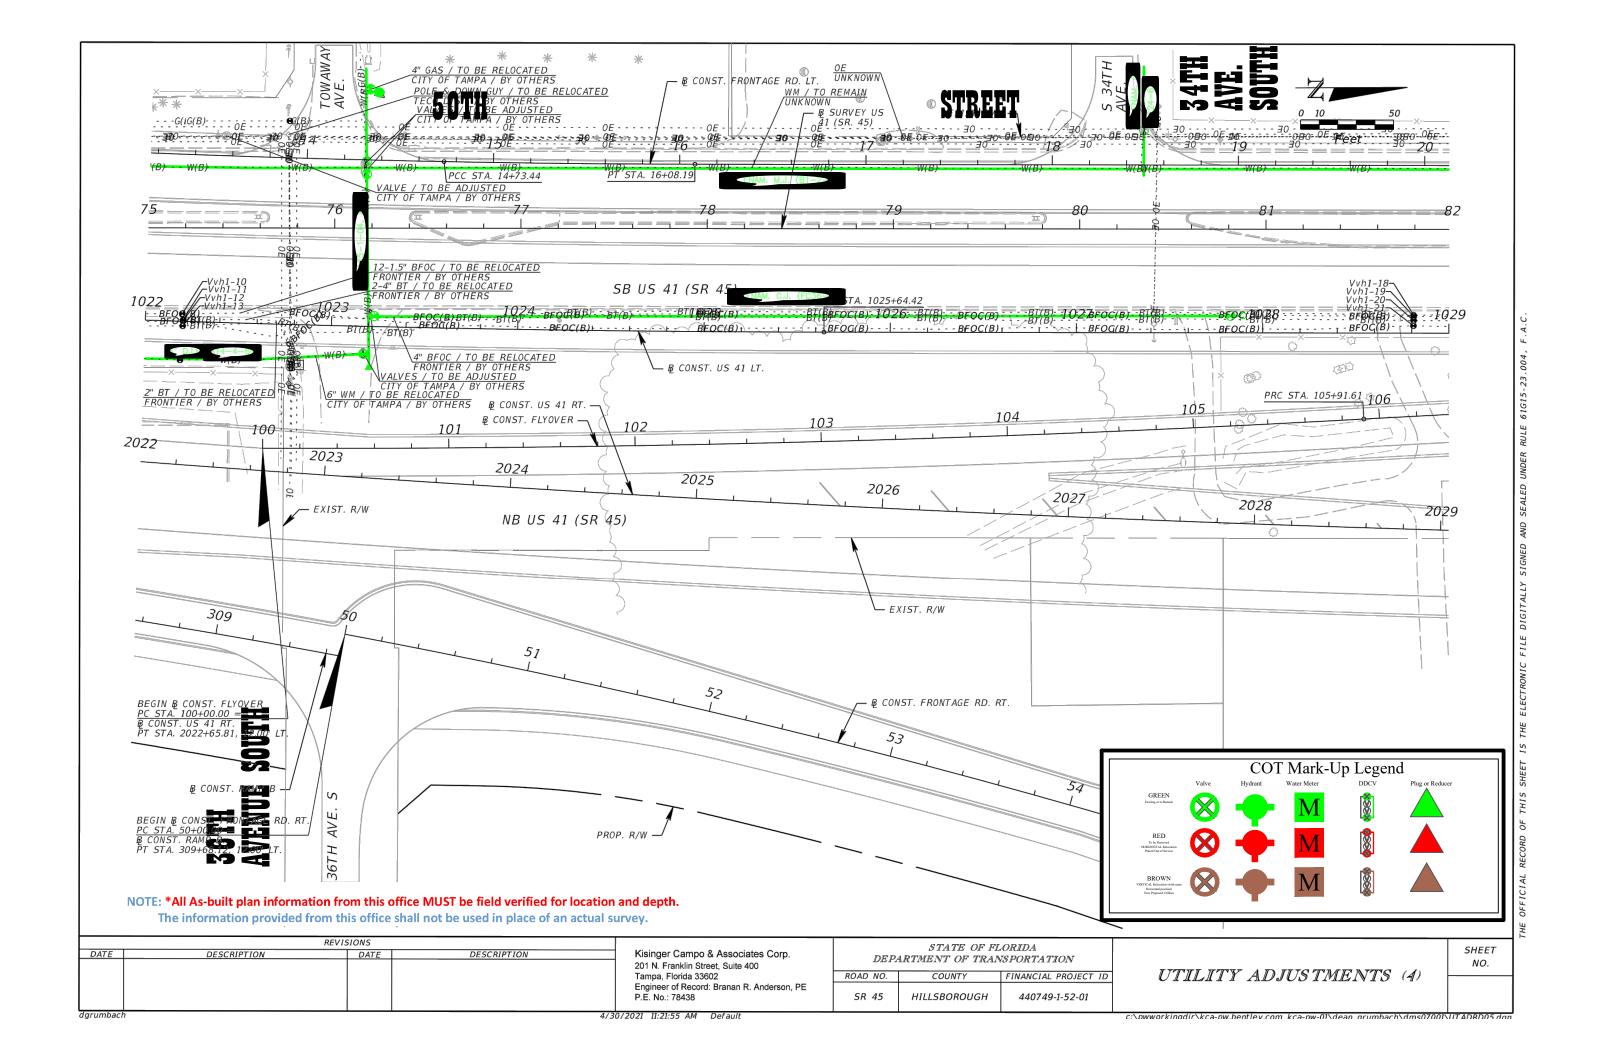


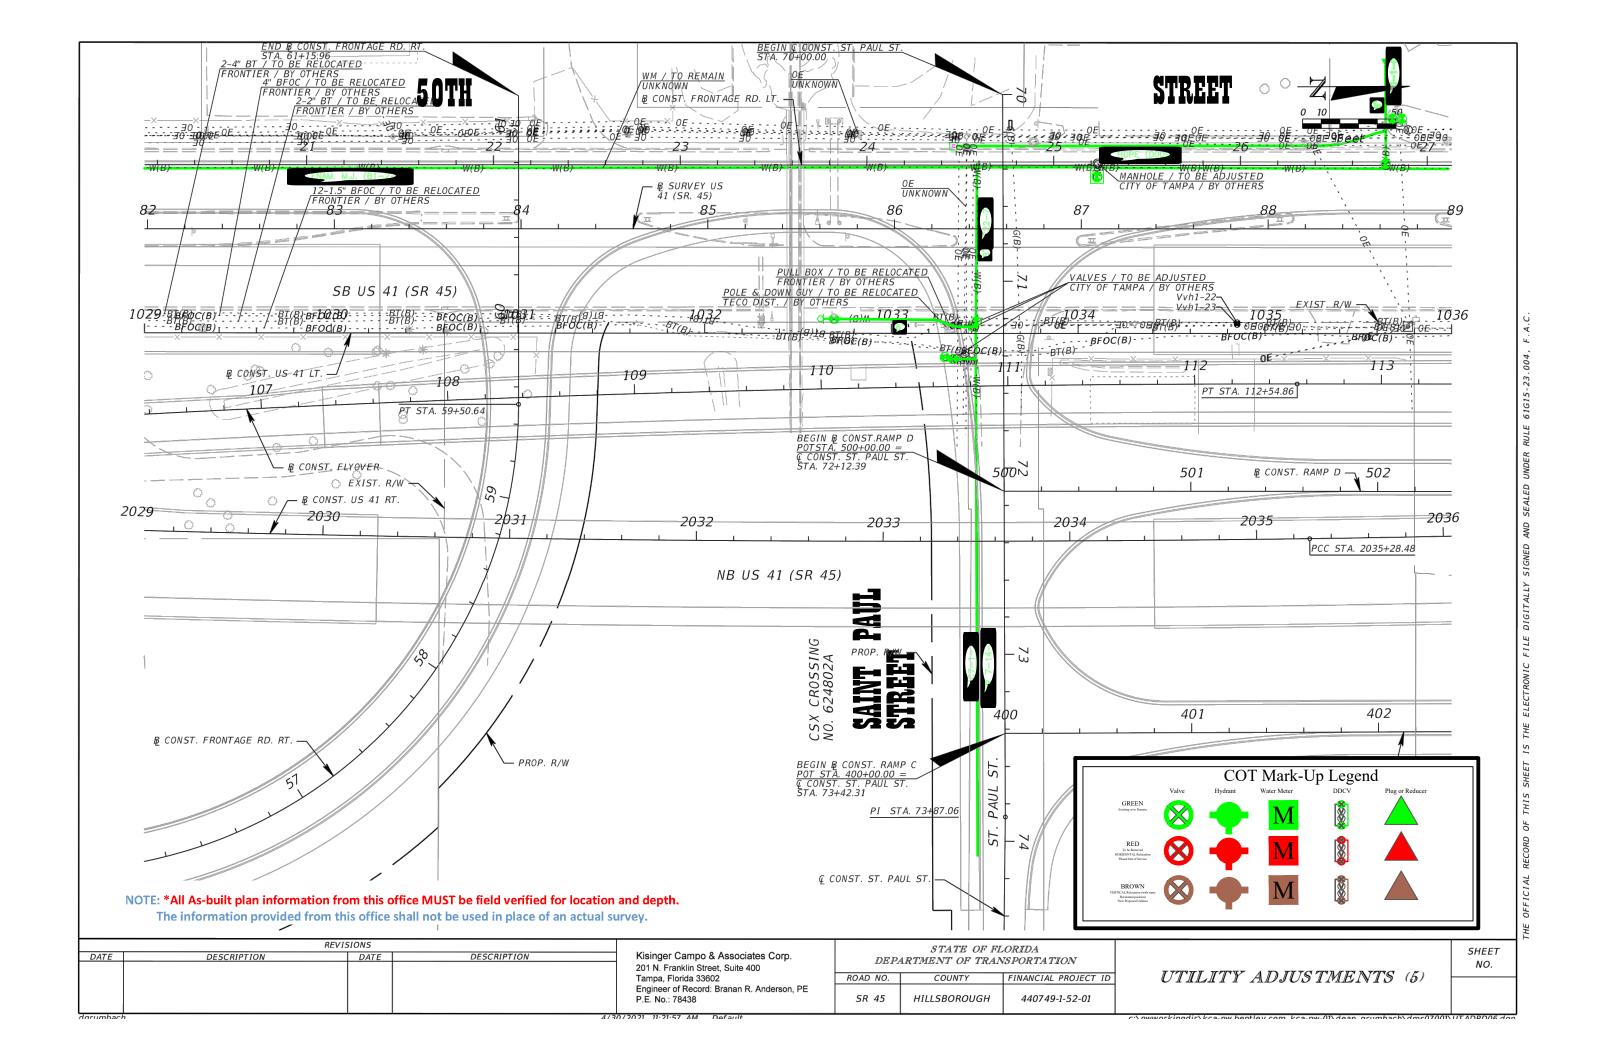


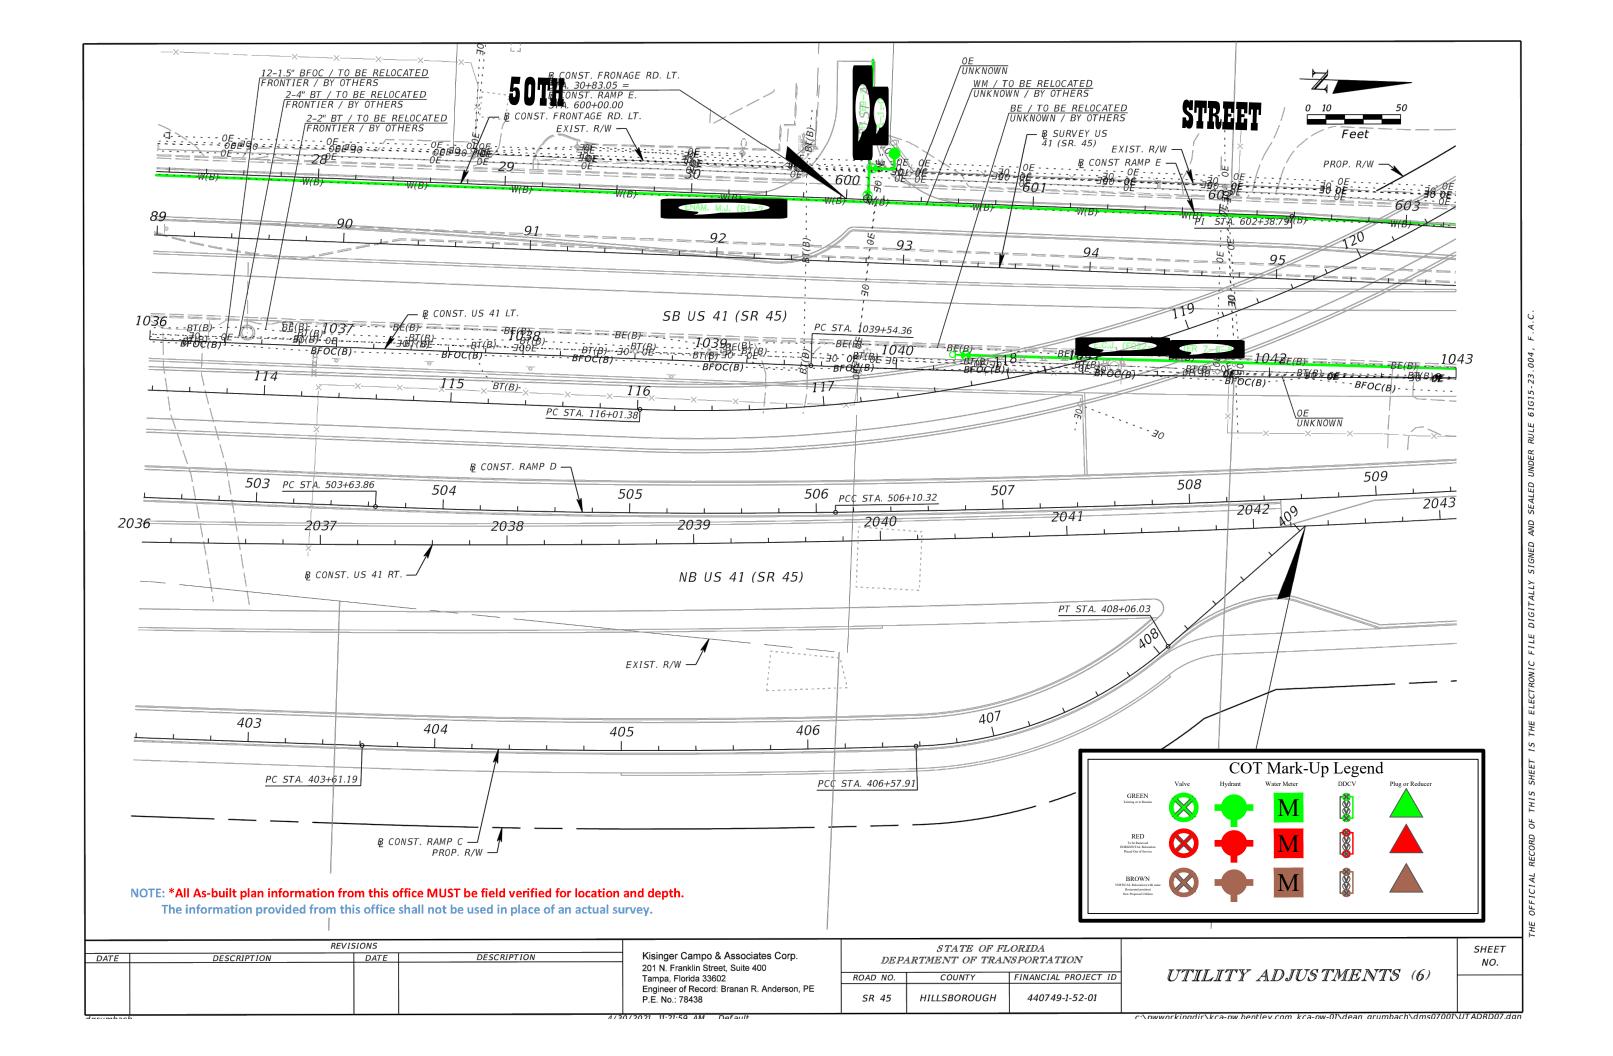


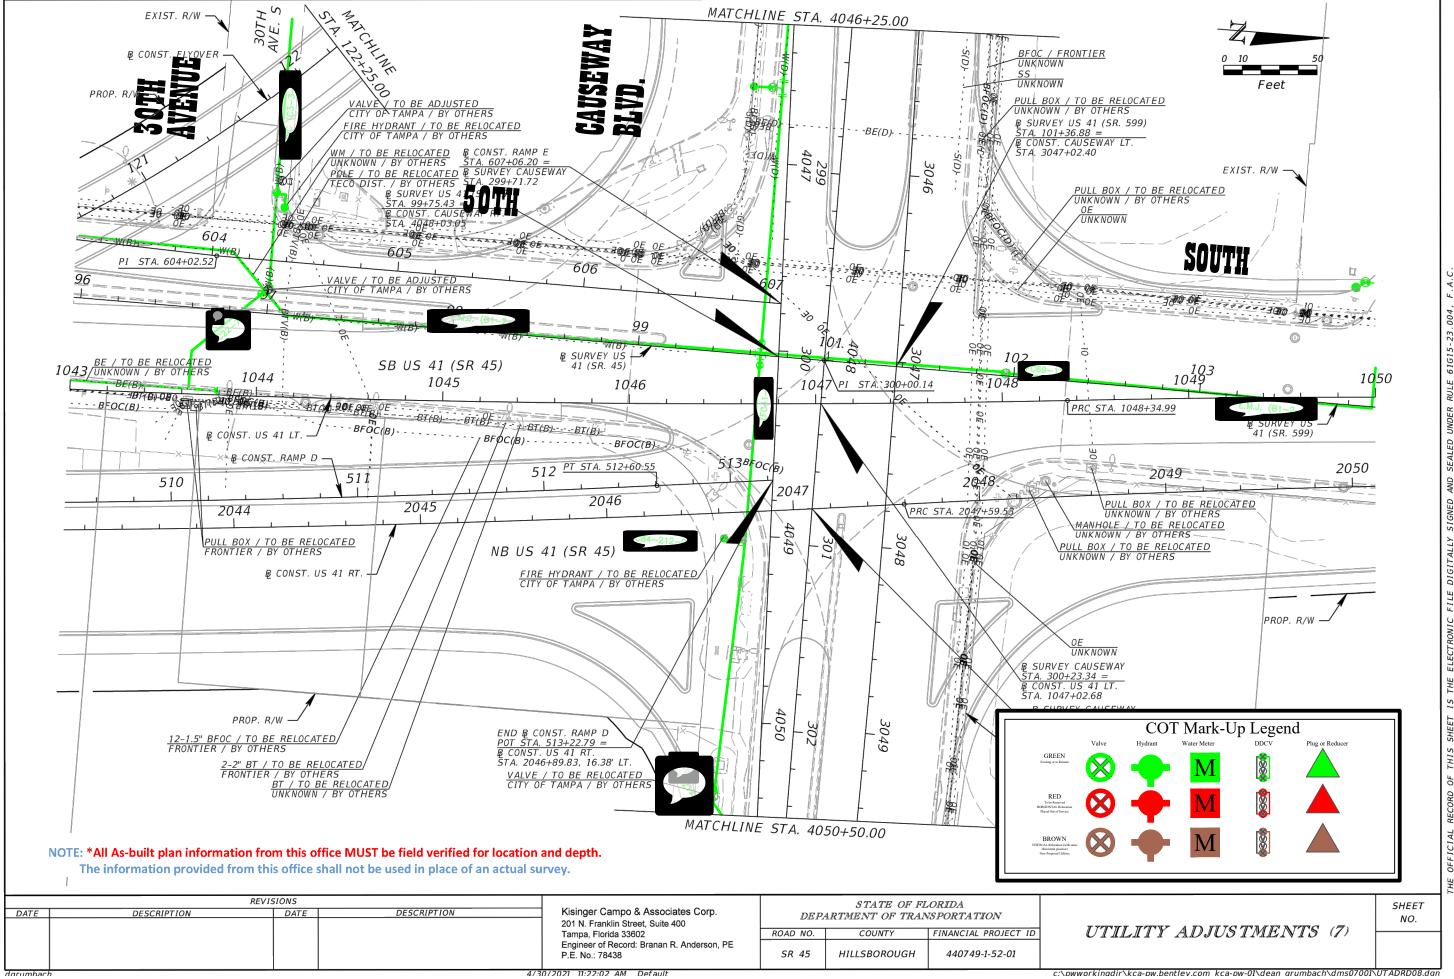


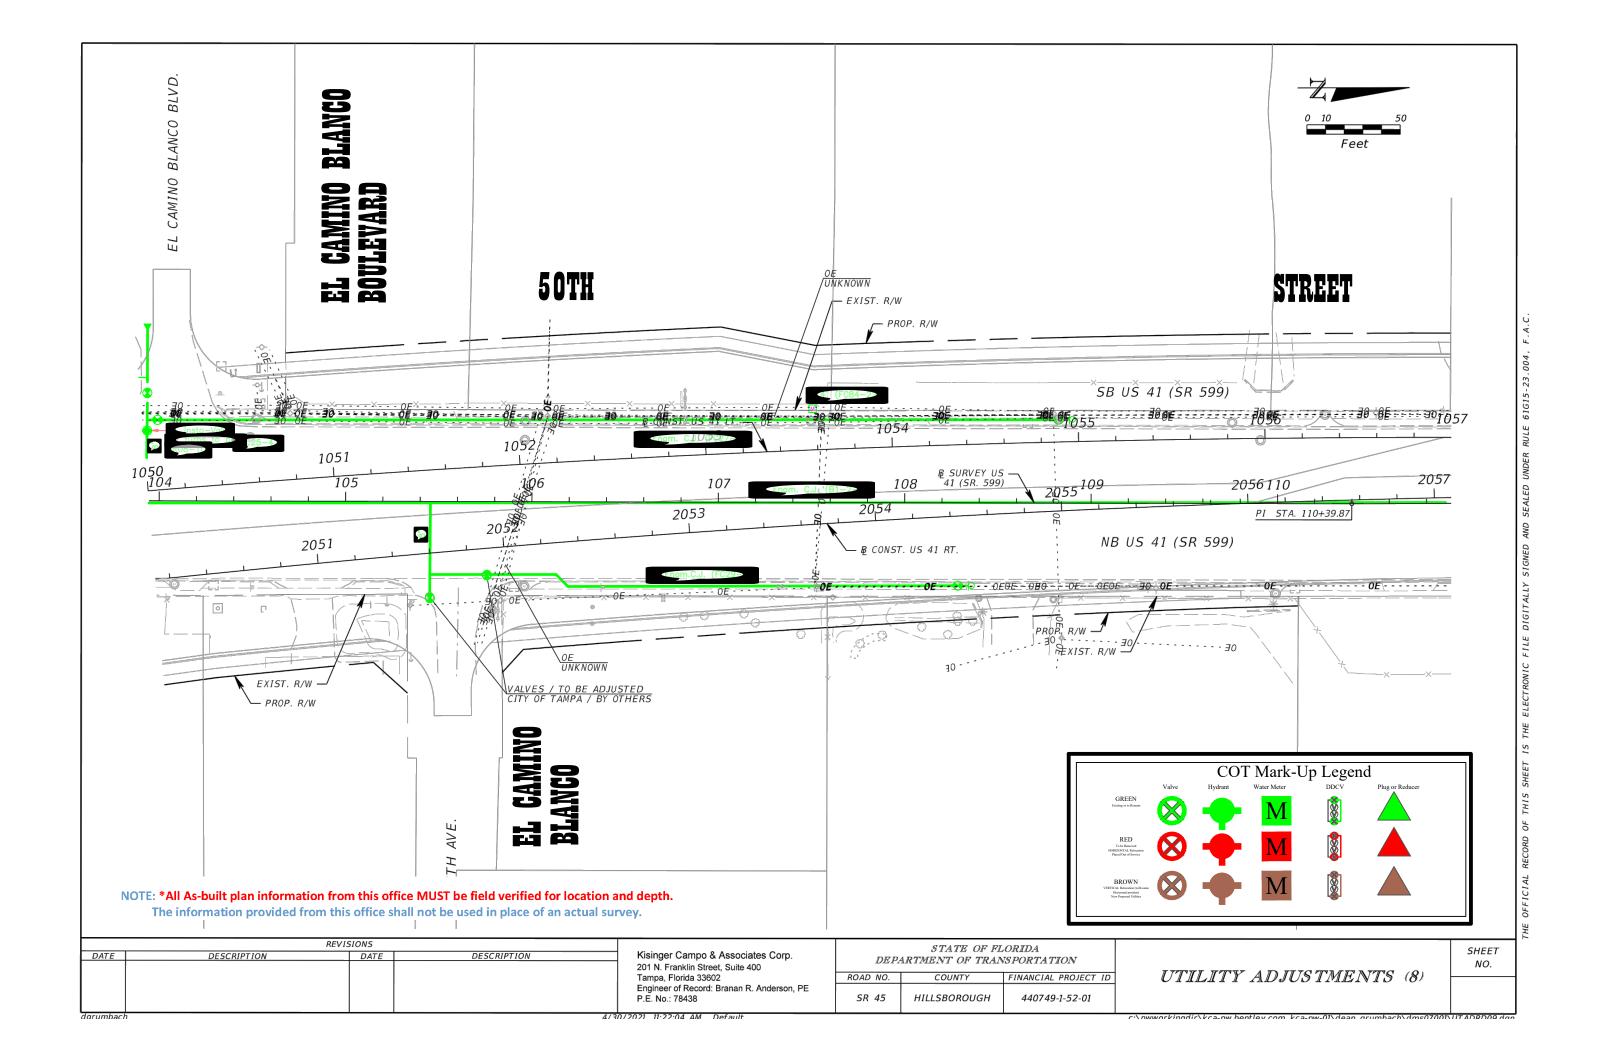

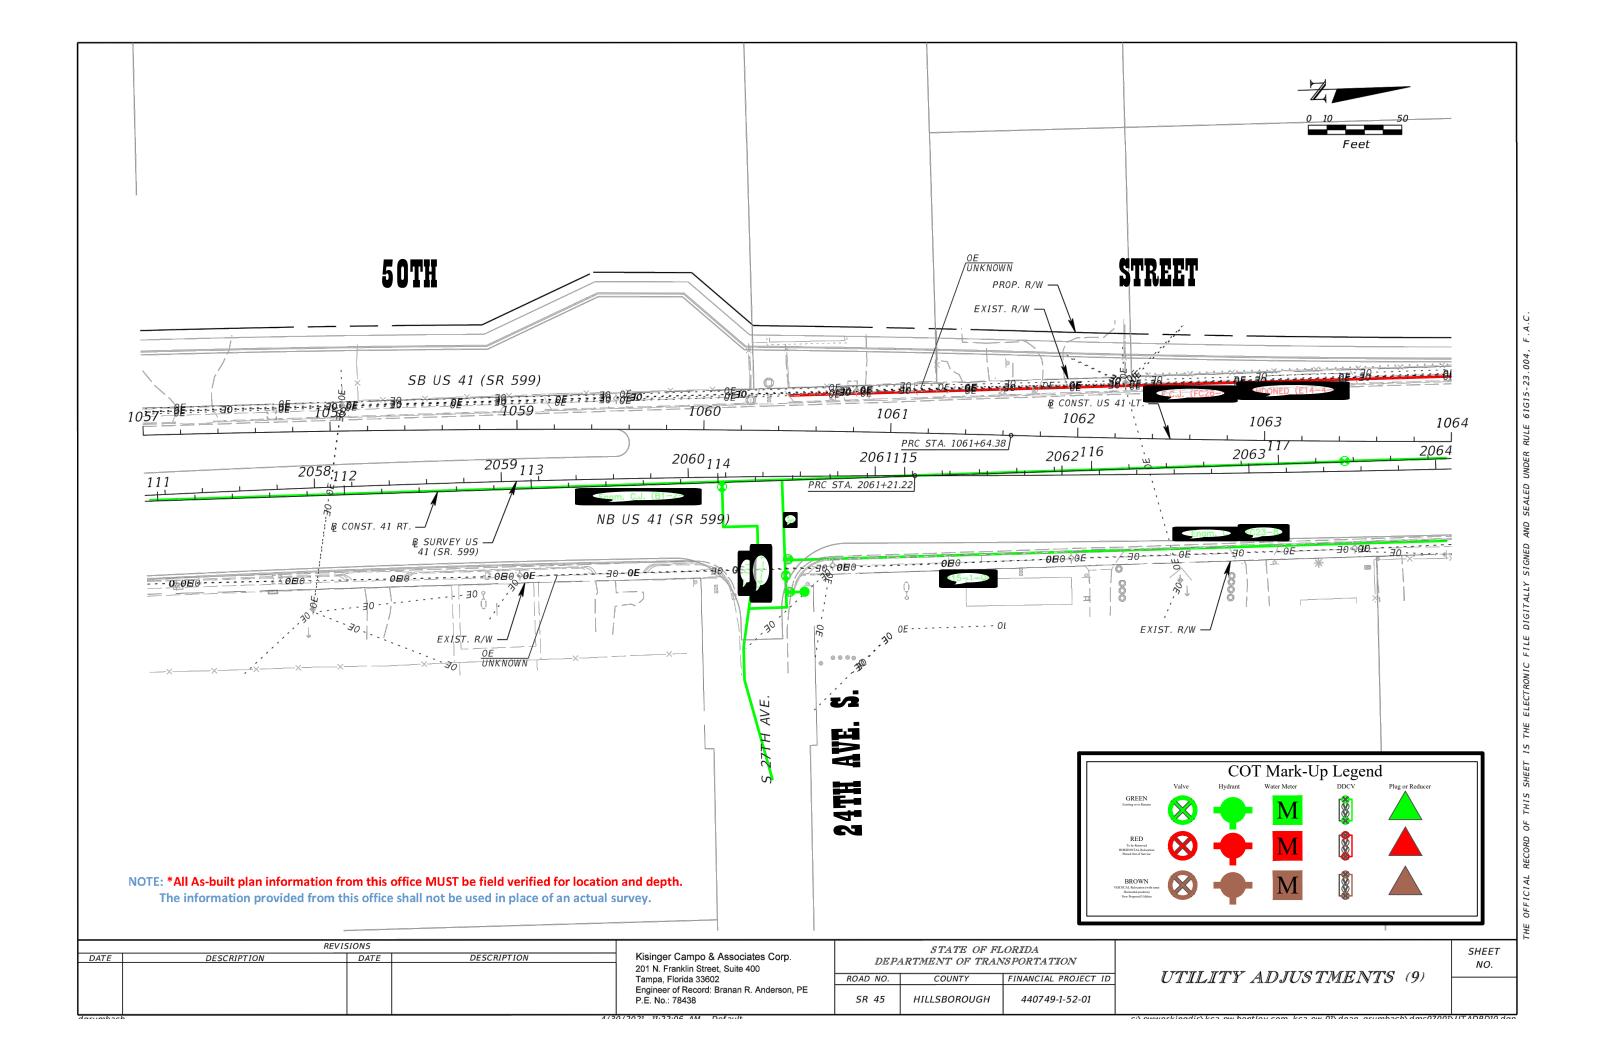

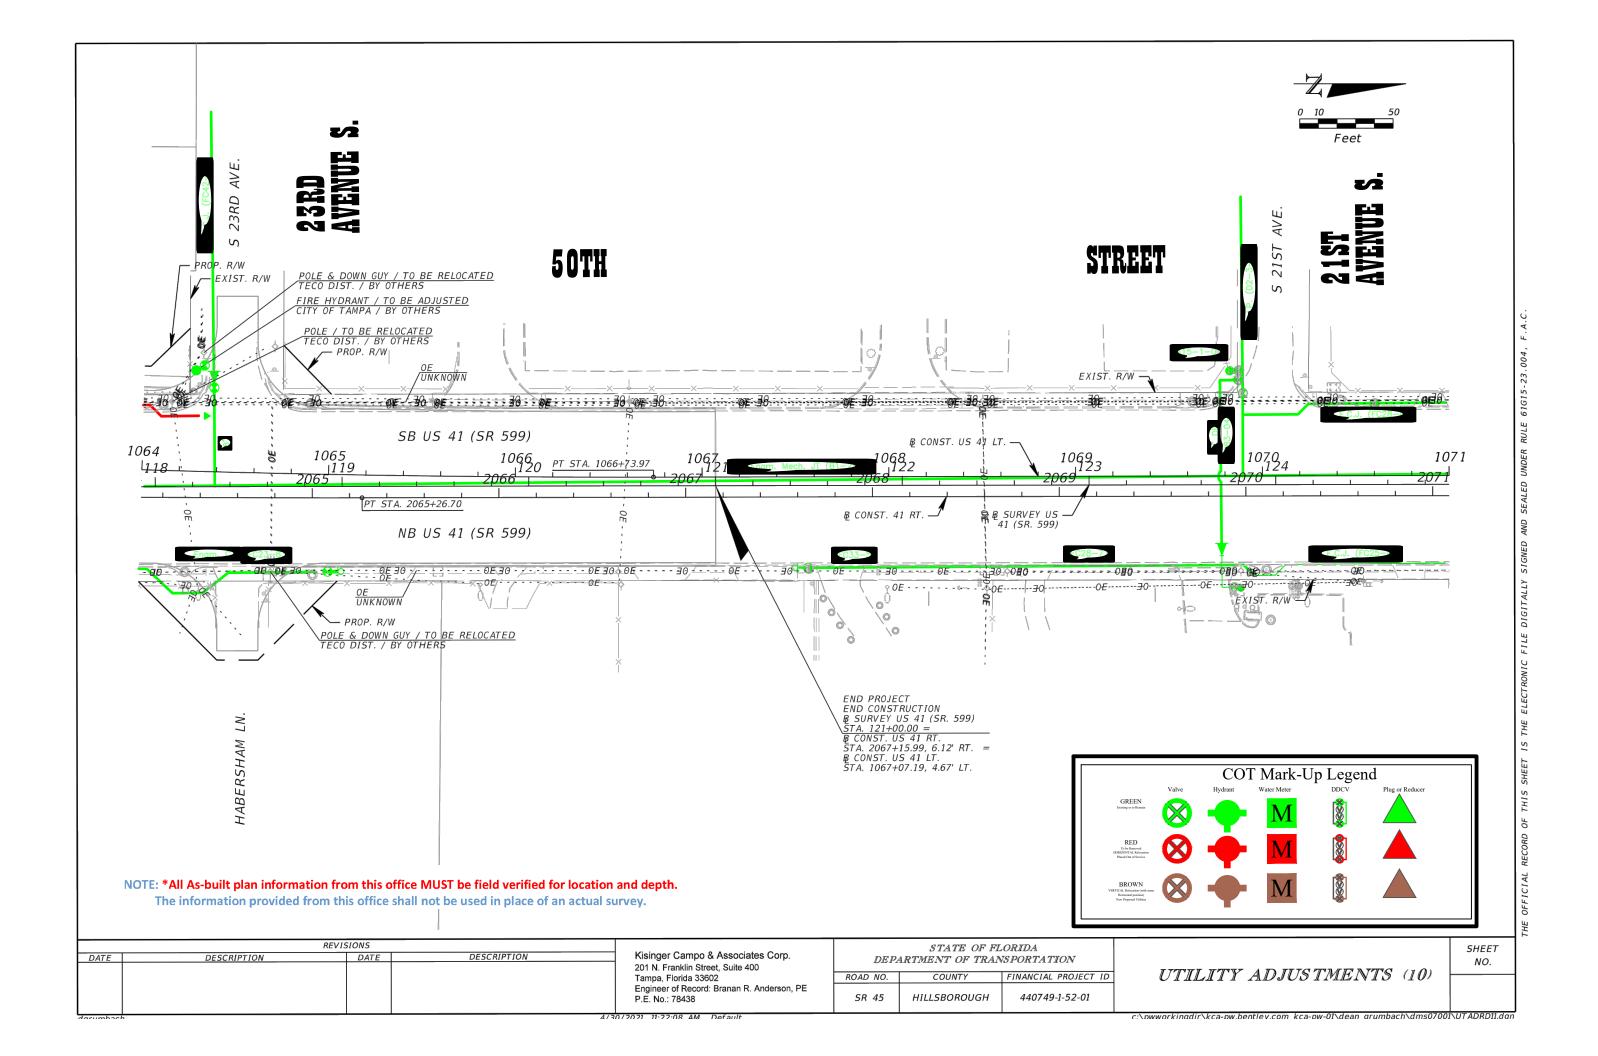

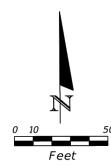

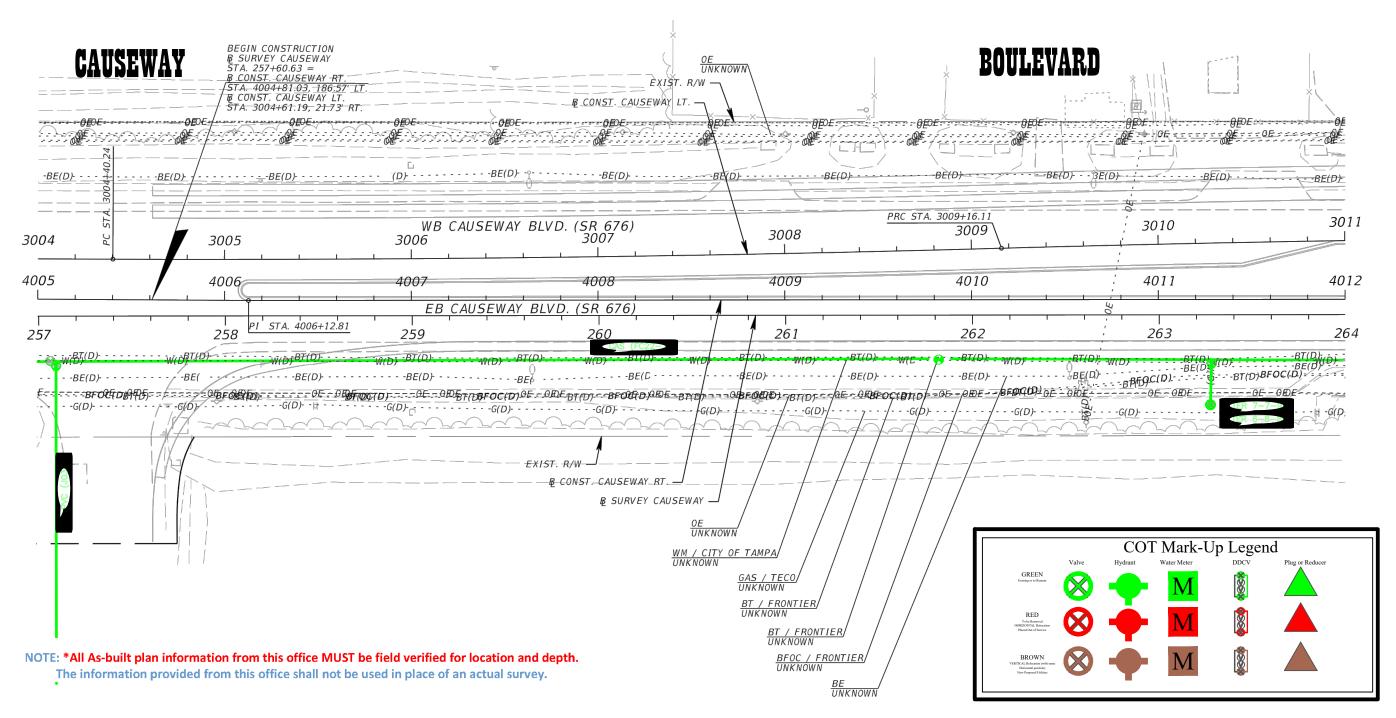

STATE OF FLORIDA

FINANCIAL PROJECT ID

440749-1-52-01

DEPARTMENT OF TRANSPORTATION

COUNTY

HILLSBOROUGH

ROAD NO.

SR 45

darumhach

DATE

REVISIONS

DATE

DESCRIPTION

DESCRIPTION

P.E. No.: 78438

4/30/2021 11:22:10 AM Default

Kisinger Campo & Associates Corp.


Engineer of Record: Branan R. Anderson, PE


201 N. Franklin Street, Suite 400 Tampa, Florida 33602


UTILITY ADJUSTMENTS (11)


SHEET NO.


c:\pwworkinadir\kca-pw.bentlev.com kca-pw-01\dean arumbach\dms07001\UTADRD14.dar

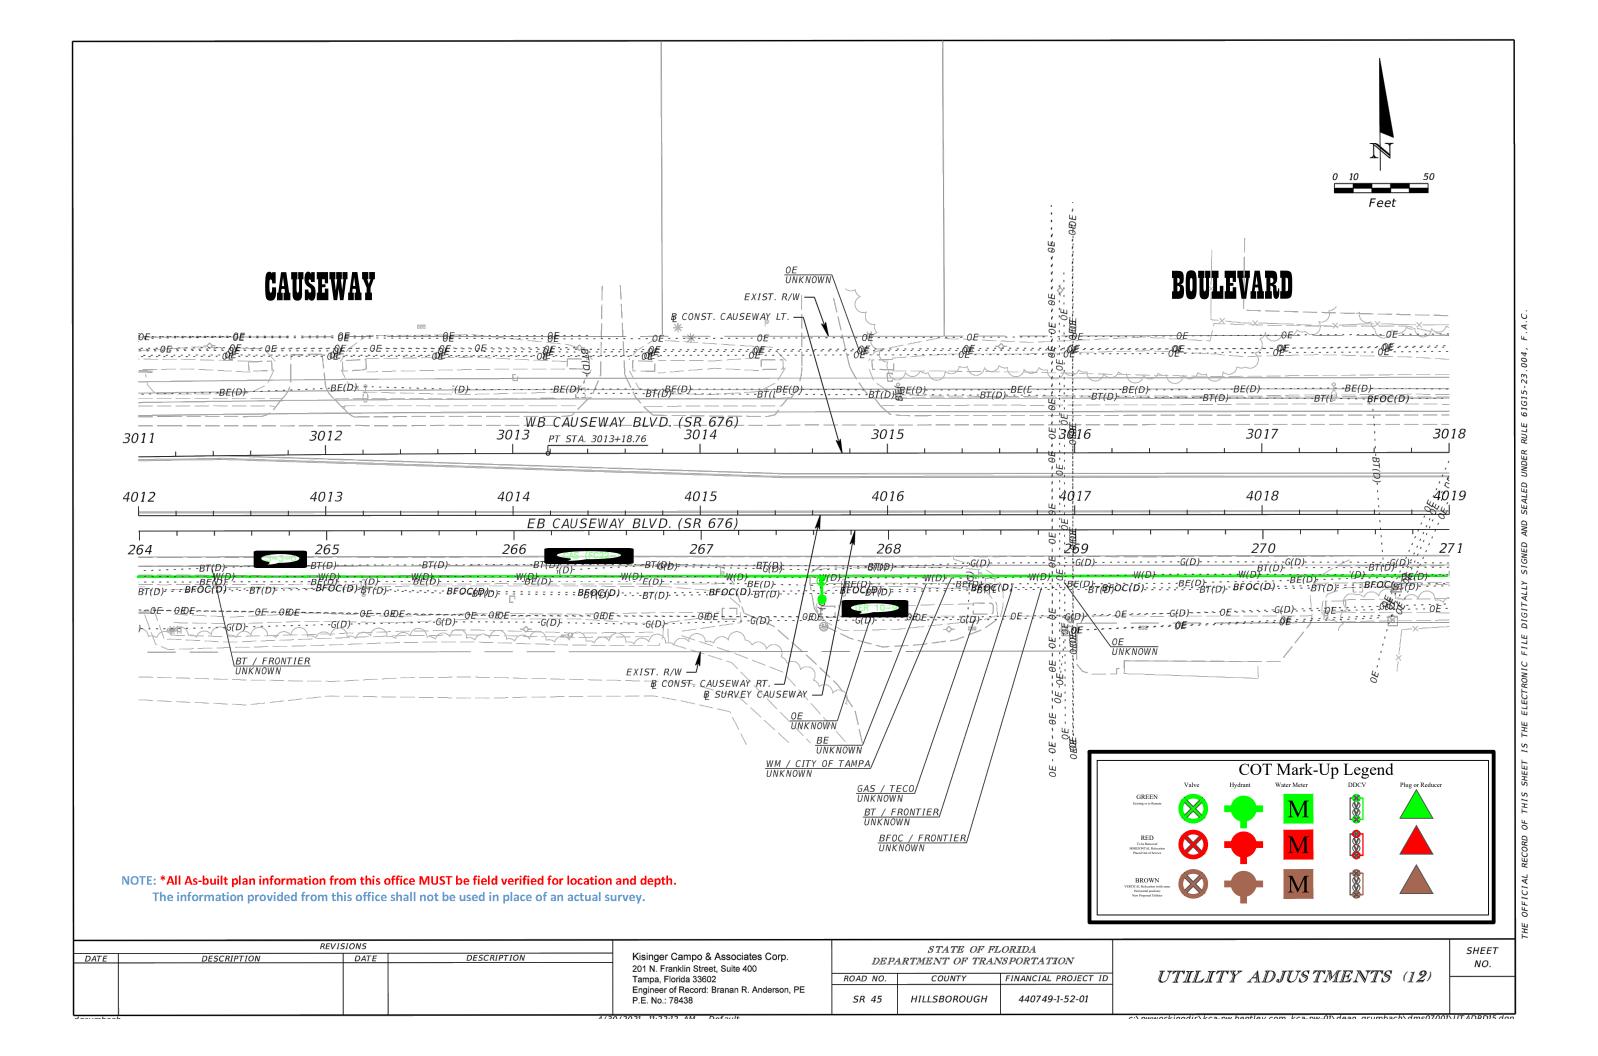


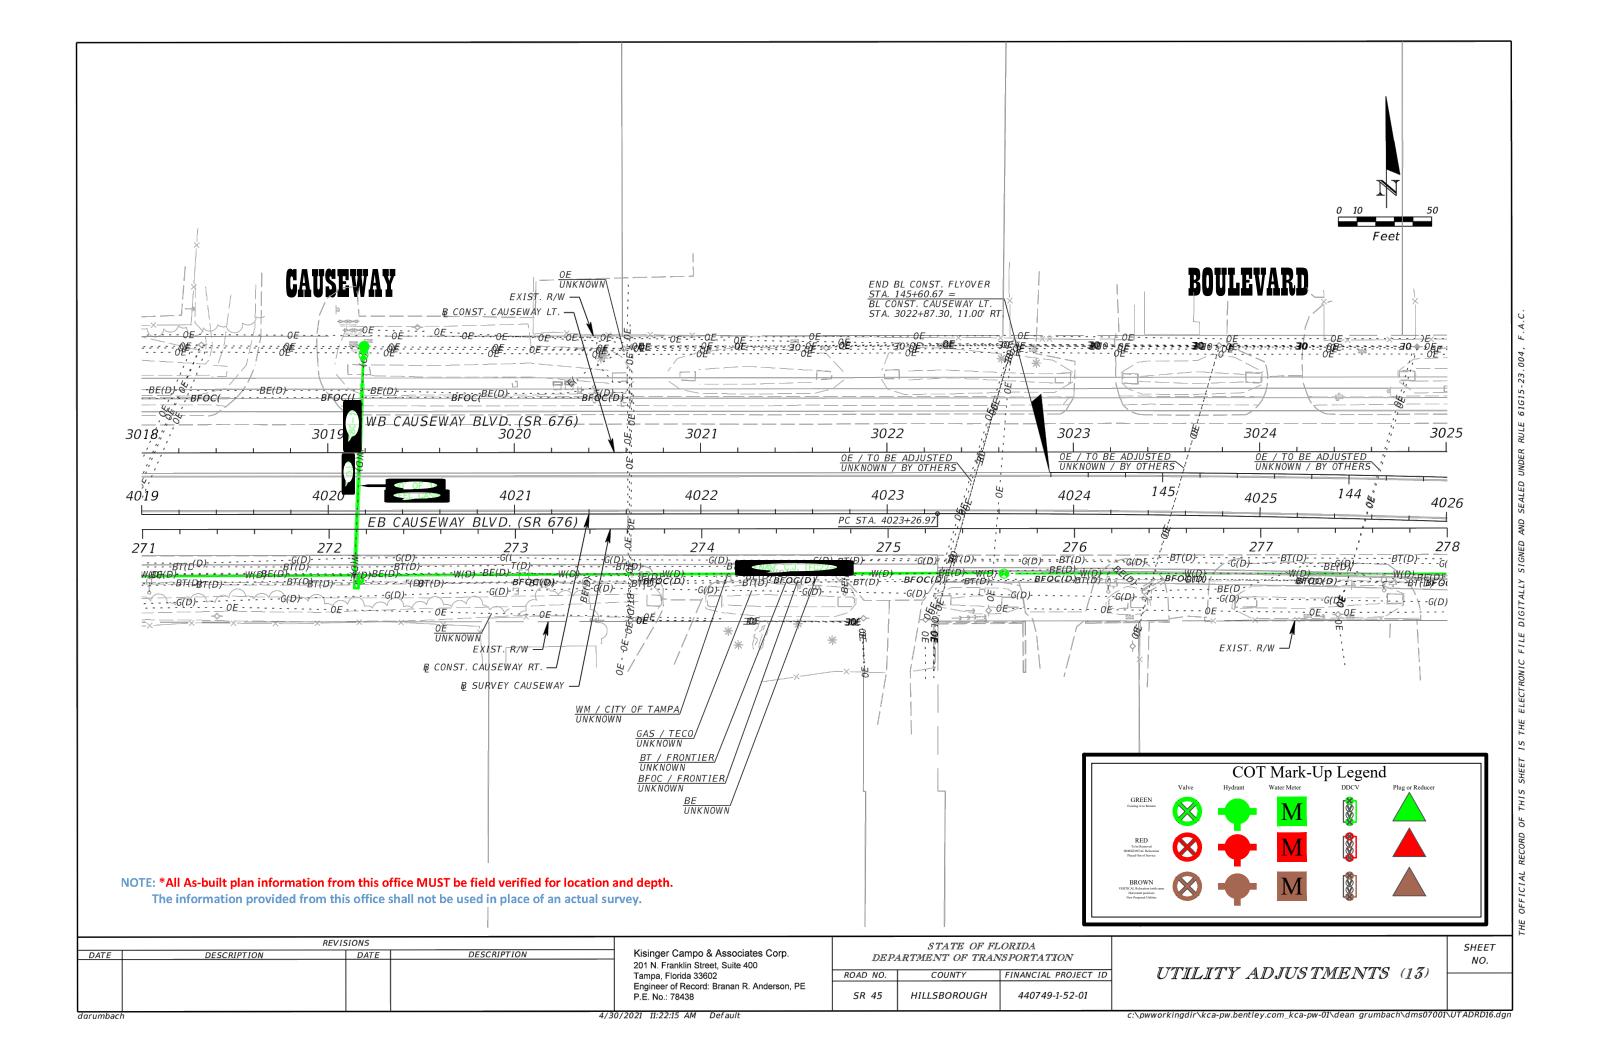


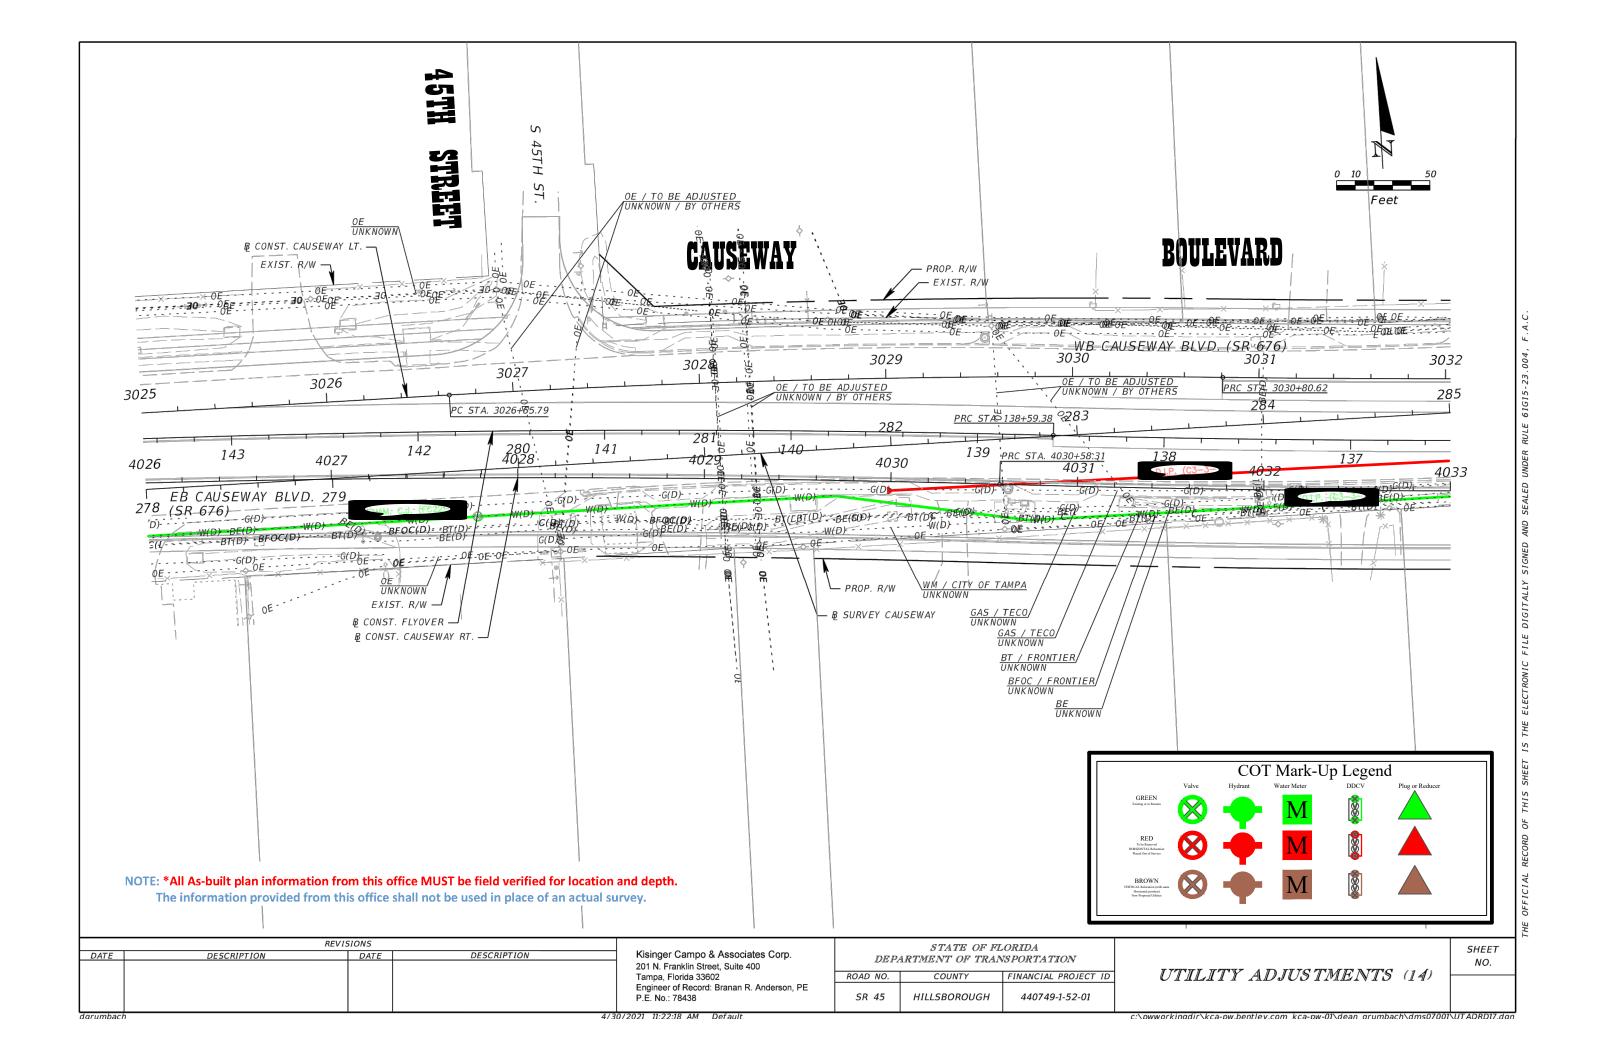

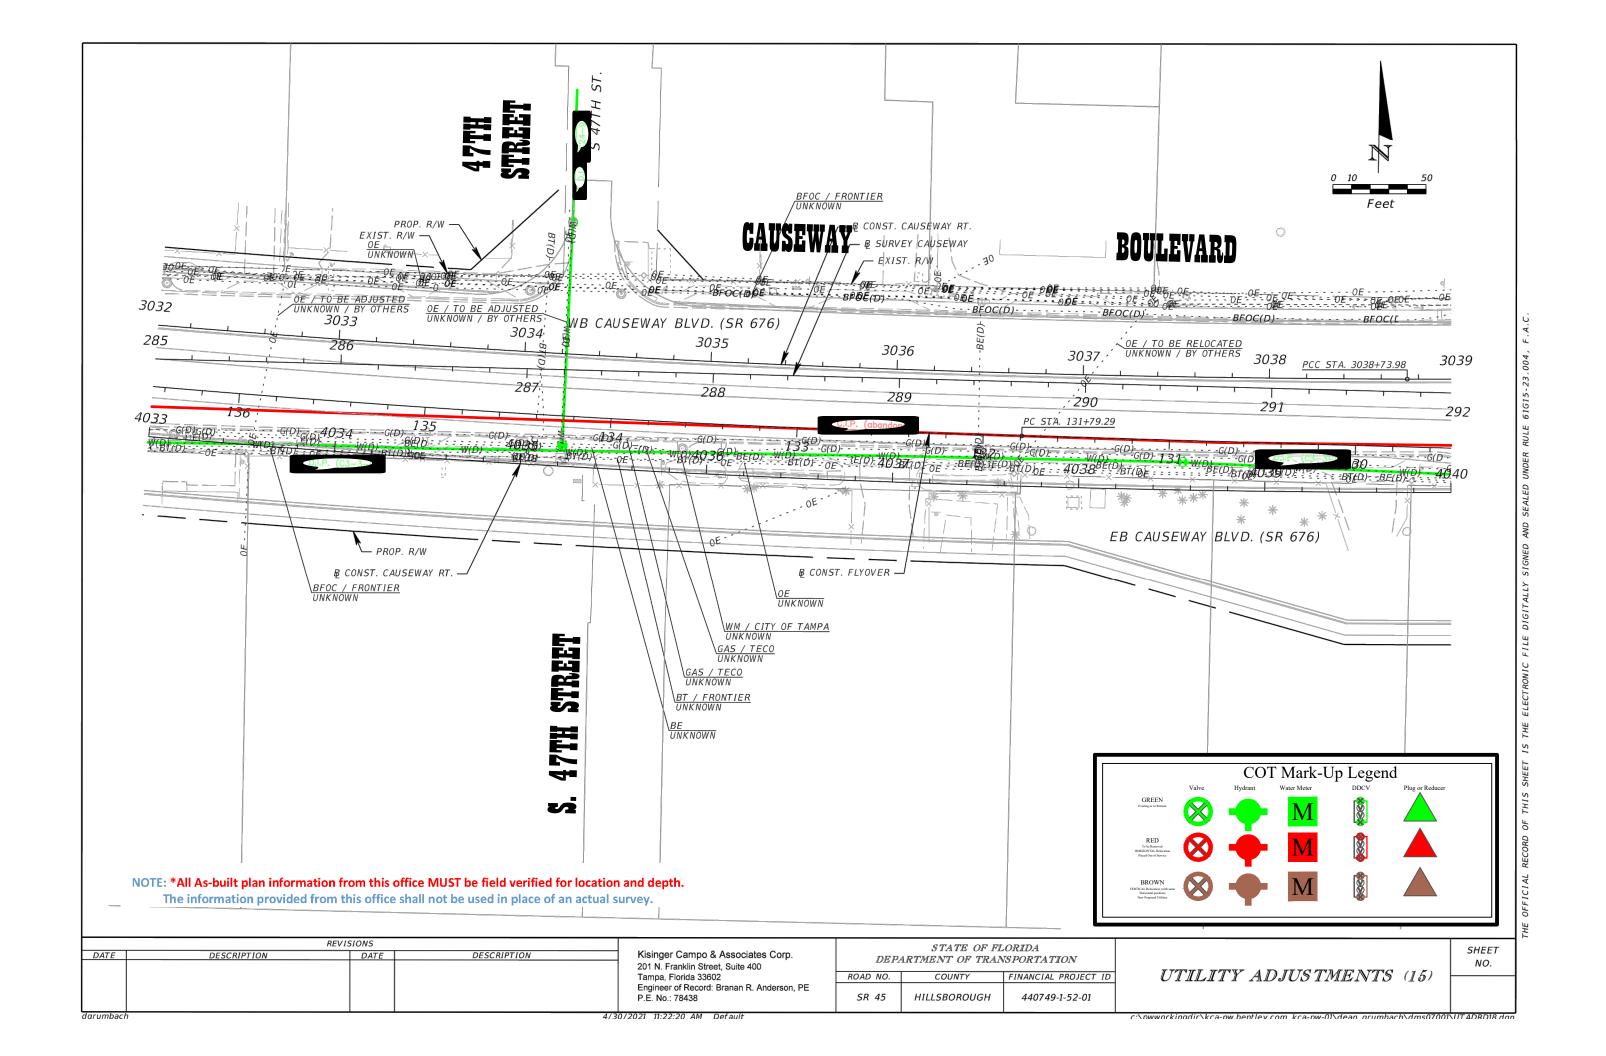


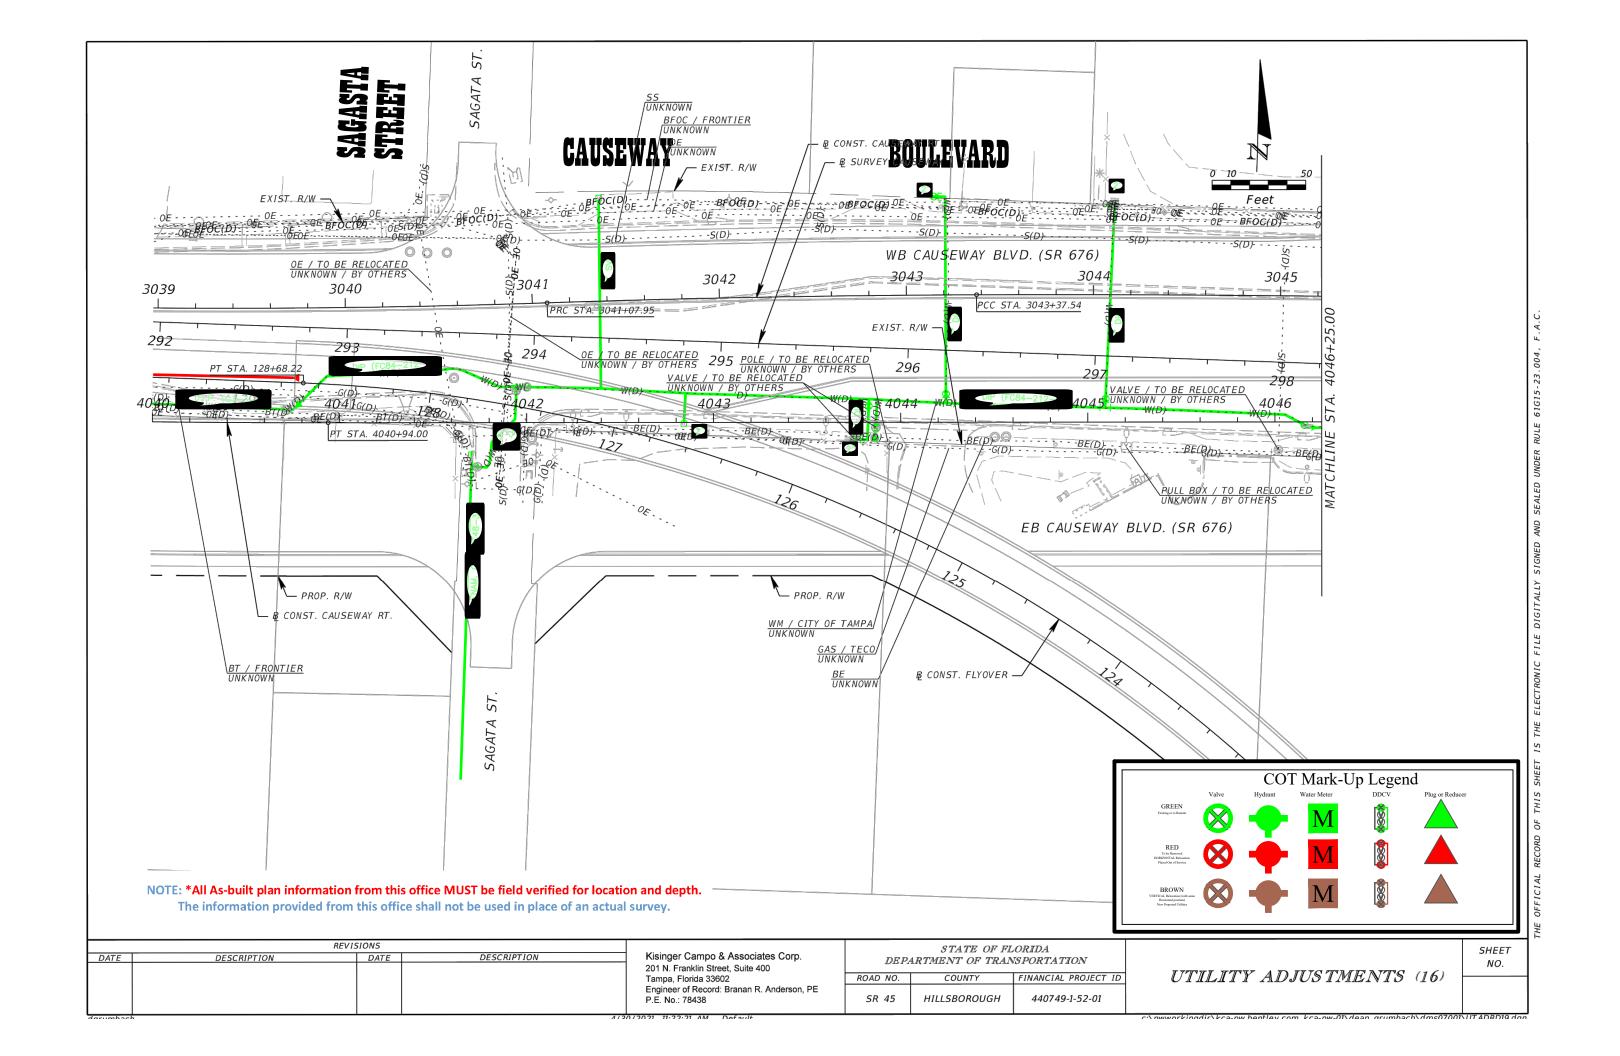


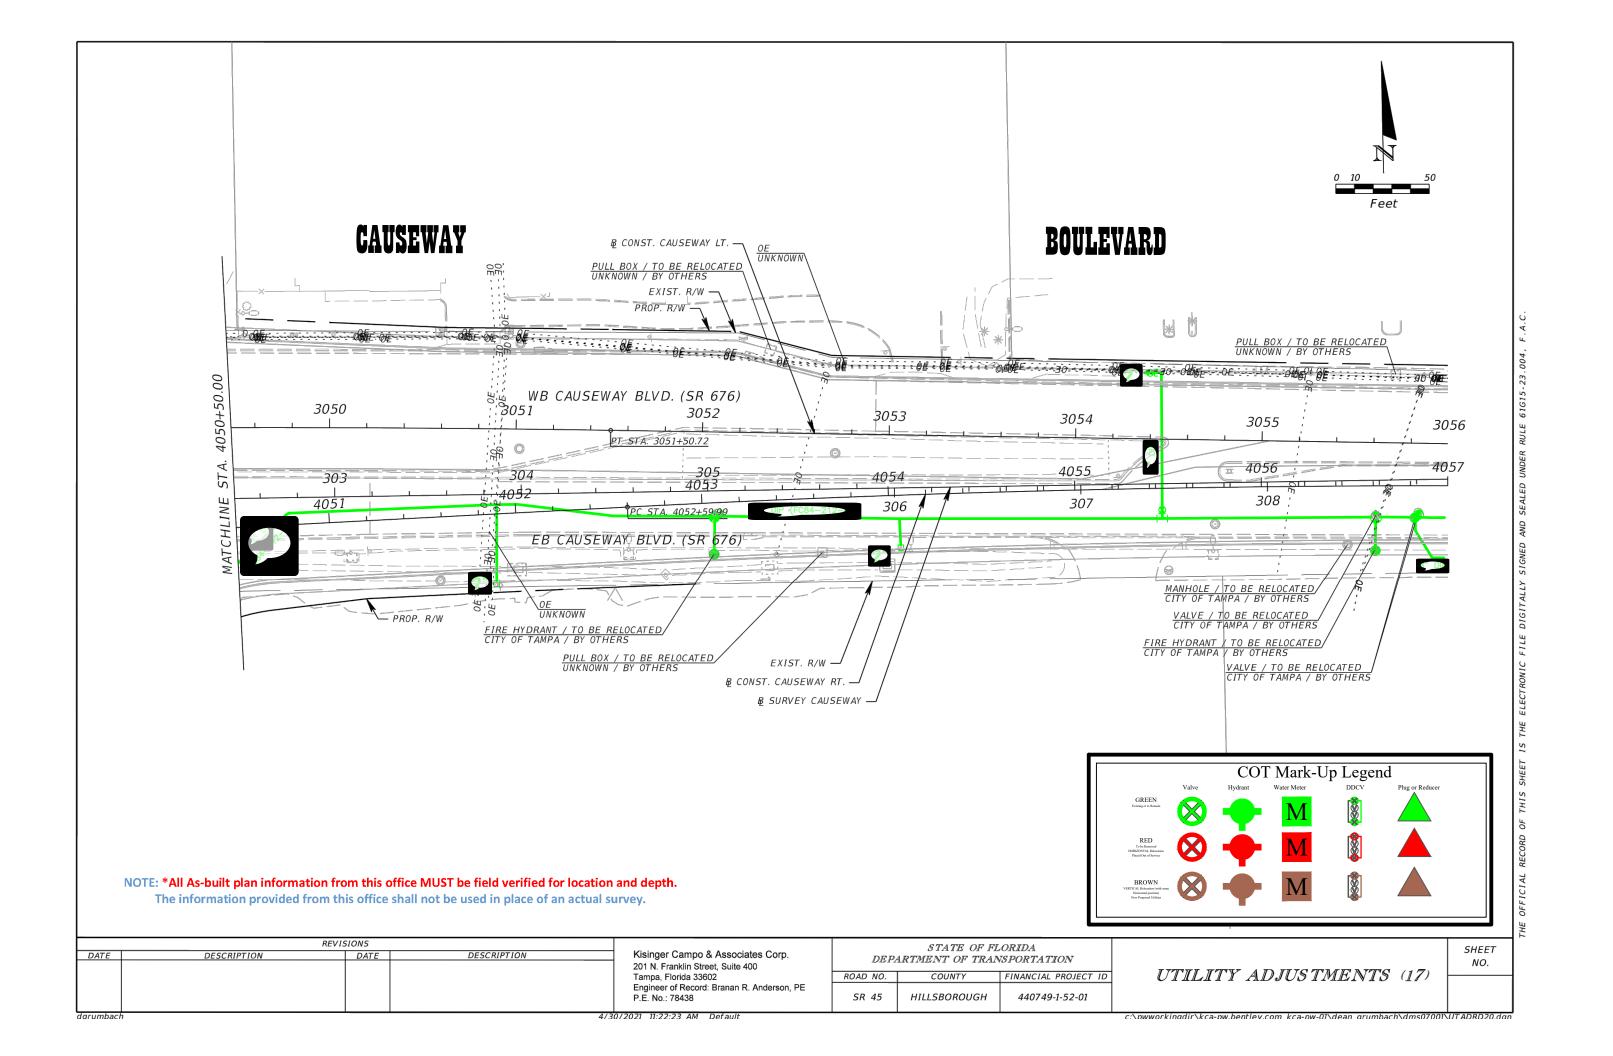


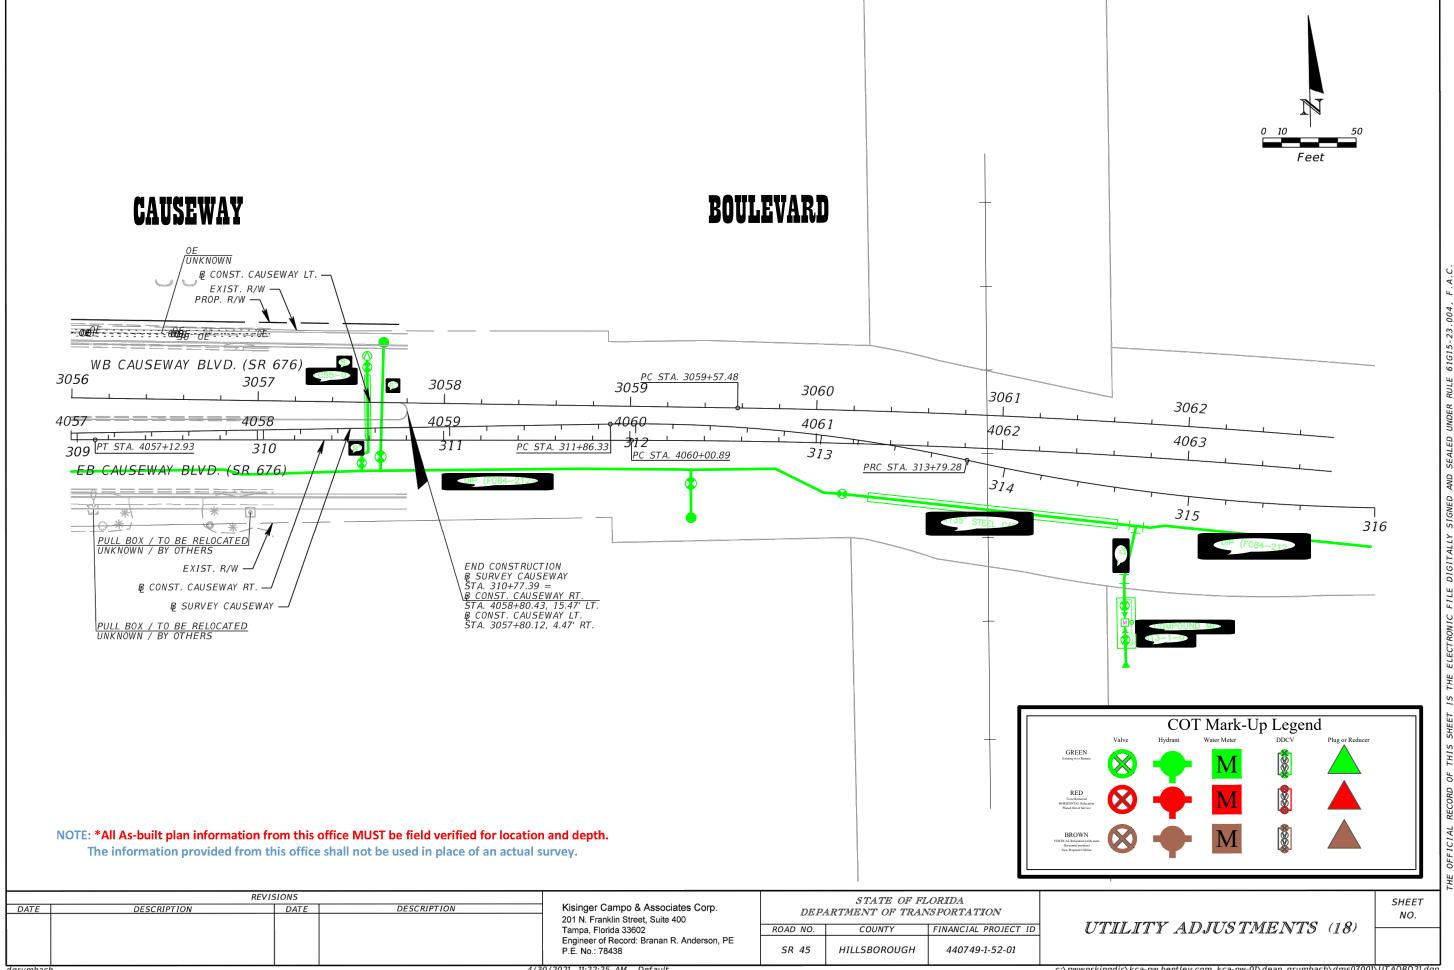

Wastewater Utility Map

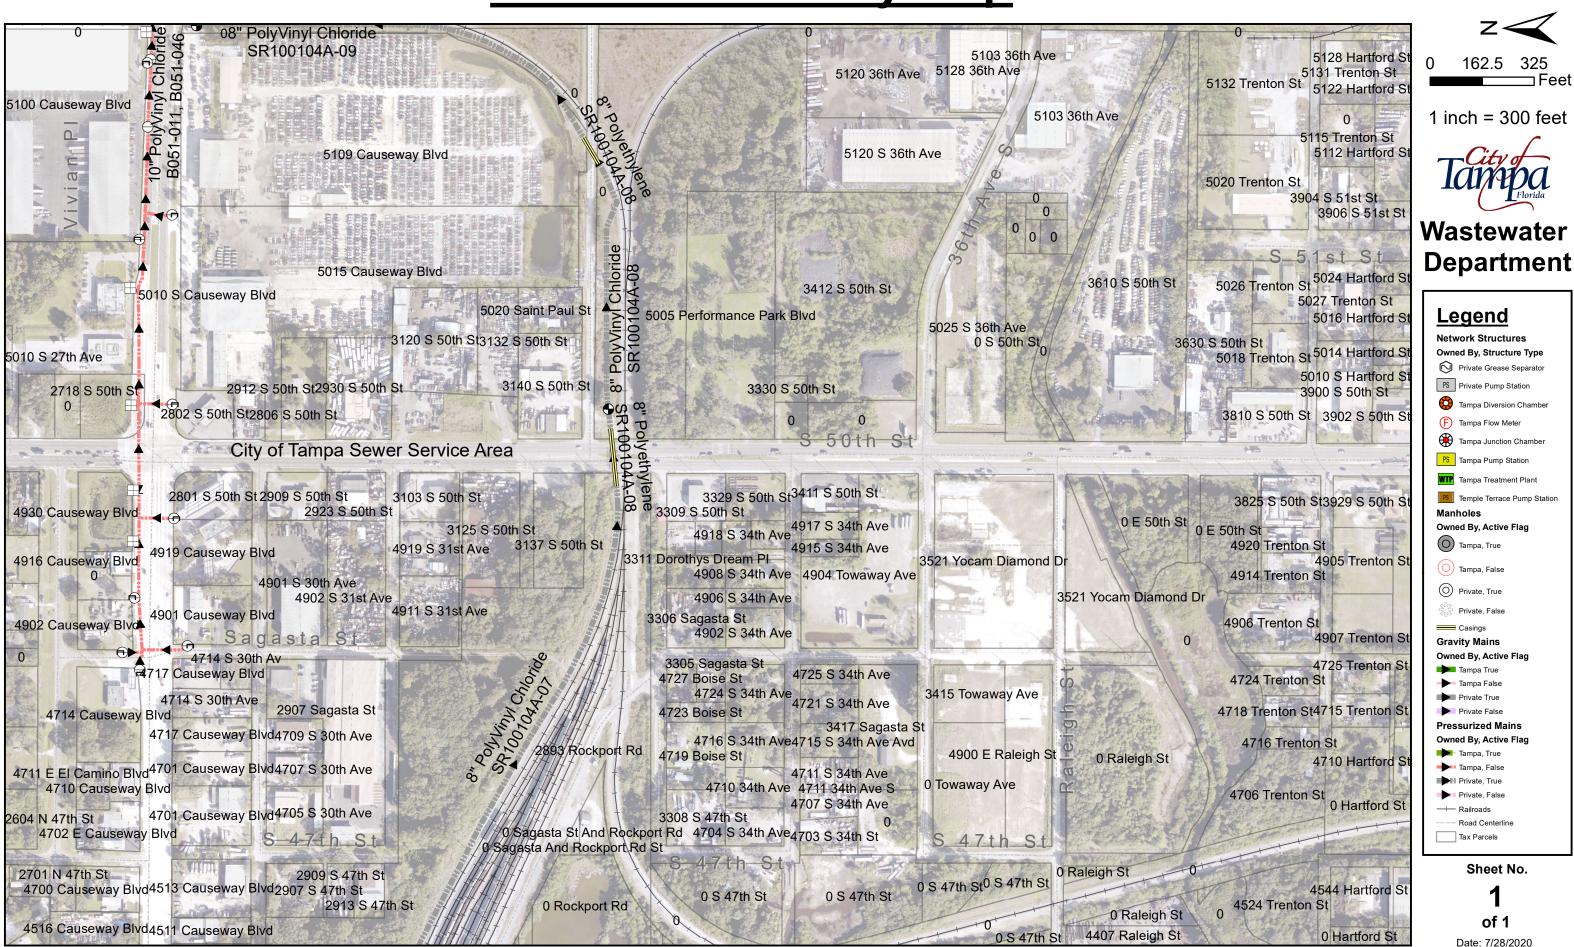

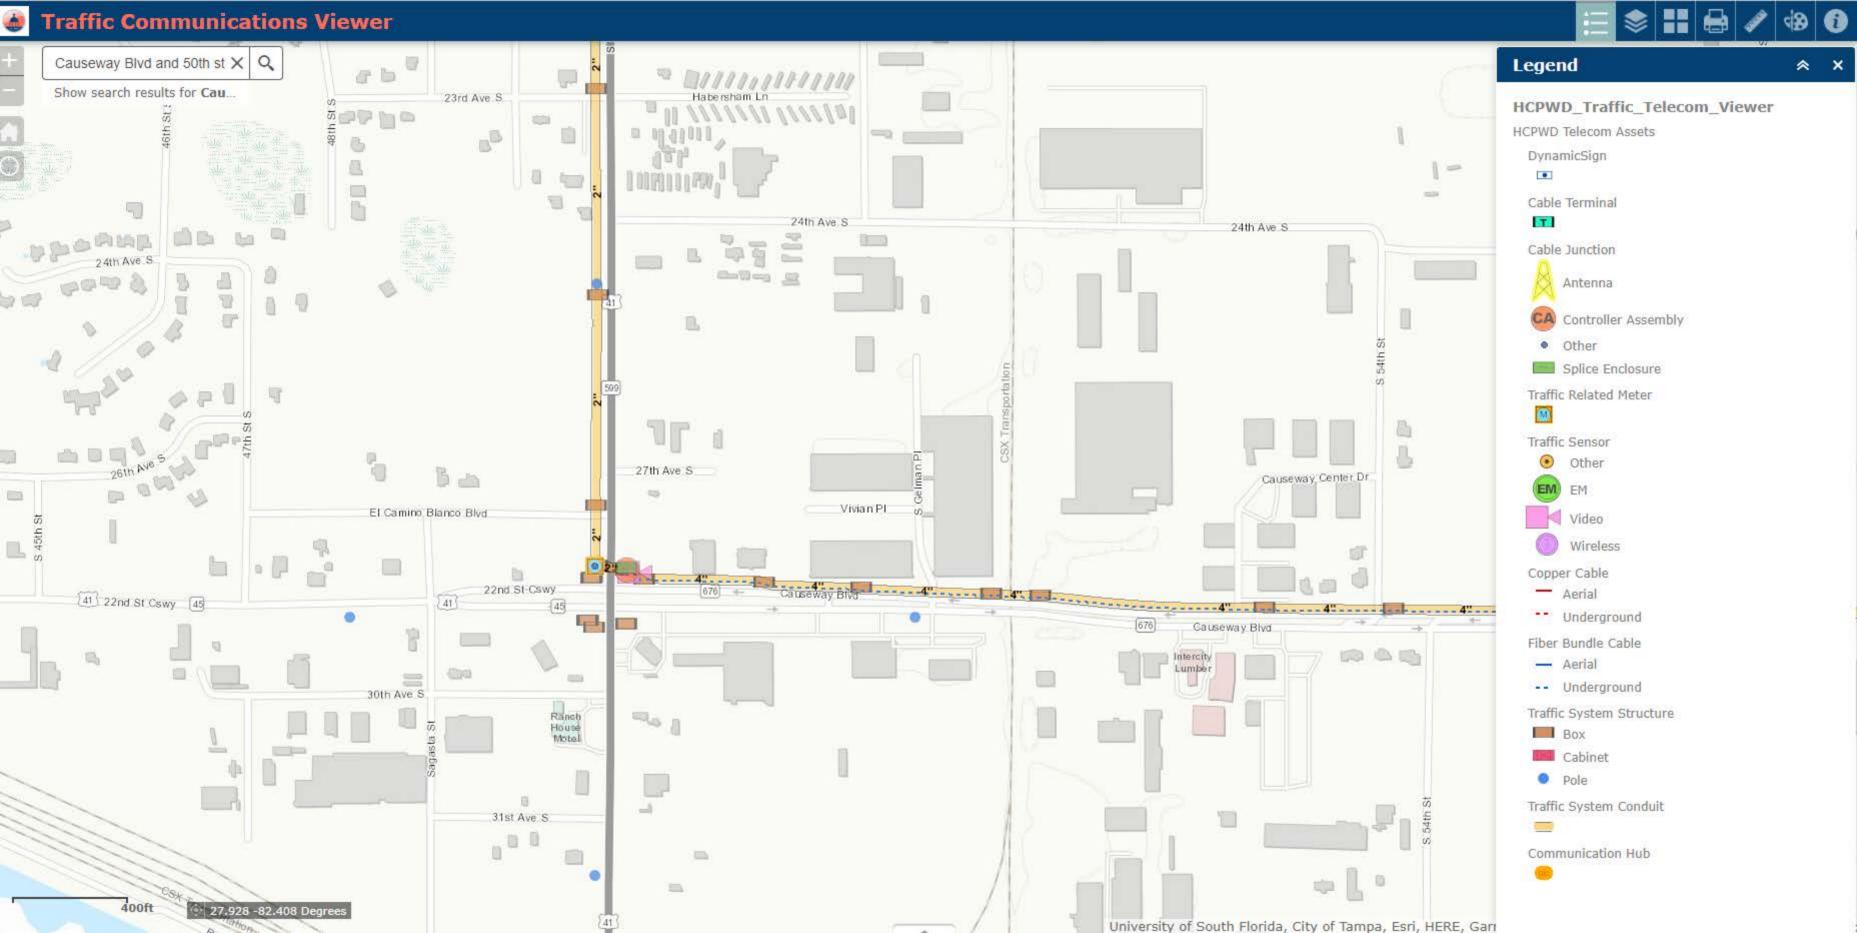

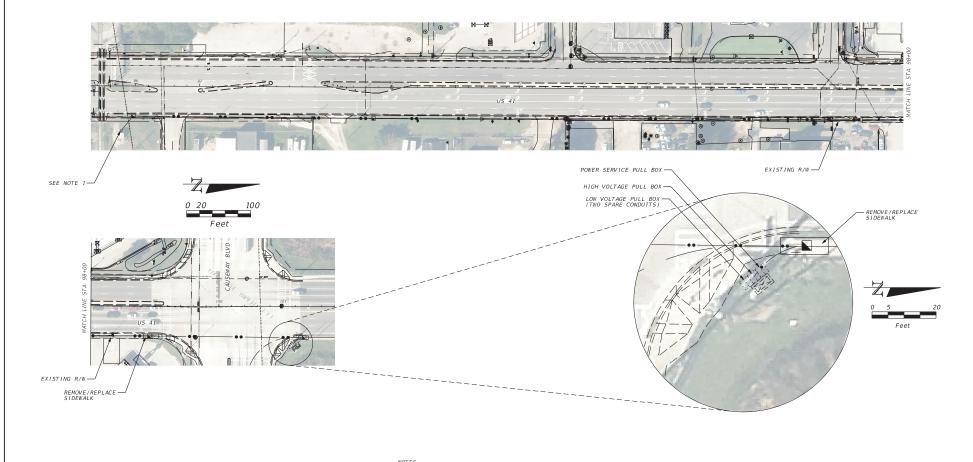


NOTES


- 1. COORDINATE WITH CSX FOR PREEMPT CABLE CONNECTION.
- 2. ENTER CONTROLLER CABINET THROUGH AVAILABLE 2 INCH SPARE FROM LOW VOLTAGE PULL BOX.
- 3. PROVIDE PREEMPTION PANEL AND CONNECTIONS AS NEEDED.
- 4. PROVIDE STEP DOWN TRANSFORMER FOR 24 VAC PREEMPT CABLE FEED. A 24 VAC ISOLATION RELAY IS REQUIRED FOR CONTROLLER PREEMPT INPUT.
- 5. PROVIDE AND IMPLEMENT PREEMPTION TIMINGS.
- 6. COORDINATE ALL WORK WITH HILLSBOROUGH COUNTY TRAFFIC AND FDOT.

1	REVIS	SIONS			STATE OF FI	ORIDA
DATE	DESCRIPTION	DATE	DESCRIPTION	DEP.	ARTMENT OF TRAI	
1						
1 1				ROAD NO.	COUNTY	FINANCIAL PROJECT ID
				SR 45	HILLSBOROUGH	
					Howard	.Holley

US 41 AT CAUSEWAY BLVD SIGNAL PREEMPTION


SHEET NO. 1 OF 1

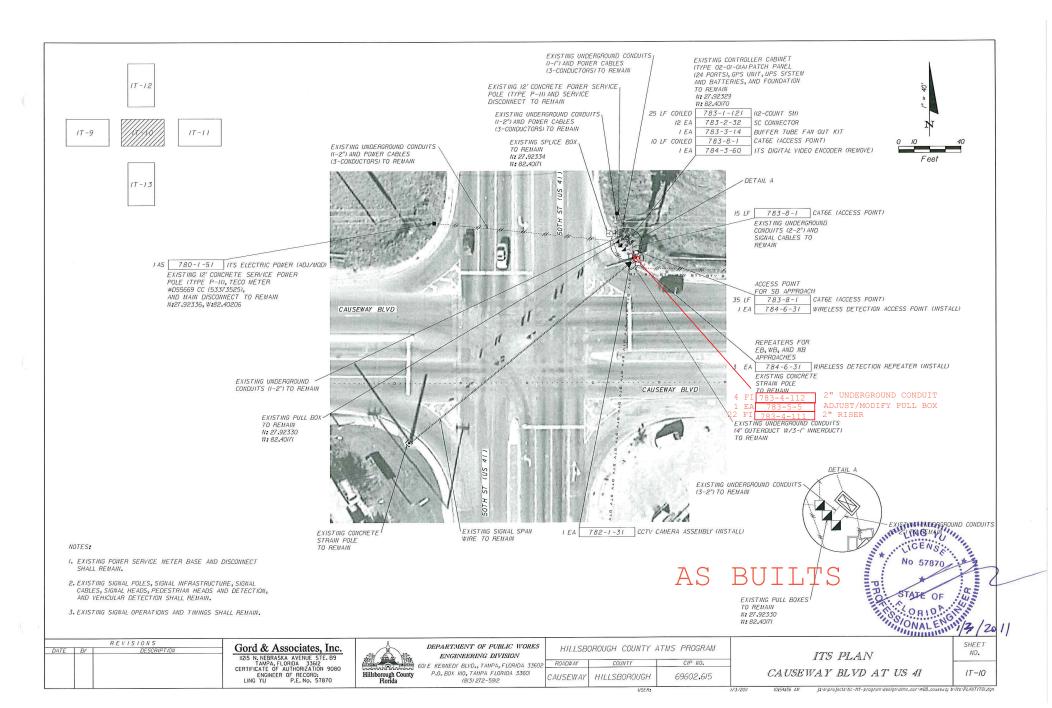


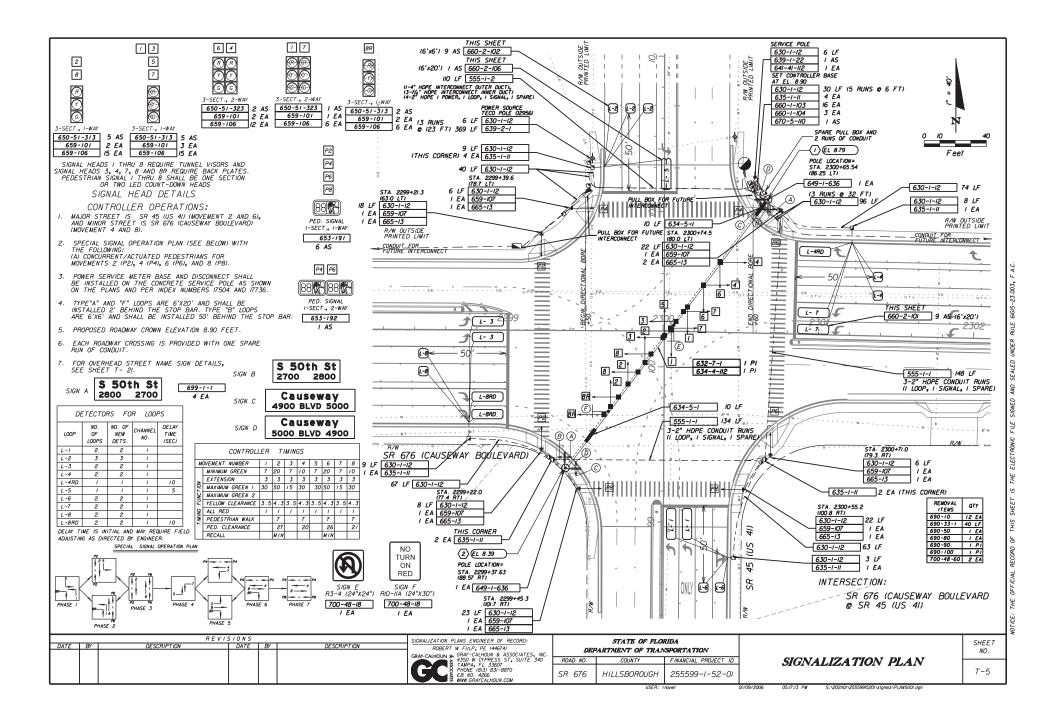

STATE OF FLORIDA DEPARTMENT OF TRANSPORTATION

CONTRACT PLANS

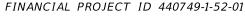

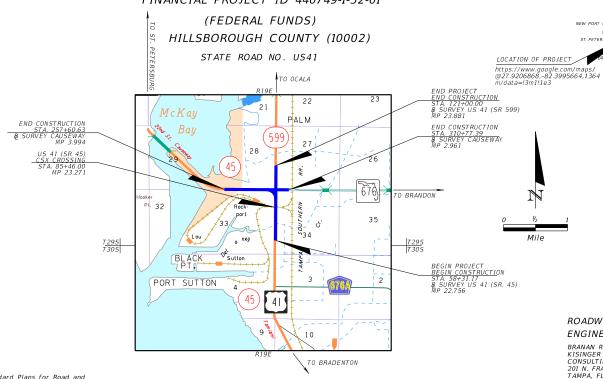

GOVERNING STANDARD PLANS:

Florida Department of Transportation, FY2021-22 Standard Plans for Road and Bridge Construction and applicable Interim Revisions (IRs).

Standard Plans for Road Construction and associated IRs are available at the $following\ website:\ http://www.fdot.gov/design/standardplans$

APPLICABLE IRS: N/A

Standard Plans for Bridge Construction are included in the Structures Plans Component

GOVERNING STANDARD SPECIFICATIONS:

Florida Department of Transportation, July 2022 Standard Specifications for Road and Bridge Construction at the following website: http://www.fdot.gov/programmanagement/Implemented/SpecBooks

ROADWAY PLANS ENGINEER OF RECORD:

BRANAN R. ANDERSON, P.E. NO.: 78438 KISINGER CAMPO AND ASSOCIATES CORP. CONSULTING ENGINEERS & PLANNERS 201 N. FRANKLIN STREET, SUITE 400 TAMPA, FLORIDA 33602 (813) 871-5331 VENDOR NUMBER.: F59-1677145


FDOT PROJECT MANAGER:


TIM O'BRIEN P.E.


CONSTRUCTION	FISCAL	SHEET
CONTRACT NO.	YEAR	NO.
TBD	21	


AYTONA REACH


LAUDERDALE

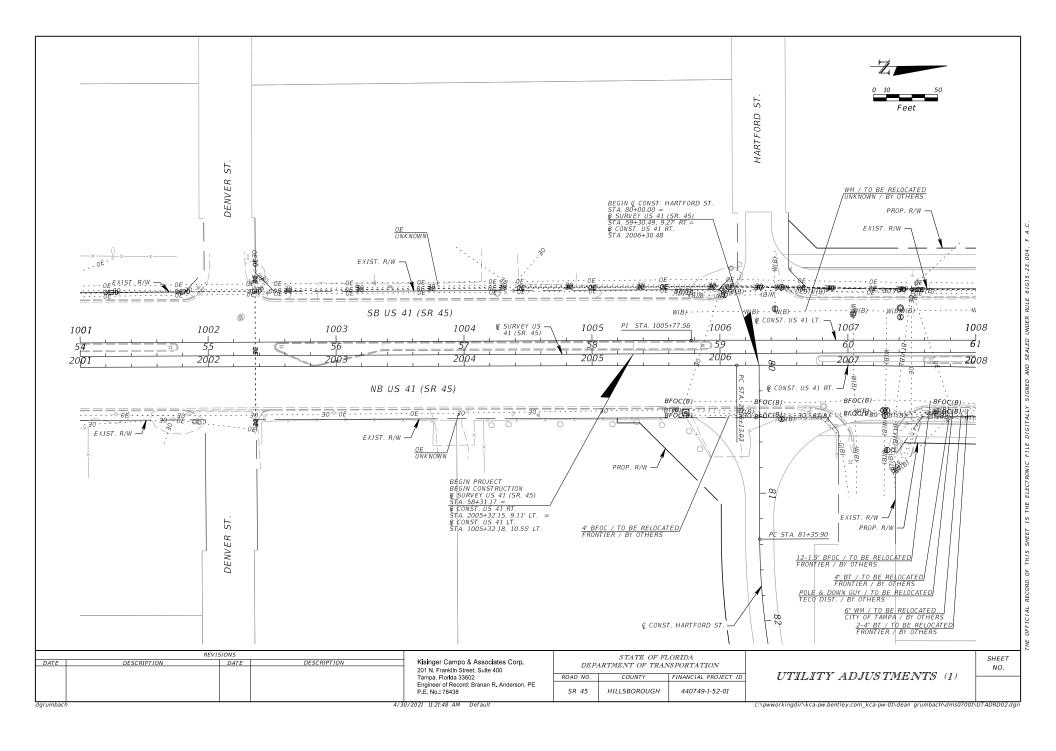


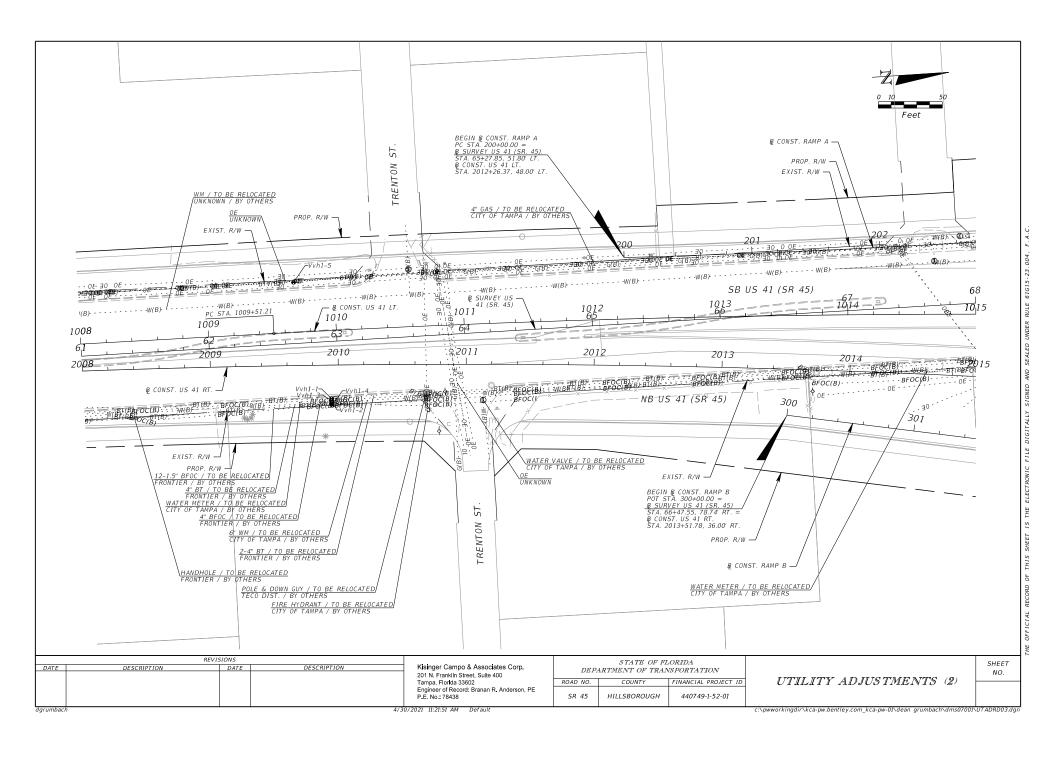


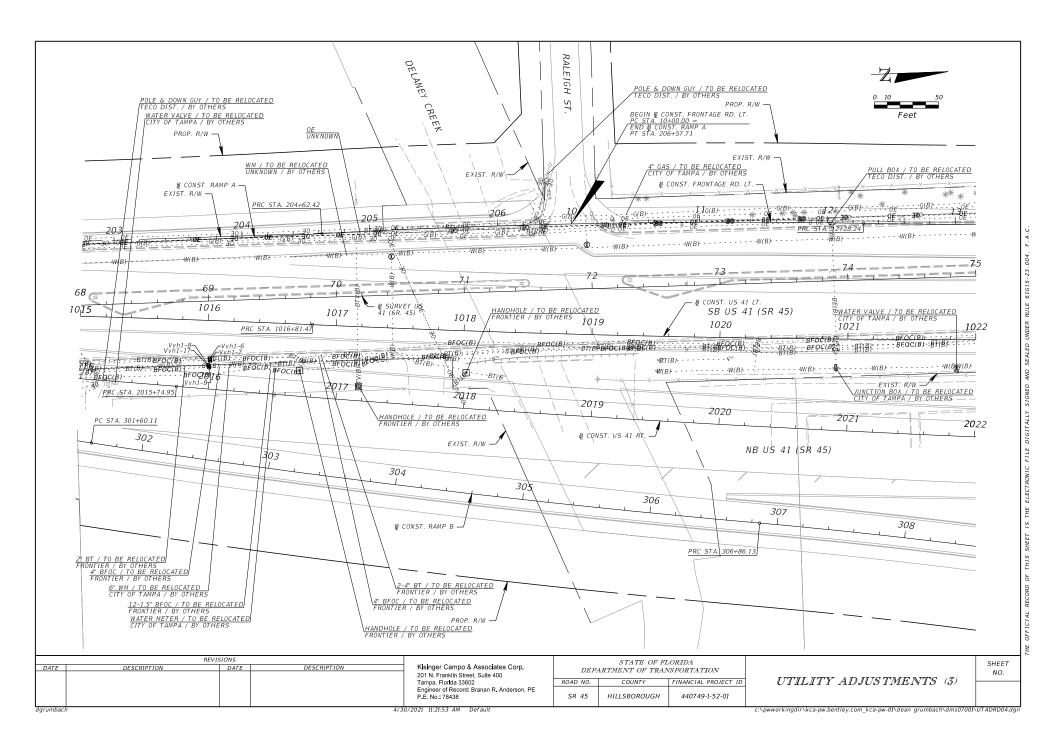


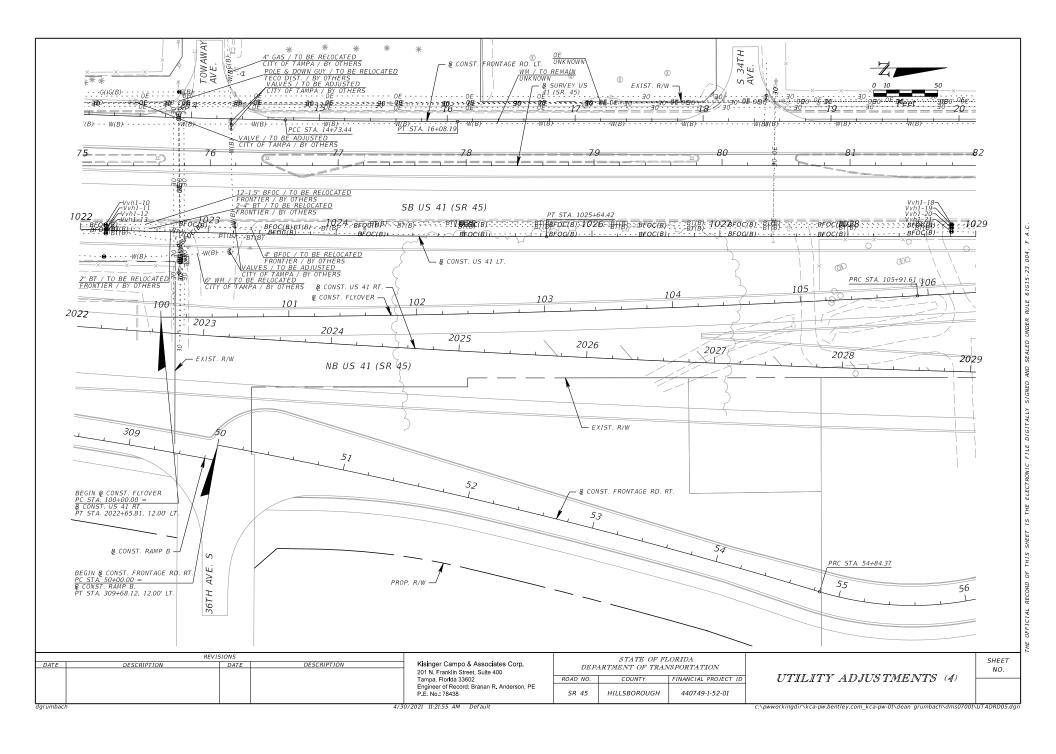


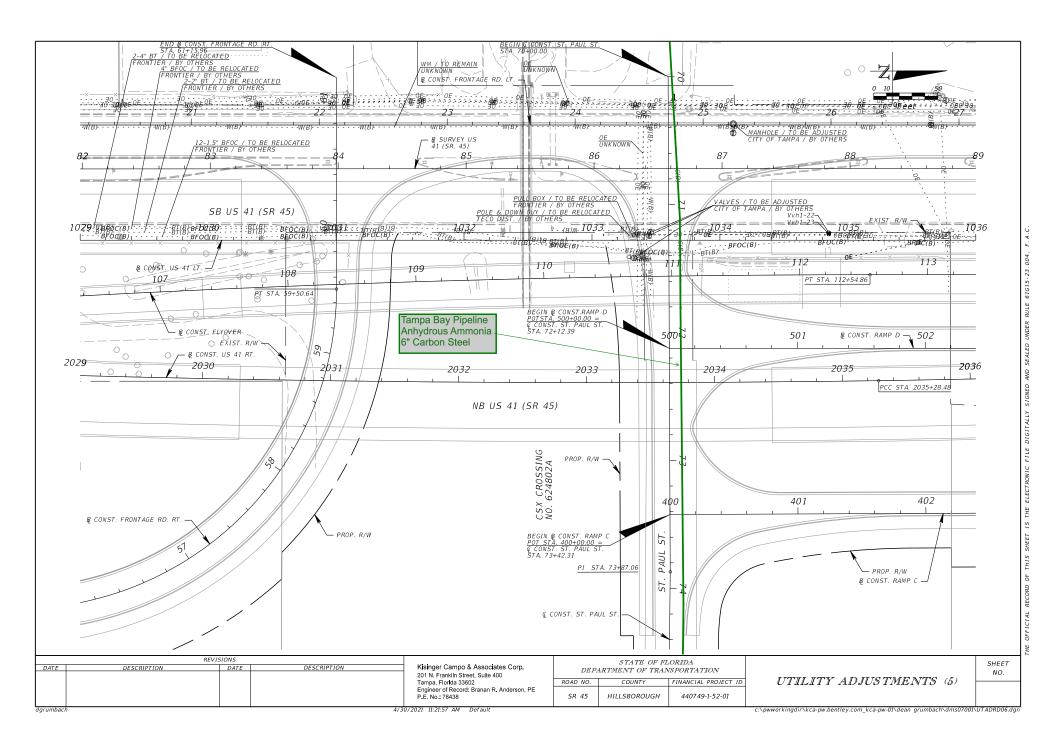


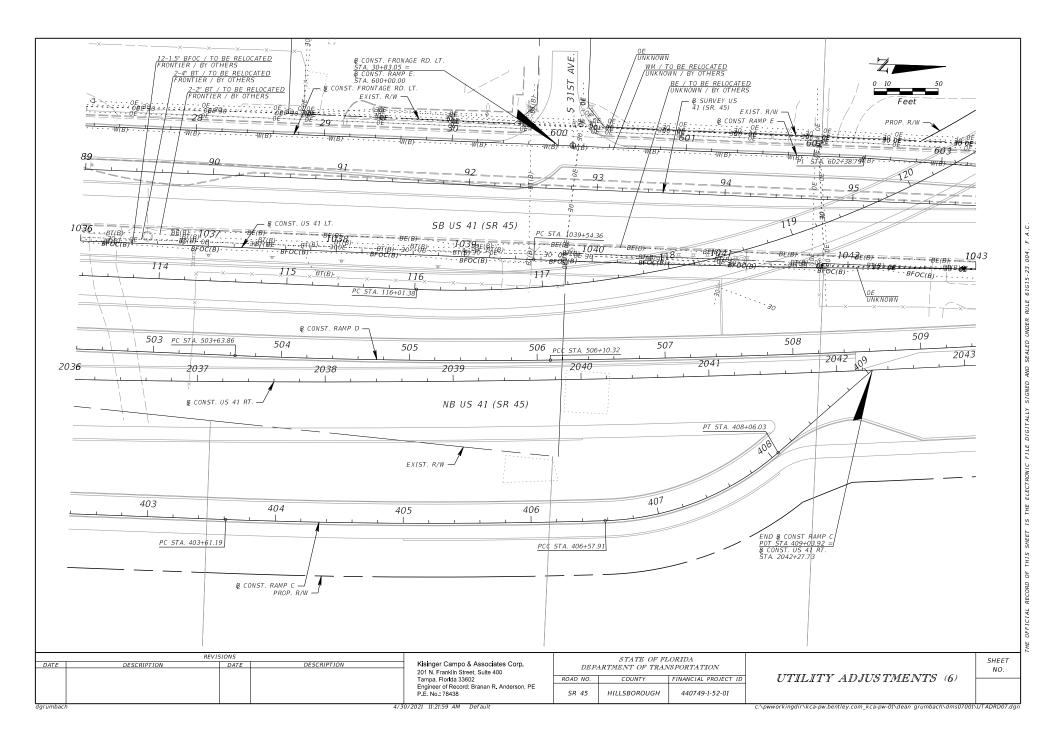


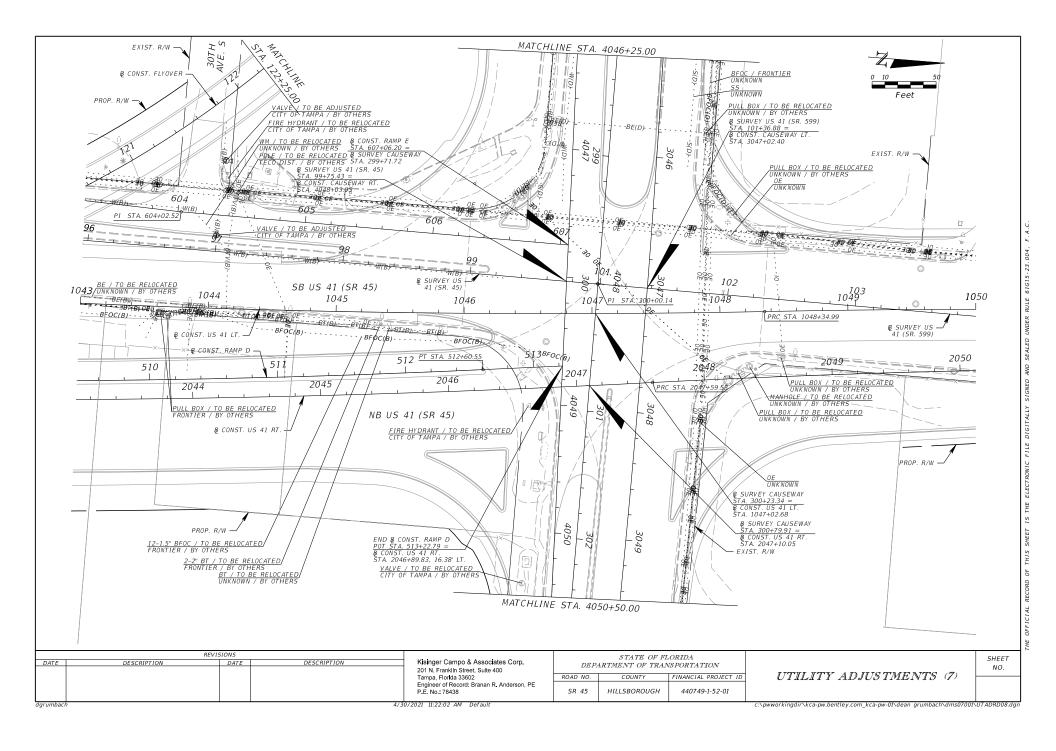


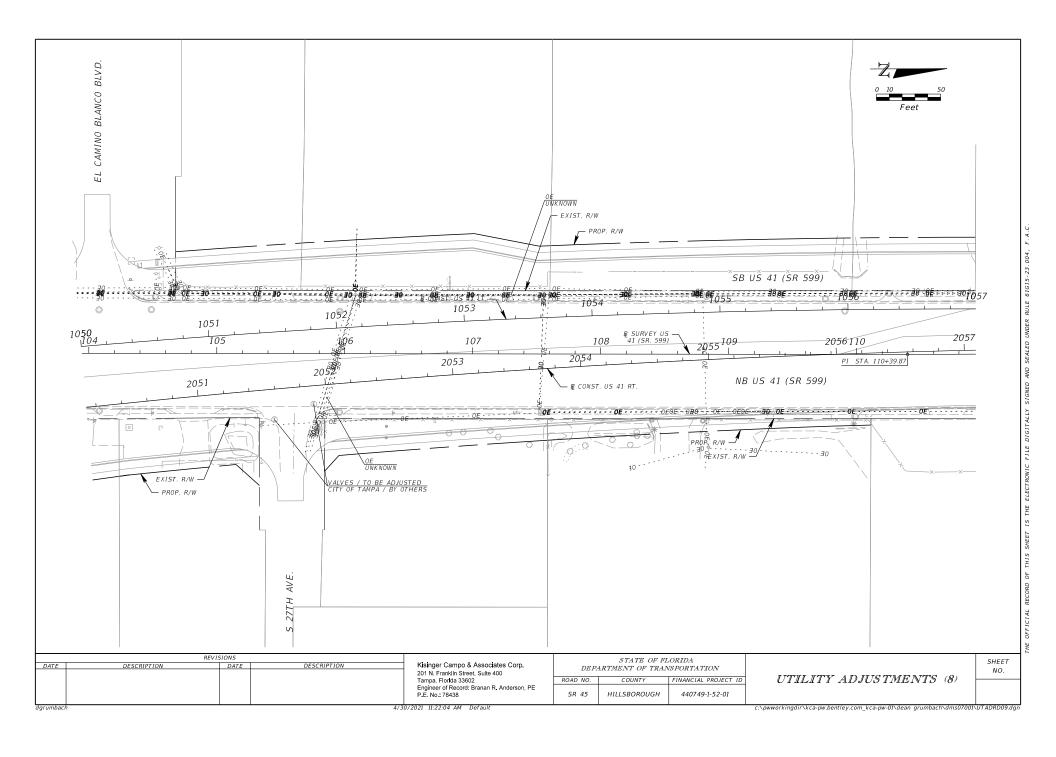


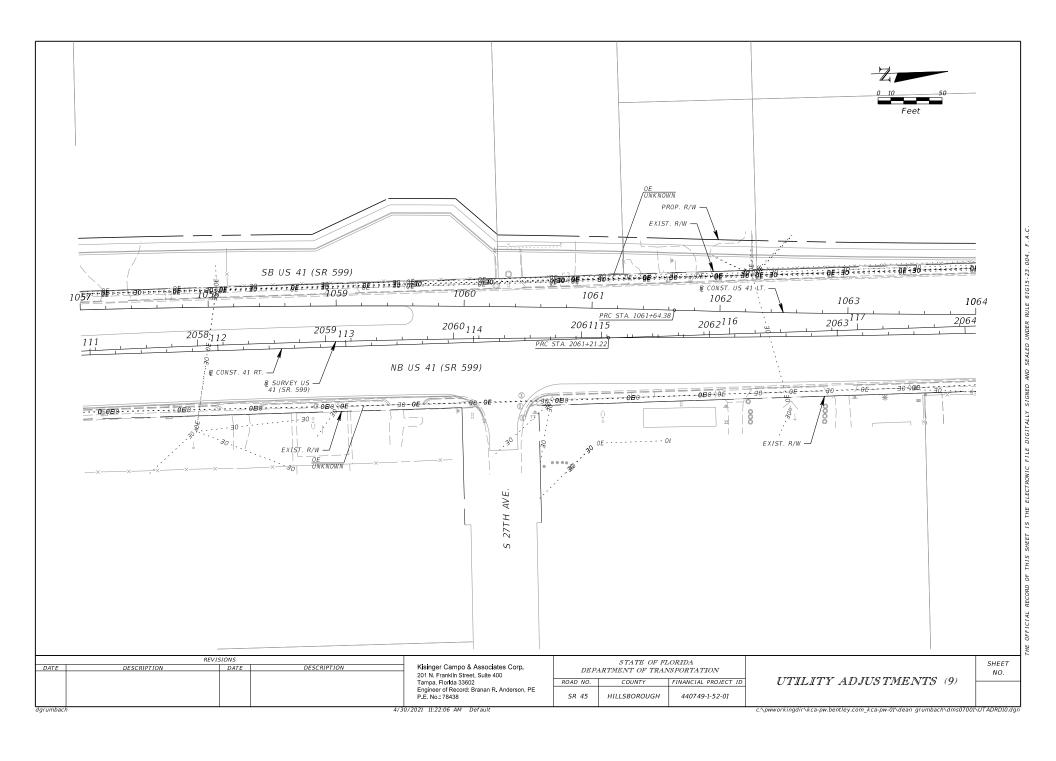


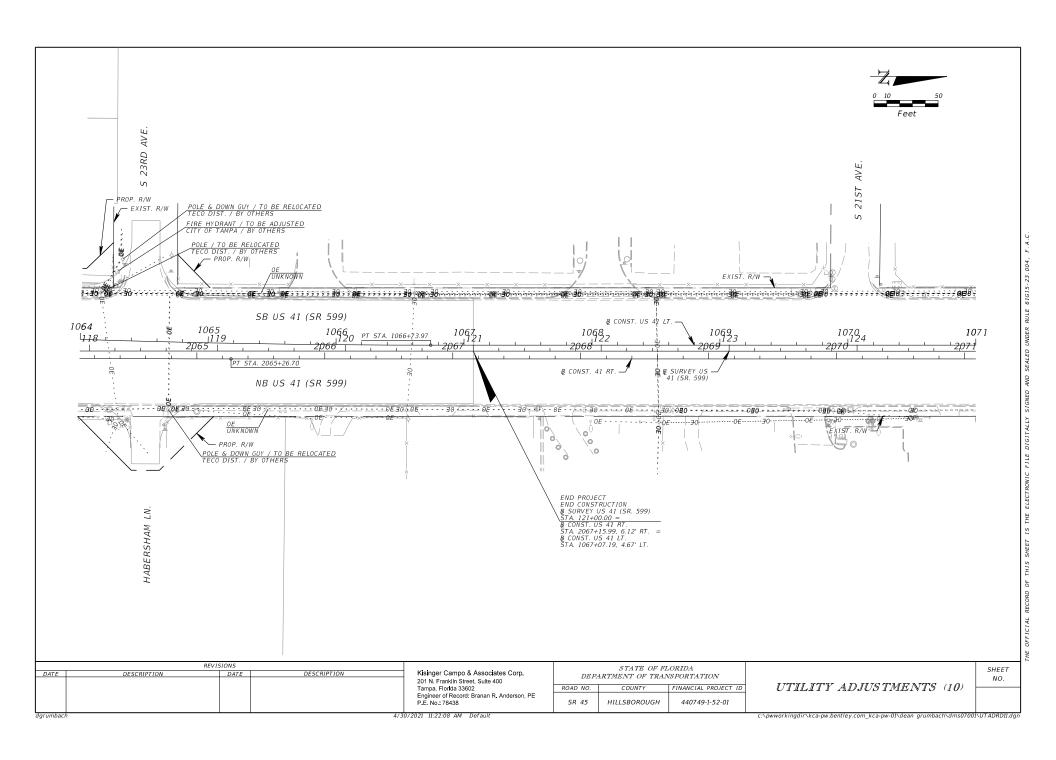


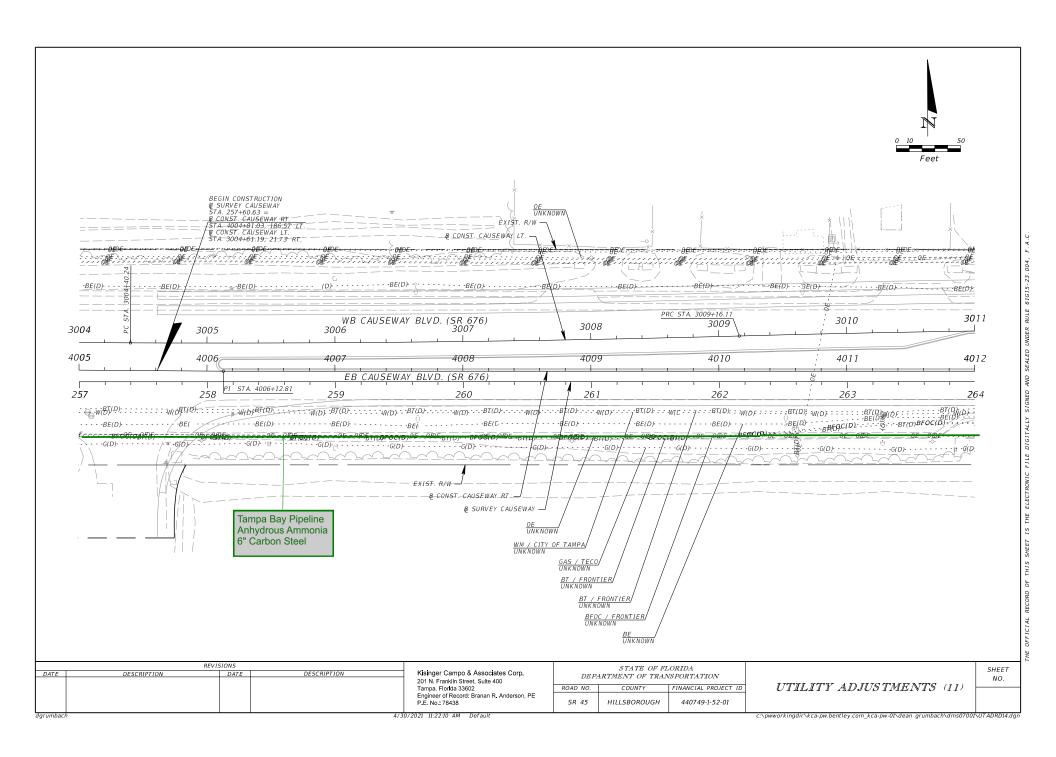


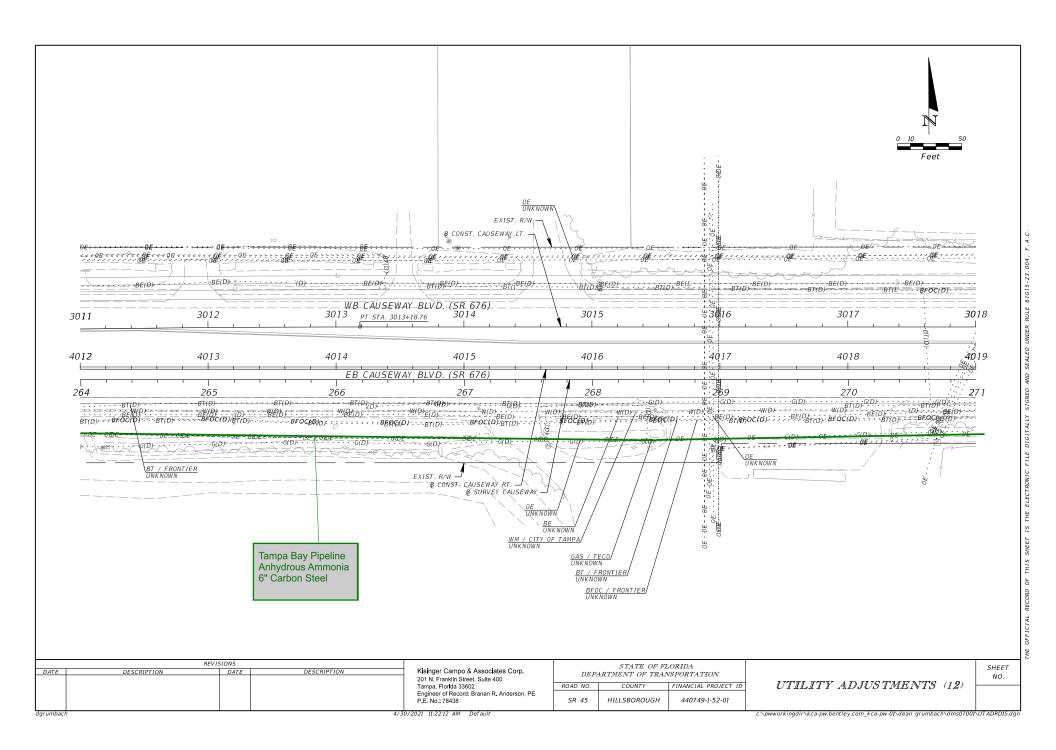


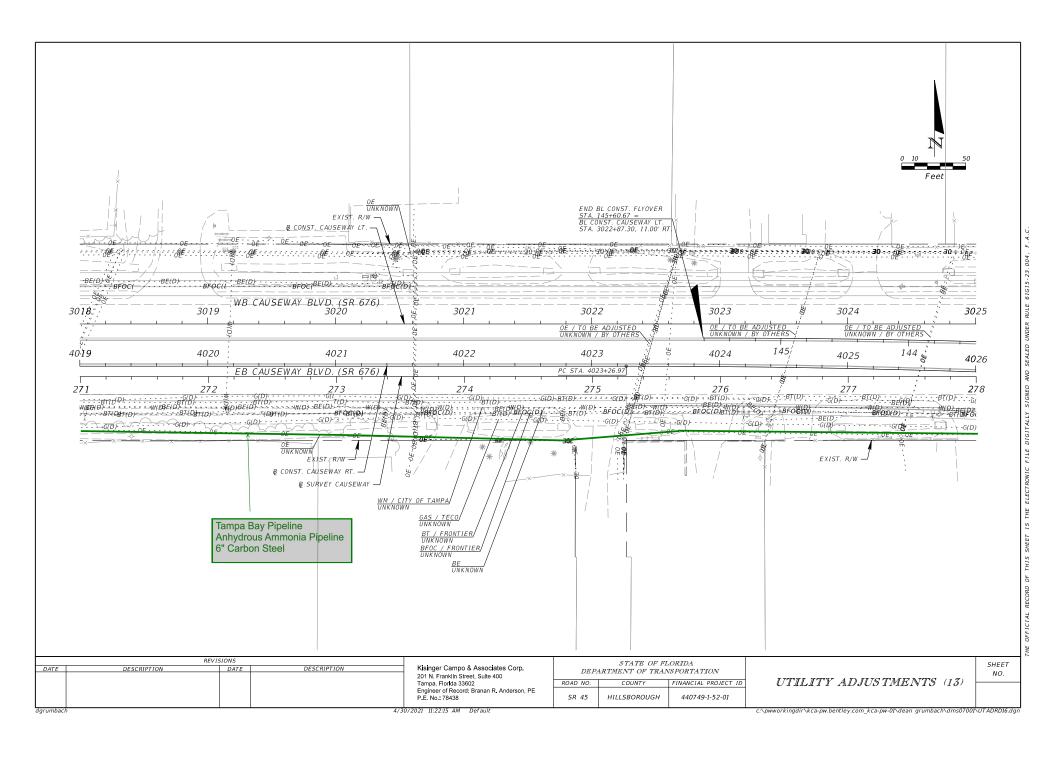


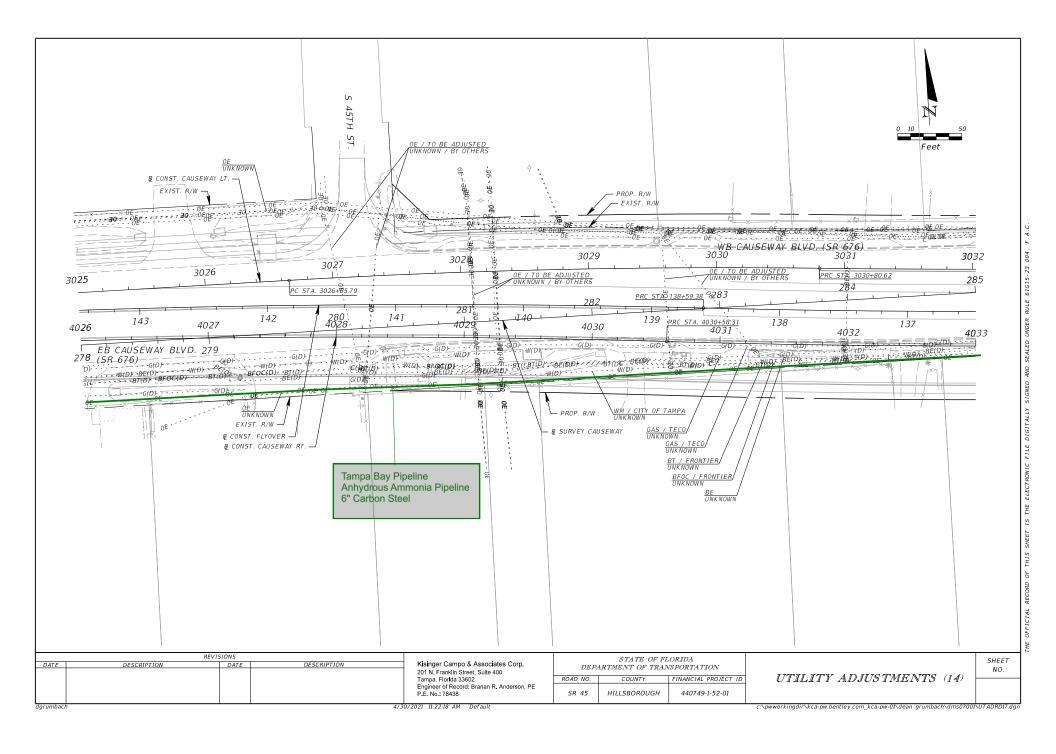

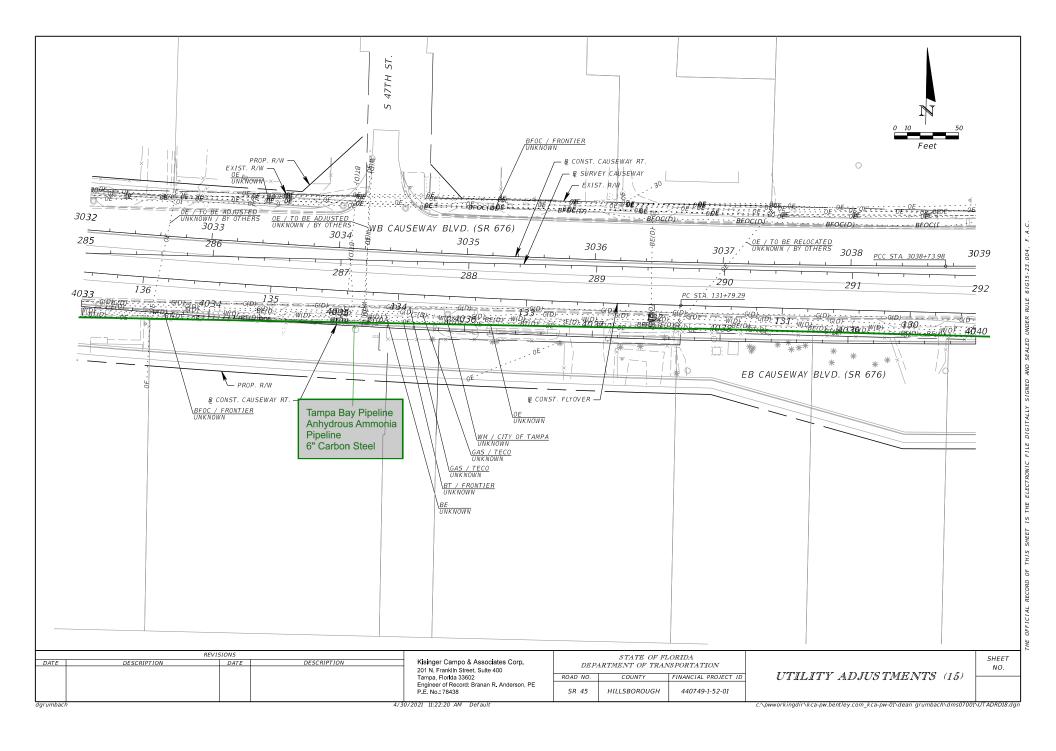

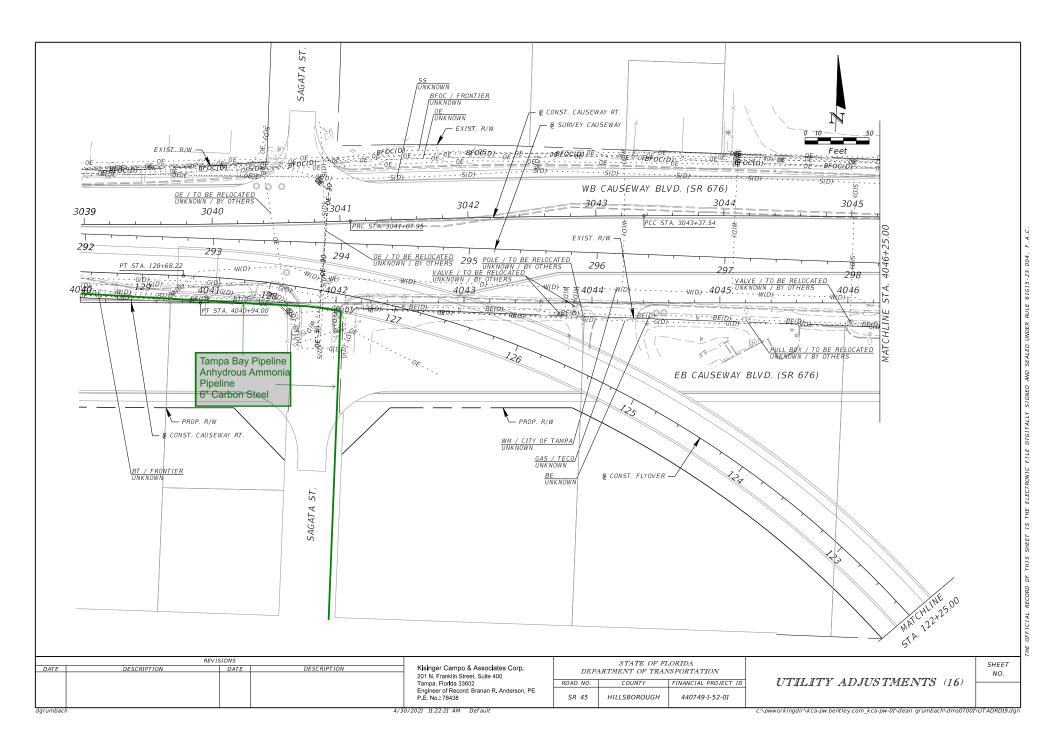

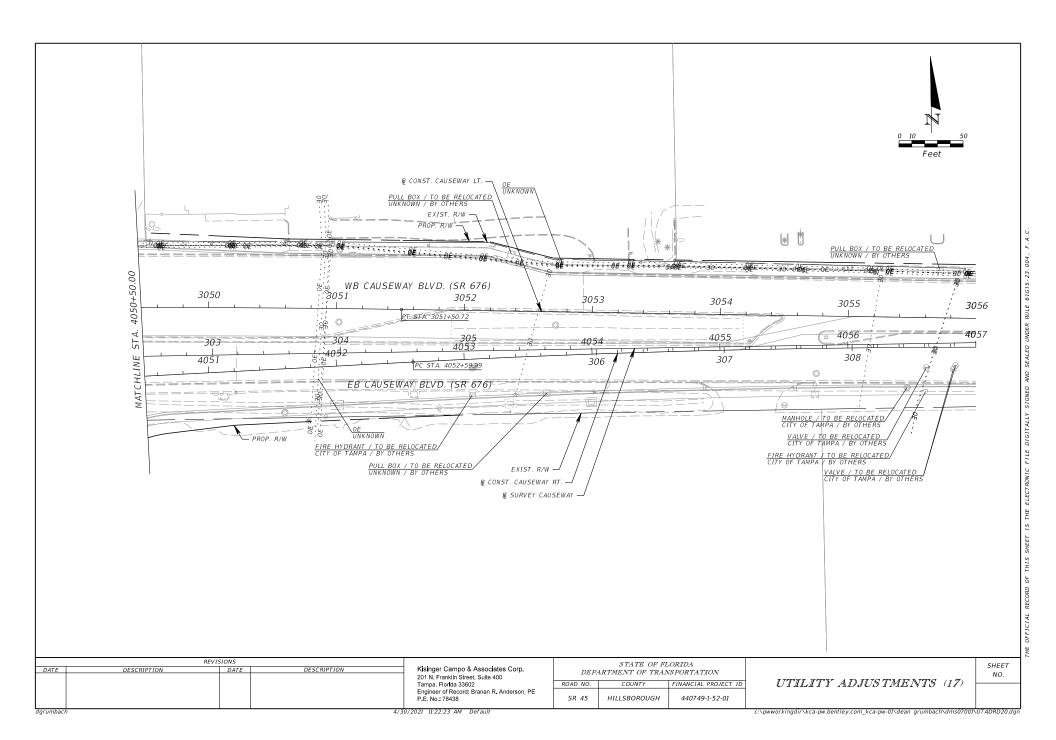

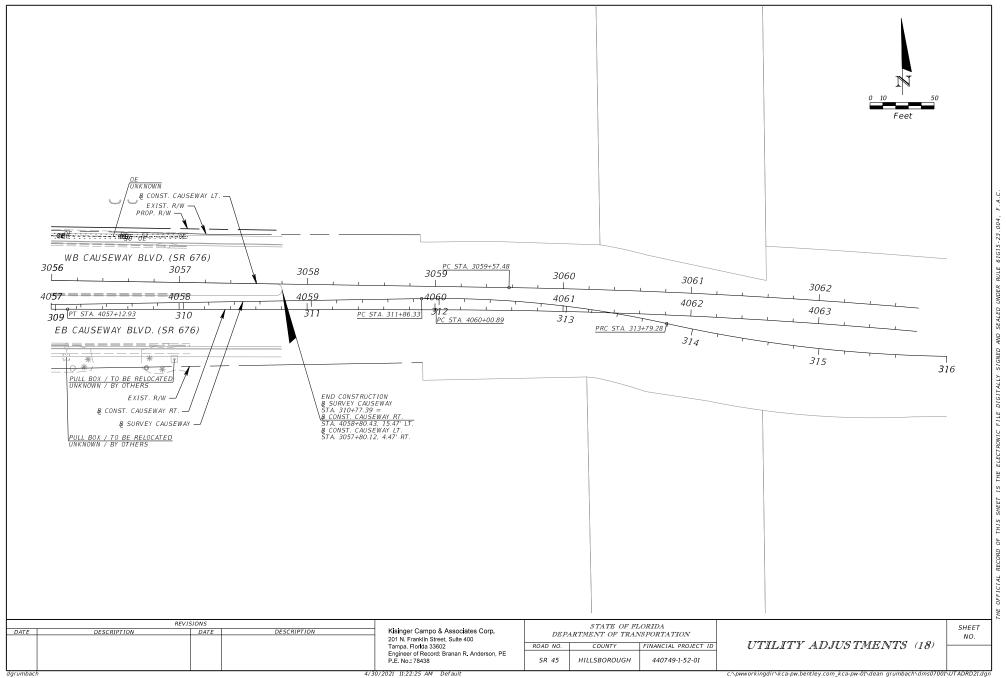

004
.23.
:ULE 61G15-23.004
RULE 6
UNDER
SEALED U
AND S
IGNED AN
ILE DIGITALLY SIGNED AND SEA
'ALLY
DIGIT
FILE
ECTRONIC
THE E
SI
SHEET 1S
THIS SI
OF
RECORD (
OFFICIAL
THE OF

SHEET

NO.

Date:		12	2/04/2018				Test Hol	e Data Reno	ort			Crew Me	mbers:		DW, TG
ECHO Pro	iect #:		18-252	Test Hole Data Report 16514 N. Dale Mabry Hwy. ECHO UES, Inc. Cit				City. Stat	City, State: Tampa, Florid						
Financial F			N/A		Tampa, Florida			CH		www.echoues.com			Location:		US 41
Truck No.:			D-3/T-2		E. SR434, Ste.		ITILITY ENG	INICEDING	CHDVEY	888.778 - GROW, INSPIRE, MA			te Unit of Meas	uro: II	S Survey Feet
Truck No.		Ailia - T		Win	ter Springs, Flo	1100 32700		INEERING &	SURVEY						
BE = Buried		Itility Type			AC = Transite	Utility	Material	less		Identif HUB = Survey Hub	iea By:		oreviations	Offset Mea	
GM = Gas M		RW = Reclai SL = Street I			CI= Cast Iron		FIBG = Fiberg	iass Density Polyet	bulono Bino	IRC = Iron Rod & Cap	"COUNTEST HOLE"	N/A = Not		EP= Edge of Pav BC = Back of Cur	
BT = Buried		TS = Traffic	_		CP = Concrete P	lina	PE = Polyethy		.nyiene ripe	NL = Nail & Disk "ECI		Datum		BL = Baseline of	
FOC = Fiber	_	FL = Fuel Lir	-		DBC = Direct Bu		PVC = Polyvir			SLEEVE = Sleeve	NO TEST HOLE		orth American	COORD = Survey	
WM = Wate		GS = Gas Se			CMP = Corrugat		STL = Steel	iyi cilionae		X = "X" in Concrete		Vertical Da		CL = Centerline	y Cooldinates
SAN = Sanita		WS = Water			CONC = Concre		VCP = Vitrifie	d Clay Pino		Surfac	e Tyne	UNK = Unk		HUB = Survey H	ub
STM = Storn			own Utility		CPP = Corrugate			ressed Cylinde	r Concrete	ASPH = Asphalt	стурс	COT = City		RW = Right of W	
CATV = Cabl			d Electrical D	luct	DCT = Duct	ed Flastic Fips	Pipe Prest	ressea cylinae	Concrete	CONC = Concrete		COT - City		ST = Swing Ties	, uy
FM = Force I			d Telephone		DIP = Ductile Iro	n Pine		rced Concrete	Pine	NG = Natural Ground	4			X = "X" in Concre	ete
1111 - 10100	viuiii	DID - Danie	Utility Size	Utility	Dir - Duccile ire	N	rici – ricinio	cea concrete		rio - riatarar oroani		Horizontal:	NAD83/11		
Test Hole	Utility Type	Utility	Outside	Manual	Cross	+	Identified Ru	Surface Type	Surface Thickness	Apparent Utility	Datums:	Vertical:	NAVD88	Ground	Utility
rest noie	Othicy type	Material	Diameter	Depth	Sectional View		identified by	ourrace Type	inches	Owner	Northing		Easting	Elevation	Elevation
			inches	feet		Utility Direction			mones		Northing	_	Lasting		
1-1	вт	PVC	2 - 4"	3.26'	00	Į.	IRC	NG	N/A	FRONTIER	1301204.90'		526413.67'	7.51'	4.25'
1-2	WM	CI	6"	3.30'		1	IRC	NG	N/A	СОТ	1301205.19		526416.74'	7.48'	4.18'
1-3	FOC/BT	PVC	4"	2.47'		‡	IRC	NG	N/A	FRONTIER	1301204.95		526415.25'	7.48'	5.01'
1-4	FOC	PE	12 - 1.5"	8.80'	%8888°		IRC	NG	N/A	FRONTIER	1301205.12		526418.96'	7.36'	-1.44'
1-5	CATV	PVC	2 - 2"	5.54'	00	1	IRC	NG	N/A	SPECTRUM	1301181.11'		526321.06'	6.85'	1.31'
1-6	ВТ	PVC	2 - 4"	3.44'	00	1	IRC	NG	N/A	FRONTIER	1301811.38		526417.02'	6.84'	3.40'
1-7	FOC/BT	PVC	4"	2.42'		1	IRC	NG	N/A	FRONTIER	1301811.47		526418.97'	6.84'	4.42'
1-8	WM	UNK	UNK	10.06'		†	IRC	NG	N/A	сот	1301810.12		526422.34'	6.83'	-3.23'
1-9	FOC/BT	PVC	4"	3.34'		†	IRC	NG	N/A	FRONTIER	1301810.56		526424.00'	6.49'	3.15'
						·									
Notes:	Notes: 1-8 - Unable to visually verify size and matterial due to depth and groundwater. Possible 6" cast iron.														
												Prepai	red by: EE	Date: 02/12/20	019
												- -		Date: 02/12/2	2019
													-		

STATE OF FLORIDA DEPARTMENT OF TRANSPORTATION

FINANCIAL PROJECT ID

440749-1-52-01

COUNTY

HILLSBOROUGH

ROAD NO.

SR 45

Kisinger Campo & Associates Corp. 201 N. Franklln Street, Sulte 400 Tampa, Florlda 33602 Engineer of Record: Branan R. Anderson, PE P.E. No.: 78438 dgrumbach 4/30/2021 11:22:27 AM Default

DESCRIPTION

REVISIONS

DATE

DESCRIPTION

DATE

c:\pwworkingdir\kca-pw.bentley.com_kca-pw-01\dean grumbach\dms07001\UTADRD00.dgn

UTILITY ADJUSTMENTS (19)

F.A
UNDER RULE 61G15-23.004,
AND SEALED
SIGNED
THE OFFICIAL RECORD OF THIS SHEET IS THE ELECTRONIC FILE DIGITALLY SIGNED AND SEALED UNDER RULE 61G15-23.004,
RECORD
THE OFFICIAL
7

Date:		12	2/05/2018				Test Ho	e Data Repo	ort			Crew Members:		DW, TG
ECHO Pro	iect #:		18-252	·			City, State:	T	ampa, Florida					
Financial Project#: N/A			Tampa, Florida			CH		www.echoues.com		General Location:		US 41		
Truck No.	,		D-3/T-2		L E. SR434, Ste.		ITILITY ENG	INFEDING 8	CLIDVEY	888.778 - GROW, INSPIRE, MA		Coordinate Unit of Mea	cure: II	S Survey Feet
TTUCK NO.		Milian Trops		Win	ter Springs, Flo	1100 32700		INEERING &	SURVET	Identif		Abbreviations	Offset Mea	· .
BE = Buried		RW = Reclai			AC = Transite	Utility	Material FIBG = Fibers	rlace		HUB = Survey Hub	led by:	N/A = Not Applicable	EP= Edge of Pav	
GM = Gas M		SL = Street l			CI= Cast Iron			Density Polyet	hylana Dina	IRC = Iron Rod & Cap	"ECHO TEST HOLE"	NAD = North American	BC = Back of Cur	
BT = Buried		TS = Traffic	-		CP = Concrete P	line	PE = Polyeth		inyiene ripe	NL = Nail & Disk "ECH		Datum	BL = Baseline of	
FOC = Fiber		FL = Fuel Lir			DBC = Direct Bu		PVC = Polyvii			SLEEVE = Sleeve	IIO TEST TIOLE	NAVD = North American	COORD = Surve	
WM = Wate		GS = Gas Se			CMP = Corrugat		STL = Steel	Tyr emorrae		X = "X" in Concrete		Vertical Datum	CL = Centerline	Coordinates
SAN = Sanita		WS = Water			CONC = Concret		VCP = Vitrifie	d Clav Pipe		Surface	e Type	UNK = Unknown	HUB = Survey H	ub
STM = Storn		UNK = Unkr	own Utility		CPP = Corrugate			ressed Cylinde	r Concrete	ASPH = Asphalt	,	COT = City of Tampa	RW = Right of W	/ay
CATV = Cabl	e Television	BED = Burie	d Electrical D	uct	DCT = Duct		Pipe	,		CONC = Concrete			ST = Swing Ties	
FM = Force	Main	BTD = Burie	d Telephone		DIP = Ductile Iro	on Pipe	RCP = Reinfo	rced Concrete	Pipe	NG = Natural Ground	d		X = "X" in Concr	ete
			Utility Size	Utility		Ņ			Surface		Datums:	Horizontal: NAD83/1	1	
Test Hole	Utility Type	Utility Material	Outside	Manual	Cross	\Rightarrow	Identified By	Surface Type	Thickness	Apparent Utility	Datums.	Vertical: NAVD8	Ground	Utility
		Material	Diameter inches	Depth feet	Sectional View	Utility Direction			inches	Owner	Northing	Easting	Elevation	Elevation
1-10	FOC	PE	12 - 1.5"	3.96'	000 0000 0000	1	IRC	NG	N/A	FRONTIER	1302430.03	526421.52'	6.62'	2.66'
1-11	ВТ	PVC	2 - 4"	2.50'	00	\$	IRC	NG	N/A	FRONTIER	1302430.50'	526424.77'	6.68'	4.18'
1-12	FOC/BT	PVC	4"	1.90'	\circ	\^	IRC	NG	N/A	FRONTIER	1302430.47'	526425.15'	6.69'	4.79'
1-13	ВТ	DBC	2"	1.56'	0	\(\)	IRC	NG	N/A	FRONTIER	1302430.15'	526428.11'	6.81'	5.25'
1-14	WM	DIP	6"	3.40*		\updownarrow	IRC	NG	N/A	сот	1302428.62'	526446.38"	8.20'	4.80'
1-15	GM	STL	4"	3.00'			IRC	NG	N/A	сот	1302488.18'	526318.06'	6.08'	3.08'
1-16	ВТ	PVC	4"	3.50*	\circ		IRC	NG	N/A	FRONTIER	1301205.22'	526417.96	7.50'	4.00'
1-17	ВТ	DBC	2"	3.00'	0	\$	IRC	NG	N/A	FRONTIER	1301810.09'	526422.72'	6.80'	3.80'
Notes:														
												Prepared by: EE	Date: 02/12/20	019
												Checked by: AB	Date: 02/12/2	2019

REVISIONS STATE OF FLORIDA DEPARTMENT OF TRANSPORTATION Kisinger Campo & Associates Corp. 201 N. Franklln Street, Sulte 400 Tampa, Florlda 33602 Engineer of Record: Branan R. Anderson, PE P.E. No.: 78438 SHEET DESCRIPTION DATE DESCRIPTION DATE NO. UTILITY ADJUSTMENTS (20) ROAD NO. COUNTY FINANCIAL PROJECT ID HILLSBOROUGH 440749-1-52-01 SR 45

dgrumbach 4/30/2021 11:22:32 AM Default

	23.
	5-
	61615
	9 J
	RULE 61G1
	ER.
	UNDER
	GJ.
	SEALED
	QN
	LE DIGITALLY SIGNED A
	SIGNED
	SI
	177X
	ITA
	516
	FILE DIGITA
	FI
	ELECTRONIC FI
	RO!
	ELECT
	13 E
	THE
	15
	HEET
	SHEET
	THIS
	17.
	PFICIAL RECORD OF THIS SHEET IS THE ELECTR
	ORD
	RECORD
	7V
	OFFICIAL
	31
7	11
4	

Date:		1	2/06/2018	_			Test Hol	e Data Rep	ort			Crew Members:		DW, TG, MA
CHO Pro	iect #:		18-252	16	5514 N. Dale Ma	ahrv Hwv	Test no	е рата кер	ort	ECHO U	IES, Inc.	City, State:	т	ampa, Florida
	,		Tompo Flor			Tampa, Florida 33618			www.ech		General Location:		US 41	
Financial Project#: N/A		151	L E. SR434, Ste.					888.778						
ruck No.		L	D-3/T-2	Wir	ter Springs, Flo	71IUU 32700		INEERING &	SURVEY	- GROW, INSPIRE, MA		Coordinate Unit of Meas		S Survey Fee
		Jtility Type				Utilit	y Material			Identif	ied By:	Abbreviations		sured From:
BE = Buried			imed Water		AC = Transite		FIBG = Fiberg			HUB = Survey Hub		N/A = Not Applicable	EP= Edge of Pay	
M = Gas N		SL = Street	-		CI= Cast Iron			Density Polye	thylene Pipe	IRC = Iron Rod & Cap		NAD = North American	BC = Back of Cu	
	Telephone	TS = Traffic	_		CP = Concrete F		PE = Polyeth			NL = Nail & Disk "ECI	HO TEST HOLE"	Datum	BL = Baseline of	
/M = Wate	Optic Cable	FL = Fuel Li			DBC = Direct Bu CMP = Corruga		PVC = Polyvii STL = Steel	nyi Chioride		SLEEVE = Sleeve X = "X" in Concrete		NAVD = North American Vertical Datum	COORD = Surve CL = Centerline	y Coordinates
AN = Sanita		WS = Wate			CONC = Concre		VCP = Vitrifie	d Clay Pine		Surfac	e Tyne	UNK = Unknown	HUB = Survey H	uh
TM = Storn	•		nown Utility		CPP = Corrugat			ressed Cylinde	r Concrete	ASPH = Asphalt	стурс	COT = City of Tampa	RW = Right of V	
	le Television		d Electrical C	Ouct	DCT = Duct	ed Flastic Fips	Pipe Prest	ressea cylinae	er concrete	CONC = Concrete		cor - city or rumpu	ST = Swing Ties	vuy
M = Force			d Telephone		DIP = Ductile Ire	on Pipe		rced Concrete	Pipe	NG = Natural Ground	1		X = "X" in Conci	ete
	I		Utility Size	Utility		N		1				Horizontal: NAD83/11		<u> </u>
Test Hole	Utility Type	Utility	Outside	Manual	Cross	\Rightarrow	Identified By	Surface Type	Surface Thickness	Apparent Utility	Datums:	Vertical: NAVD88	Ground	Utility
rescribic	Otimey Type	Material	Diameter inches	Depth feet	Sectional View	Utility Direction	identified by	Surface Type	inches	Owner	Northing	Easting	Elevation	Elevation
1-18	ВТ	PVC	2 - 4"	3.82'	00	thirty Birestion	IRC	NG	N/A	FRONTIER	1303091.15	526425.13'	7.04'	3.22'
1-19	FOC/BT	PVC	4"	2.54'	0	†	IRC	NG	N/A	FRONTIER	1303091.17'	526425.73'	6.99'	4.45'
1-20	ВТ	LEAD	2 - 2"	3.00"	00	‡	IRC	NG	N/A	FRONTIER	1303091.09'	526427.92'	6.86'	3.86'
1-21	FOC	UNK	12 - 1.5"	9.22'	888888	\$	IRC	NG	N/A	FRONTIER	1303091.01	526430.76'	6.58'	-2.64'
1-22	ВТ	LEAD	2 - 2"	2.00'	00	_	IRC	NG	N/A	FRONTIER	1303695.15'	526432.46'	6.77'	4.77'
1-23	ВТ	PVC	2 - 4"	2.76'	00	‡	IRC	NG	N/A	FRONTIER	1303695.20'	526433.46'	6.70'	3.94'
1-24	ВТ	LEAD	2 - 2"	2.74'	00	1	IRC	NG	N/A	FRONTIER	1304500.45'	526435.531	7.28'	4.54'
lotes:	1-21 - Unable	to visually	verify size an	d material d	ue to depth and	groundwater. Possi	bly 12 - 1.5" p	olyethylene pi	pes.					
												_		
												Prepared by: EE	Date: 02/12/2	019
												Checked by: AB	Date: 02/12/	

	REVI	SIONS				STATE OF FI	ORIDA		SHEET
DATE	DESCRIPTION	DATE	DESCRIPTION	Kisinger Campo & Associates Corp. 201 N. Franklin Street, Sulte 400	DEPARTMENT OF TRANSPORTATION				NO.
				Tampa, Florida 33602	ROAD NO.	COUNTY	FINANCIAL PROJECT ID	UTILITY ADJUSTMENTS (21)	
				Engineer of Record: Branan R. Anderson, PE P.E. No.: 78438	SR 45	HILLSBOROUGH	440749-1-52-01		
dgrumbaci	ĥ		4/3	0/2021 11:22:38 AM Default			-	c:\pwworkingdir\kca-pw.bentley.com_kca-pw-01\dean_grumbach\dms07001\	UT ADRD00.dgn


STATE OF FLORIDA DEPARTMENT OF TRANSPORTATION

CONTRACT PLANS

FINANCIAL PROJECT ID 440749-1-52-01





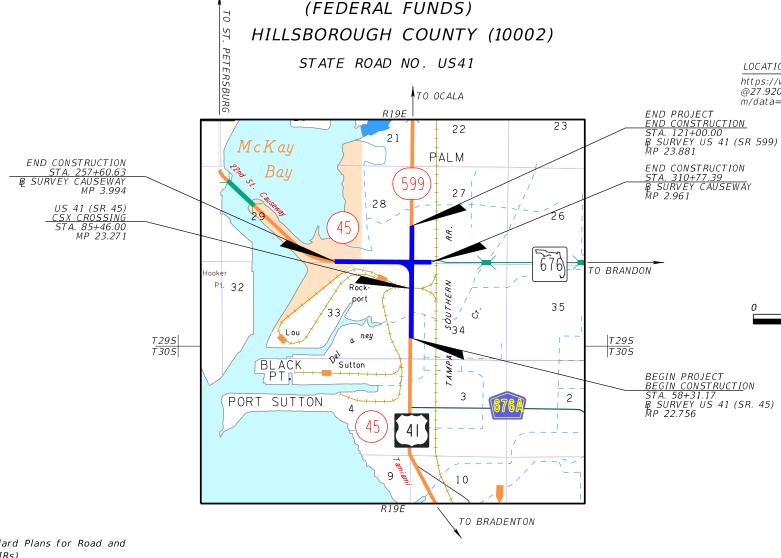

GOVERNING STANDARD PLANS:

Florida Department of Transportation, FY2021-22 Standard Plans for Road and Bridge Construction and applicable Interim Revisions (IRs).

Standard Plans for Road Construction and associated IRs are available at the following website: http://www.fdot.gov/design/standardplans

APPLICABLE IRs: N/A

Standard Plans for Bridge Construction are included in the Structures Plans Component

GOVERNING STANDARD SPECIFICATIONS:

Florida Department of Transportation, July 2022 Standard Specifications for Road and Bridge Construction at the following website: http://www.fdot.gov/programmanagement/Implemented/SpecBooks

ROADWAY PLANS ENGINEER OF RECORD:

NAPLE

BRANAN R. ANDERSON, P.E. NO.: 78438 KISINGER CAMPO AND ASSOCIATES CORP. CONSULTING ENGINEERS & PLANNERS 201 N. FRANKLIN STREET, SUITE 400 TAMPA, FLORIDA 33602 (813) 871-5331 VENDOR NUMBER.: F59-1677145

FDOT PROJECT MANAGER:

TIM O'BRIEN P.E.

LOCATION OF PROJECT

Mile


m/data=!3m1!1e3


https://www.google.com/maps/ @27.9206868,-82.3995664,1364


CONSTRUCTION	FISCAL	SHEET		
CONTRACT NO.	YEAR	NO.		
TBD	21	1		


AYTONA BEACH


c:\pwworkingdir\kca-pw.bentley.com_kca-pw-01\dean grumbach\dms07001\KEYSRD01.dgn 4/13/2021 2:47:16 PM dgrumbach Def aul

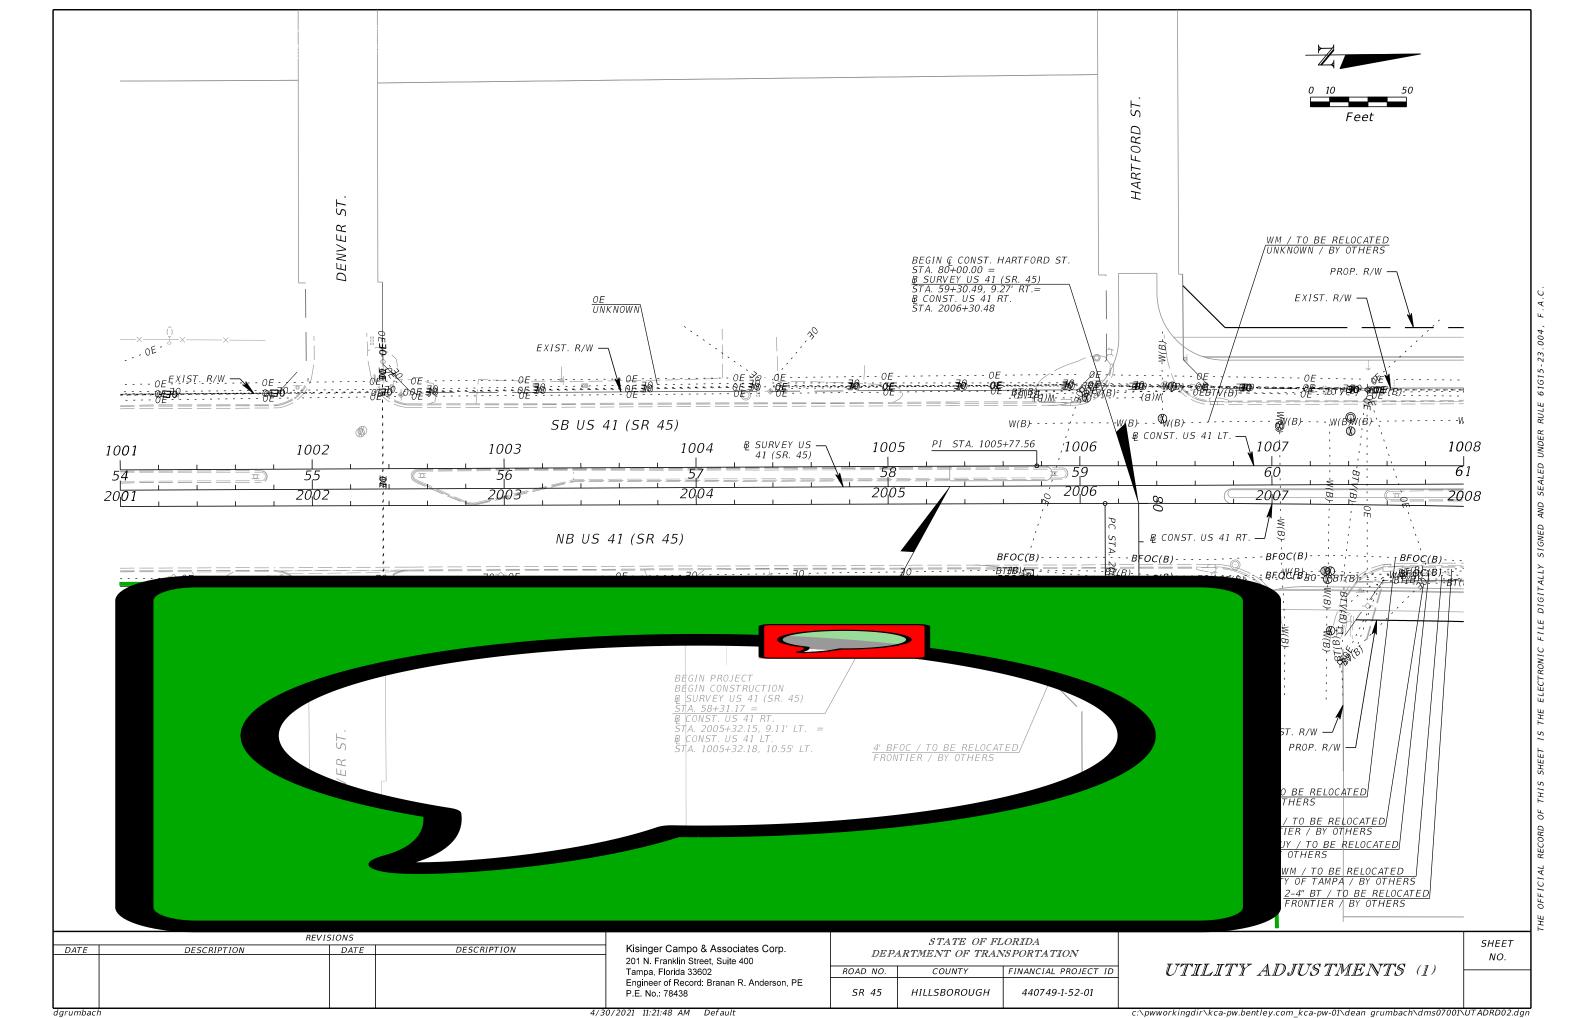


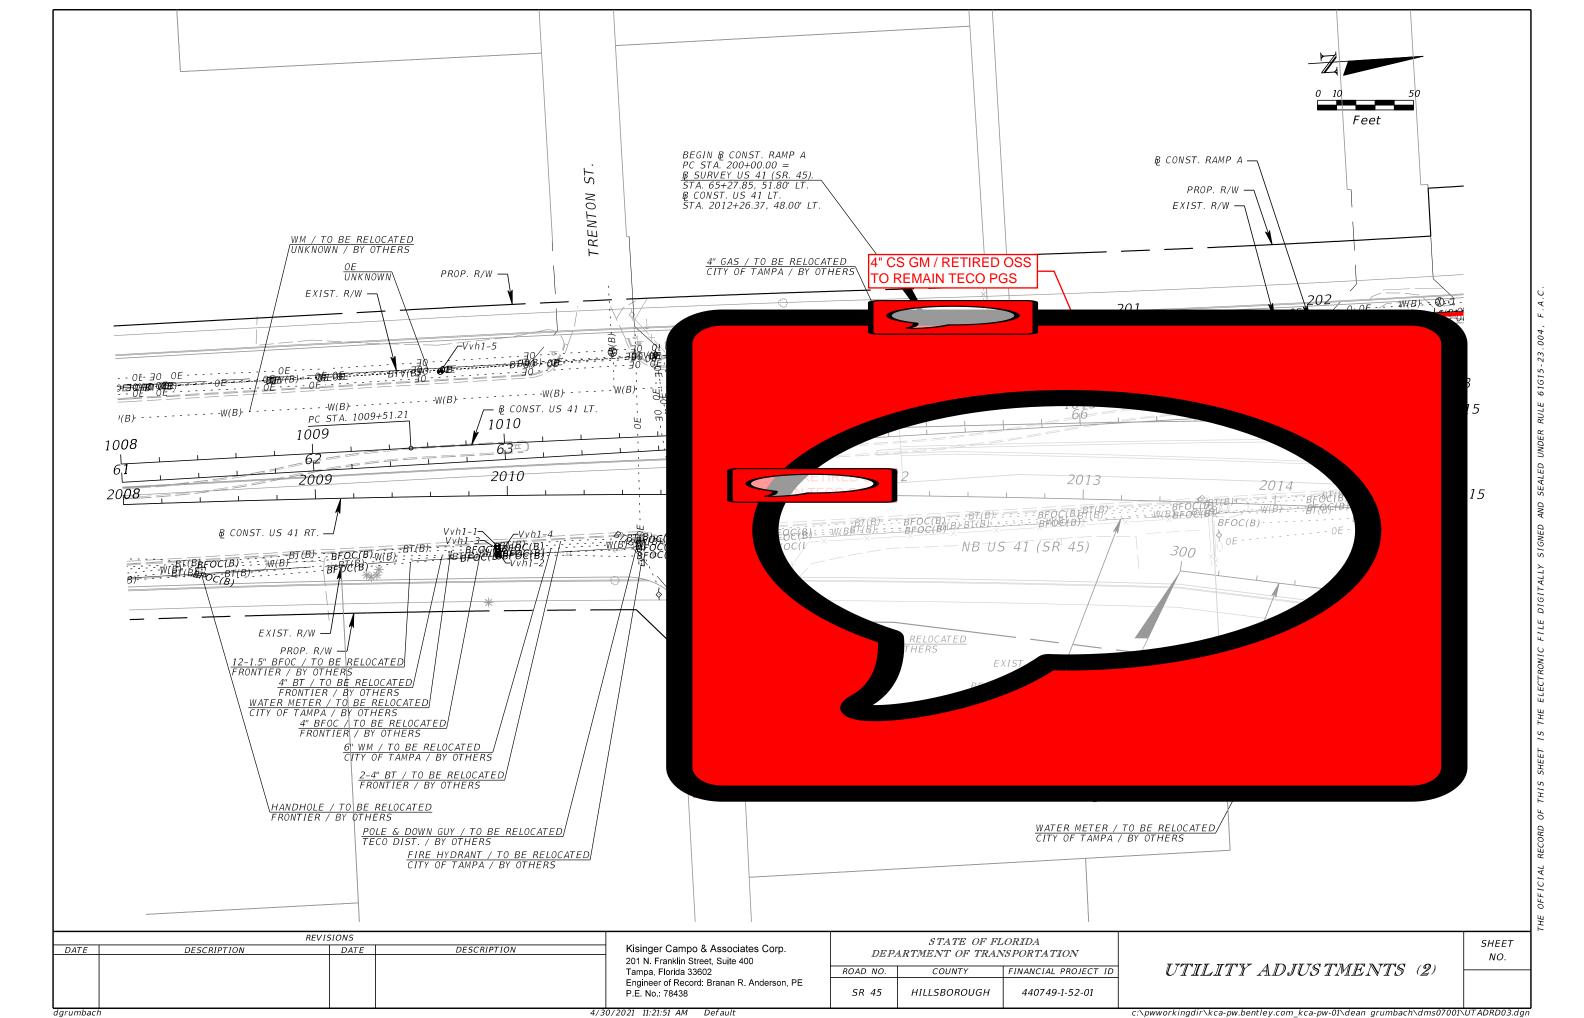


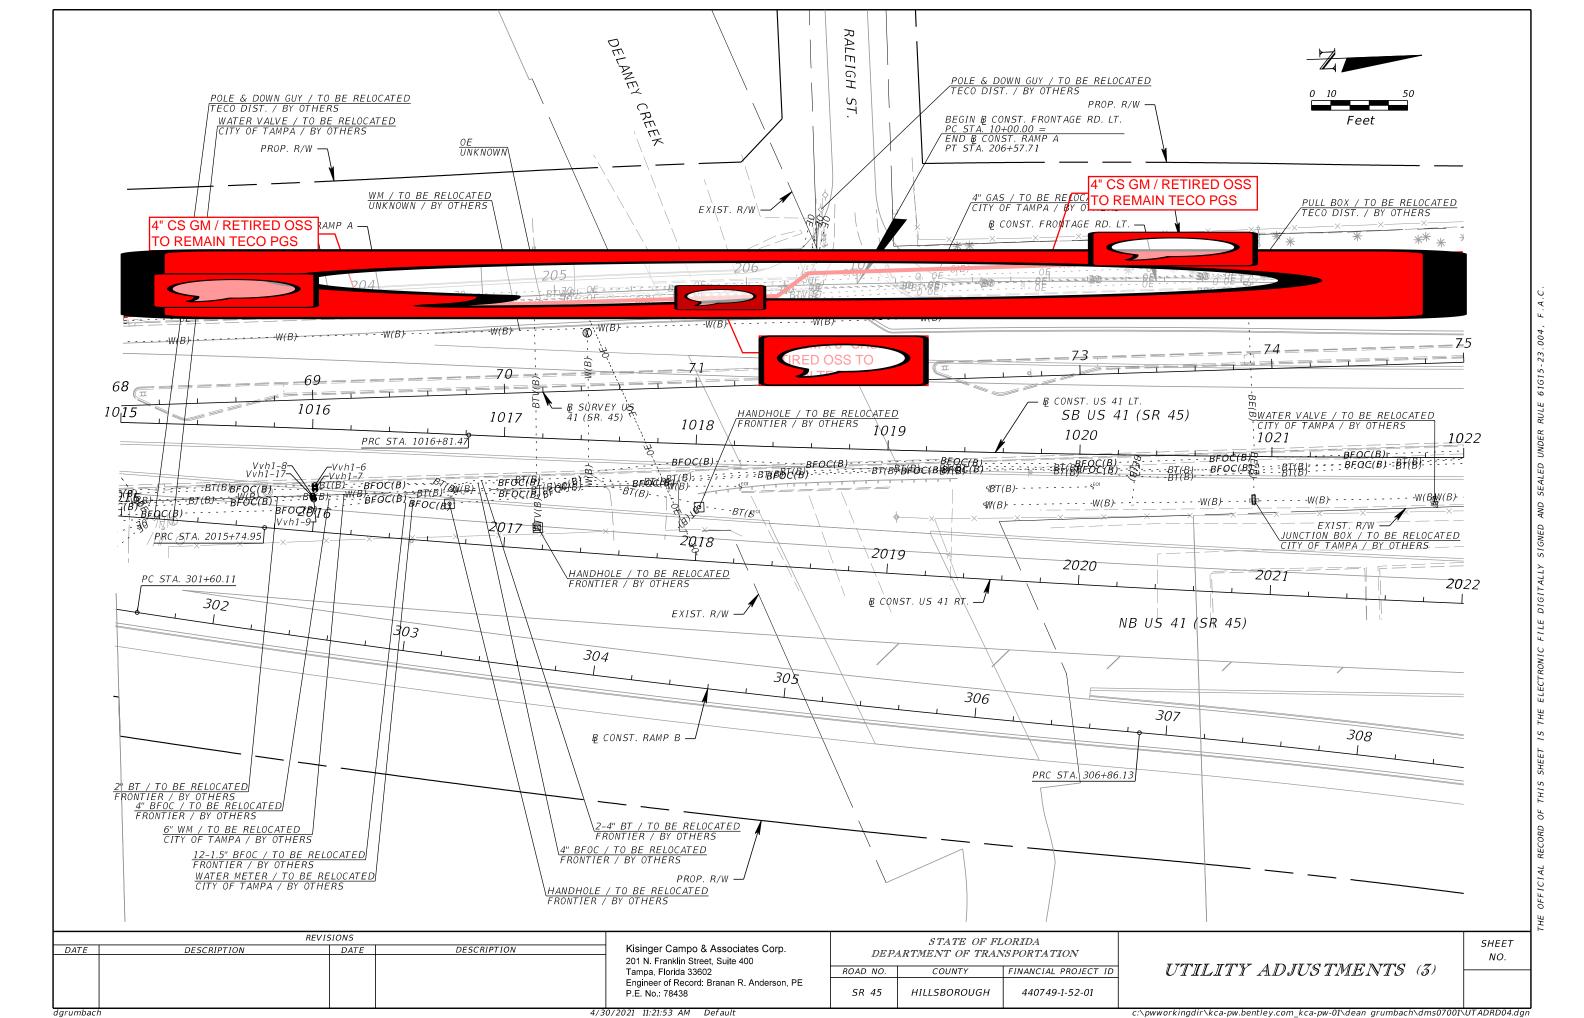


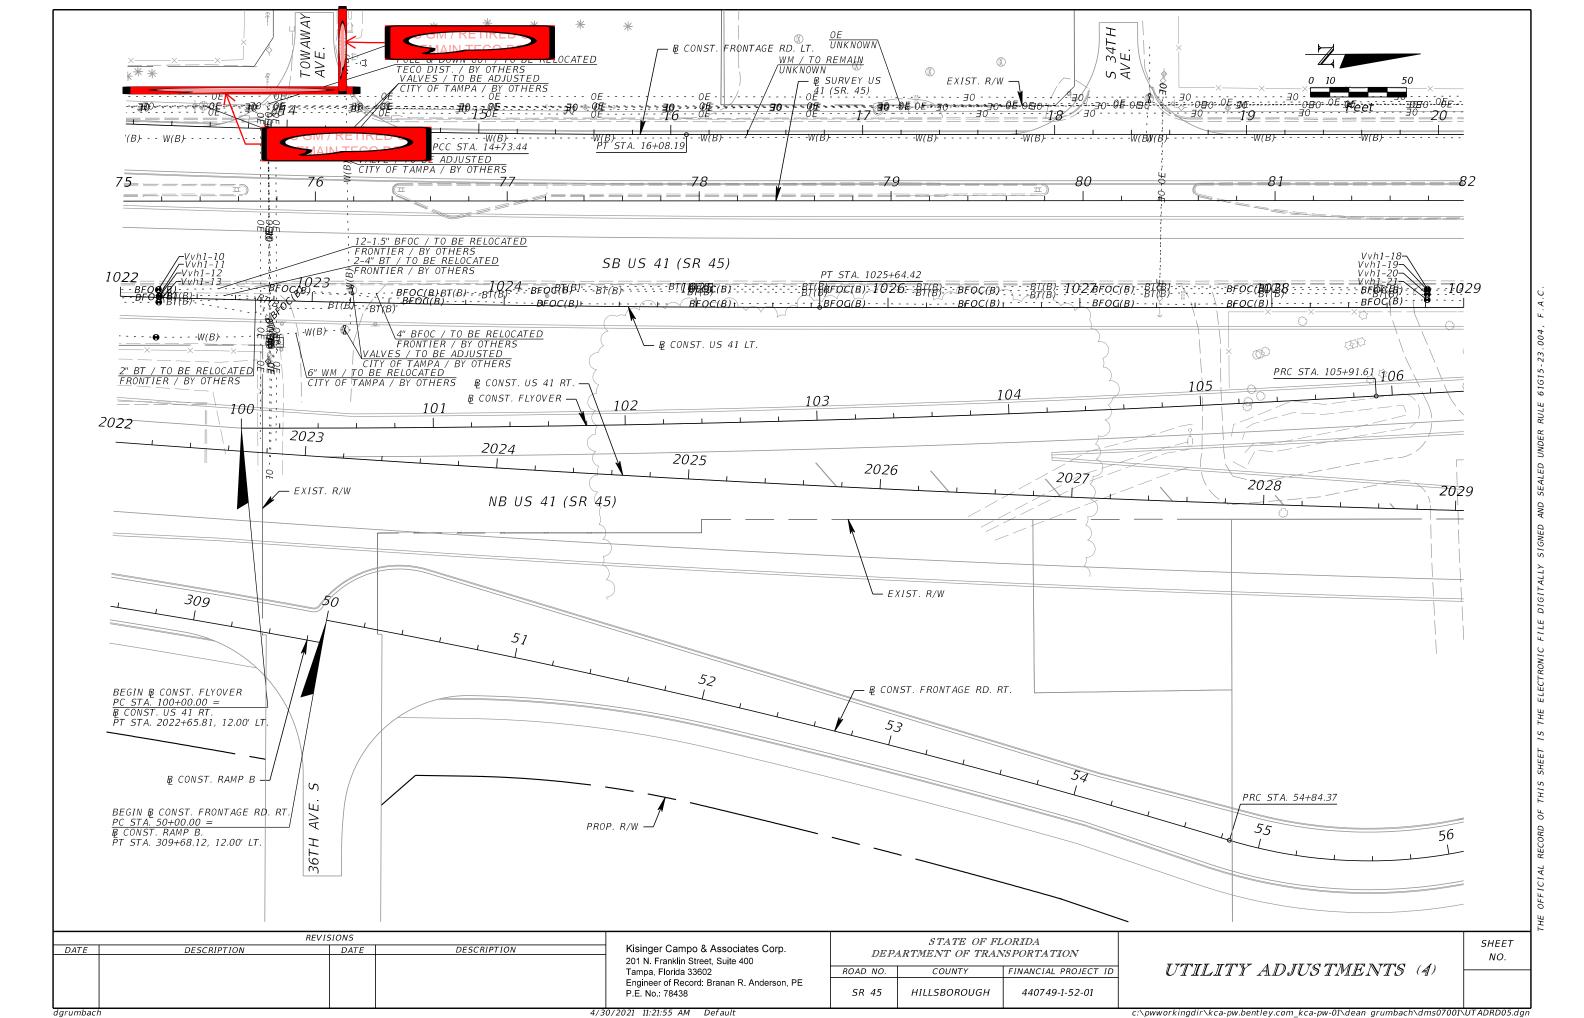


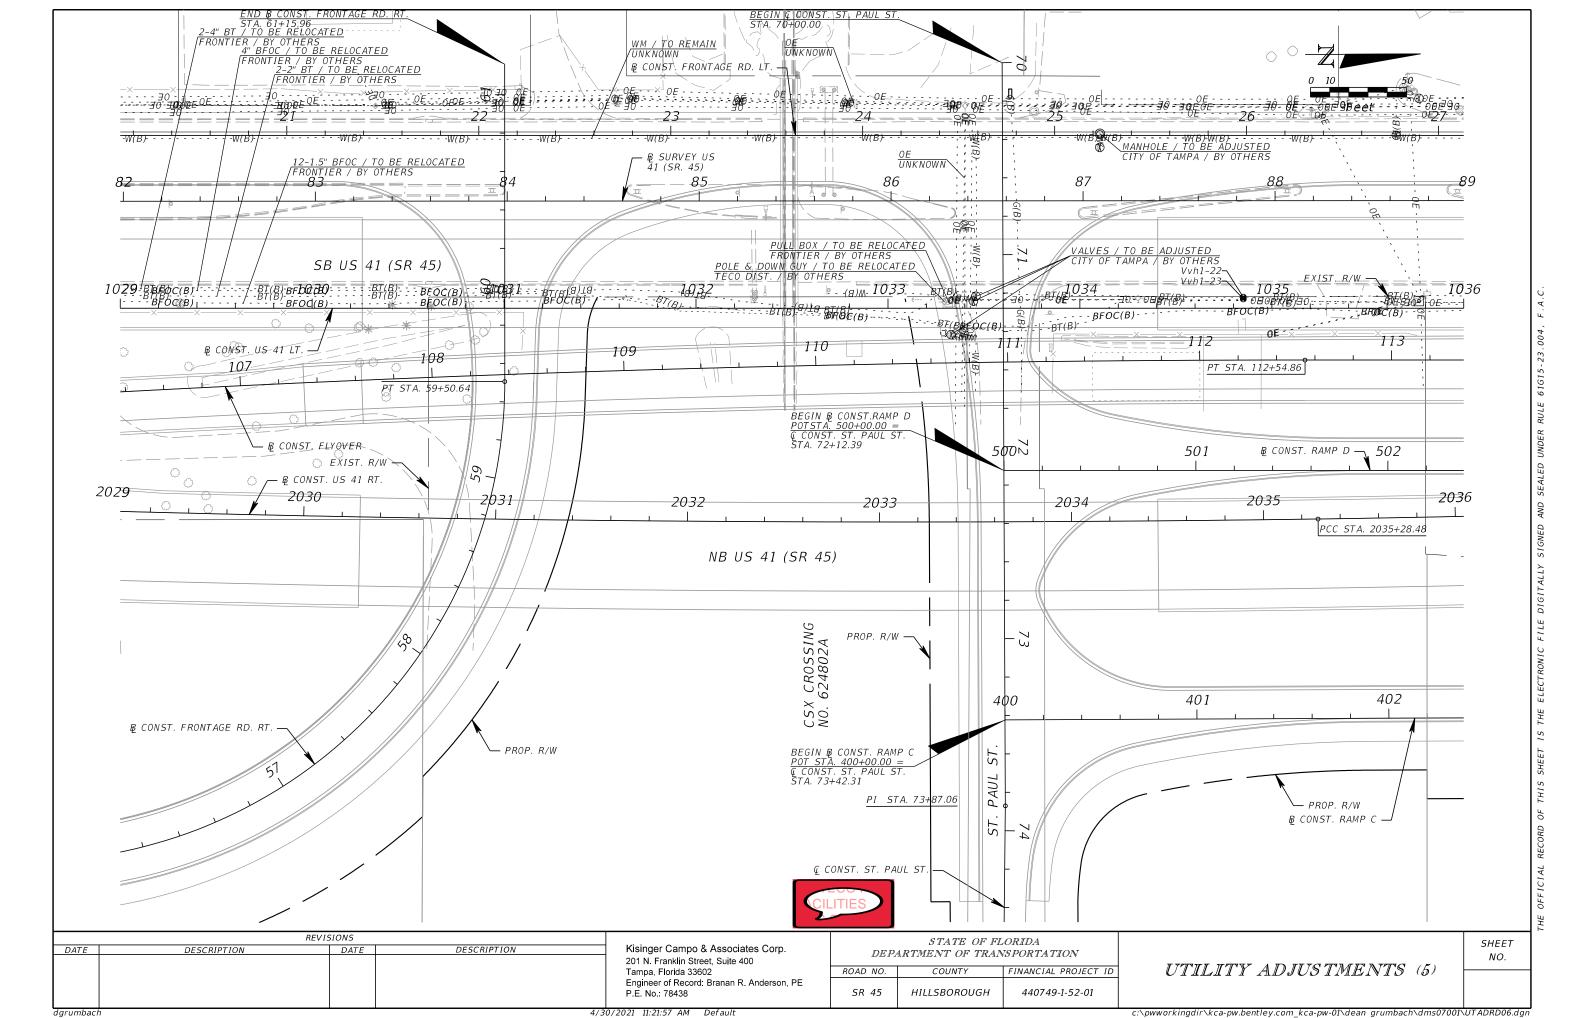


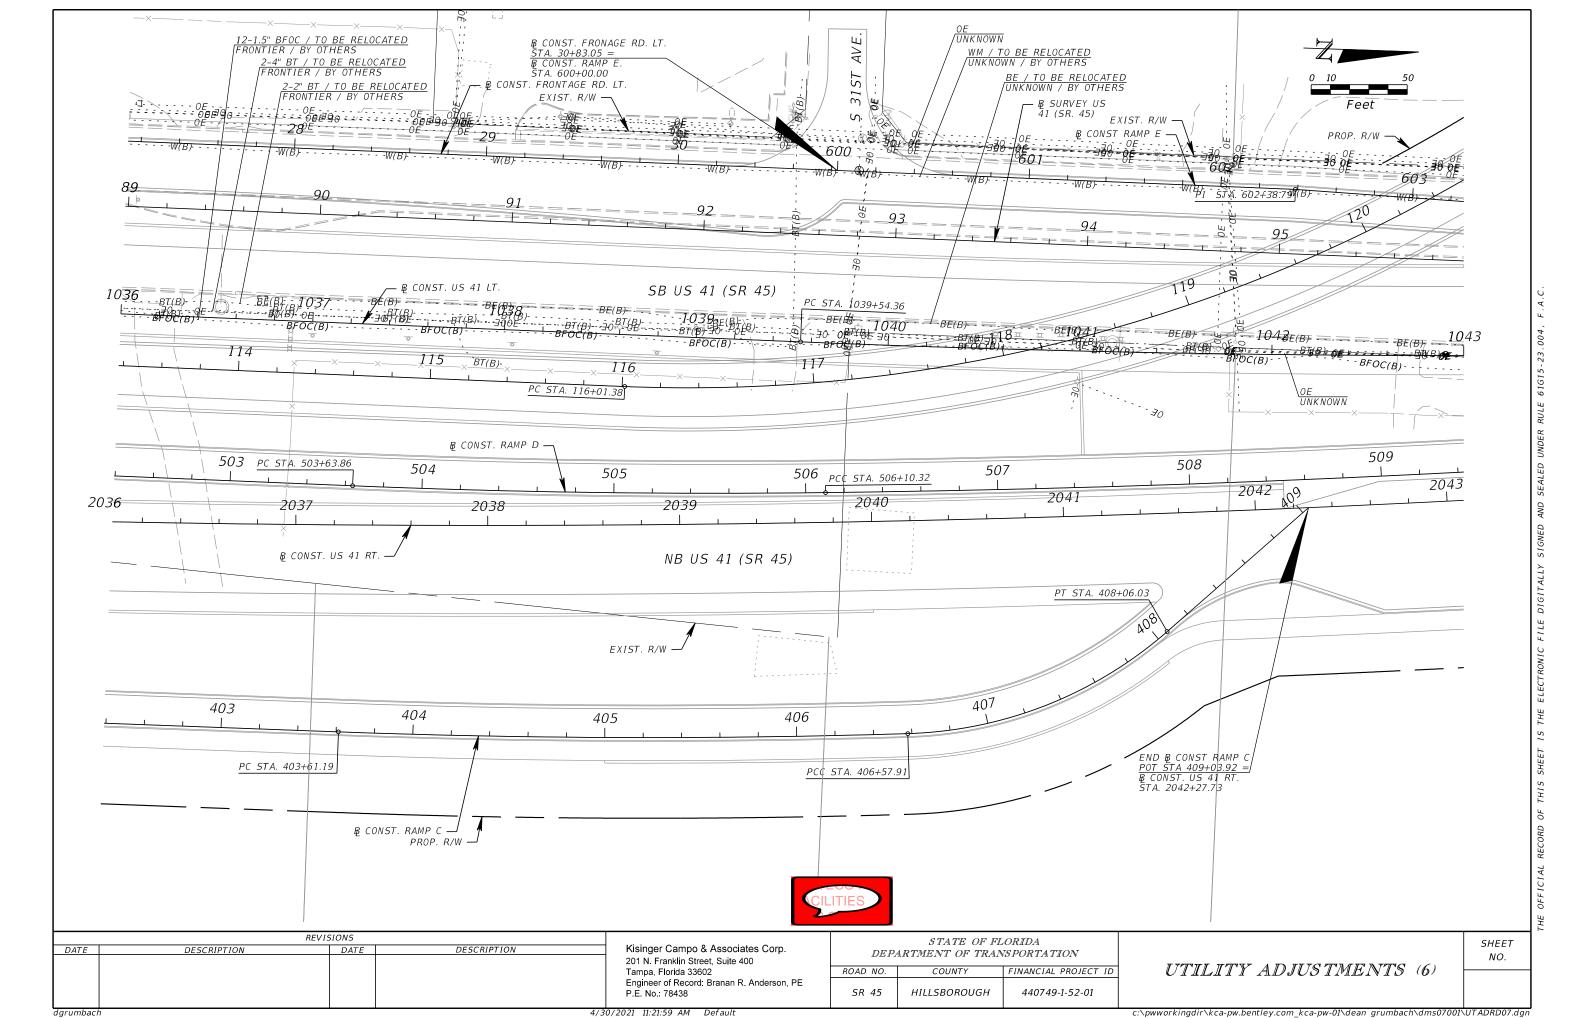

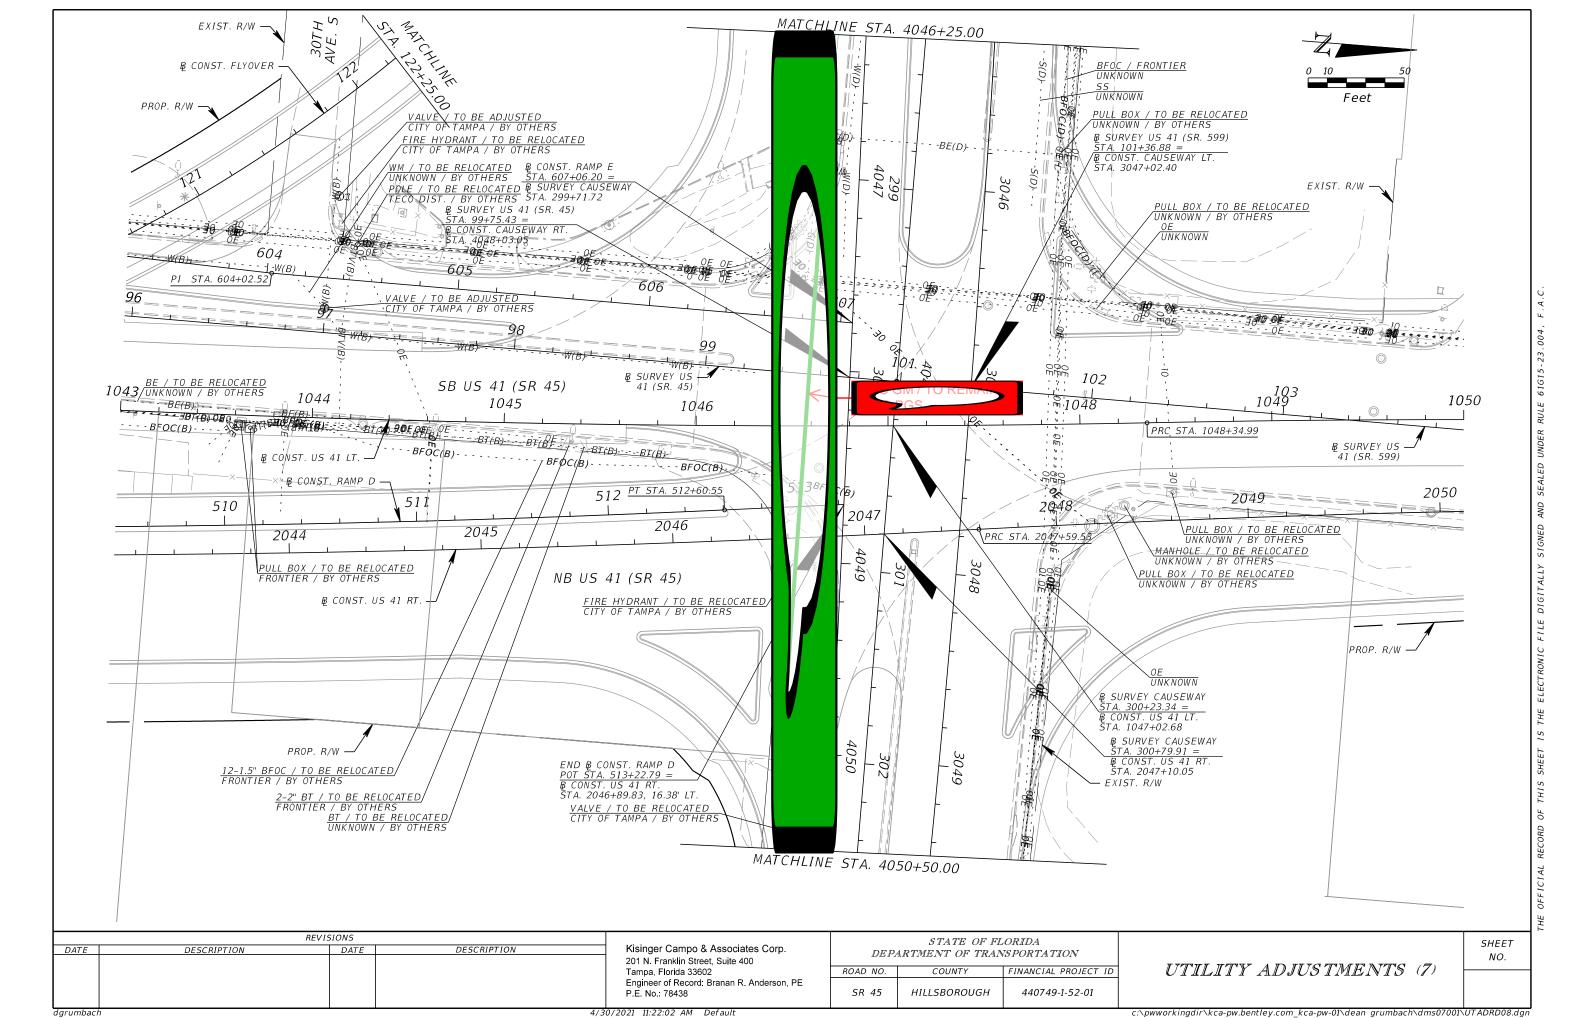

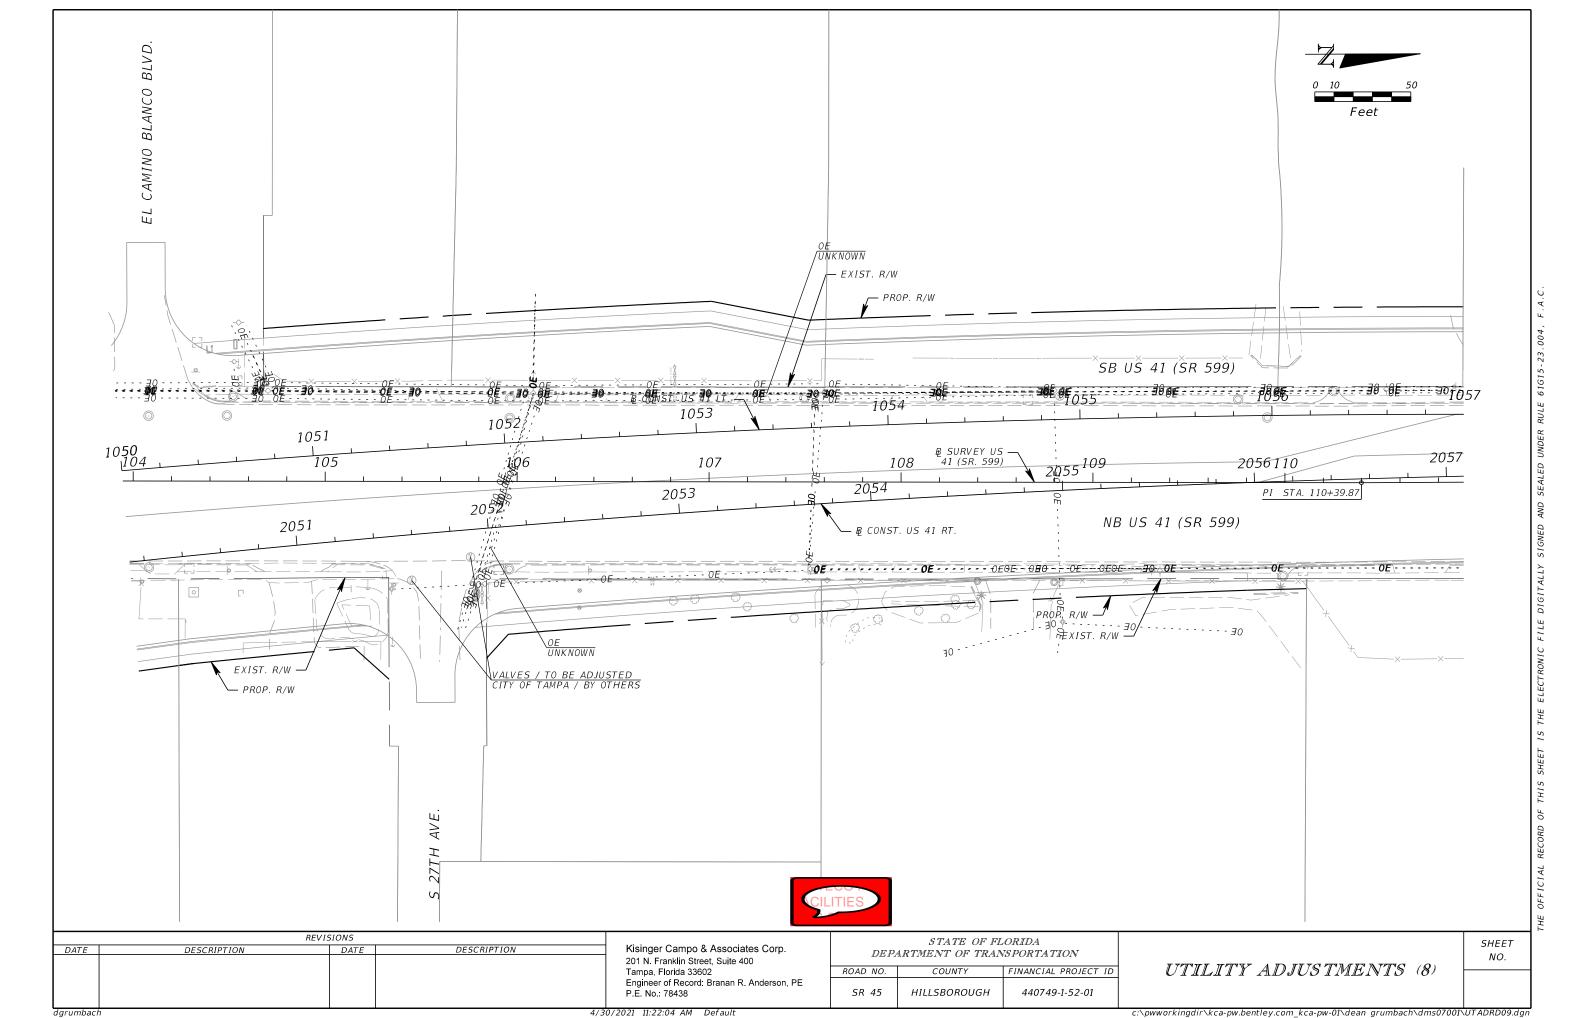

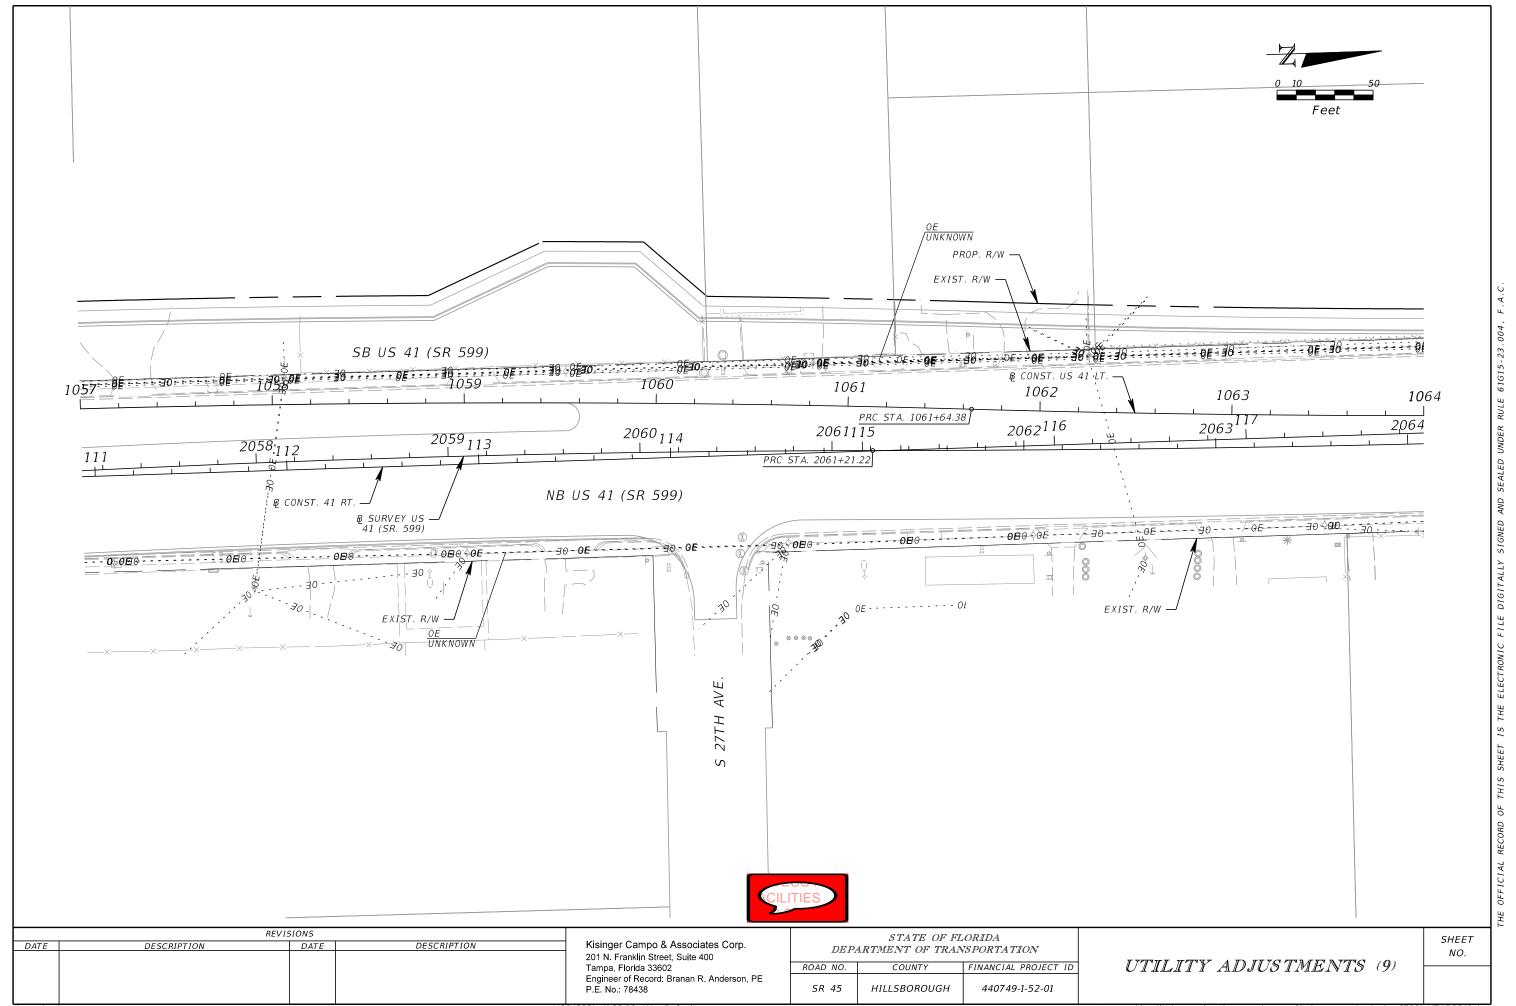


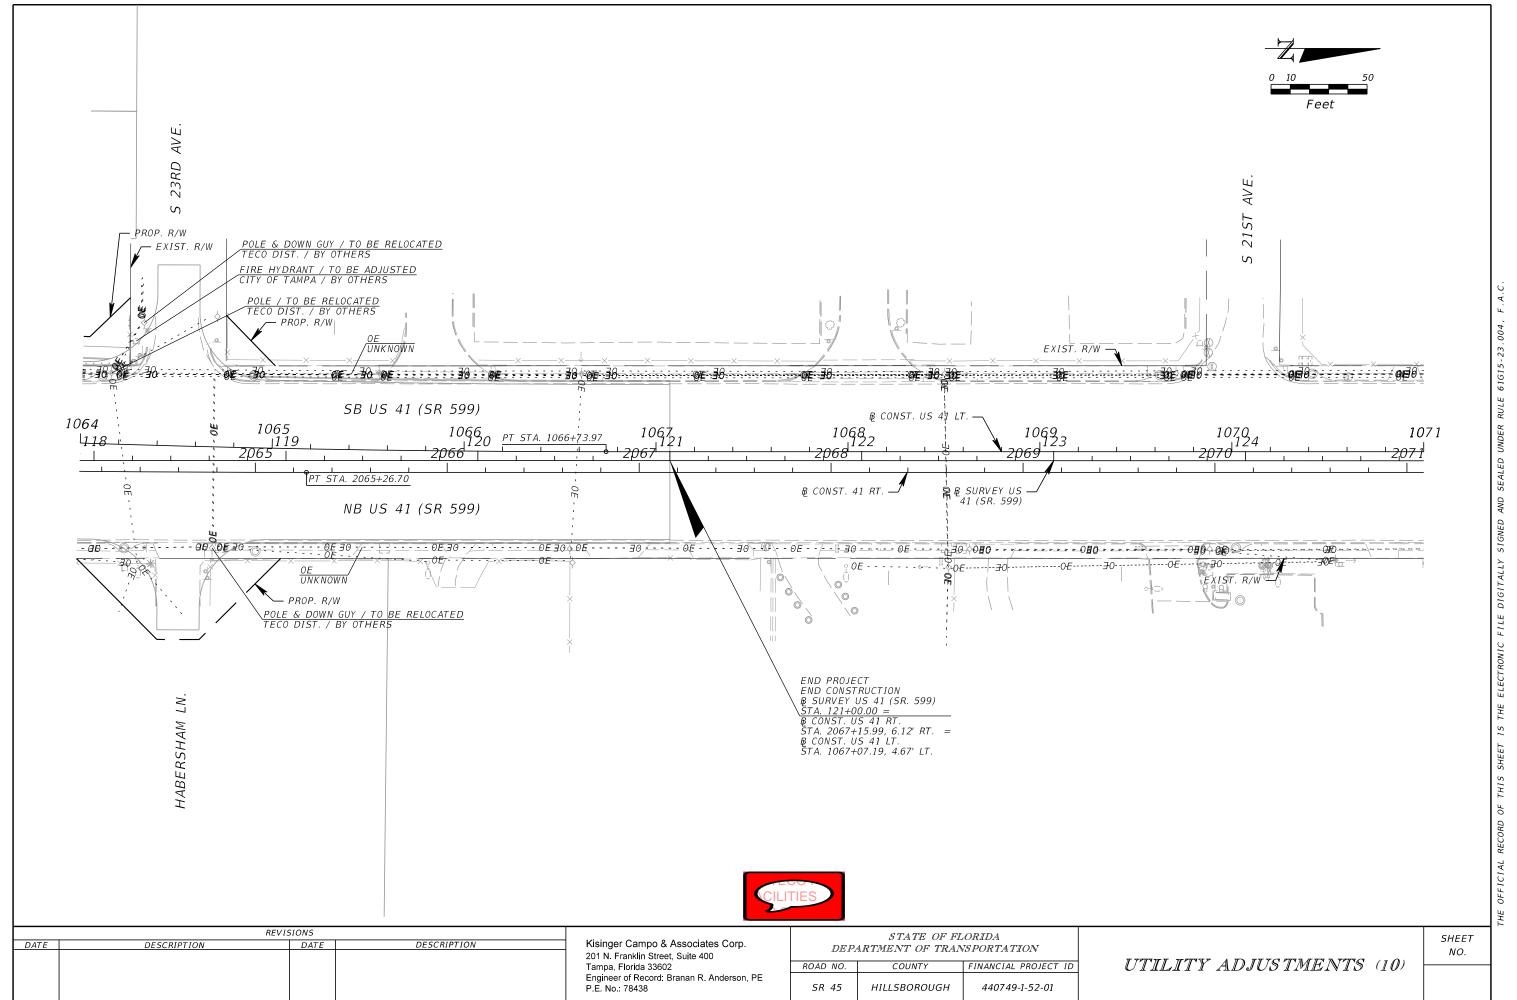



4/30/2021 11:22:08 AM Default


dgrumbach


c:\pwworkingdir\kca-pw.bentley.com_kca-pw-01\dean_grumbach\dms07001\UTADRD11.dgr

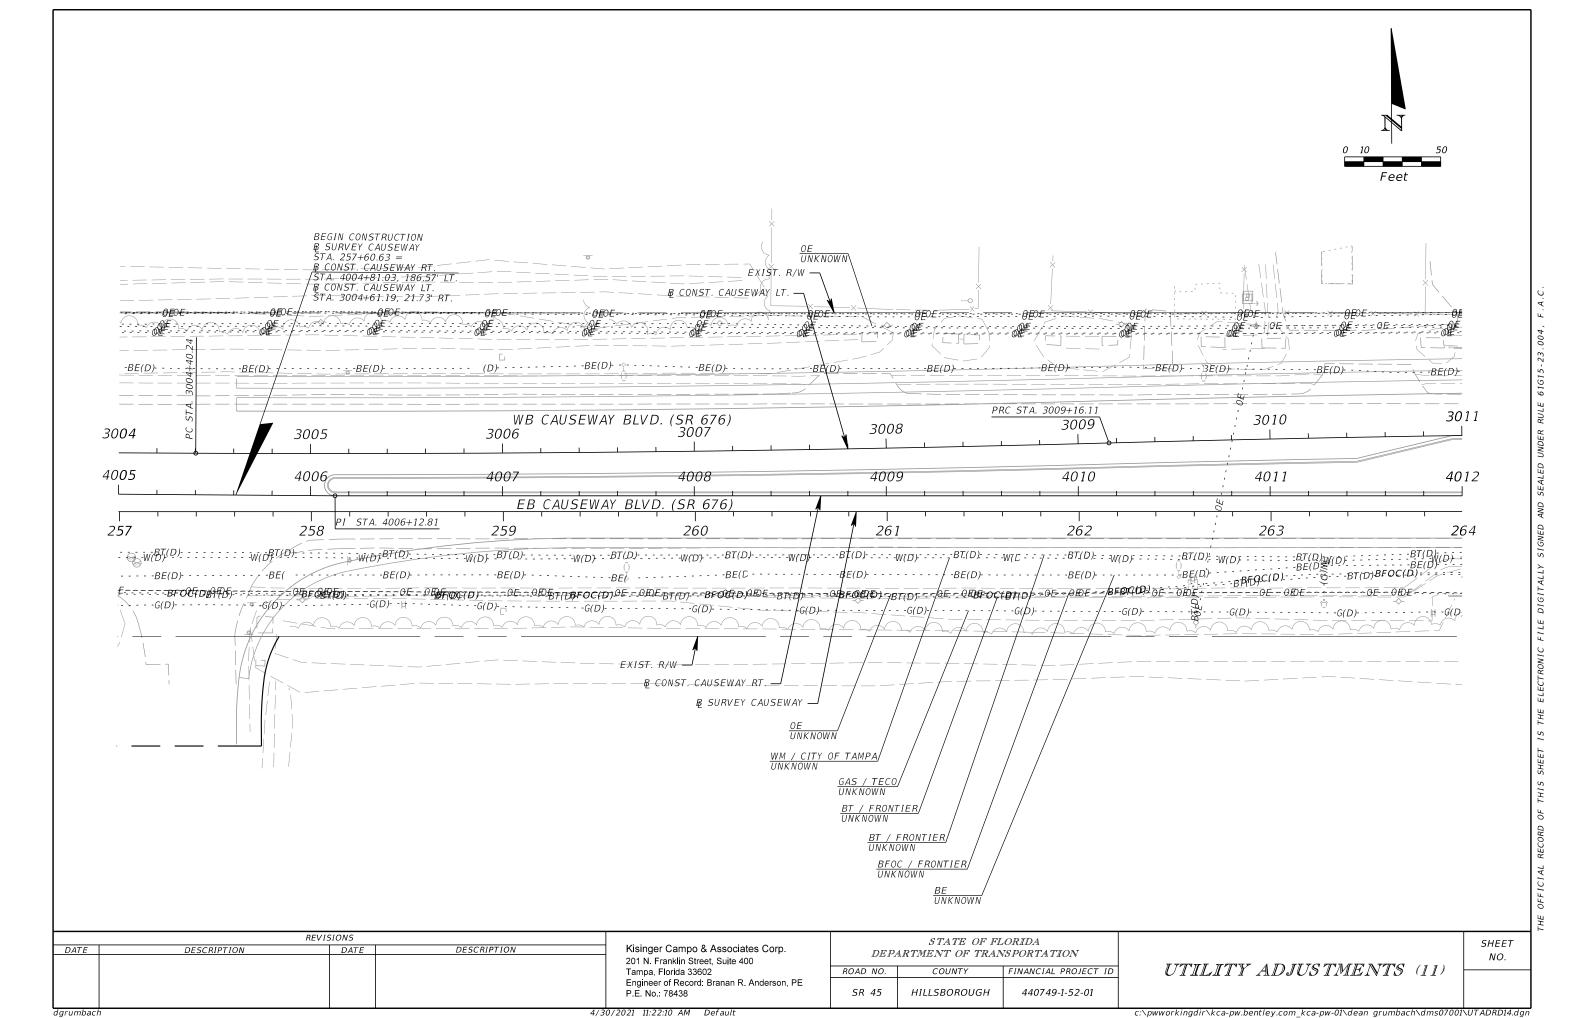


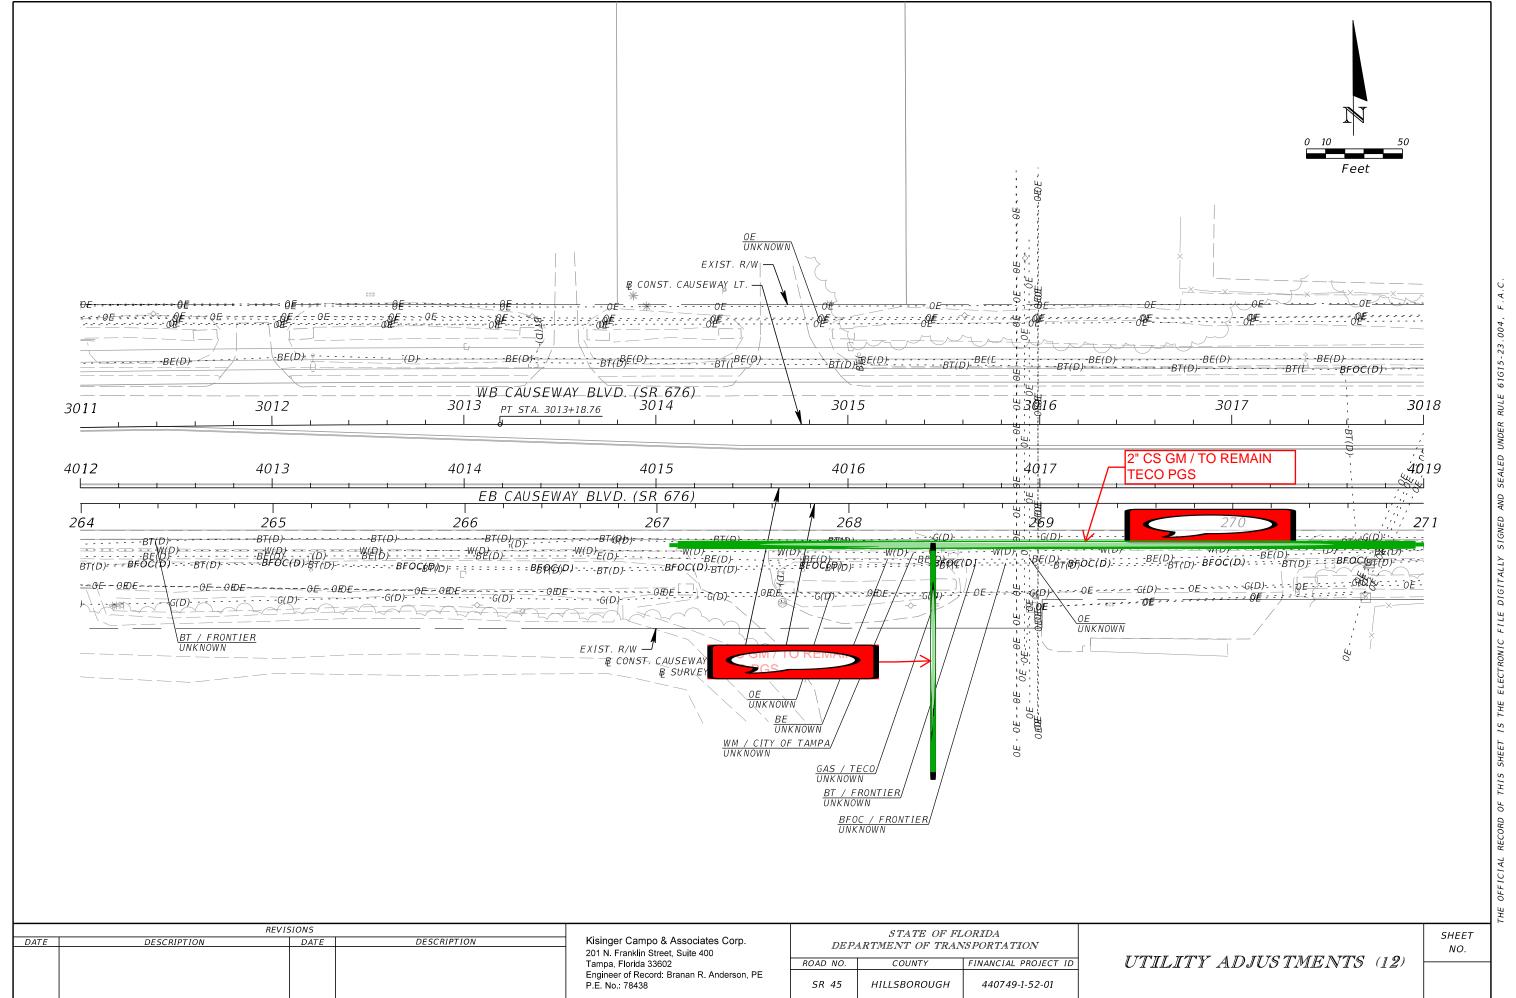


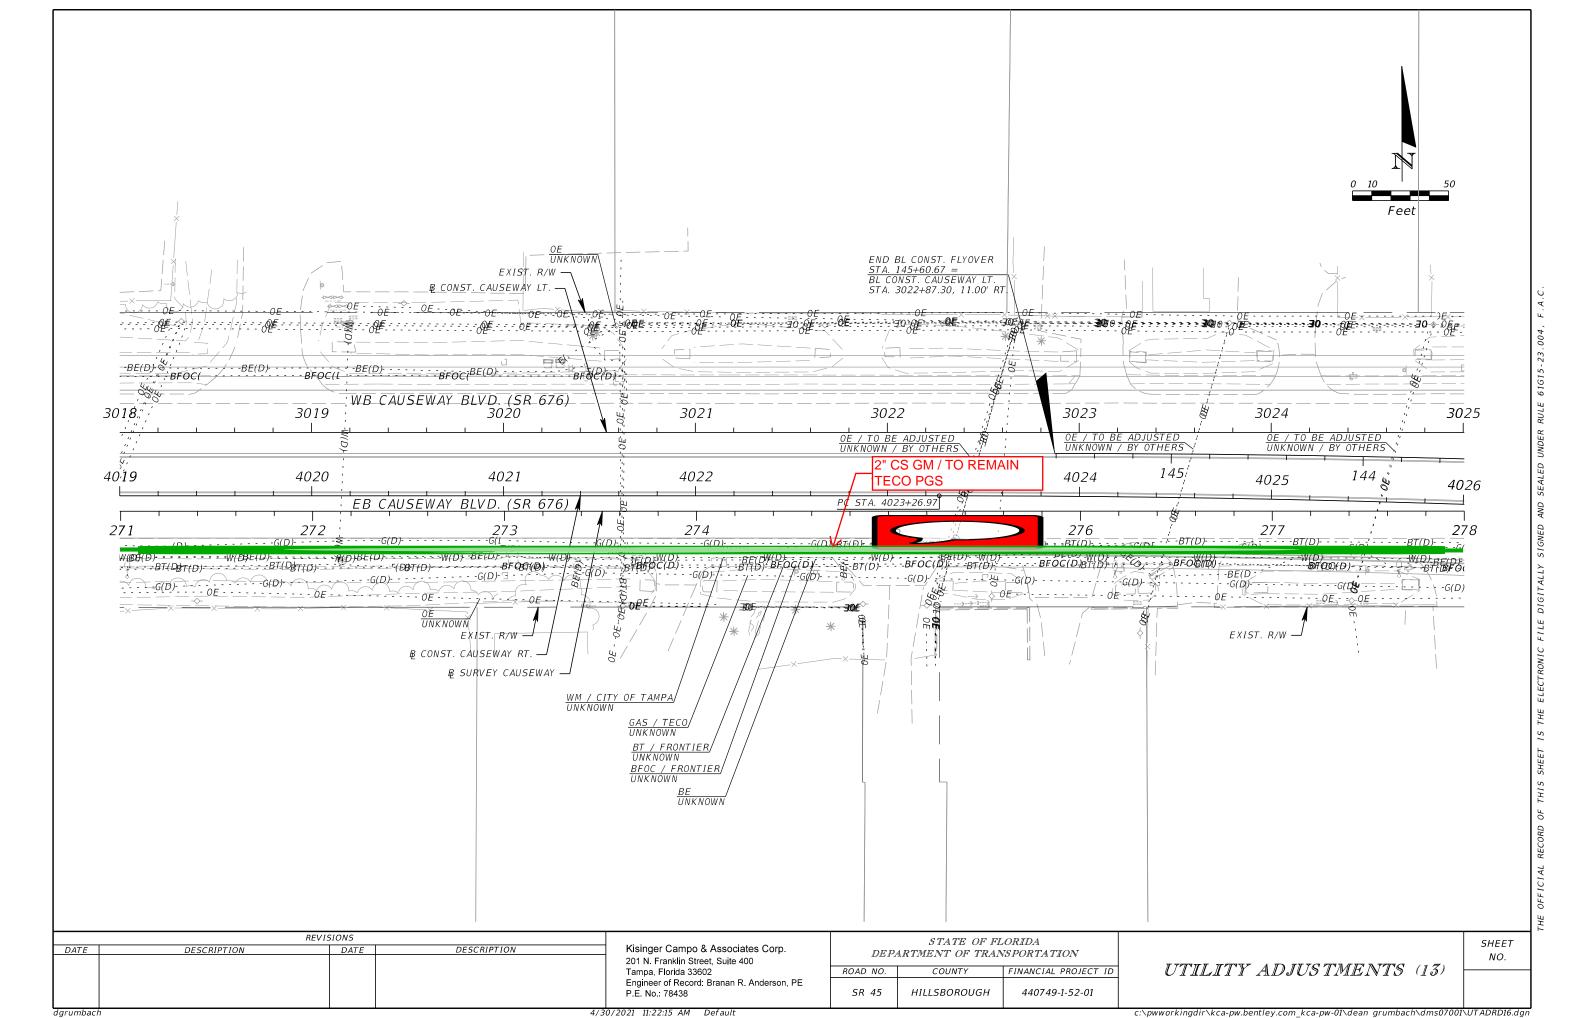


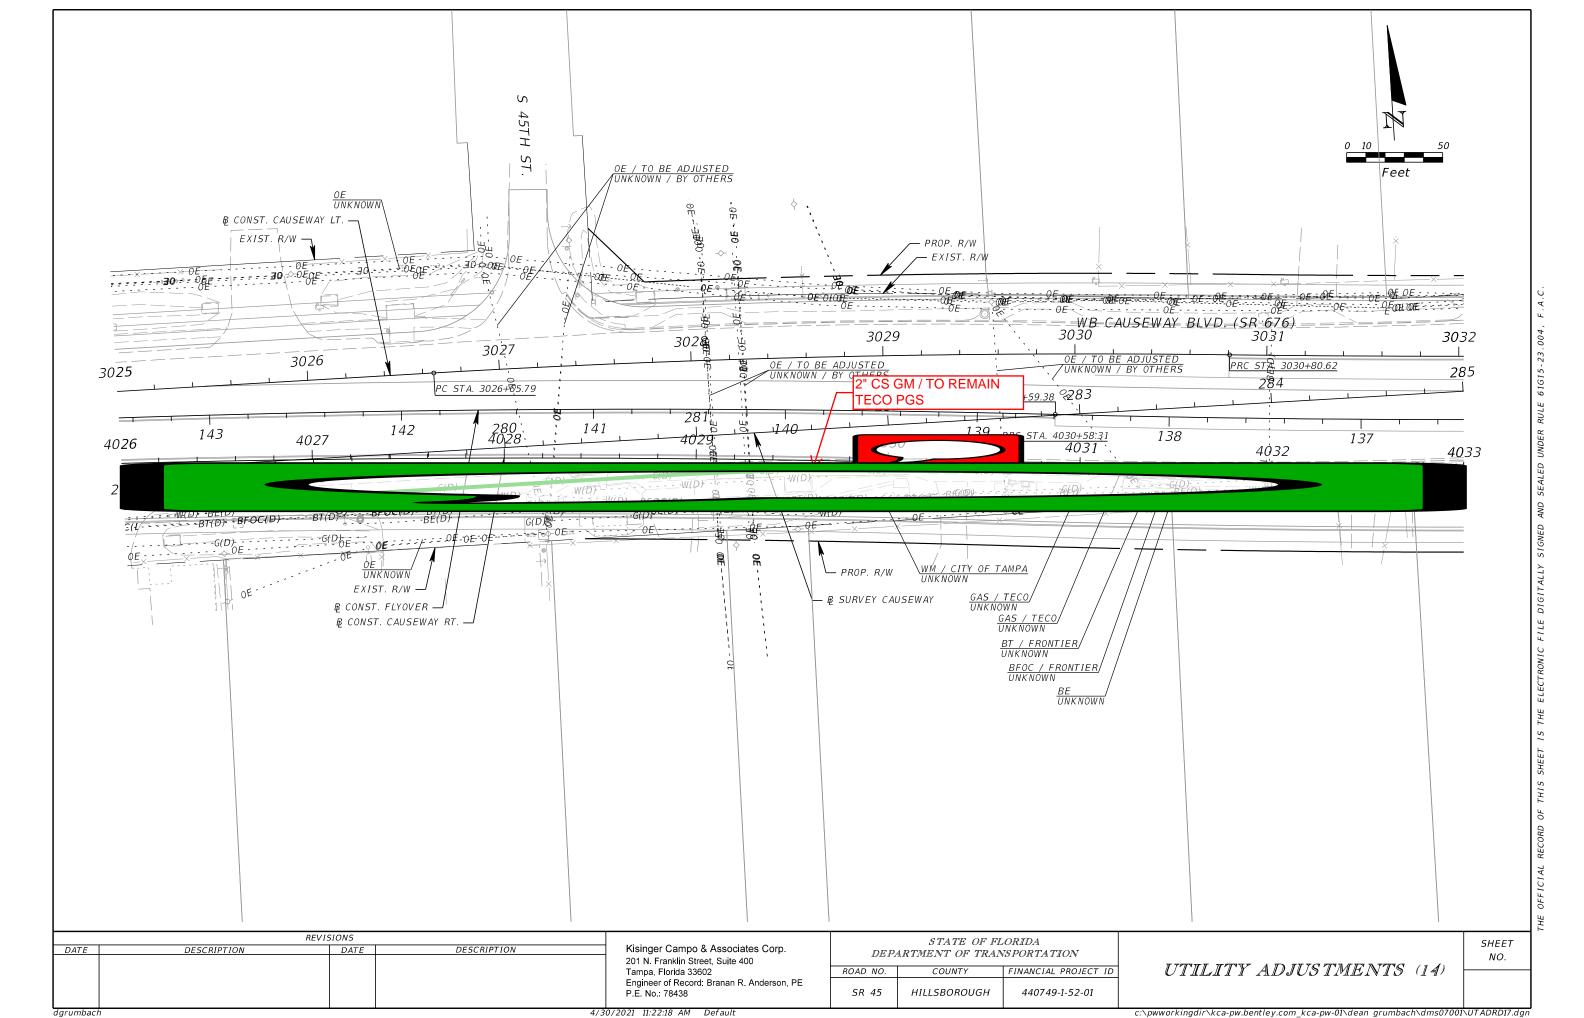

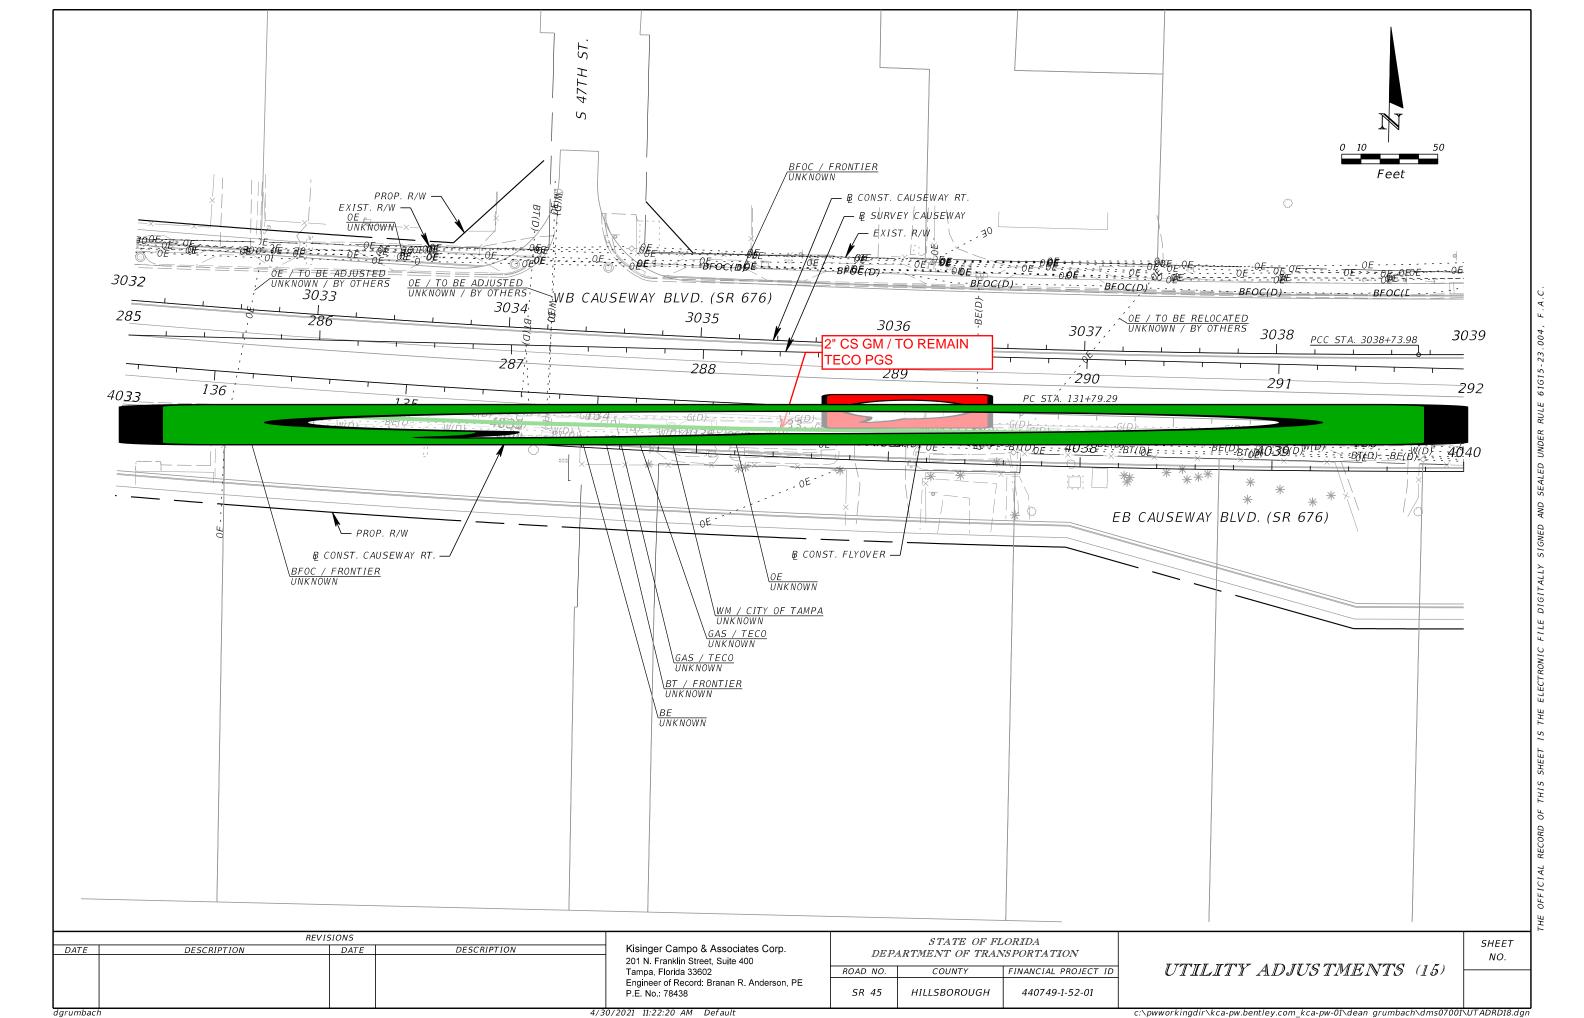

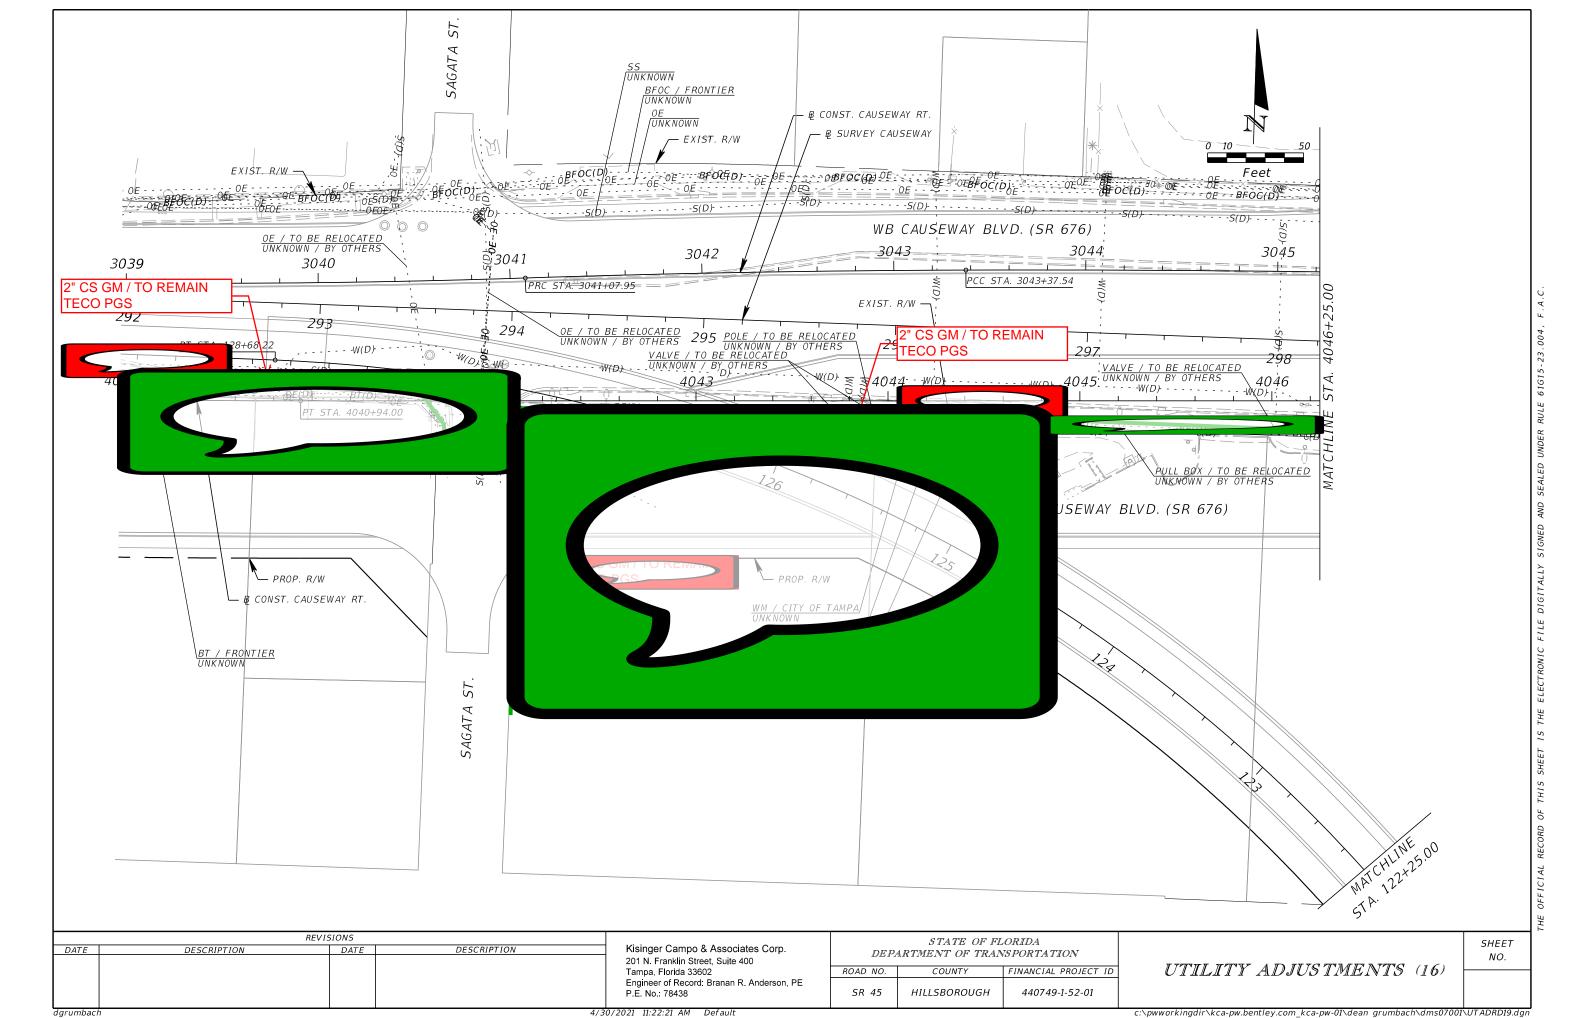

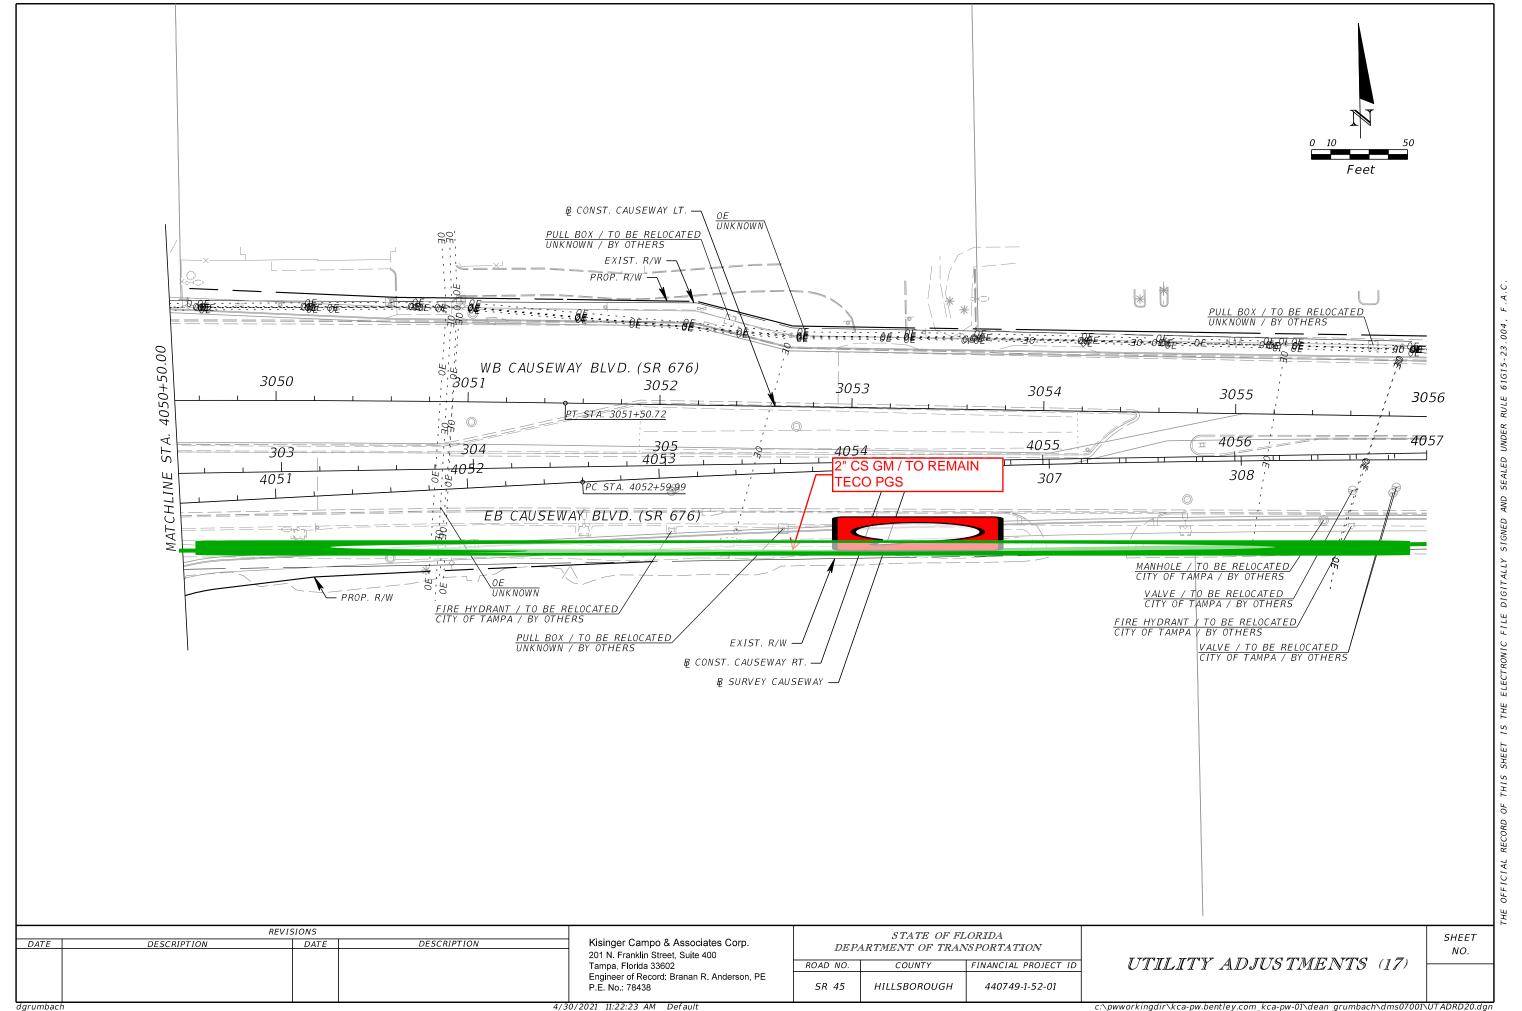

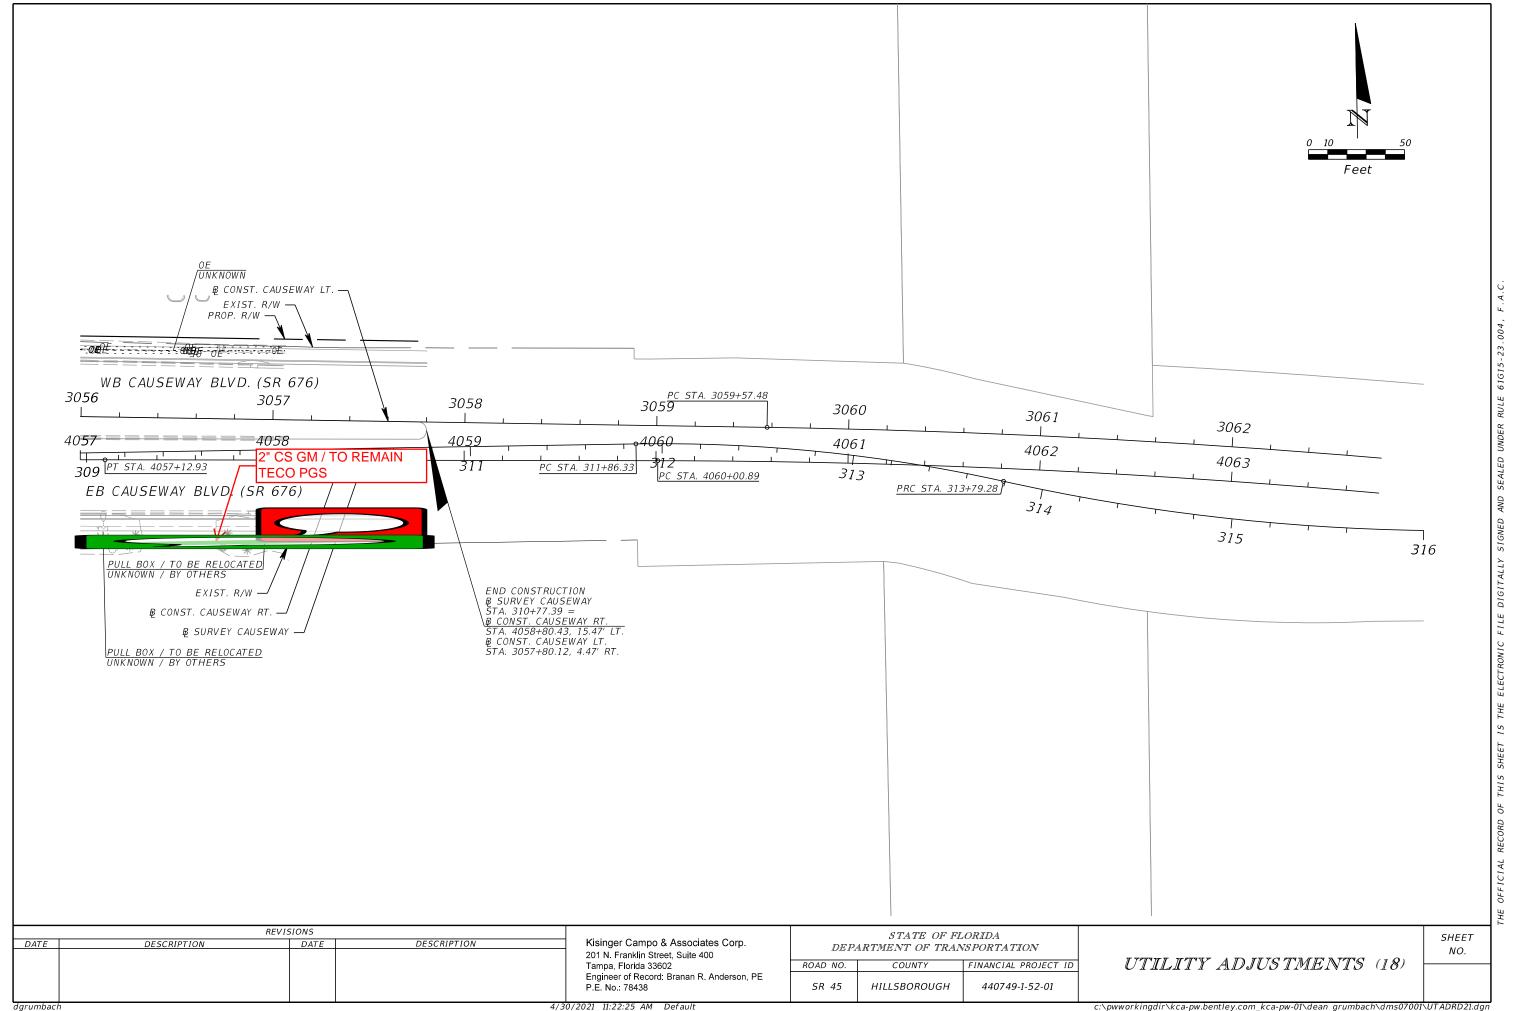

	Cre	w Memb	ers:		DW, TG						
	City	, State:		Ta	ampa, Florida						
	Ger	neral Loca	ation:		US 41						
NCE-	Coc	ordinate (Unit of Meas	ure: U	S Survey Fee						
		Abbrev	riations	Offset Measured From:							
	N/A	= Not Appl	icable	EP= Edge of Pavement							
HOLE"	NAD	= North A	merican	BC = Back of Cu	rb						
	Datu	ım		BL = Baseline of	Survey						
	NAV	D = North	American	COORD = Surve	y Coordinates						
	Vert	ical Datum		CL = Centerline							
	UNK	= Unknow	m	HUB = Survey H	ub						
	COT	= City of T	ampa	RW = Right of W	/ay						
				ST = Swing Ties							
				X = "X" in Concr	ete						
	Hori	zontal:	NAD83/11								
	Vert	ical:	NAVD88	Ground	Utility						
ng		Е	asting	Elevation	Elevation						
4.90'			6413.67	7.51'	4.25'						
5.19'		526	416.74"	7.48'	4.18'						
4.95'		526	415.25'	7.48'	5.01'						
5.12'		526	418.96'	7.36'	-1.44'						
1.11'		526	321.06'	6.85'	1.31'						
1.38'		526	417.02	6.84'	3.40'						
1.47'		526	6418.97	6.84'	4.42'						
0.12'		526	422.34'	6.83'	-3.23'						
0.56'		526	424.00'	6.49'	3.15'						
		_									
		Prepared L	by: EE	Date: 02/12/20	019						
		i e									

Truck No.:	uck No.:		l Do/Tol			orida 32708	UTILITY ENG	INEERING &	SURVEY	- GROW, INSPIRE, MAKE A DIFFERENCE-		Coordinate Unit of Meas	ure: US Survey Fee	
	U	Itility Type	e				y Material				ied By:	Abbreviations	Offset Measured From	
BE = Buried	Electrical	RW = Reclai	imed Water		AC = Transite		FIBG = Fiberg	glass		HUB = Survey Hub		N/A = Not Applicable	EP= Edge of Pav	ement
GM = Gas M	1ain	SL = Street I	Light		CI= Cast Iron		HDPE = High Density Polyethylene Pipe			IRC = Iron Rod & Cap "ECHO TEST HOLE"		NAD = North American	BC = Back of Curb	
BT = Buried	Telephone	TS = Traffic	Signal		CP = Concrete f	Pipe	PE = Polyethy	PE = Polyethylene Pipe			HO TEST HOLE"	Datum	BL = Baseline of	Survey
OC = Fiber	Optic Cable	FL = Fuel Lir	ne		DBC = Direct Bu	ıried Cable	PVC = Polyvir	PVC = Polyvinyl Chloride S				NAVD = North American	COORD = Surve	y Coordinat
VM = Wate	r Main	GS = Gas Se	rvice		CMP = Corruga	ted Metal Pipe	STL = Steel			X = "X" in Concrete		Vertical Datum	CL = Centerline	
SAN = Sanita	ary Sewer	WS = Water	r Service		CONC = Concre	te	VCP = Vitrifie	d Clay Pipe		Surfac	е Туре	UNK = Unknown	HUB = Survey H	ub
STM = Storn	n Sewer	UNK = Unkr	nown Utility		CPP = Corrugat	ed Plastic Pipe	PCCP = Prest	ressed Cylinde	r Concrete	ASPH = Asphalt		COT = City of Tampa	RW = Right of V	/ay
CATV = Cabl	le Television	BED = Burie	d Electrical C	Duct	DCT = Duct		Pipe			CONC = Concrete			ST = Swing Ties	
FM = Force I	Main	BTD = Burie	d Telephone	Duct	DIP = Ductile Ire	on Pipe	RCP = Reinfo	rced Concrete	Pipe	NG = Natural Groun	d		X = "X" in Concr	ete
Test Hole	Utility Type	Utility Material	Utility Size Outside Diameter	Utility Manual Depth	Cross Sectional View	***	Identified By	Surface Type	Surface Thickness inches	Apparent Utility Owner	Datums: Northing	Horizontal: NAD83/11 Vertical: NAVD88	Ground Elevation	Utility Elevati
			inches	feet		Utility Direction			IIICIICS		Northing	Easting		
1-1	вт	PVC	2 - 4"	3.26'	00	<u></u>	IRC	NG	N/A	FRONTIER	1301204.90'	526413.67	7.51'	4.25'
1-2	WM	CI	6"	3.30'		<u></u>	IRC	NG	N/A	сот	1301205.19	526416.74'	7.48'	4.18'
1-3	FOC/BT	PVC	4"	2.47'	\circ		IRC	NG	N/A	FRONTIER	1301204.95'	526415.25'	7.48'	5.01'
1-4	FOC	PE	12 - 1.5"	8.80'	08888c	<u></u>	IRC	NG	N/A	FRONTIER	1301205.12'	526418.96'	7.36'	-1.44
1-5	CATV	PVC	2 - 2"	5.54'	00	\$	IRC	NG	N/A	SPECTRUM	1301181.11'	526321.06'	6.85'	1.31
1-6	вт	PVC	2 - 4"	3.44'		‡	IRC	NG	N/A	FRONTIER	1301811.38'	526417.02'	6.84'	3.40'
1-7	FOC/BT	PVC	4"	2.42'			IRC	NG	N/A	FRONTIER	1301811.47	526418.97"	6.84'	4.42'
1-8	WM	UNK	UNK	10.06'		\$	IRC	NG	N/A	сот	1301810.12'	526422.34'	6.83'	-3.23
1-9	FOC/BT	PVC	4"	3.34'	0	‡	IRC	NG	N/A	FRONTIER	1301810.56'	526424.00'	6.49'	3.15
Notes:	1-8 - Unable	to visually ve	erify size and	matterial du	ue to depth and	groundwater. Possi	ble 6" cast iro	n.				Prengred by: EE	Date: 02/12/2	019
												Prepared by: EE	Date: 02/12/20	
												Checked by: AB	Date: 02/12/	2019
	REVISION	5								Q et a et es	OF FLORIDA			

Test Hole Data Report

ECHO UES, Inc. www.echoues.com

888.778.ECHO

SHEET

4/30/2021 11:22:27 AM Default

Tampa, Florida 33602
Engineer of Record: Branan R. Anderson, PE
P.E. No.: 78438

ROAD NO.

SR 45

COUNTY

HILLSBOROUGH

FINANCIAL PROJECT ID

440749-1-52-01

UTILITY ADJUSTMENTS (19)

Date:

dgrumbach

ECHO Project #:

Financial Project #:

12/04/2018

18-252

N/A

16514 N. Dale Mabry Hwy.

Tampa, Florida 33618

1511 E. SR434, Ste. 2001, #252

Date:		12	2/05/2018				Test Hol	e Data Repo	art.			Crew Members:		DW, TG
ECHO Pro	iect #:		18-252	16	5514 N. Dale Ma	ibry Hwy.			_	ECHO U	ES, Inc.	City, State:	Т	ampa, Florida
			N/A		Tampa, Florida	33618	 	CH		www.echo	-	General Location:		US 41
Financial F	•			1511	l E. SR434, Ste.					888.778				
Truck No.:			D-3/T-2	Win	ter Springs, Flo	1108 32700	JTILITY ENG	INEERING &	SURVEY	- GROW, INSPIRE, MA		Coordinate Unit of Meas		S Survey Feet
		Itility Type				Utilit	y Material			Identifi	ed By:	Abbreviations		sured From:
BE = Buried		RW = Reclai			AC = Transite		FIBG = Fiberg			HUB = Survey Hub		N/A = Not Applicable	EP= Edge of Pavement	
GM = Gas M		SL = Street I	_		CI= Cast Iron				hylene Pipe	IRC = Iron Rod & Cap			BC = Back of Cu	
BT = Buried		TS = Traffic			CP = Concrete P		PE = Polyethy			NL = Nail & Disk "ECH	IO TEST HOLE"	Datum	BL = Baseline of	
FOC = Fiber		FL = Fuel Lir GS = Gas Se			DBC = Direct Bu		PVC = Polyvin	iyi Chloride		SLEEVE = Sleeve X = "X" in Concrete		NAVD = North American Vertical Datum	COORD = Surve CL = Centerline	y Coordinates
WM = Wate SAN = Sanita		WS = Water			CMP = Corrugat CONC = Concret		STL = Steel VCP = Vitrifie	d Clay Dina		Surface	Tuno	UNK = Unknown	HUB = Survey H	ub
SAN = Sanita STM = Storn		UNK = Unkr			CPP = Corrugate		†		r Constato	ASPH = Asphalt	: туре	COT = City of Tampa	RW = Right of W	
CATV = Cabl			d Electrical D	ouct	DCT = Duct	ed Flastic Fipe	Pipe Presti	ressed Cylinde	r concrete	CONC = Concrete		cor – city or rampa	ST = Swing Ties	, uy
FM = Force I			d Telephone		DIP = Ductile Iro	on Pipe		rced Concrete	Pipe	NG = Natural Ground			X = "X" in Concr	ete
			Utility Size	Utility		Ņ			Surface			Horizontal: NAD83/11		
Test Hole	Utility Type	Utility	Outside	Manual	Cross	+	Identified By	Surface Type	Thickness	Apparent Utility	Datums:	Vertical: NAVD88		Utility
100011010	ounty type	Material	Diameter	Depth	Sectional View	¥↓¾ Utility Direction	raciiciica by	ouridee Type	inches	Owner	Northing	Easting	Elevation	Elevation
1-10	FOC	PE	inches 12 - 1.5"	feet 3.96'	000 0000 0000	A A	IRC	NG	N/A	FRONTIER	1302430.03	526421.52'	6.62'	2.66'
1-11	ВТ	PVC	2 - 4"	2.50'	000000	*	IRC	NG	N/A	FRONTIER	1302430.50	526424.77'	6.68'	4.18'
1-12	FOC/BT	PVC	4"	1.90'		<u> </u>	IRC	NG	N/A	FRONTIER	1302430.47'	526425.15'	6.69'	4.79'
						<u> </u>								
1-13	ВТ	DBC	2"	1.56'	0	\	IRC	NG	N/A	FRONTIER	1302430.15'	526428.11'	6.81'	5.25'
1-14	WM	DIP	6"	3.40"		<u> </u>	IRC	NG	N/A	СОТ	1302428.62	526446.38'	8.20'	4.80'
1-15	GM	STL	4"	3.00'		Ţ	IRC	NG	N/A	сот	1302488.18'	526318.06'	6.08'	3.08'
1-16	ВТ	PVC	4"	3.50'			IRC	NG	N/A	FRONTIER	1301205.22'	526417.96'	7.50'	4.00'
1-17	ВТ	DBC	2"	3.00'	0		IRC	NG	N/A	FRONTIER	1301810.09'	526422.72'	6.80'	3.80'
Notes:														
												Prepared by: EE	Date: 02/12/20	019
												Checked by: AB	Date: 02/12/	2019

REVISIONS STATE OF FLORIDA Kisinger Campo & Associates Corp. 201 N. Franklin Street, Suite 400 DESCRIPTION DATE DESCRIPTION DATE DEPARTMENT OF TRANSPORTATION Tampa, Florida 33602
Engineer of Record: Branan R. Anderson, PE
P.E. No.: 78438 ROAD NO. COUNTY SR 45 HILLSBOROUGH 440749-1-52-01

FINANCIAL PROJECT ID

UTILITY ADJUSTMENTS (20)

SHEET NO.

c:\pwworkingdir\kca-pw.bentley.com_kca-pw-01\dean grumbach\dms07001\UTADRD00.dgn

Date:		12	2/06/2018				Test Hol	e Data Repo	ort			Crew Members:		DW, TG, MAJ
ECHO Proj	ject #:		18-252	16	5514 N. Dale Ma	abry Hwy.				ECHO U	IES, Inc.	City, State:	Т	ampa, Florida
Financial F	•		N/A		Tampa, Florida	33618	≫⊩	ECH		www.ech		General Location:	US 41	
Truck No.:			D-3/T-2		L E. SR434, Ste.					888.778 - GROW, INSPIRE, M		Coordinate Unit of Measure:		S Survey Feet
TTUCK NO		IATIDA - Trans	,	Win	ter Springs, Flo	nida SE700		INEERING &	SURVET					· ·
DE D 41.41		Itility Type			A.C. Turning	Utilit	y Material	l		Identif	iea By:	Abbreviations		sured From:
BE = Buried I		RW = Reclai			AC = Transite		FIBG = Fiberg		hulana Bina	HUB = Survey Hub	PECHO TEST HOLE!	N/A = Not Applicable NAD = North American	EP= Edge of Pay	
GM = Gas M BT = Buried		SL = Street TS = Traffic	ŭ		CI= Cast Iron CP = Concrete P	lino	PE = Polyethy		nylene Pipe	IRC = Iron Rod & Cap NL = Nail & Disk "ECI		Datum	BC = Back of Cu BL = Baseline of	
FOC = Fiber		FL = Fuel Lir			DBC = Direct Bu		PVC = Polyetny			SLEEVE = Sleeve	HO TEST HOLE	NAVD = North American	COORD = Surve	,
WM = Water		GS = Gas Se			CMP = Corrugat		STL = Steel	iyi cilionde		X = "X" in Concrete		Vertical Datum	CL = Centerline	
SAN = Sanita		WS = Water			CONC = Concre		VCP = Vitrifie	d Clay Bina		Surfac	o Typo	UNK = Unknown	HUB = Survey H	
STM = Storm	•	UNK = Unkr			CPP = Corrugate		1		v Consusta	ASPH = Asphalt	етуре	COT = City of Tampa	RW = Right of V	
CATV = Cable			d Electrical D	huct	DCT = Duct	eu riasuc ripe	Pipe Prest	ressed Cylinde	r Concrete	CONC = Concrete		COT - City of Tampa	ST = Swing Ties	
FM = Force N			d Telephone		DIP = Ductile Iro	n Pine		rced Concrete	Pine	NG = Natural Ground	4		X = "X" in Conci	
rivi – roice	viaiii	BTB - Burie	Utility Size	Utility	DIF - Ductile II C	N N	KCF - Kellilo	rcea concrete		NG - Natural Ground		Horizontal: NAD83/11	X = X III conci	
Took Upla	I IAIlian Tono	Utility	Outside	Manual	Cross	*	uda asida ad no.	Conferentian	Surface	Apparent Utility	Datums:	Vertical: NAVD88	Ground	Utility
lest Hole	Utility Type	Material	Diameter	Depth	Sectional View	▼	identified by	Surface Type	Thickness inches	Owner	Northina		Elevation	Elevation
			inches	feet		Utility Direction			inches		Northing	Easting		
1-18	вт	PVC	2 - 4"	3.82'	00		IRC	NG	N/A	FRONTIER	1303091.15'	526425.13'	7.04'	3.22'
1-19	FOC/BT	PVC	4"	2.54'			IRC	NG	N/A	FRONTIER	1303091.17	526425.73"	6.99'	4.45'
1-20	вт	LEAD	2 - 2"	3.00'	00	\^	IRC	NG	N/A	FRONTIER	1303091.09'	526427.92'	6.86'	3.86'
1-21	FOC	UNK	12 - 1.5"	9.22'	888888	‡	IRC	NG	N/A	FRONTIER	1303091.01	526430.76'	6.58'	-2.64'
1-22	вт	LEAD	2 - 2"	2.00'	00		IRC	NG	N/A	FRONTIER	1303695.15'	526432.46'	6.77'	4.77'
1-23	вт	PVC	2 - 4"	2.76'	00		IRC	NG	N/A	FRONTIER	1303695.20'	526433.46'	6.70'	3.94'
1-24	ВТ	LEAD	2 - 2"	2.74'	00	‡	IRC	NG	N/A	FRONTIER	1304500.45	526435.53'	7.28'	4.54'
Notes:	1-21 - Unable	e to visually v	erify size and	d material du	ue to depth and g	groundwater. Possil	bly 12 - 1.5" p	olyethylene pi	pes.					
												Prepared by: EE	Date: 02/12/2	019
												Checked by: AB	Date: 02/12/	2019

REVISIONS DESCRIPTION DESCRIPTION DATE

Kisinger Campo & Associates Corp. 201 N. Franklin Street, Suite 400 Tampa, Florida 33602 Engineer of Record: Branan R. Anderson, PE P.E. No.: 78438

STATE OF FLORIDA DEPARTMENT OF TRANSPORTATION ROAD NO. COUNTY FINANCIAL PROJECT ID SR 45 HILLSBOROUGH 440749-1-52-01


UTILITY ADJUSTMENTS (21)


SHEET NO.

STATE OF FLORIDA DEPARTMENT OF TRANSPORTATION

CONTRACT PLANS

FINANCIAL PROJECT ID 440749-1-52-01

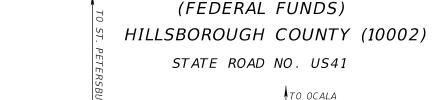

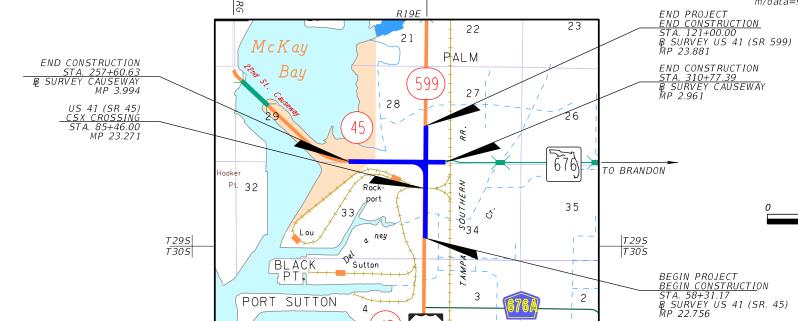

TO BRADENTON

Mile

LOCATION OF PROJECT

m/data=!3m1!1e3

https://www.google.com/maps/ @27.9206868,-82.3995664,1364

ROADWAY PLANS ENGINEER OF RECORD:

NAPLE

BRANAN R. ANDERSON, P.E. NO.: 78438 KISINGER CAMPO AND ASSOCIATES CORP. CONSULTING ENGINEERS & PLANNERS 201 N. FRANKLIN STREET, SUITE 400 TAMPA, FLORIDA 33602 (813) 871-5331 VENDOR NUMBER.: F59-1677145

FDOT PROJECT MANAGER:

TIM O'BRIEN P.E.

CONSTRUCTION	FISCAL	SHEET			
CONTRACT NO.	YEAR	NO.			
TBD	21	1			


AYTONA BEACH


PIERCE


verizon V


one Terrace, FL 5


PLDCD DV ANDV CO

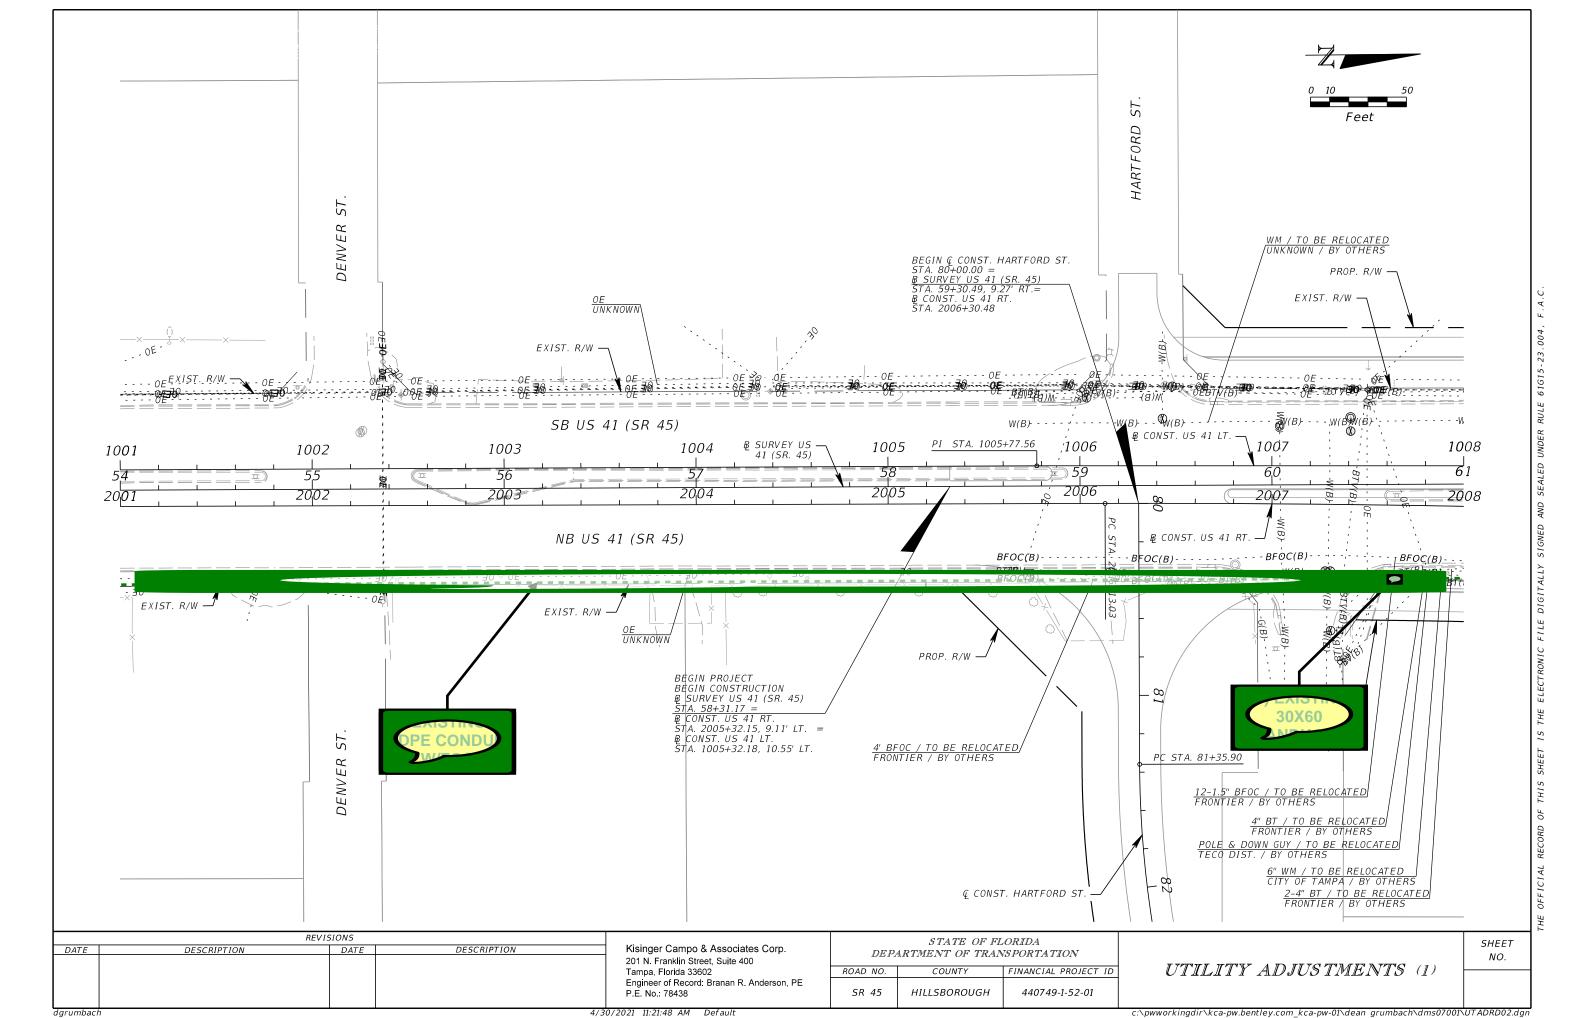


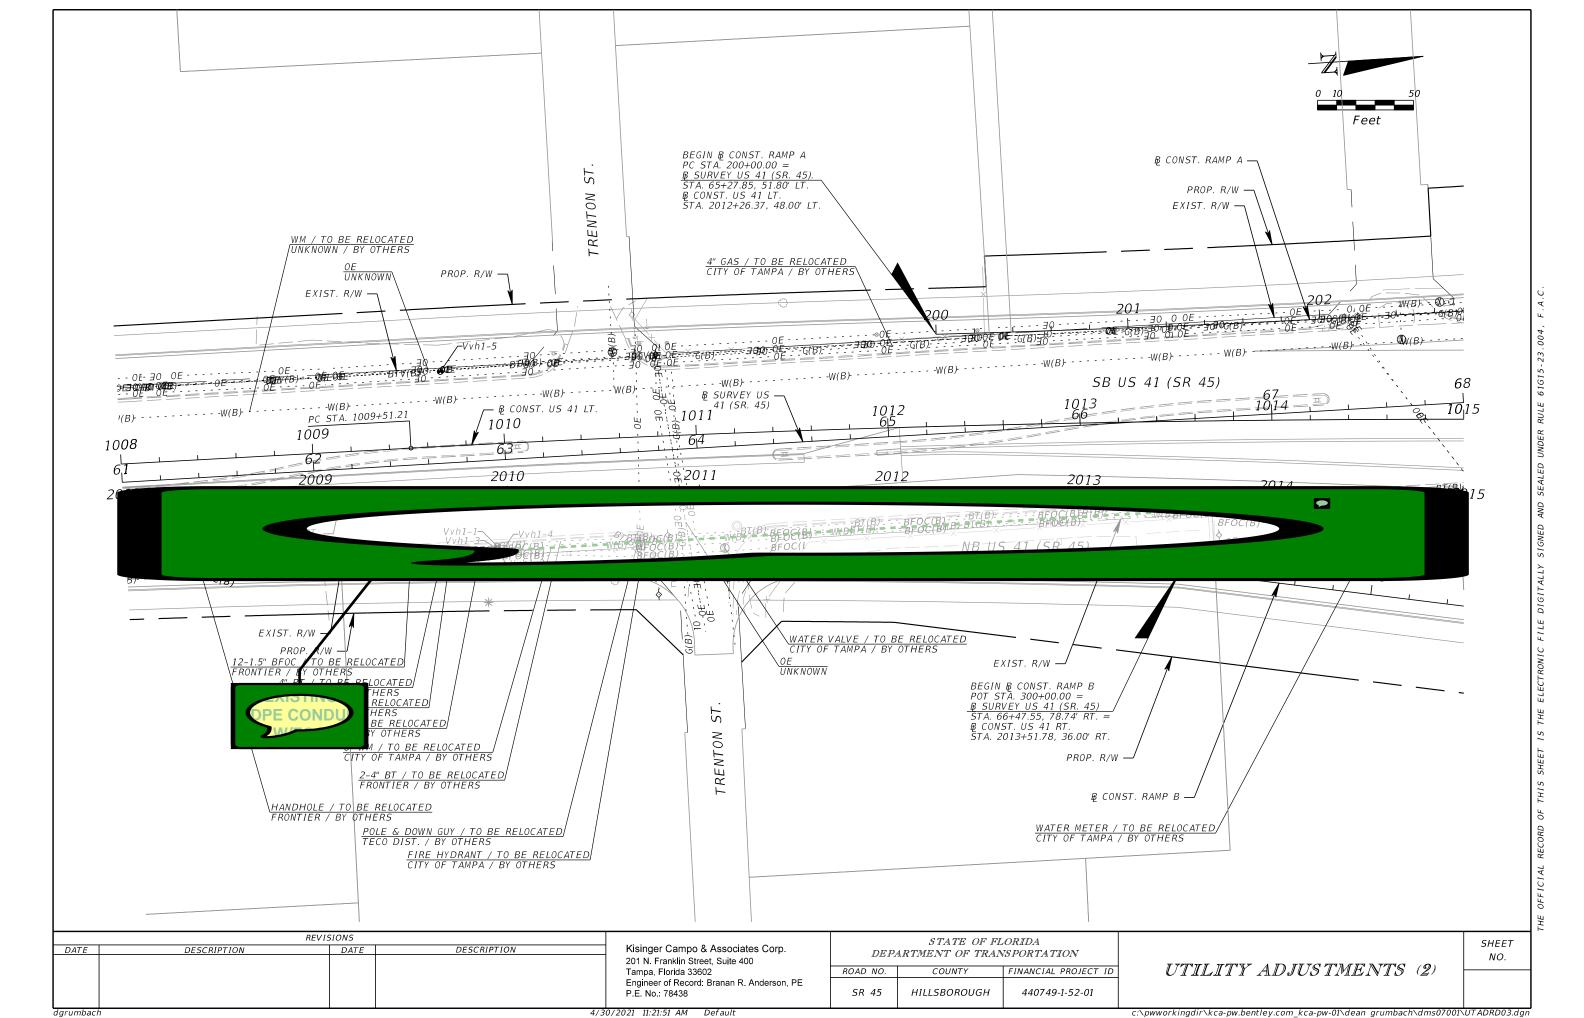


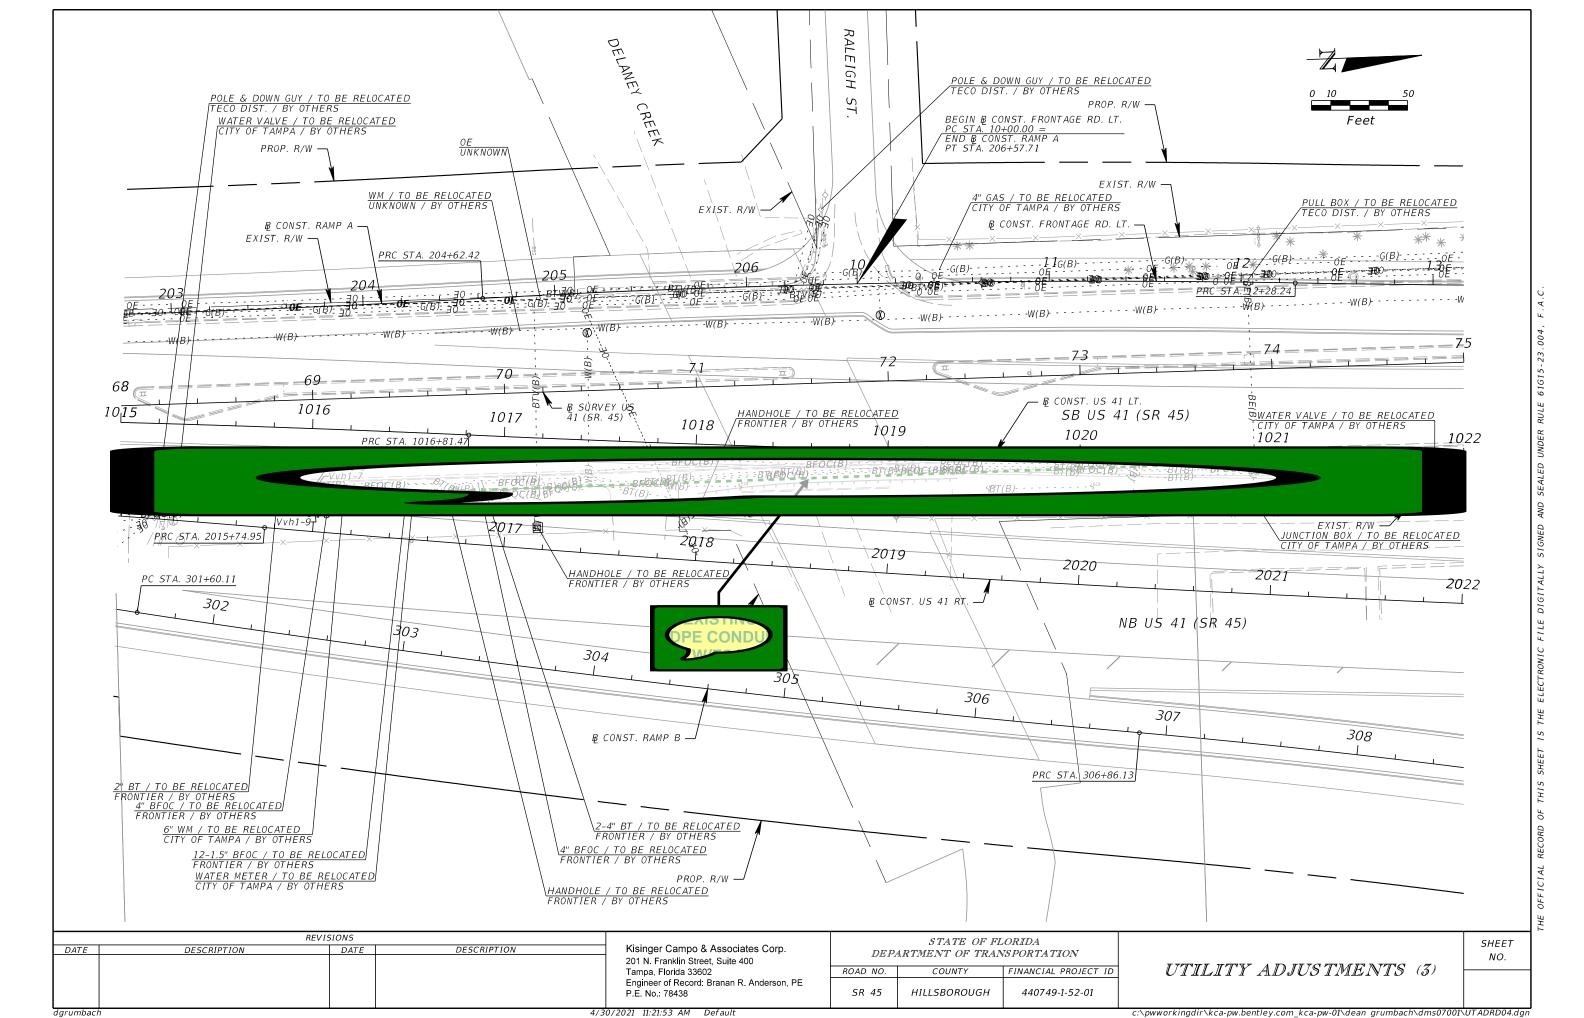


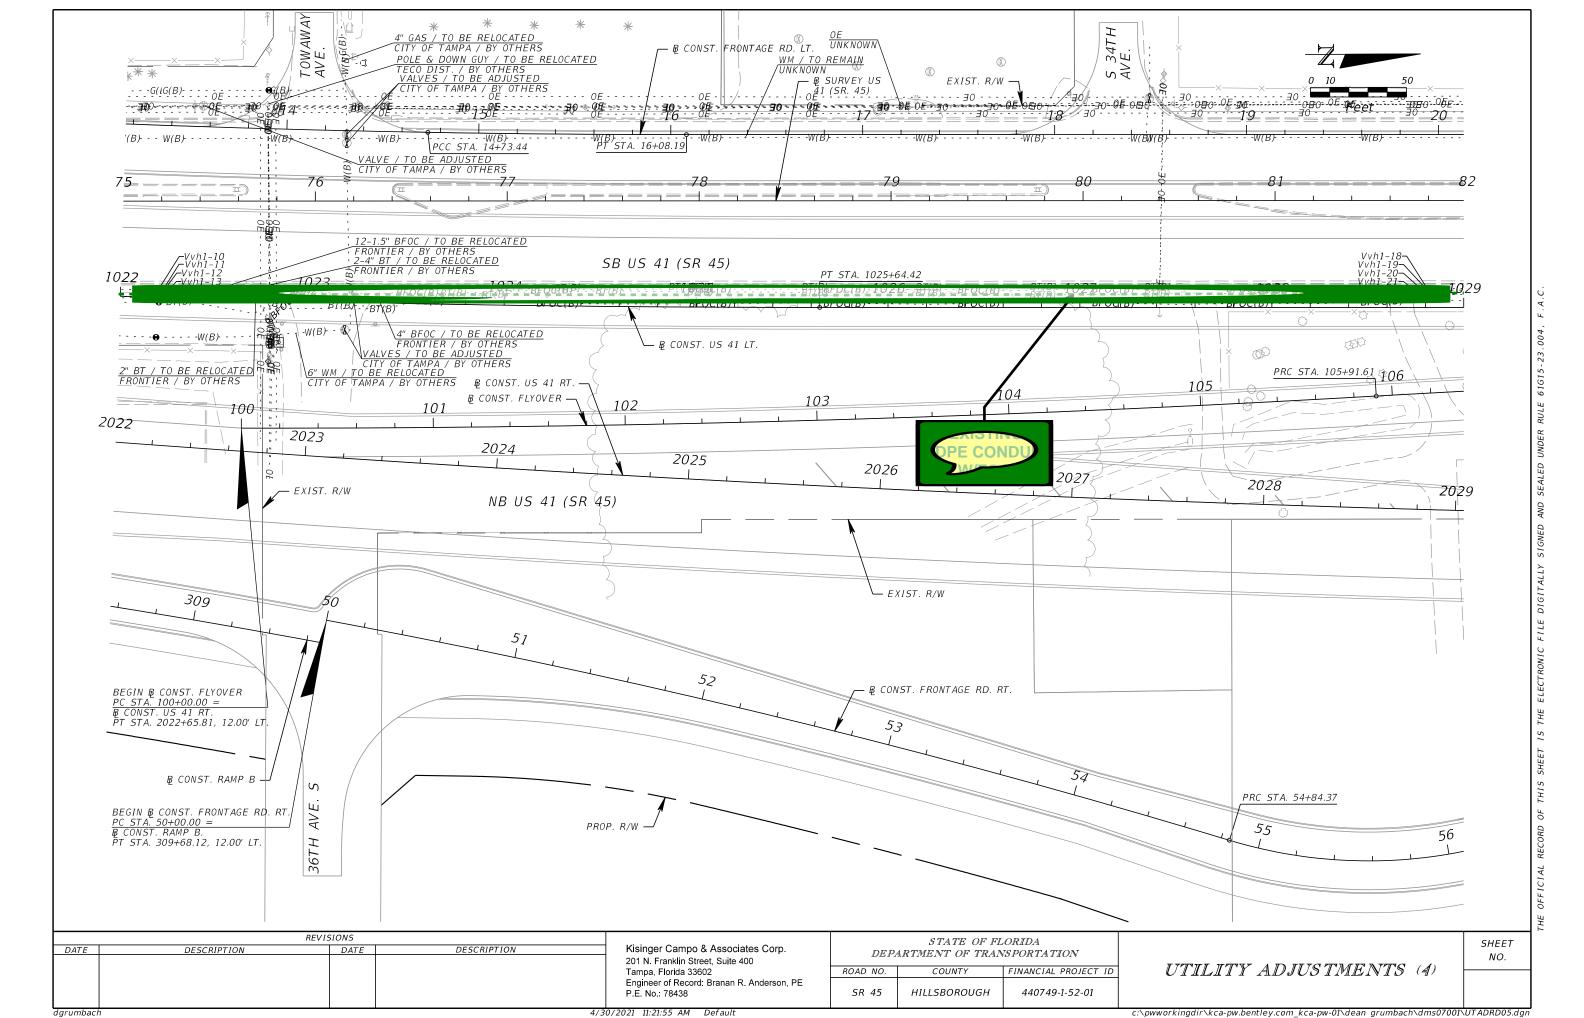


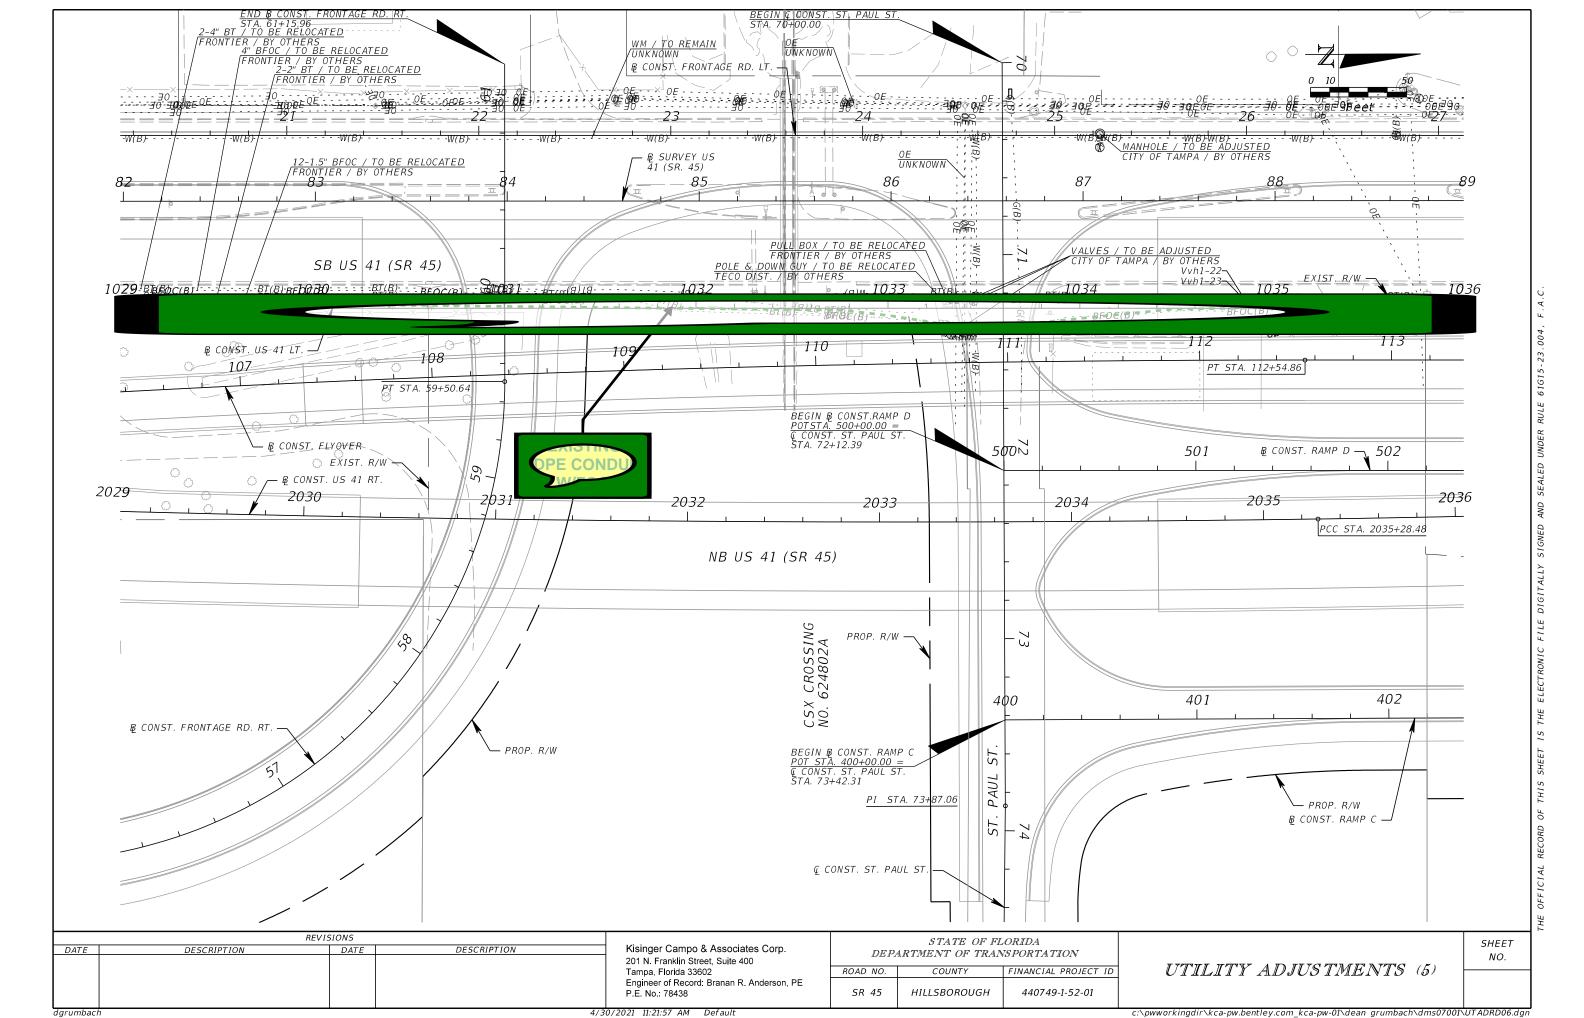


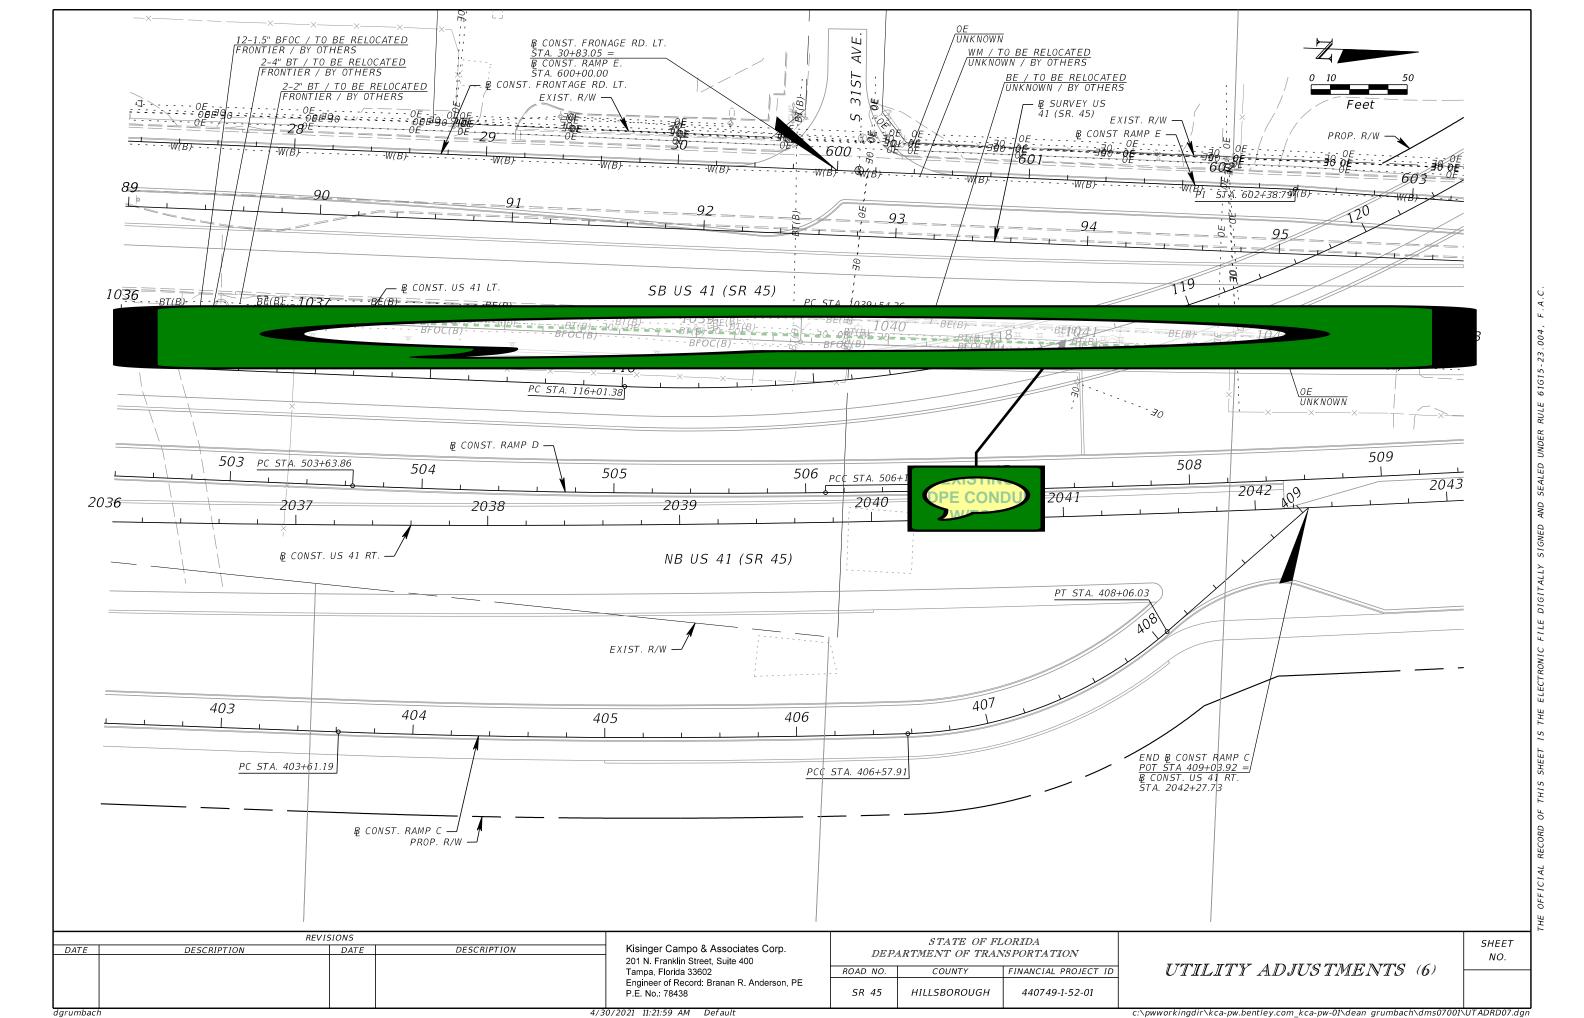


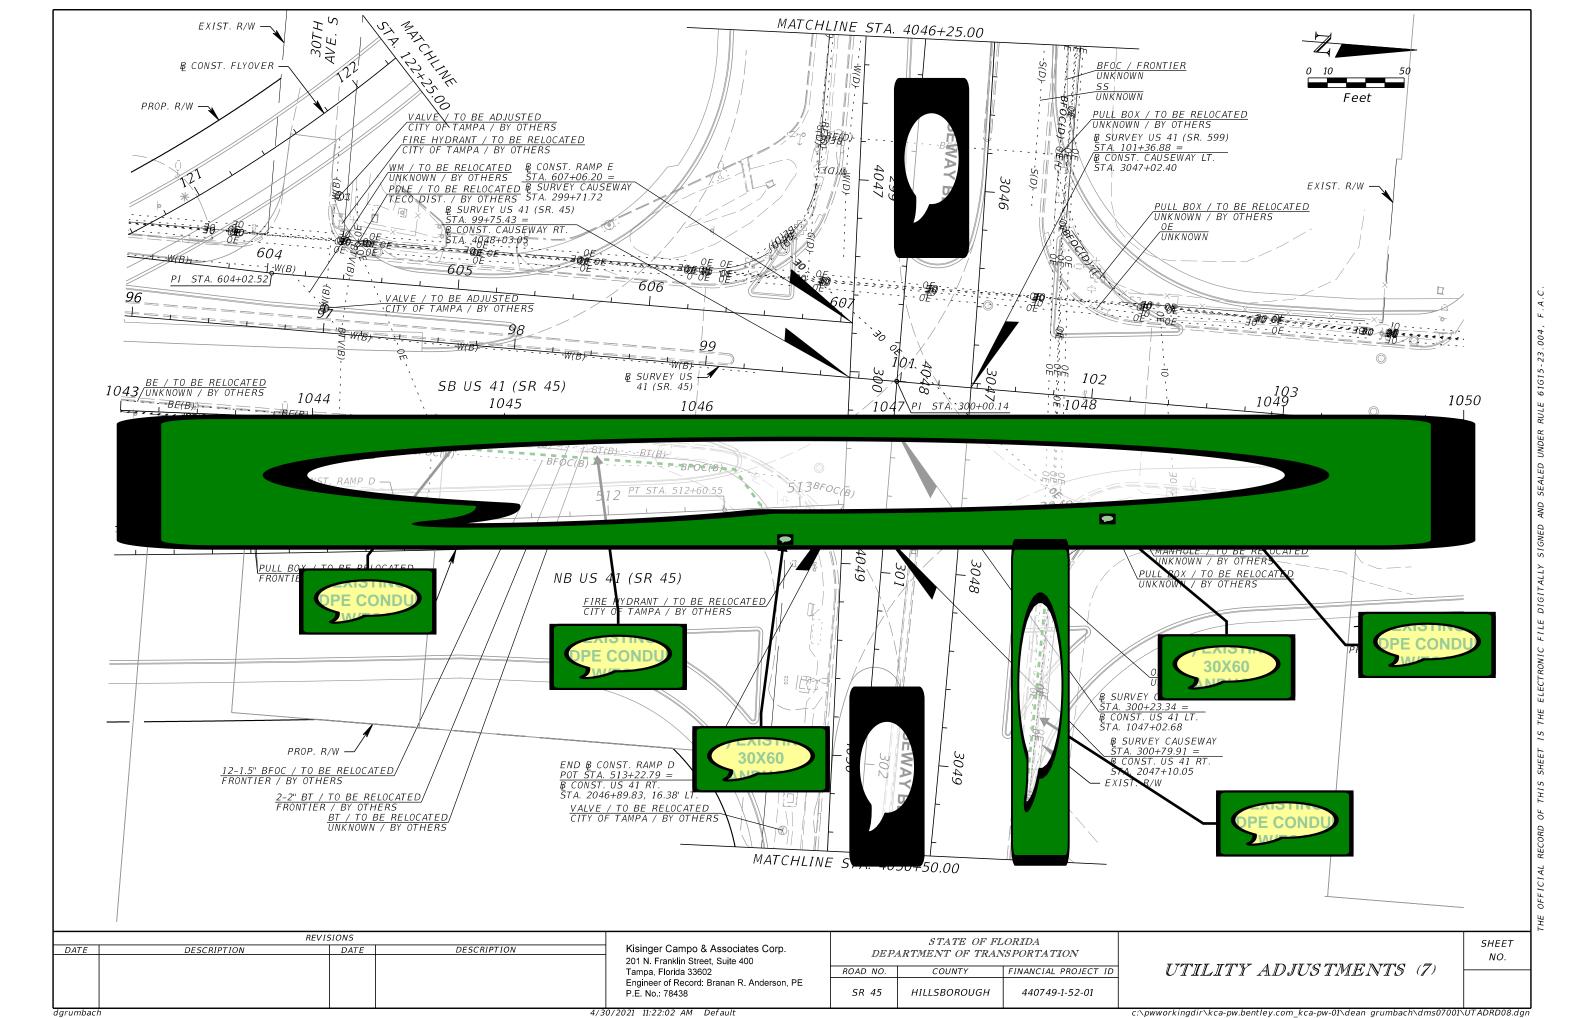

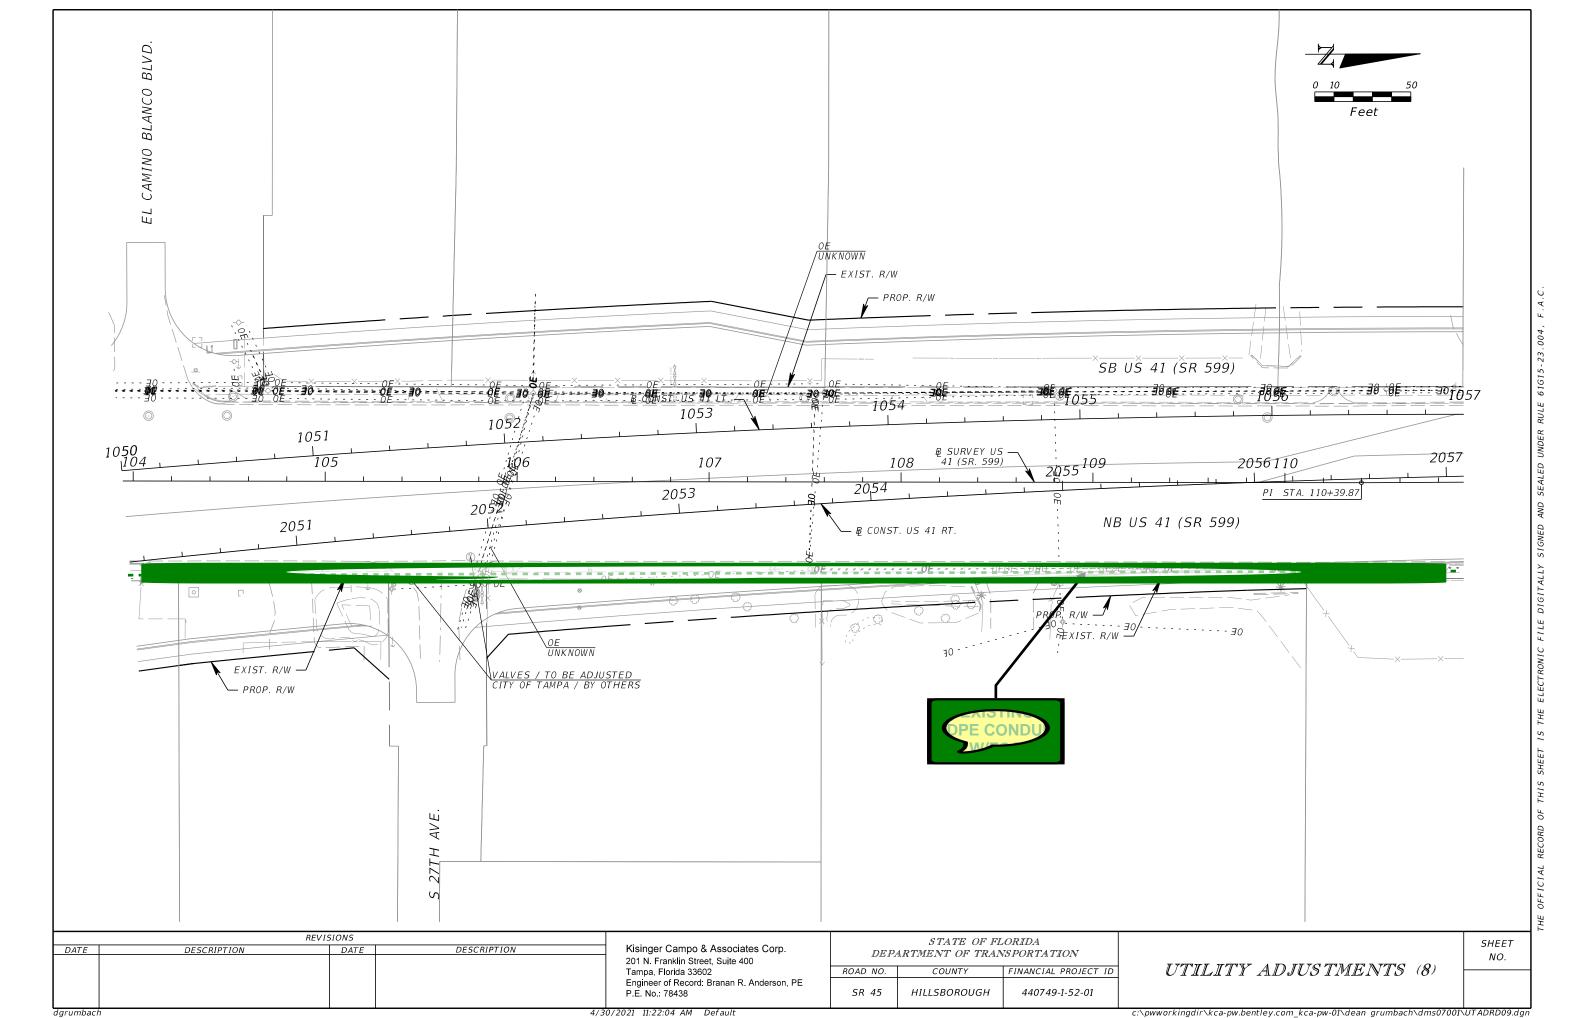

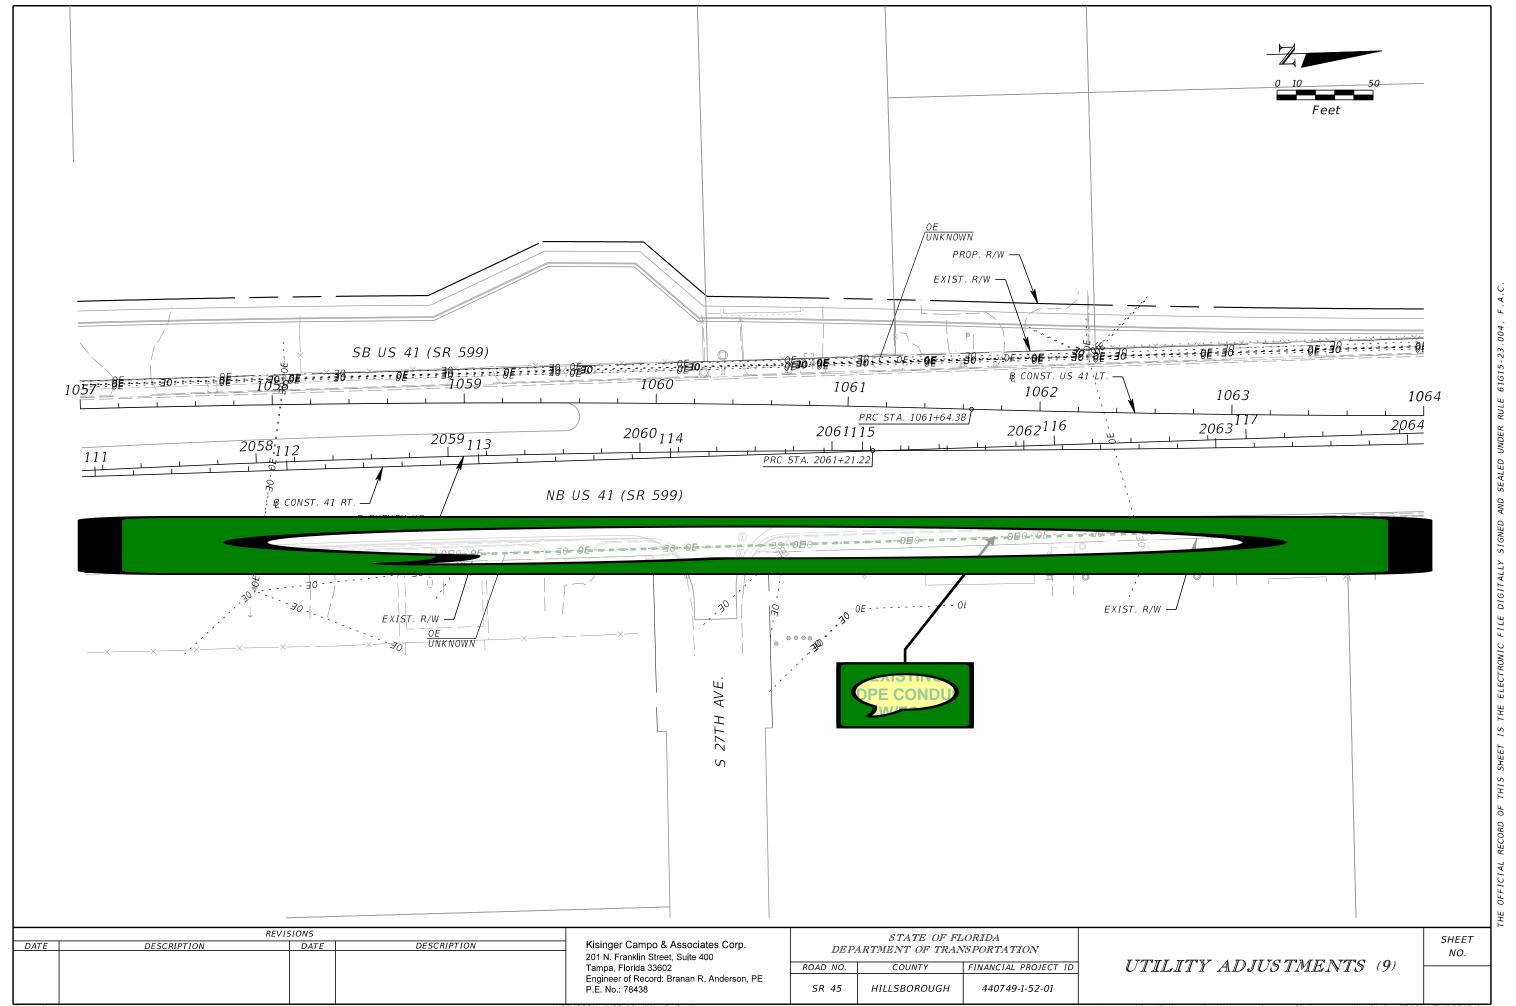


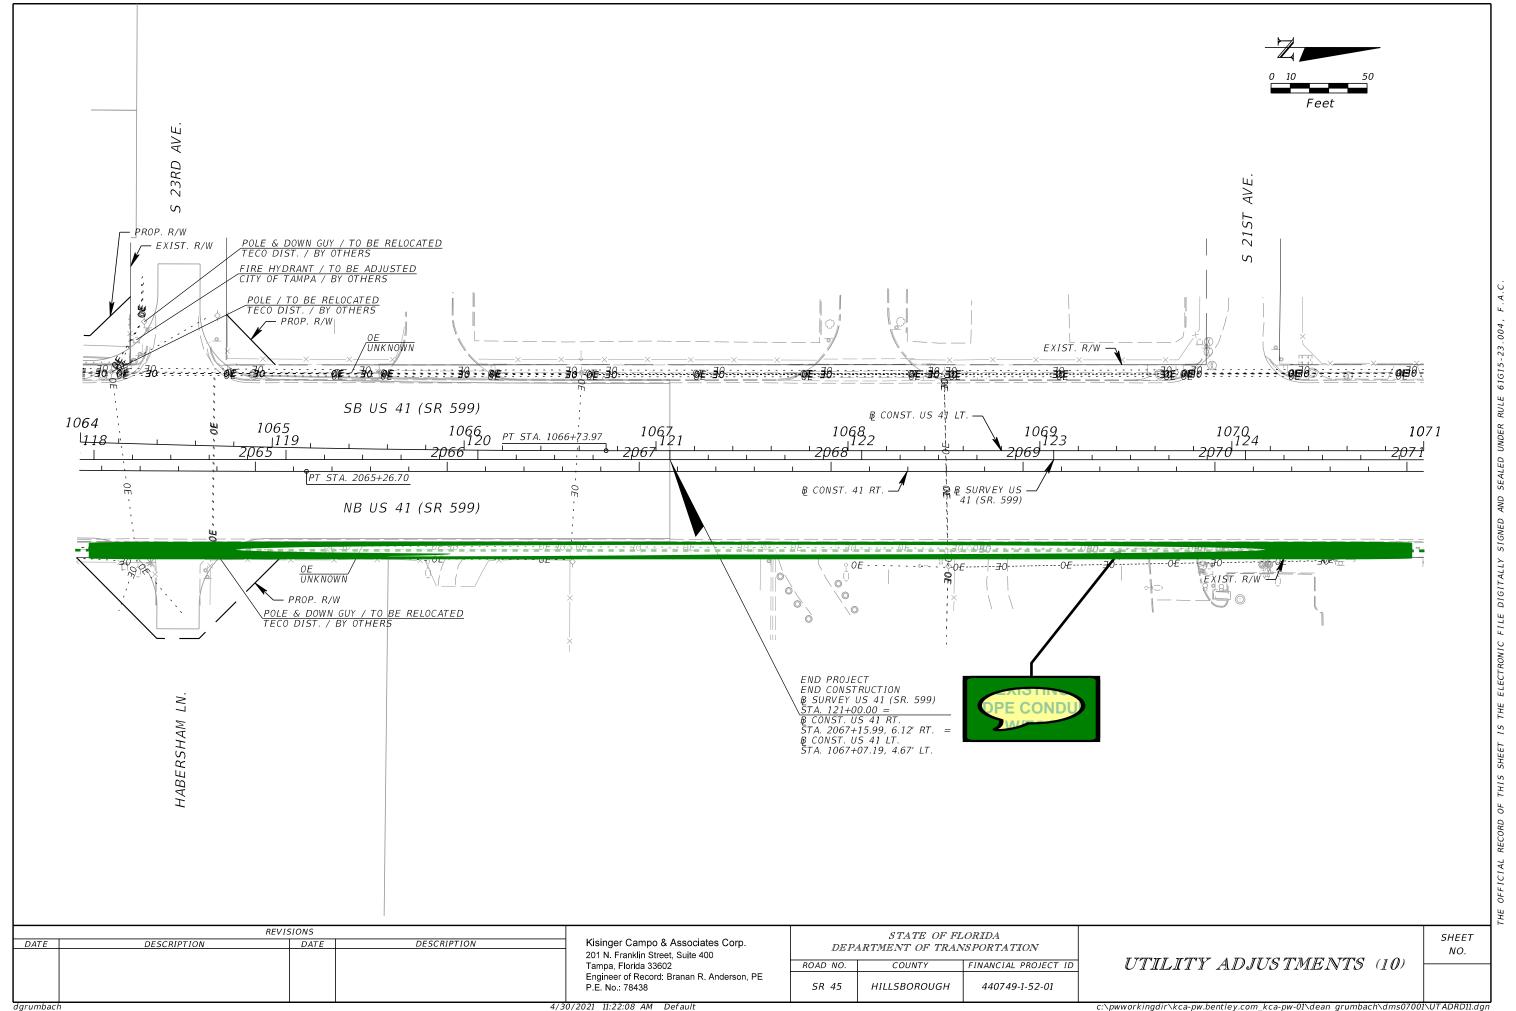

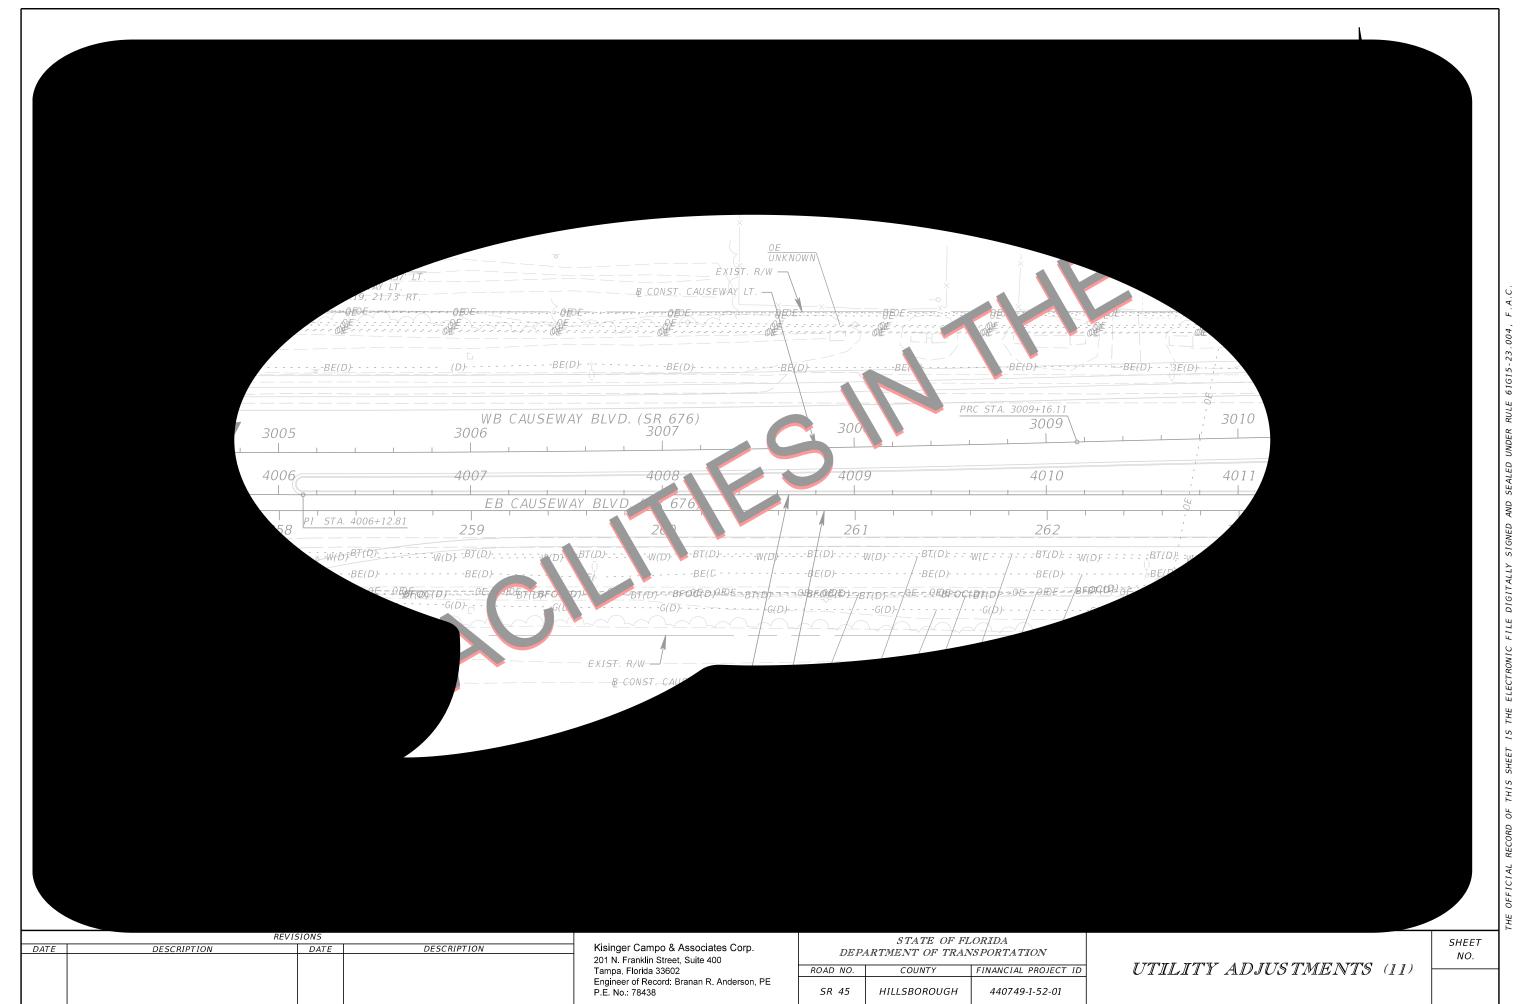


4/30/2021 11:22:10 AM Default


c:\pwworkingdir\kca-pw.bentley.com_kca-pw-01\dean grumbach\dms07001\UTADRD14.dg

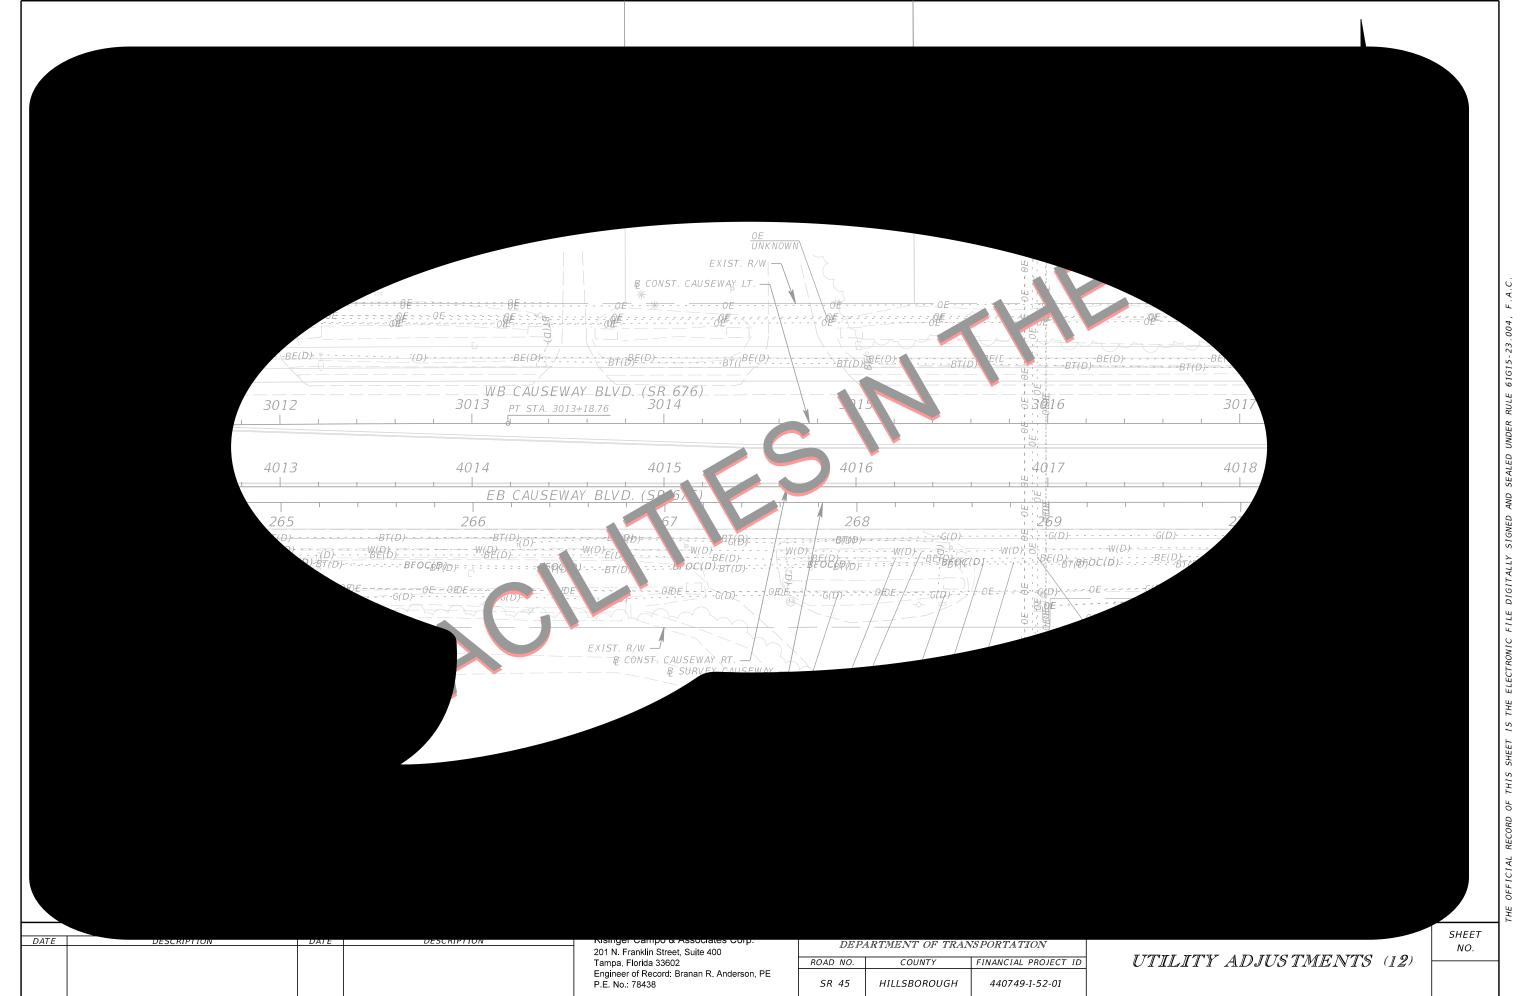


4/30/2021 11:22:12 AM Default


c:\pwworkingdir\kca-pw.bentley.com_kca-pw-01\dean_grumbach\dms07001\UTADRD15.dg

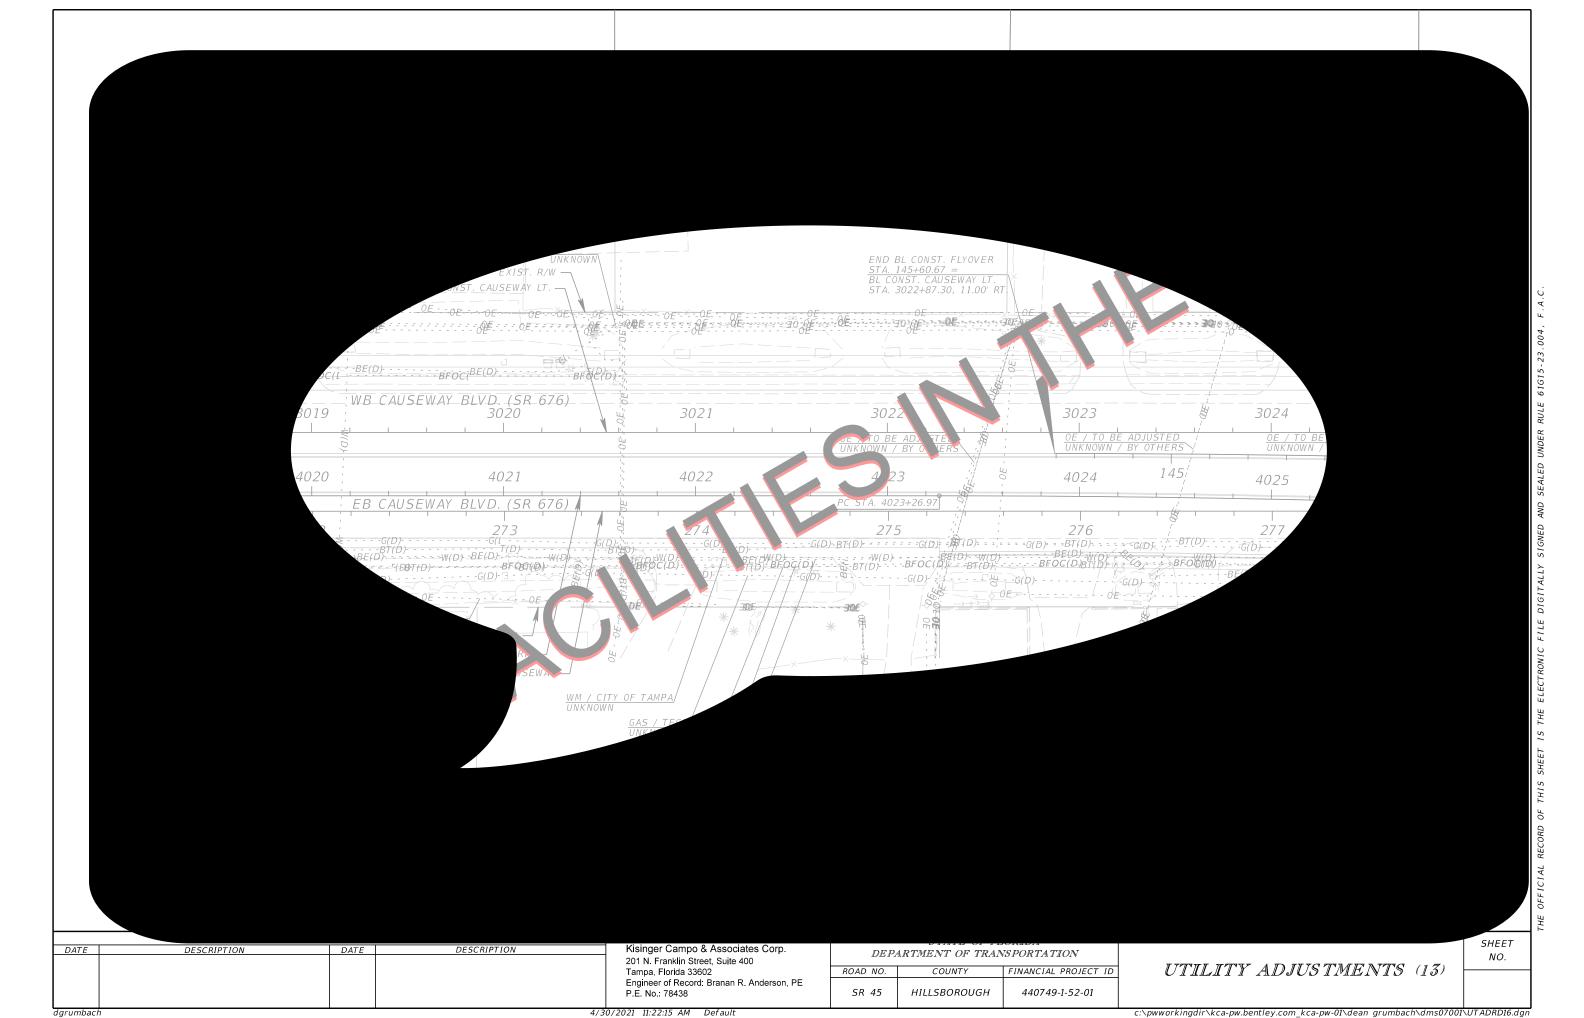


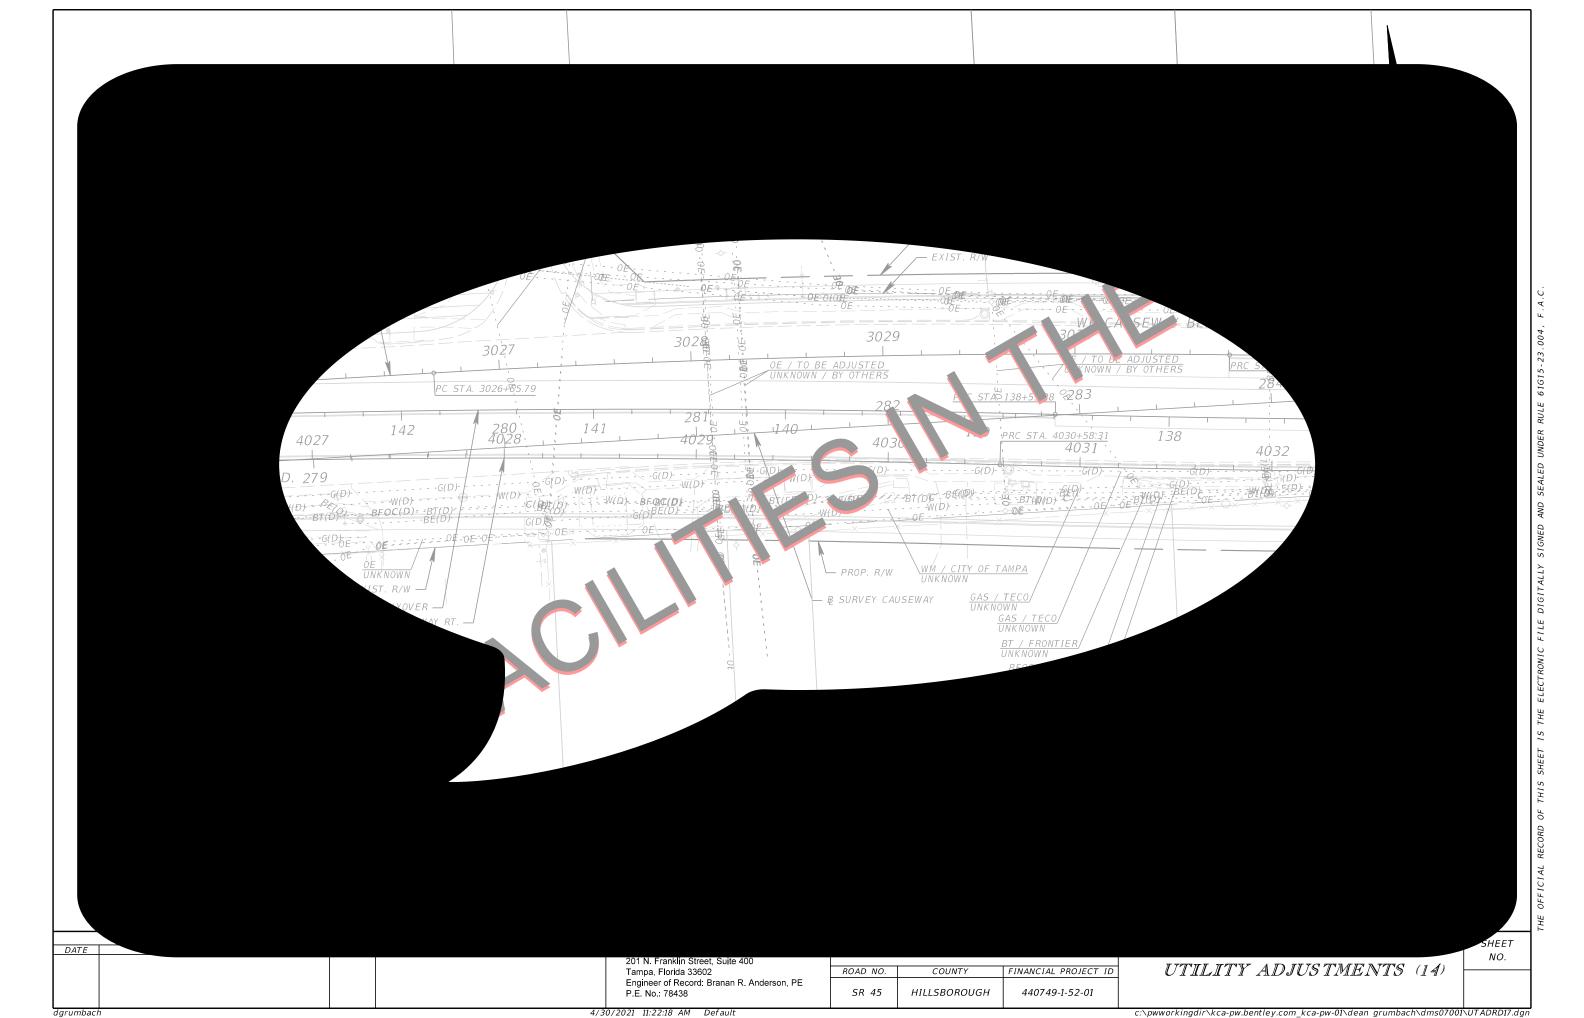


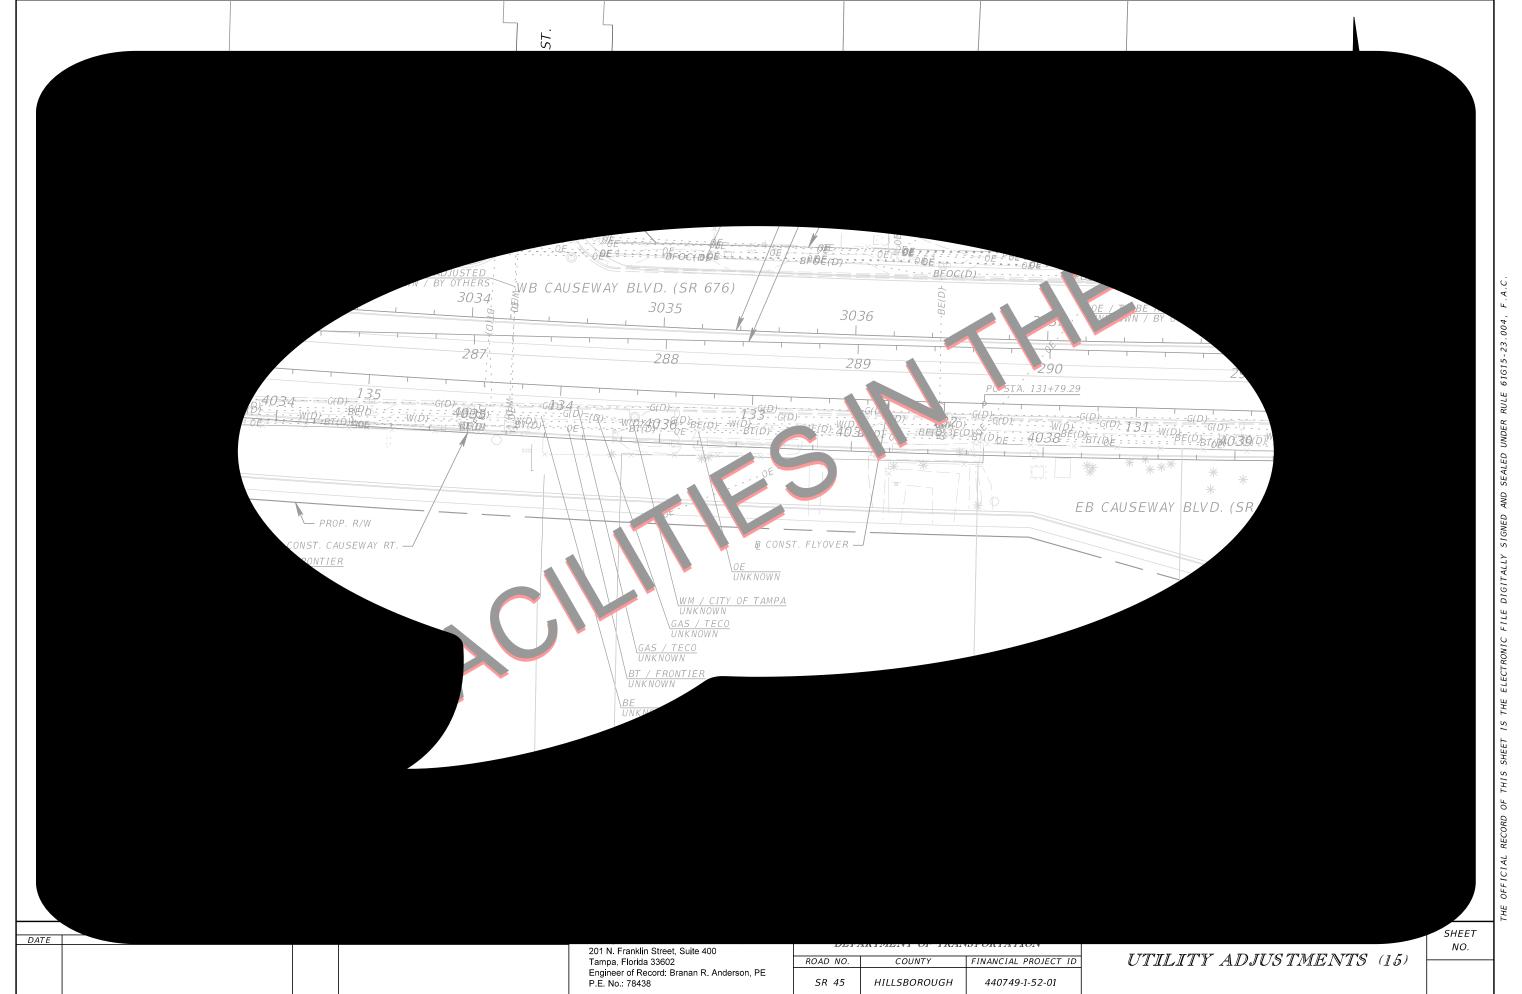

dgrumbach

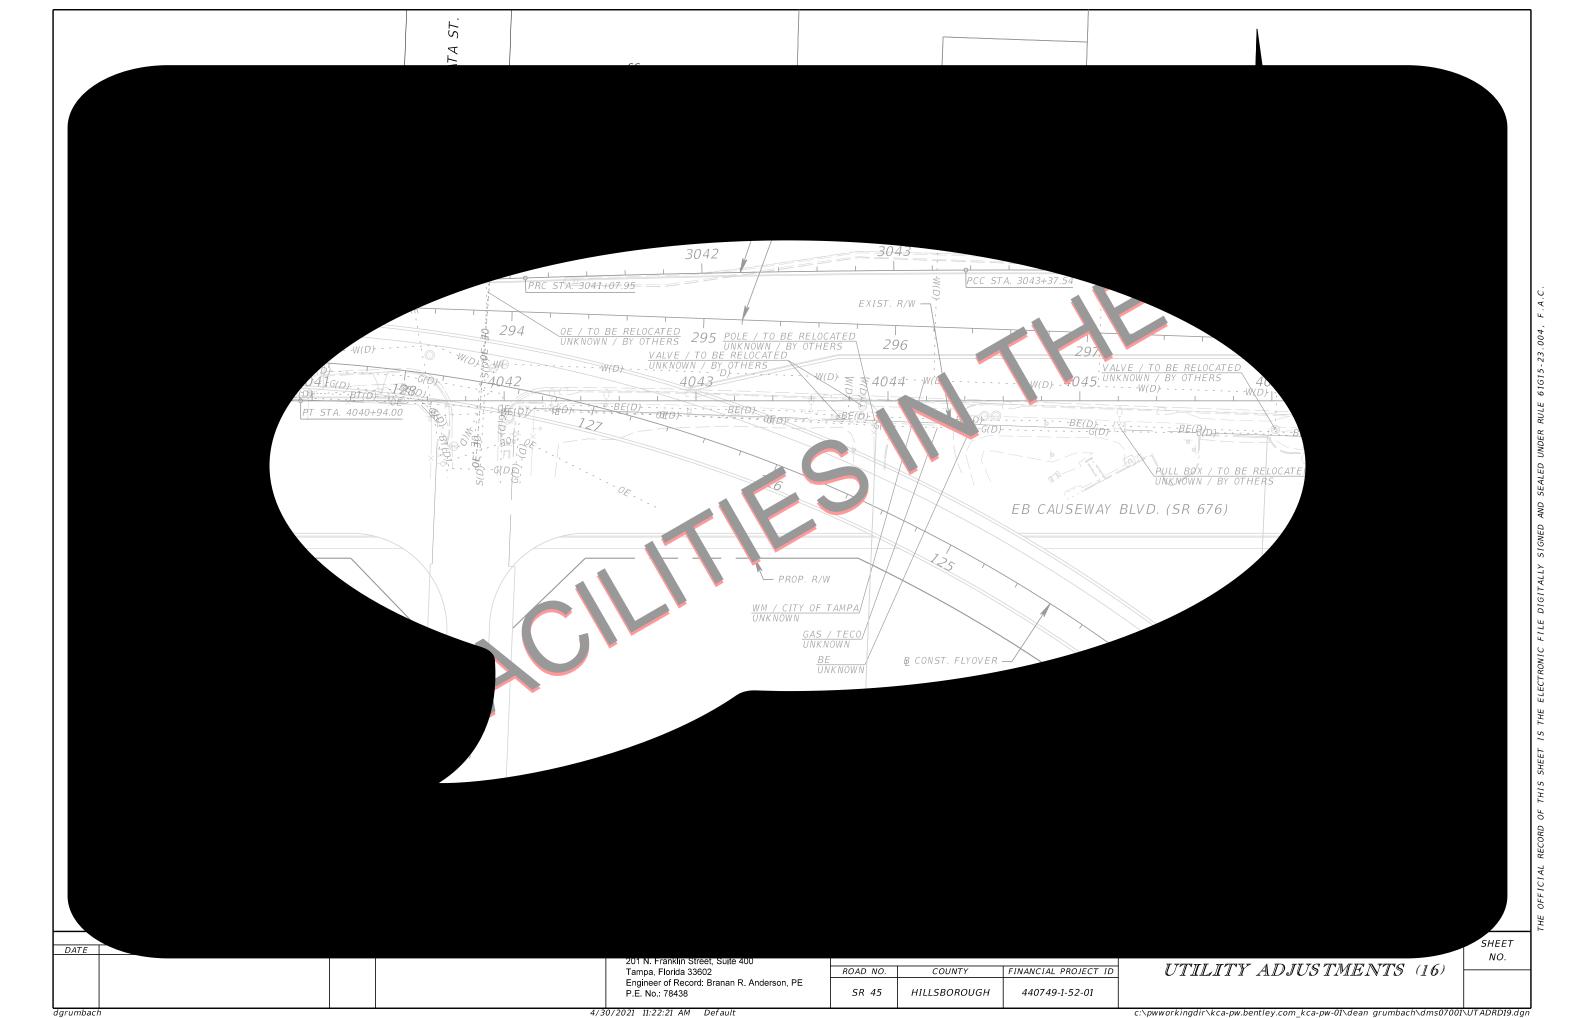

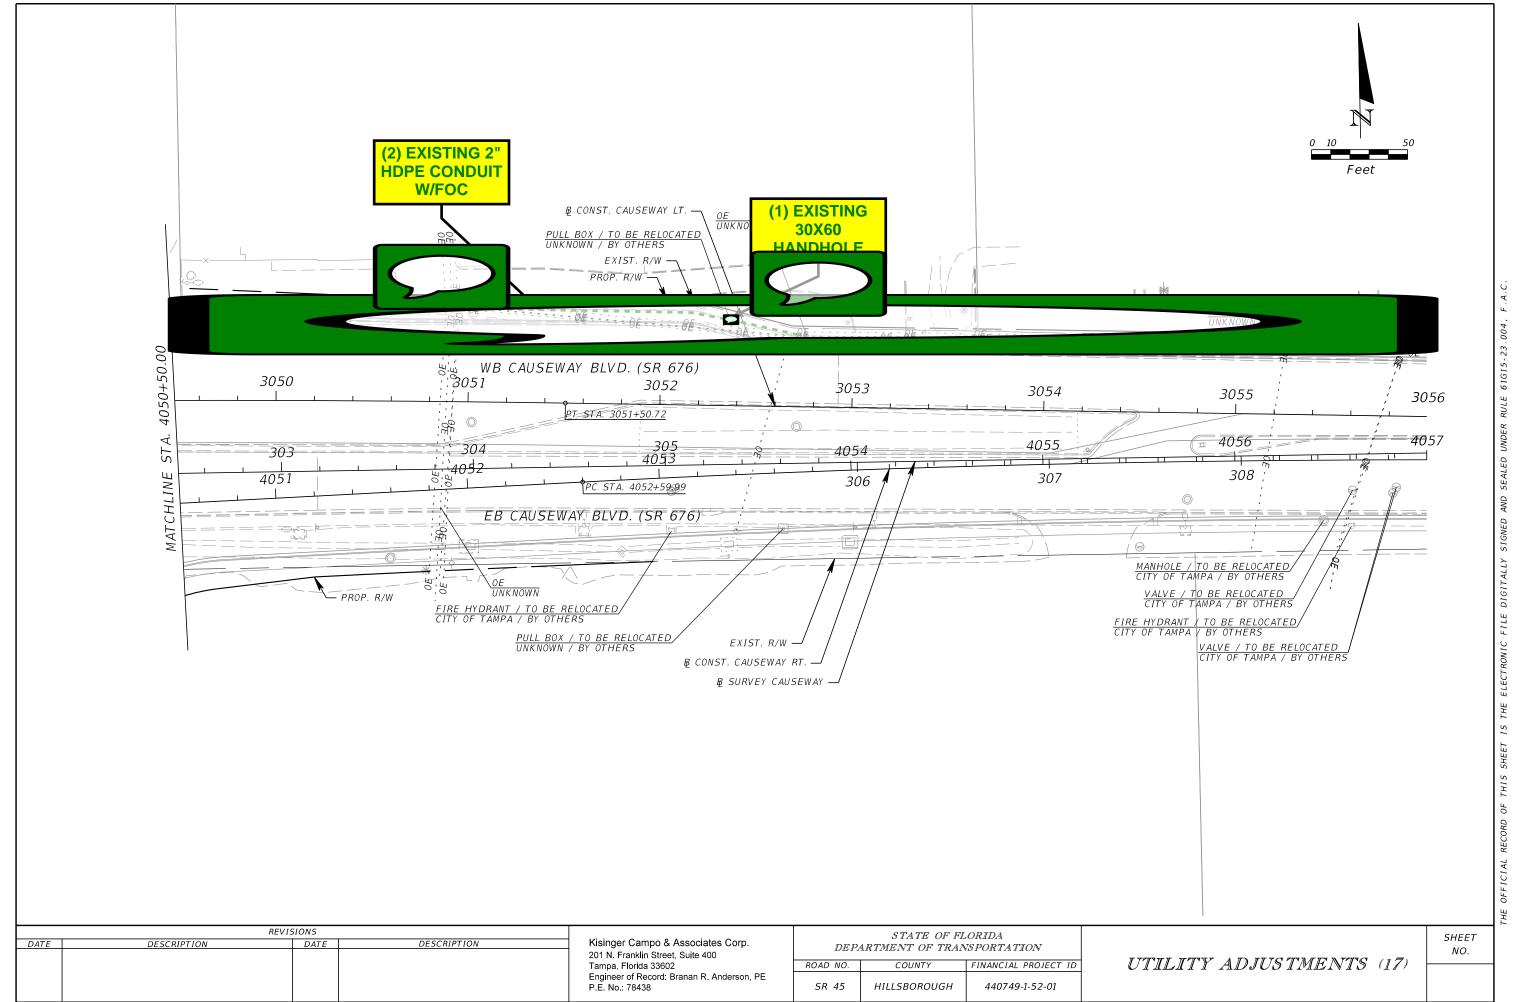

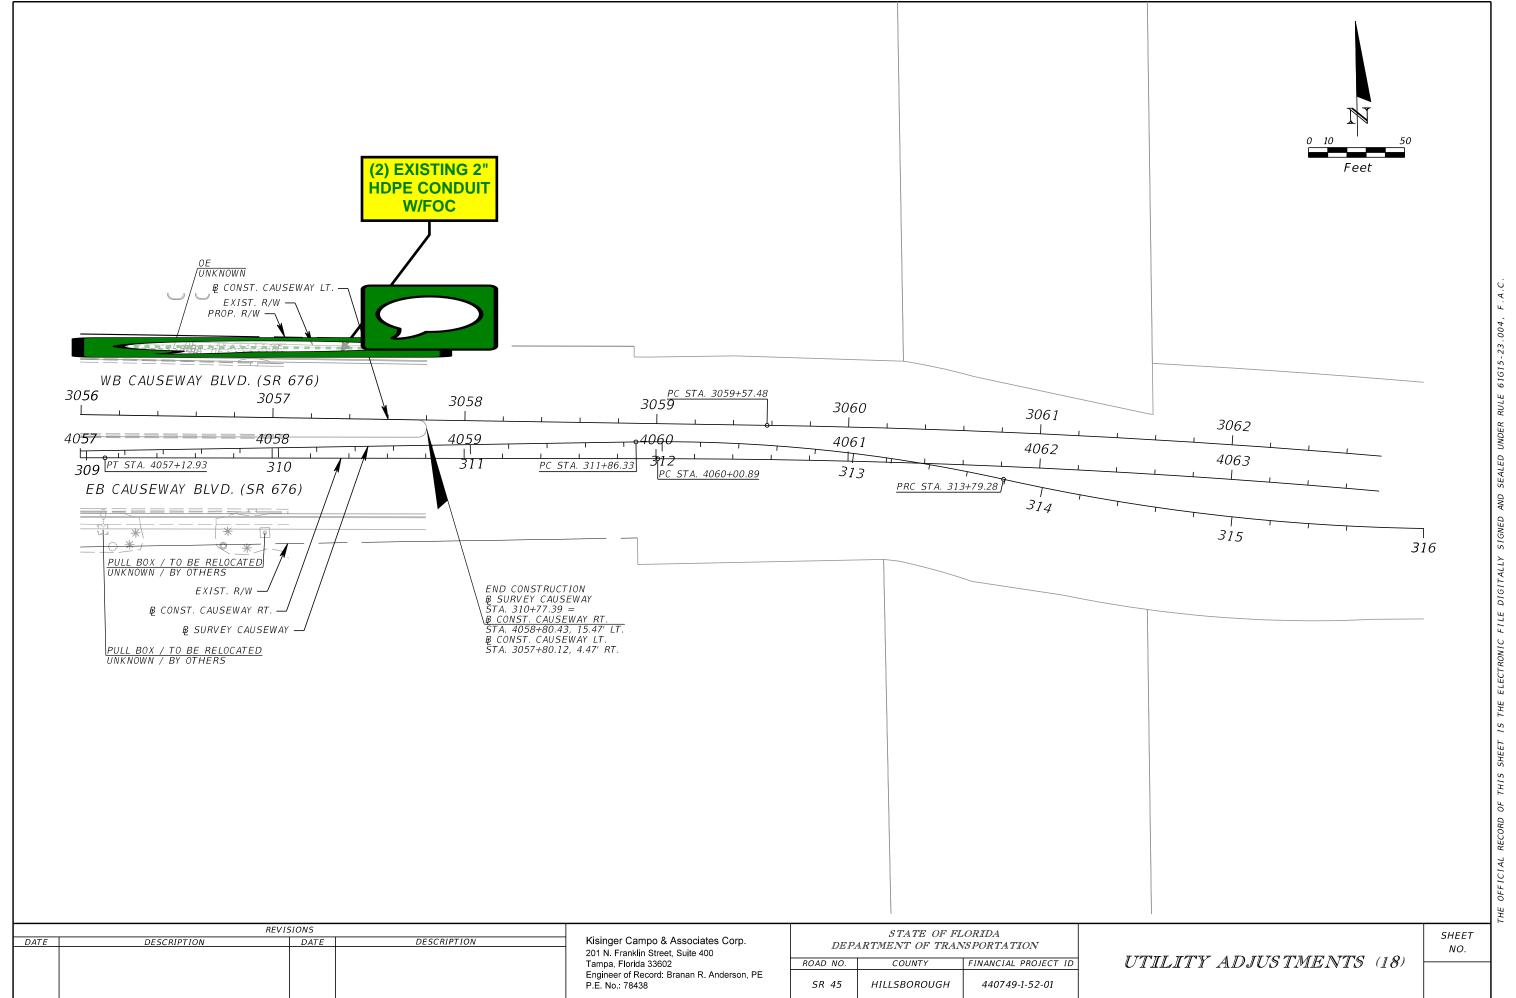

	Cre	w Memb	ers:		DW, TG						
	City	, State:		Ta	ampa, Florida						
	Ger	neral Loca	ation:		US 41						
NCE-	Coc	ordinate (Unit of Meas	ure: U	S Survey Fee						
		Abbrev	riations	Offset Measured From:							
	N/A	= Not Appl	icable	EP= Edge of Pavement							
HOLE"	NAD	= North A	merican	BC = Back of Cu	rb						
	Datu	ım		BL = Baseline of	Survey						
	NAV	D = North	American	COORD = Surve	y Coordinates						
	Vert	ical Datum		CL = Centerline							
	UNK	= Unknow	m	HUB = Survey H	ub						
	COT	= City of T	ampa	RW = Right of W	/ay						
				ST = Swing Ties							
				X = "X" in Concr	ete						
	Hori	zontal:	NAD83/11								
	Vert	ical:	NAVD88	Ground	Utility						
ng		Е	asting	Elevation	Elevation						
4.90'			6413.67	7.51'	4.25'						
5.19'		526	416.74"	7.48'	4.18'						
4.95'		526	415.25'	7.48'	5.01'						
5.12'		526	418.96'	7.36'	-1.44'						
1.11'		526	321.06'	6.85'	1.31'						
1.38'		526	417.02	6.84'	3.40'						
1.47'		526	6418.97	6.84'	4.42'						
0.12'		526	422.34'	6.83'	-3.23'						
0.56'		526	424.00'	6.49'	3.15'						
		_									
		Prepared L	by: EE	Date: 02/12/20	019						
		i e									

Truck No.:	uck No.:		l Do/Tol			orida 32708	UTILITY ENG	INEERING &	SURVEY	- GROW, INSPIRE, MAKE A DIFFERENCE-		Coordinate Unit of Meas	ure: US Survey Fee	
	U	Itility Type	e				y Material				ied By:	Abbreviations	Offset Measured From	
BE = Buried	Electrical	RW = Reclai	imed Water		AC = Transite		FIBG = Fiberg	glass		HUB = Survey Hub		N/A = Not Applicable	EP= Edge of Pav	ement
GM = Gas M	1ain	SL = Street I	Light		CI= Cast Iron		HDPE = High Density Polyethylene Pipe			IRC = Iron Rod & Cap "ECHO TEST HOLE"		NAD = North American	BC = Back of Curb	
BT = Buried	Telephone	TS = Traffic	Signal		CP = Concrete f	Pipe	PE = Polyethy	PE = Polyethylene Pipe			HO TEST HOLE"	Datum	BL = Baseline of	Survey
OC = Fiber	Optic Cable	FL = Fuel Lir	ne		DBC = Direct Bu	ıried Cable	PVC = Polyvir	PVC = Polyvinyl Chloride S				NAVD = North American	COORD = Surve	y Coordinat
VM = Wate	r Main	GS = Gas Se	rvice		CMP = Corruga	ted Metal Pipe	STL = Steel			X = "X" in Concrete		Vertical Datum	CL = Centerline	
SAN = Sanita	ary Sewer	WS = Water	r Service		CONC = Concre	te	VCP = Vitrifie	d Clay Pipe		Surfac	е Туре	UNK = Unknown	HUB = Survey H	ub
STM = Storn	n Sewer	UNK = Unkr	nown Utility		CPP = Corrugat	ed Plastic Pipe	PCCP = Prest	ressed Cylinde	r Concrete	ASPH = Asphalt		COT = City of Tampa	RW = Right of V	/ay
CATV = Cabl	le Television	BED = Burie	d Electrical C	Duct	DCT = Duct		Pipe			CONC = Concrete			ST = Swing Ties	
FM = Force I	Main	BTD = Burie	d Telephone	Duct	DIP = Ductile Ire	on Pipe	RCP = Reinfo	rced Concrete	Pipe	NG = Natural Groun	d		X = "X" in Concr	ete
Test Hole	Utility Type	Utility Material	Utility Size Outside Diameter	Utility Manual Depth	Cross Sectional View	***	Identified By	Surface Type	Surface Thickness inches	Apparent Utility Owner	Datums: Northing	Horizontal: NAD83/11 Vertical: NAVD88	Ground Elevation	Utility Elevati
			inches	feet		Utility Direction			IIICIICS		Northing	Easting		
1-1	вт	PVC	2 - 4"	3.26'	00	<u></u>	IRC	NG	N/A	FRONTIER	1301204.90'	526413.67	7.51'	4.25'
1-2	WM	CI	6"	3.30'		<u></u>	IRC	NG	N/A	сот	1301205.19	526416.74'	7.48'	4.18'
1-3	FOC/BT	PVC	4"	2.47'	\circ		IRC	NG	N/A	FRONTIER	1301204.95'	526415.25'	7.48'	5.01'
1-4	FOC	PE	12 - 1.5"	8.80'	08888c	<u></u>	IRC	NG	N/A	FRONTIER	1301205.12'	526418.96'	7.36'	-1.44
1-5	CATV	PVC	2 - 2"	5.54'	00	\$	IRC	NG	N/A	SPECTRUM	1301181.11'	526321.06'	6.85'	1.31
1-6	вт	PVC	2 - 4"	3.44'		‡	IRC	NG	N/A	FRONTIER	1301811.38'	526417.02'	6.84'	3.40'
1-7	FOC/BT	PVC	4"	2.42'			IRC	NG	N/A	FRONTIER	1301811.47	526418.97"	6.84'	4.42'
1-8	WM	UNK	UNK	10.06'		\$	IRC	NG	N/A	сот	1301810.12'	526422.34'	6.83'	-3.23
1-9	FOC/BT	PVC	4"	3.34'	0	‡	IRC	NG	N/A	FRONTIER	1301810.56'	526424.00'	6.49'	3.15
Notes:	1-8 - Unable	to visually ve	erify size and	matterial du	ue to depth and	groundwater. Possi	ble 6" cast iro	n.				Prengred by: EE	Date: 02/12/2	019
												Prepared by: EE	Date: 02/12/20	
												Checked by: AB	Date: 02/12/	2019
	REVISION	5								Q et a et es	OF FLORIDA			

Test Hole Data Report

ECHO UES, Inc. www.echoues.com

888.778.ECHO

SHEET

4/30/2021 11:22:27 AM Default

Tampa, Florida 33602
Engineer of Record: Branan R. Anderson, PE
P.E. No.: 78438

ROAD NO.

SR 45

COUNTY

HILLSBOROUGH

FINANCIAL PROJECT ID

440749-1-52-01

UTILITY ADJUSTMENTS (19)

Date:

dgrumbach

ECHO Project #:

Financial Project #:

12/04/2018

18-252

N/A

16514 N. Dale Mabry Hwy.

Tampa, Florida 33618

1511 E. SR434, Ste. 2001, #252

Date:		12	2/05/2018				Test Hol	e Data Repo	art.			Crew Members:		DW, TG
ECHO Pro	iect #:		18-252	16	5514 N. Dale Ma	ibry Hwy.			_	ECHO U	ES, Inc.	City, State:	Т	ampa, Florida
			N/A		Tampa, Florida	33618	 	CH		www.echo	-	General Location:		US 41
Financial F	•			1511	l E. SR434, Ste.					888.778				
Truck No.:			D-3/T-2	Win	ter Springs, Flo	1108 32700	JTILITY ENG	INEERING &	SURVEY	- GROW, INSPIRE, MA		Coordinate Unit of Meas		S Survey Feet
		Itility Type				Utilit	y Material			Identifi	ed By:	Abbreviations		sured From:
BE = Buried		RW = Reclai			AC = Transite		FIBG = Fiberg			HUB = Survey Hub		N/A = Not Applicable	EP= Edge of Pavement	
GM = Gas M		SL = Street I	_		CI= Cast Iron				hylene Pipe	IRC = Iron Rod & Cap			BC = Back of Cu	
BT = Buried		TS = Traffic			CP = Concrete P		PE = Polyethy			NL = Nail & Disk "ECH	IO TEST HOLE"	Datum	BL = Baseline of	
FOC = Fiber		FL = Fuel Lir GS = Gas Se			DBC = Direct Bu		PVC = Polyvin	iyi Chloride		SLEEVE = Sleeve X = "X" in Concrete		NAVD = North American Vertical Datum	COORD = Surve CL = Centerline	y Coordinates
WM = Wate SAN = Sanita		WS = Water			CMP = Corrugat CONC = Concret		STL = Steel VCP = Vitrifie	d Clay Dina		Surface	Tuno	UNK = Unknown	HUB = Survey H	ub
SAN = Sanita STM = Storn		UNK = Unkr			CPP = Corrugate		t		r Constato	ASPH = Asphalt	: туре	COT = City of Tampa	RW = Right of W	
CATV = Cabl			d Electrical D	ouct	DCT = Duct	ed Flastic Fipe	Pipe Presti	ressed Cylinde	r concrete	CONC = Concrete		cor – city or rampa	ST = Swing Ties	, uy
FM = Force I			d Telephone		DIP = Ductile Iro	on Pipe		rced Concrete	Pipe	NG = Natural Ground			X = "X" in Concr	ete
			Utility Size	Utility		Ņ			Surface			Horizontal: NAD83/11		
Test Hole	Utility Type	Utility	Outside	Manual	Cross	+	Identified By	Surface Type	Thickness	Apparent Utility	Datums:	Vertical: NAVD88		Utility
100011010	ounty type	Material	Diameter	Depth	Sectional View	¥↓¾ Utility Direction	raciiciica by	ouridee Type	inches	Owner	Northing	Easting	Elevation	Elevation
1-10	FOC	PE	inches 12 - 1.5"	feet 3.96'	000 0000 0000	A A	IRC	NG	N/A	FRONTIER	1302430.03	526421.52'	6.62'	2.66'
1-11	ВТ	PVC	2 - 4"	2.50'	000000	*	IRC	NG	N/A	FRONTIER	1302430.50	526424.77'	6.68'	4.18'
1-12	FOC/BT	PVC	4"	1.90'		<u> </u>	IRC	NG	N/A	FRONTIER	1302430.47'	526425.15'	6.69'	4.79'
						<u> </u>								
1-13	ВТ	DBC	2"	1.56'	0	\	IRC	NG	N/A	FRONTIER	1302430.15'	526428.11'	6.81'	5.25'
1-14	WM	DIP	6"	3.40"		<u> </u>	IRC	NG	N/A	СОТ	1302428.62	526446.38'	8.20'	4.80'
1-15	GM	STL	4"	3.00'		Ţ	IRC	NG	N/A	сот	1302488.18'	526318.06'	6.08'	3.08'
1-16	ВТ	PVC	4"	3.50'			IRC	NG	N/A	FRONTIER	1301205.22'	526417.96'	7.50'	4.00'
1-17	ВТ	DBC	2"	3.00'	0		IRC	NG	N/A	FRONTIER	1301810.09'	526422.72'	6.80'	3.80'
Notes:														
												Prepared by: EE	Date: 02/12/20	019
												Checked by: AB	Date: 02/12/	2019

REVISIONS STATE OF FLORIDA Kisinger Campo & Associates Corp. 201 N. Franklin Street, Suite 400 DESCRIPTION DATE DESCRIPTION DATE DEPARTMENT OF TRANSPORTATION Tampa, Florida 33602
Engineer of Record: Branan R. Anderson, PE
P.E. No.: 78438 ROAD NO. COUNTY SR 45 HILLSBOROUGH 440749-1-52-01

FINANCIAL PROJECT ID

UTILITY ADJUSTMENTS (20)

SHEET NO.

c:\pwworkingdir\kca-pw.bentley.com_kca-pw-01\dean grumbach\dms07001\UTADRD00.dgn

Date:		12	2/06/2018				Test Hol	e Data Repo	ort			Crew Members:		DW, TG, MAJ
ECHO Proj	ject #:		18-252	16	5514 N. Dale Ma	abry Hwy.				ECHO U	IES, Inc.	City, State:	Т	ampa, Florida
Financial F	•		N/A		Tampa, Florida	33618	≫⊩	ECH		www.ech		General Location:	US 41	
Truck No.:			D-3/T-2		L E. SR434, Ste.					888.778 - GROW, INSPIRE, M		Coordinate Unit of Measure:		S Survey Feet
TTUCK NO		IATIDA - Trans	,	Win	ter Springs, Flo	nida SE700		INEERING &	SURVET					· ·
DE D 41.41		Itility Type			A.C. Turning	Utilit	y Material	l		Identif	iea By:	Abbreviations		sured From:
BE = Buried I		RW = Reclai			AC = Transite		FIBG = Fiberg		hulana Bina	HUB = Survey Hub	PECHO TEST HOLE!	N/A = Not Applicable NAD = North American	EP= Edge of Pay	
GM = Gas M BT = Buried		SL = Street TS = Traffic	ŭ		CI= Cast Iron CP = Concrete P	lino	PE = Polyethy		nylene Pipe	IRC = Iron Rod & Cap NL = Nail & Disk "ECI		Datum	BC = Back of Cu BL = Baseline of	
FOC = Fiber		FL = Fuel Lir			DBC = Direct Bu		PVC = Polyetny			SLEEVE = Sleeve	HO TEST HOLE	NAVD = North American	COORD = Surve	,
WM = Water		GS = Gas Se			CMP = Corrugat		STL = Steel	iyi cilionde		X = "X" in Concrete		Vertical Datum	CL = Centerline	
SAN = Sanita		WS = Water			CONC = Concre		VCP = Vitrifie	d Clay Bina		Surfac	o Typo	UNK = Unknown	HUB = Survey H	
STM = Storm	•	UNK = Unkr			CPP = Corrugate		1		v Consusta	ASPH = Asphalt	етуре	COT = City of Tampa	RW = Right of V	
CATV = Cable			d Electrical D	huct	DCT = Duct	eu riasuc ripe	Pipe Prest	ressed Cylinde	r Concrete	CONC = Concrete		COT - City of Tampa	ST = Swing Ties	
FM = Force N			d Telephone		DIP = Ductile Iro	n Pine		rced Concrete	Pine	NG = Natural Ground	4		X = "X" in Conci	
rivi – roice	viaiii	BTB - Burie	Utility Size	Utility	DIF - Ductile II C	N N	KCF - Kellilo	rcea concrete		NG - Natural Ground		Horizontal: NAD83/11	X = X III conci	
Took Upla	I IAIlian Tono	Utility	Outside	Manual	Cross	*	uda asida ad no.	Conferentian	Surface	Apparent Utility	Datums:	Vertical: NAVD88	Ground	Utility
lest Hole	Utility Type	Material	Diameter	Depth	Sectional View	▼	identified by	Surface Type	Thickness inches	Owner	Northina		Elevation	Elevation
			inches	feet		Utility Direction			inches		Northing	Easting		
1-18	вт	PVC	2 - 4"	3.82'	00		IRC	NG	N/A	FRONTIER	1303091.15'	526425.13'	7.04'	3.22'
1-19	FOC/BT	PVC	4"	2.54'			IRC	NG	N/A	FRONTIER	1303091.17	526425.73"	6.99'	4.45'
1-20	вт	LEAD	2 - 2"	3.00'	00	\^	IRC	NG	N/A	FRONTIER	1303091.09'	526427.92'	6.86'	3.86'
1-21	FOC	UNK	12 - 1.5"	9.22'	888888	‡	IRC	NG	N/A	FRONTIER	1303091.01	526430.76'	6.58'	-2.64'
1-22	вт	LEAD	2 - 2"	2.00'	00		IRC	NG	N/A	FRONTIER	1303695.15'	526432.46'	6.77'	4.77'
1-23	вт	PVC	2 - 4"	2.76'	00		IRC	NG	N/A	FRONTIER	1303695.20'	526433.46'	6.70'	3.94'
1-24	ВТ	LEAD	2 - 2"	2.74'	00	‡	IRC	NG	N/A	FRONTIER	1304500.45	526435.53'	7.28'	4.54'
Notes:	1-21 - Unable	e to visually v	erify size and	d material du	ue to depth and g	groundwater. Possil	bly 12 - 1.5" p	olyethylene pi	pes.					
												Prepared by: EE	Date: 02/12/2	019
												Checked by: AB	Date: 02/12/	2019

REVISIONS DESCRIPTION DESCRIPTION DATE

Kisinger Campo & Associates Corp. 201 N. Franklin Street, Suite 400 Tampa, Florida 33602 Engineer of Record: Branan R. Anderson, PE P.E. No.: 78438


STATE OF FLORIDA DEPARTMENT OF TRANSPORTATION ROAD NO. COUNTY FINANCIAL PROJECT ID SR 45 HILLSBOROUGH 440749-1-52-01


UTILITY ADJUSTMENTS (21)

SHEET NO.

STATE OF FLORIDA DEPARTMENT OF TRANSPORTATION

CONTRACT PLANS

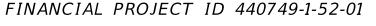

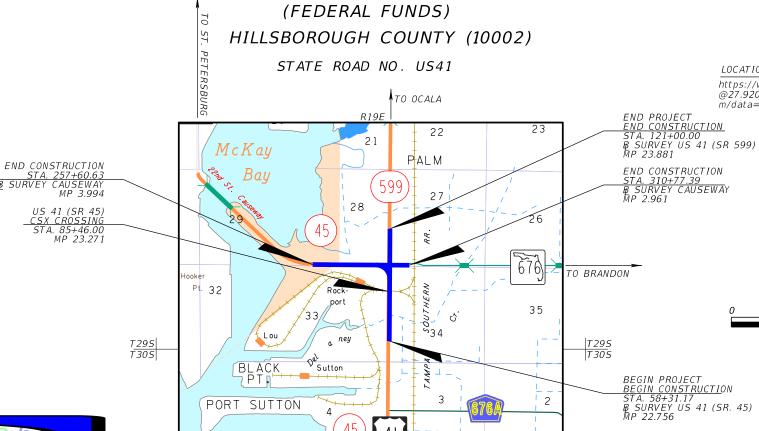

□ Group Green-lines 6

GOVERNING STANDARD PLANS:

Florida Department of Transportation, FY2021-22 Standard Plans for Road and Bridge Construction and applicable Interim Revisions (IRs).


Standard Plans for Road Construction and associated IRs are available at the following website: http://www.fdot.gov/design/standardplans

APPLICABLE IRs: N/A

Standard Plans for Bridge Construction are included in the Structures Plans Component

GOVERNING STANDARD SPECIFICATIONS:

Florida Department of Transportation, July 2022 Standard Specifications for Road and Bridge Construction at the following website: http://www.fdot.gov/programmanagement/Implemented/SpecBooks

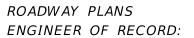

NAPLE

BRANAN R. ANDERSON, P.E. NO.: 78438 KISINGER CAMPO AND ASSOCIATES CORP. CONSULTING ENGINEERS & PLANNERS 201 N. FRANKLIN STREET, SUITE 400 TAMPA, FLORIDA 33602 (813) 871-5331 VENDOR NUMBER.: F59-1677145

FDOT PROJECT MANAGER:

TIM O'BRIEN P.E.

LOCATION OF PROJECT

Mile

m/data=!3m1!1e3

https://www.google.com/maps/ @27.9206868,-82.3995664,1364





TO BRADENTON


CONSTRUCTION	FISCAL	SHEET
CONTRACT NO.	YEAR	NO.
TBD	21	1


AYTONA BEACH


dgrumbach 4/13/2021 2:47:16 PM Default c:\pwworkingdir\kc

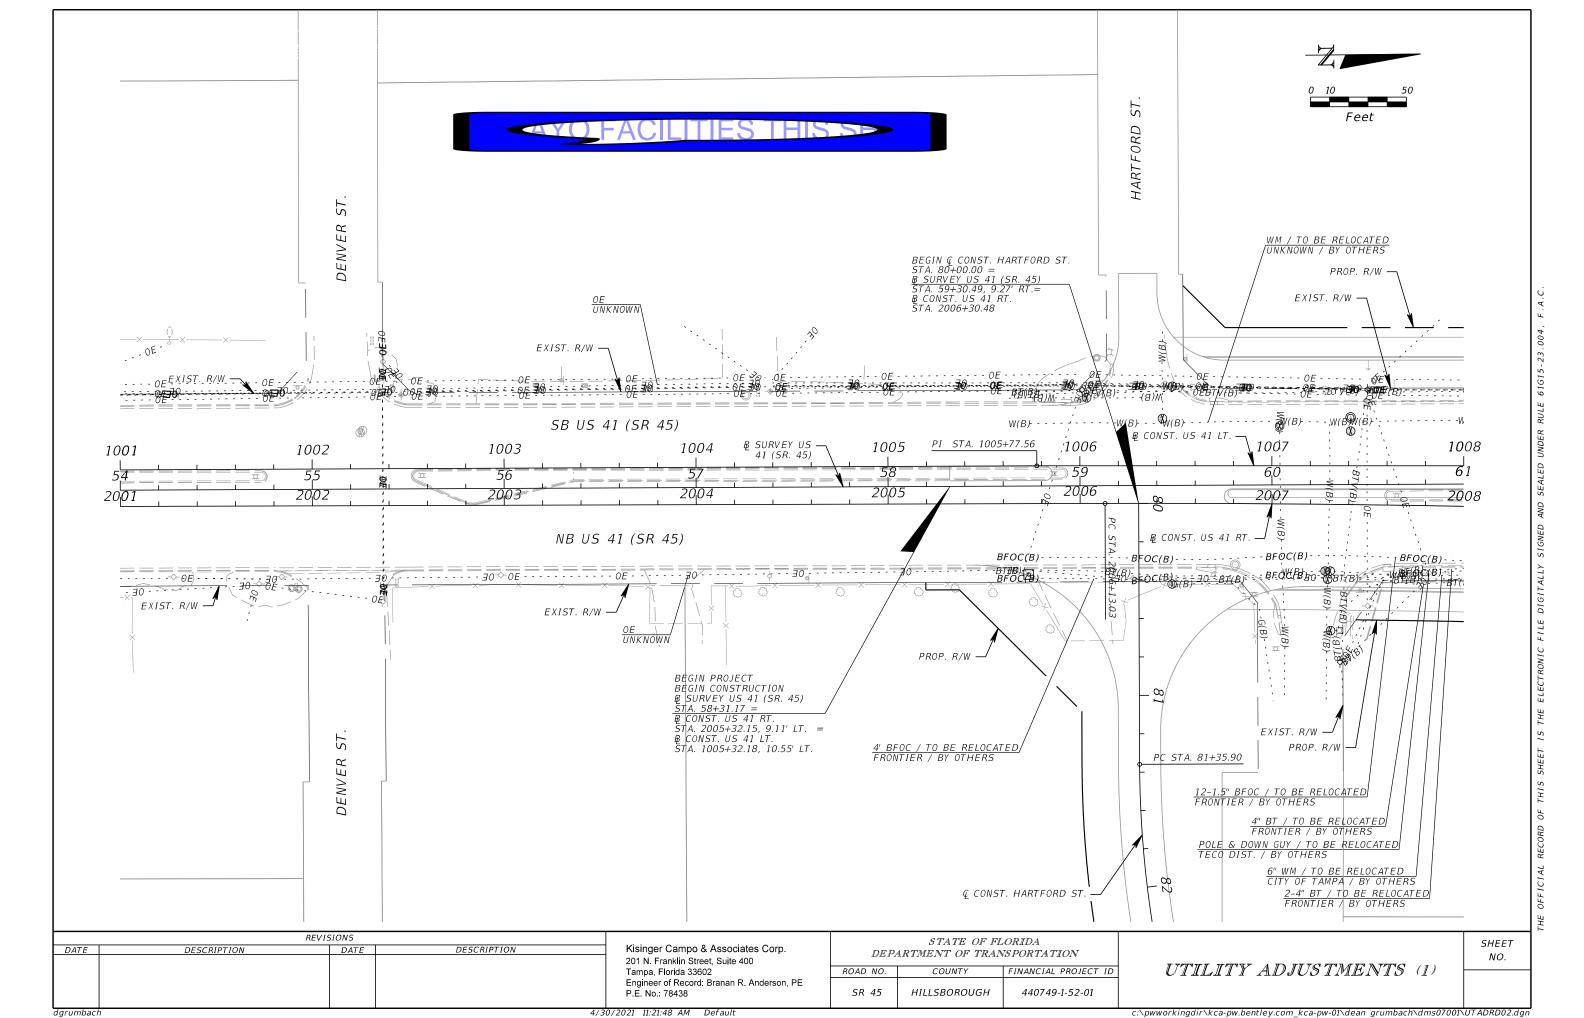


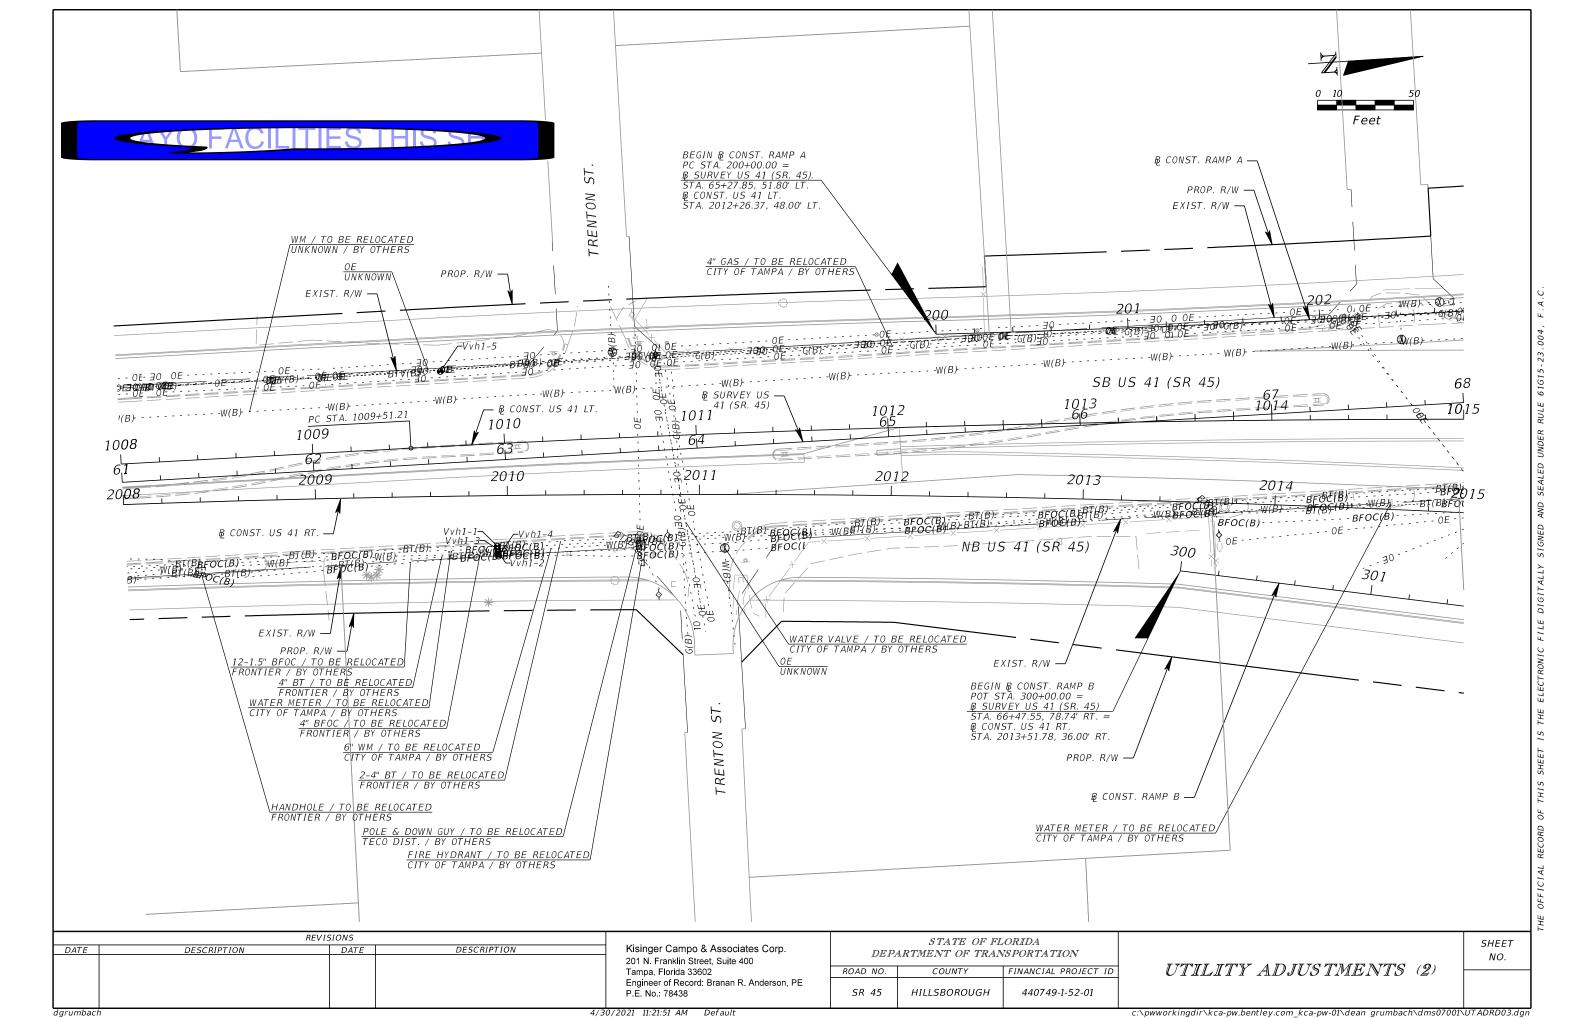


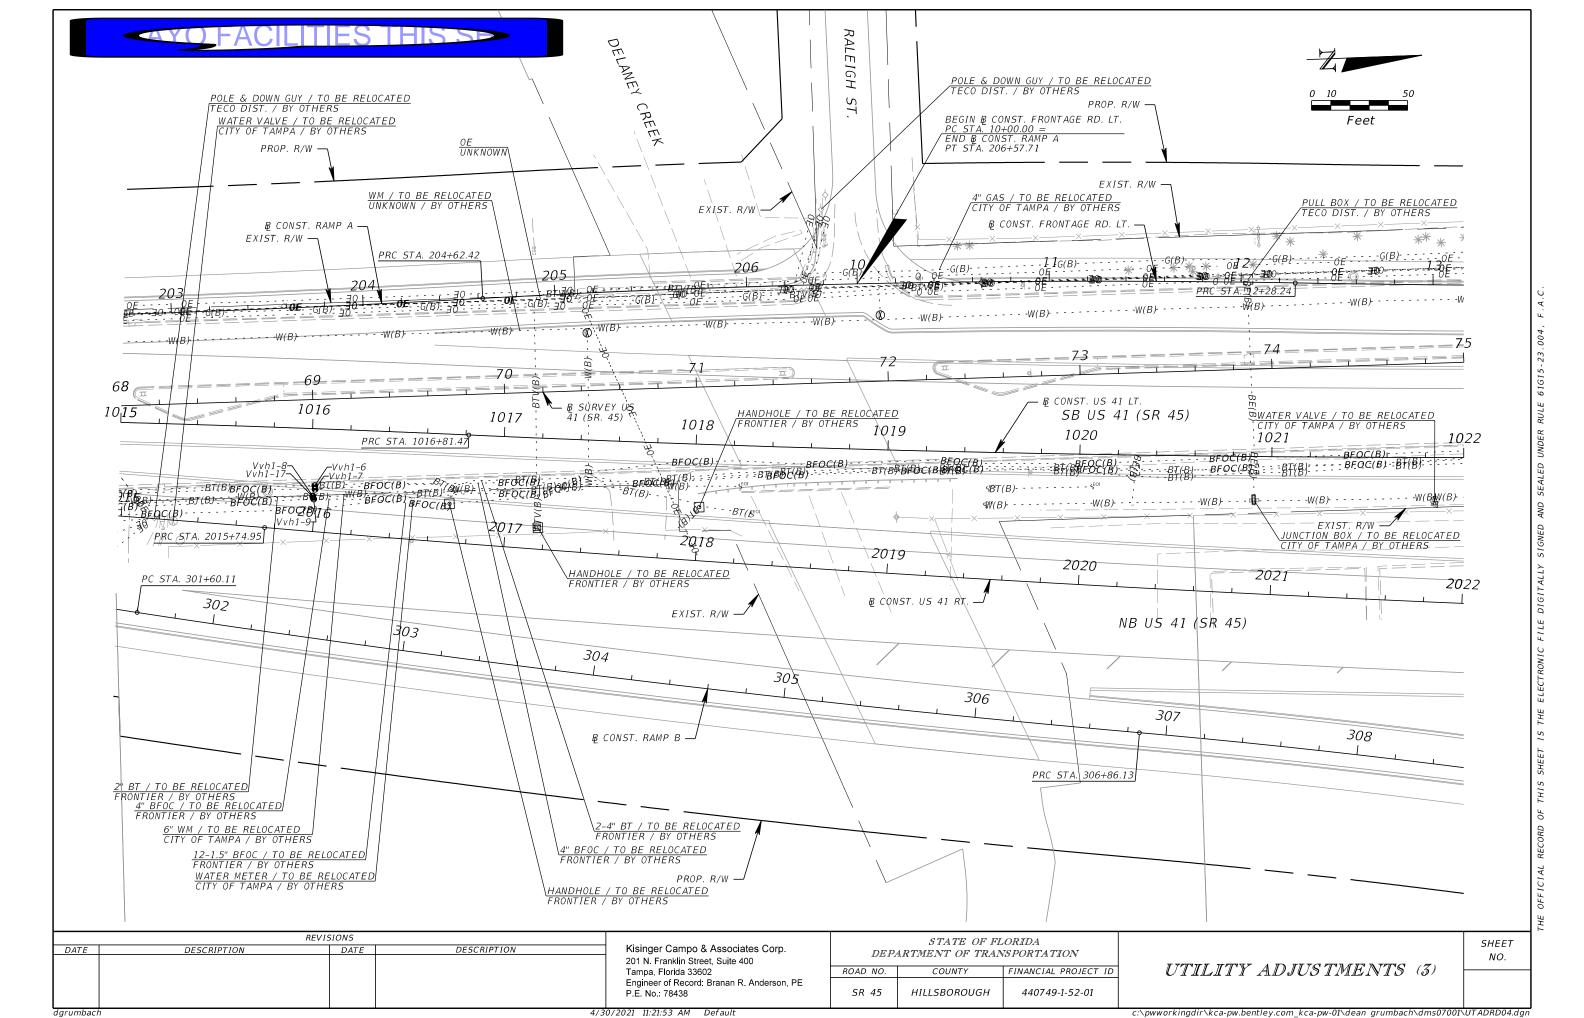


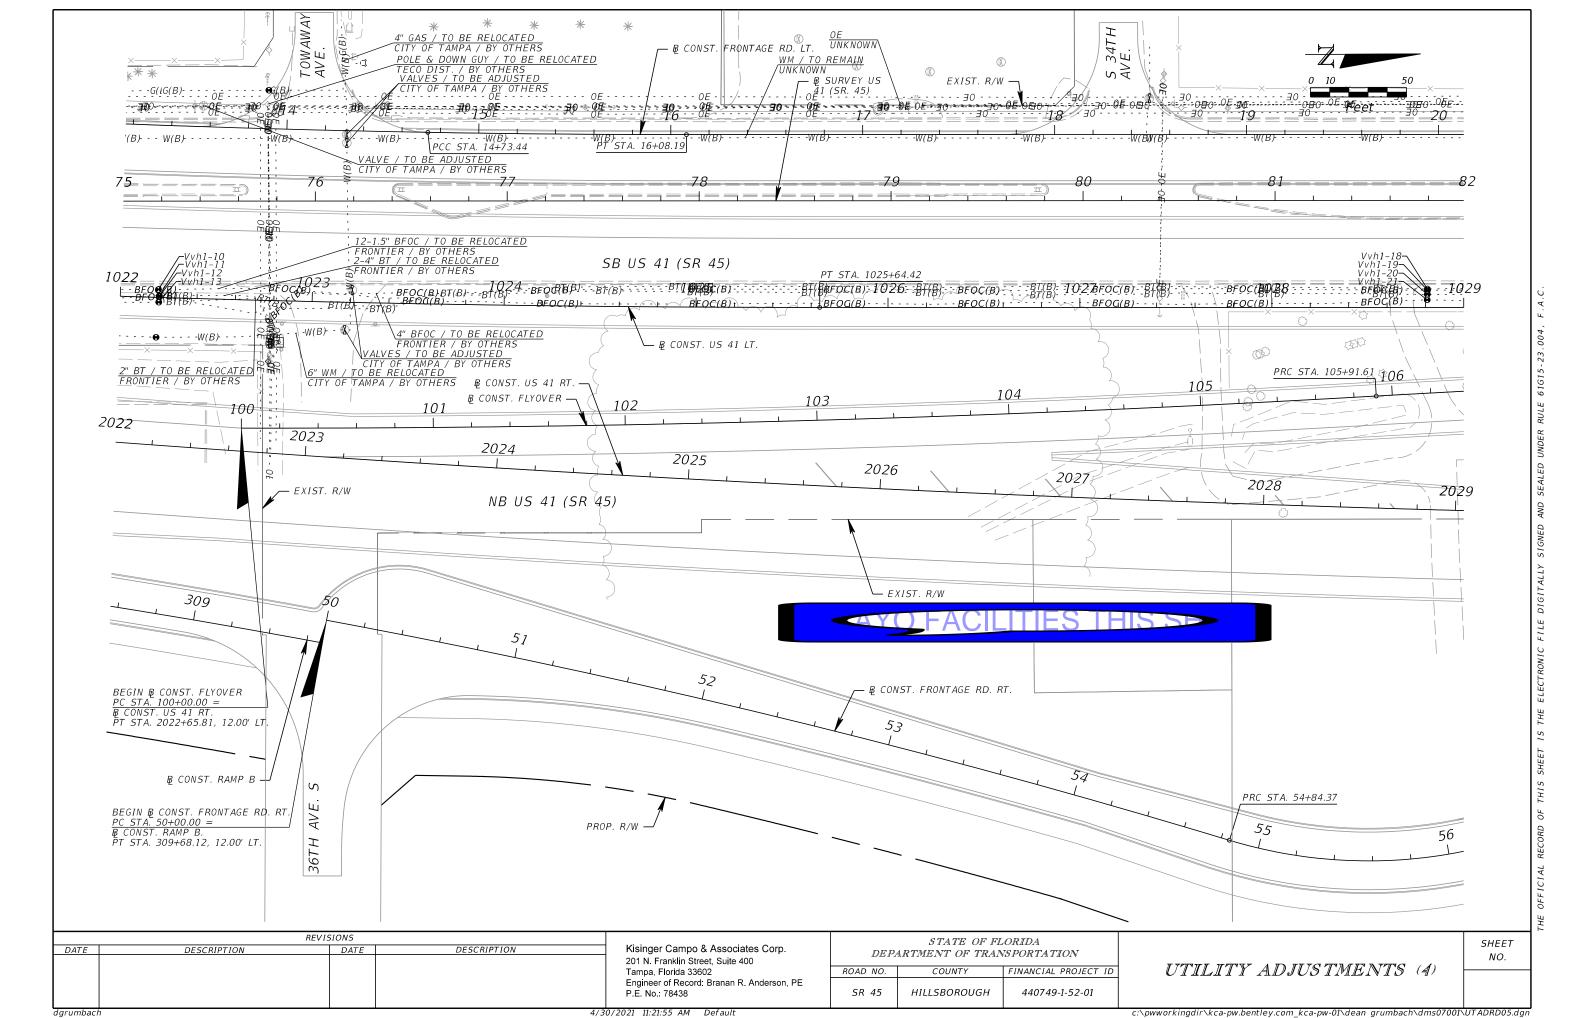


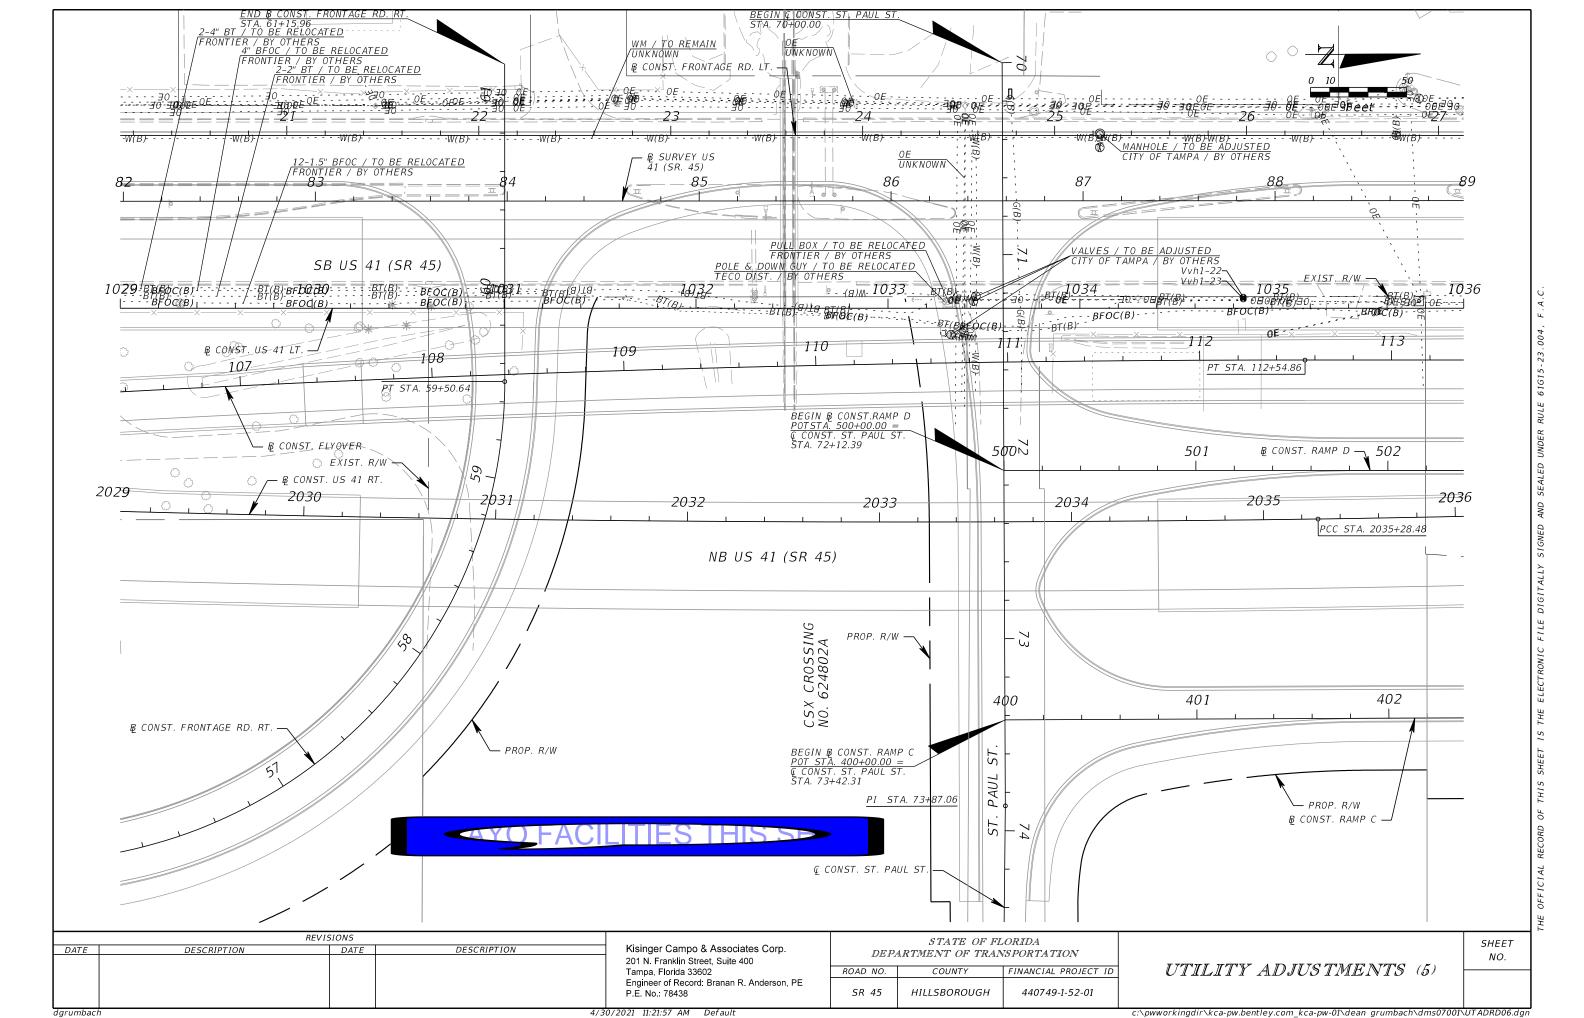


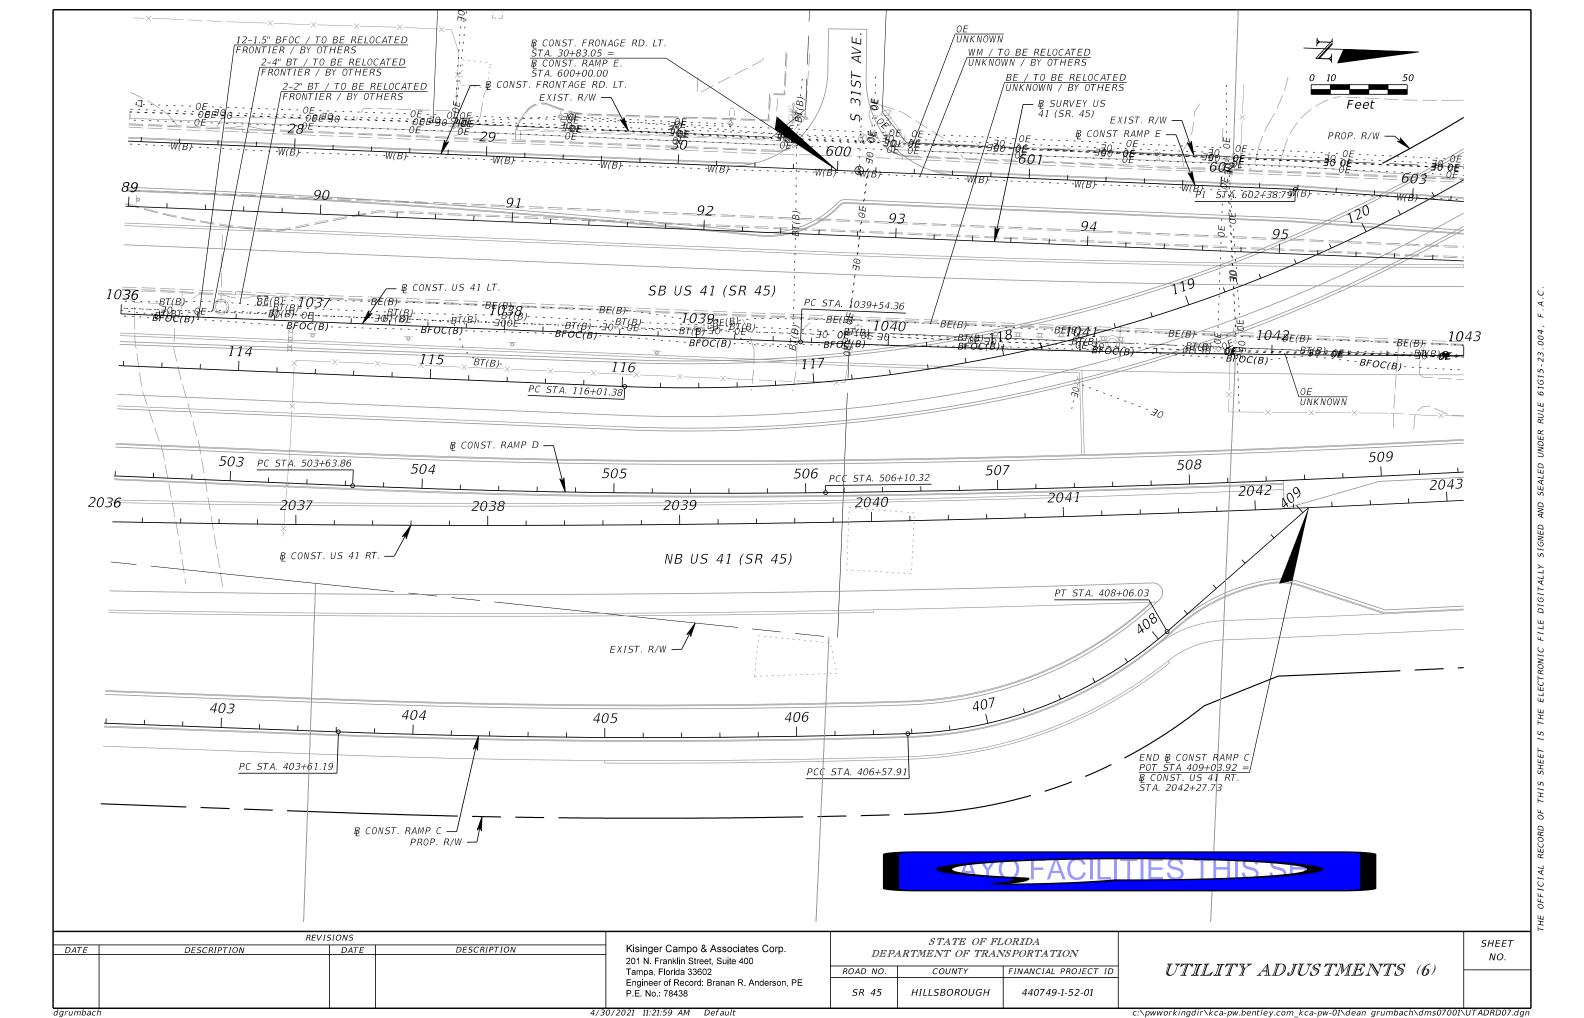

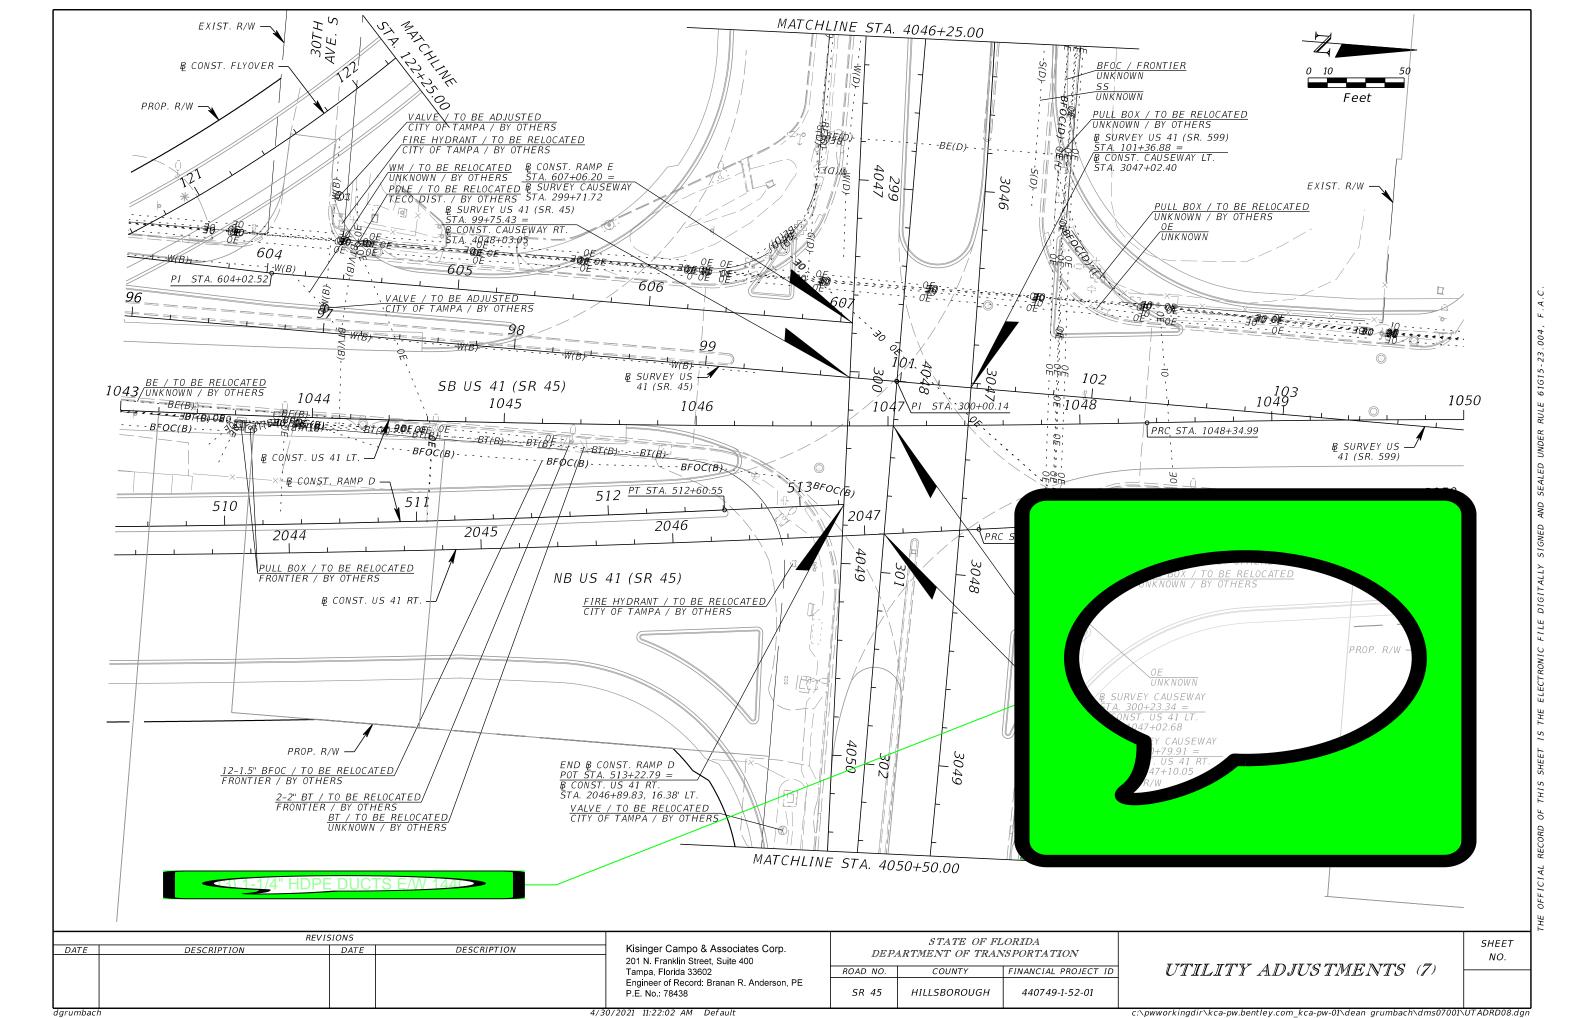

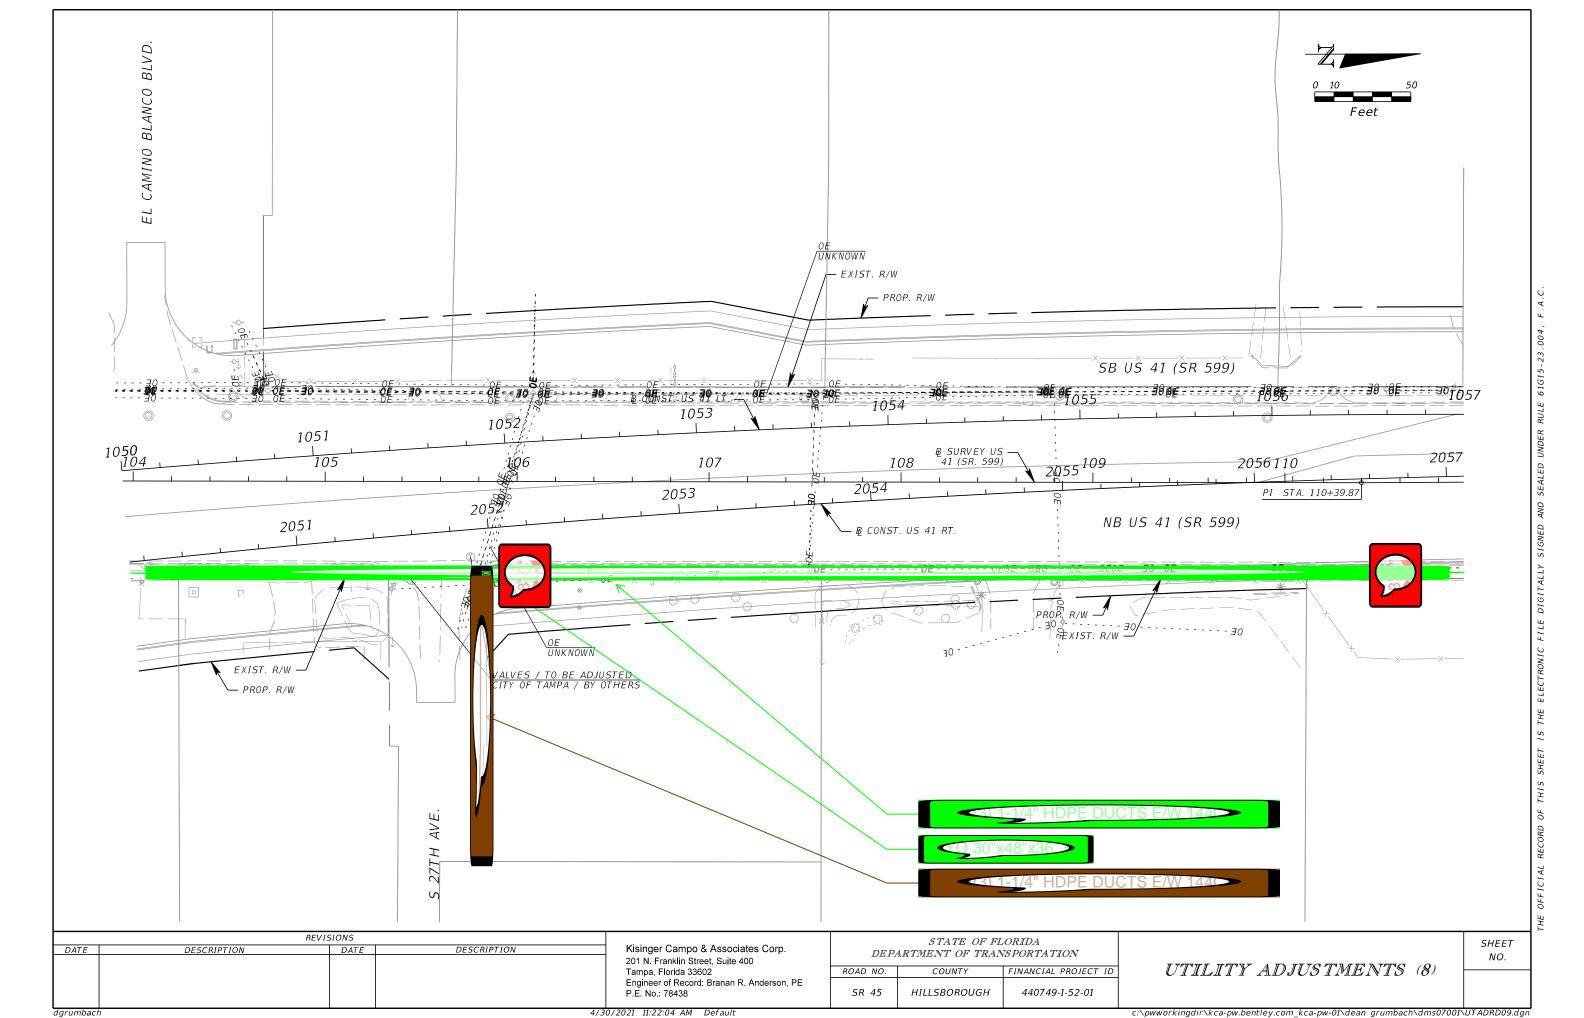


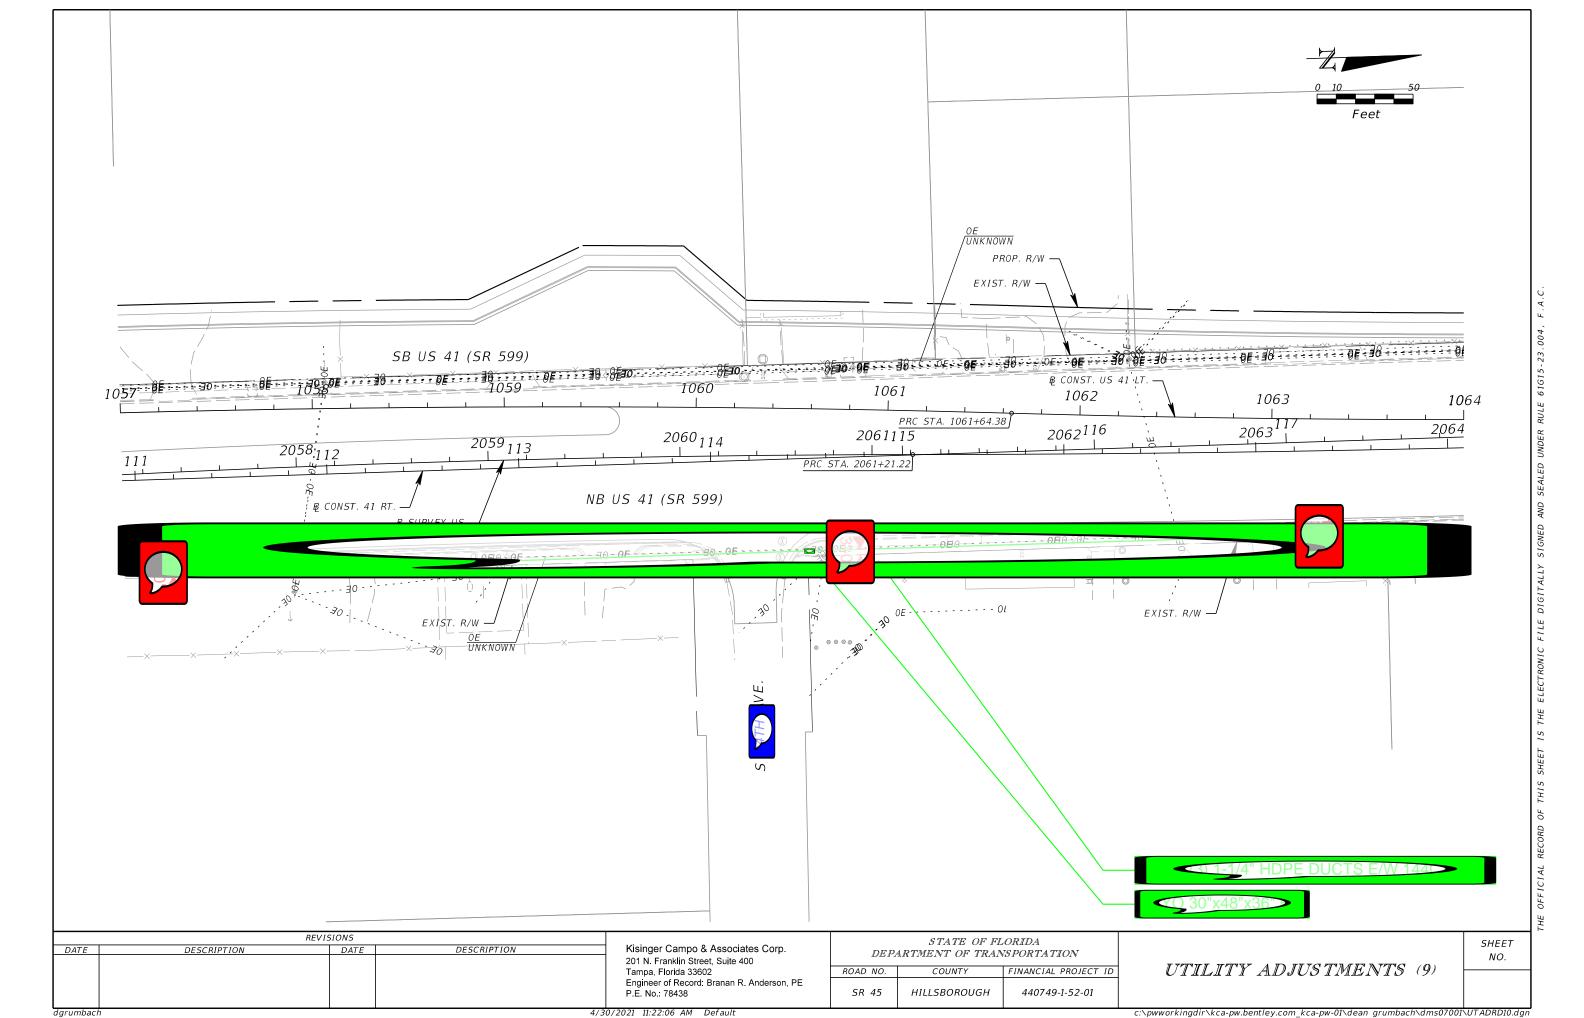


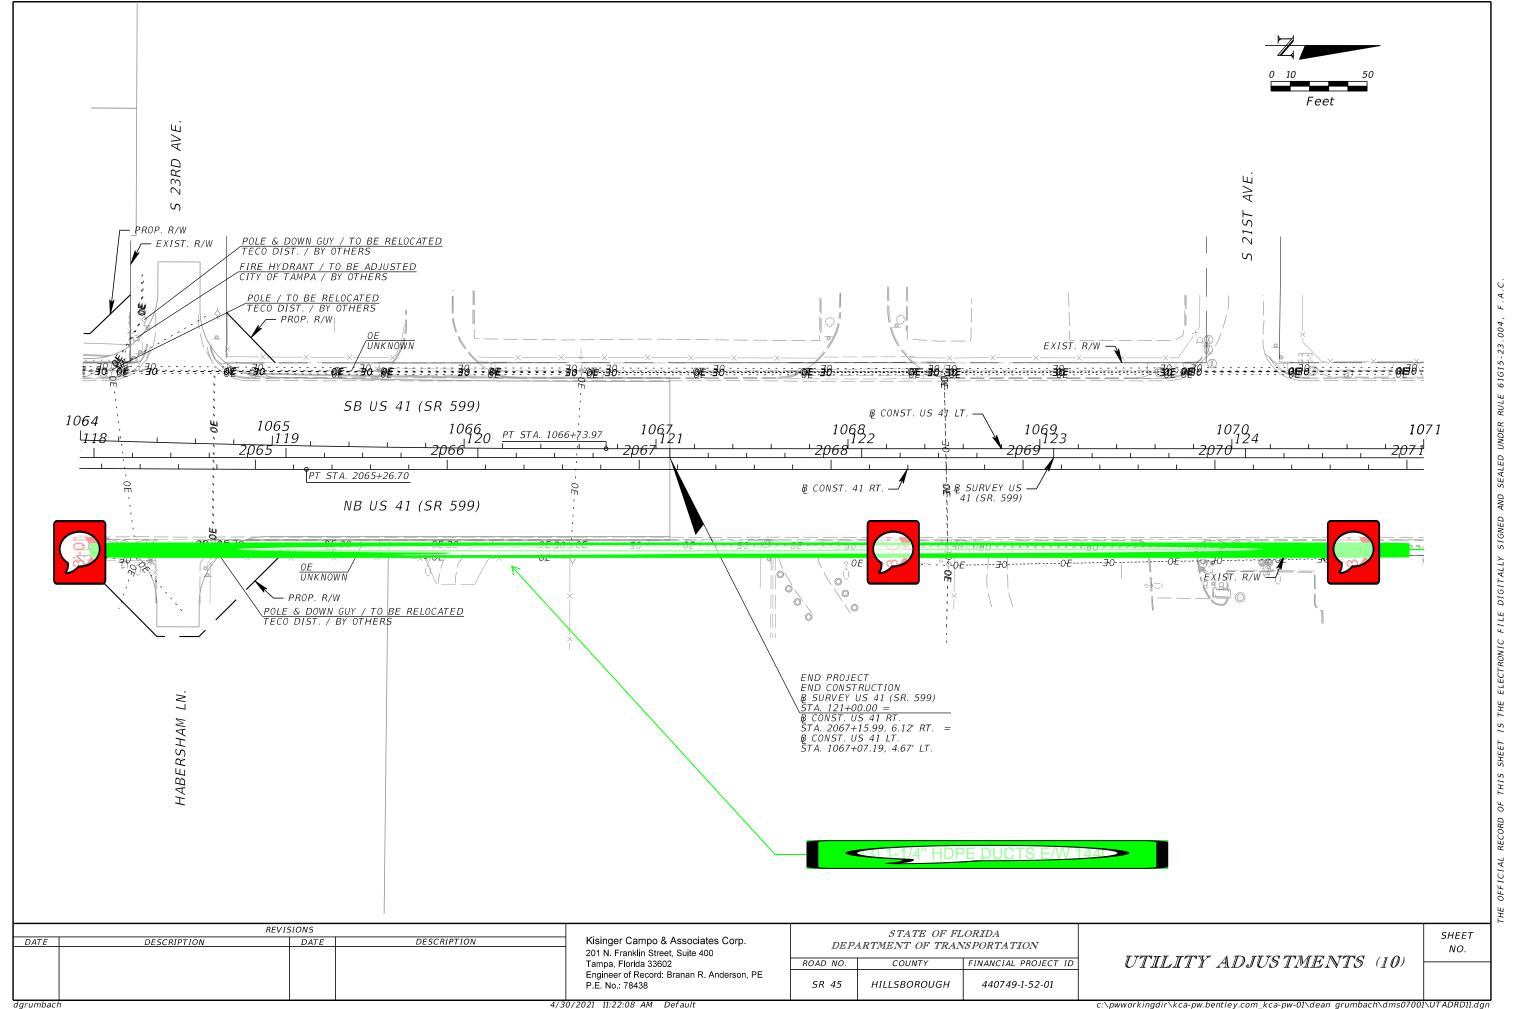

dgrumbach

AYO FACILITIES THIS SE

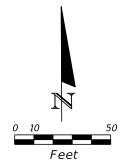

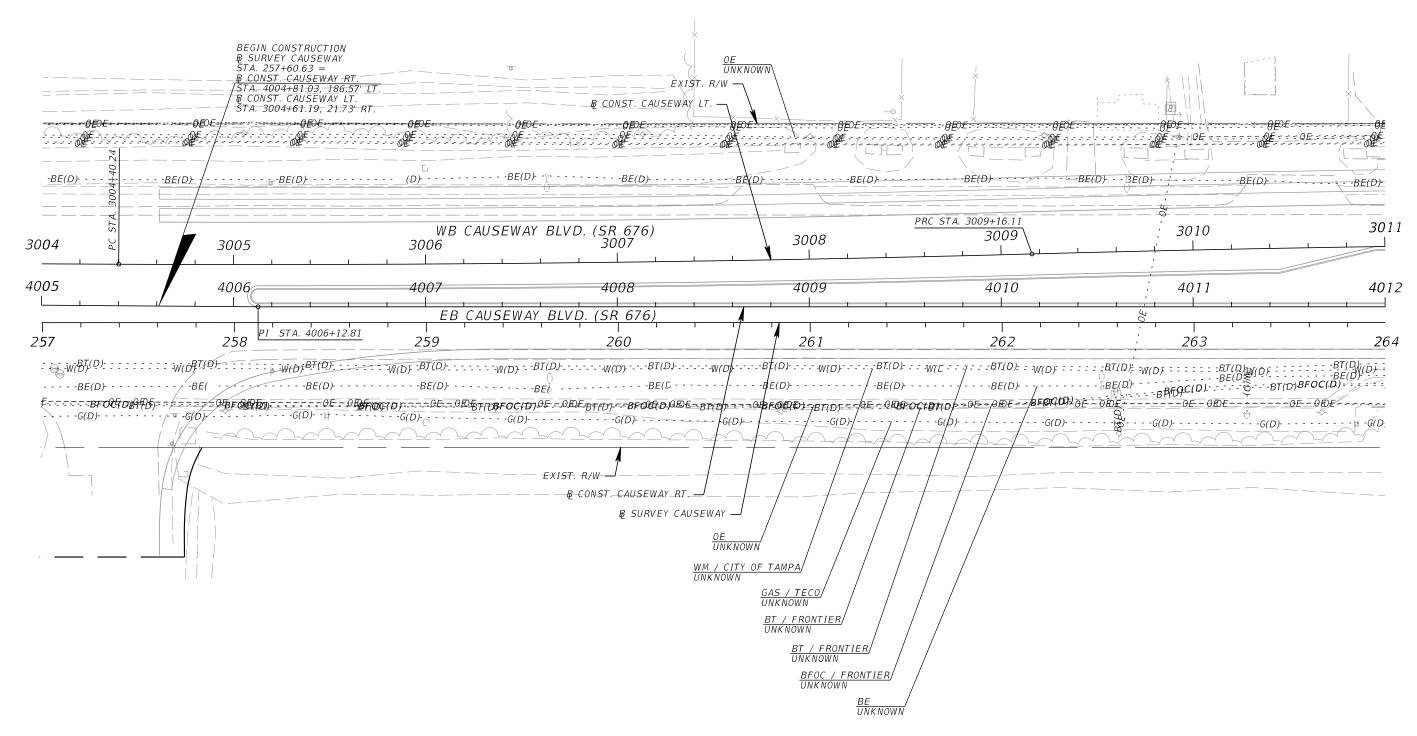

REVISIONS

DATE DESCRIPTION DATE DESCRIPTION


Kisinger Campo & Associates Corp. 201 N. Franklin Street, Suite 400 Tampa, Florida 33602 Engineer of Record: Branan R. Anderson, PE P.E. No.: 78438 STATE OF FLORIDA
DEPARTMENT OF TRANSPORTATION


ROAD NO. COUNTY FINANCIAL PROJECT ID


SR 45 HILLSBOROUGH 440749-1-52-01


UTILITY ADJUSTMENTS (11)


SHEET NO.

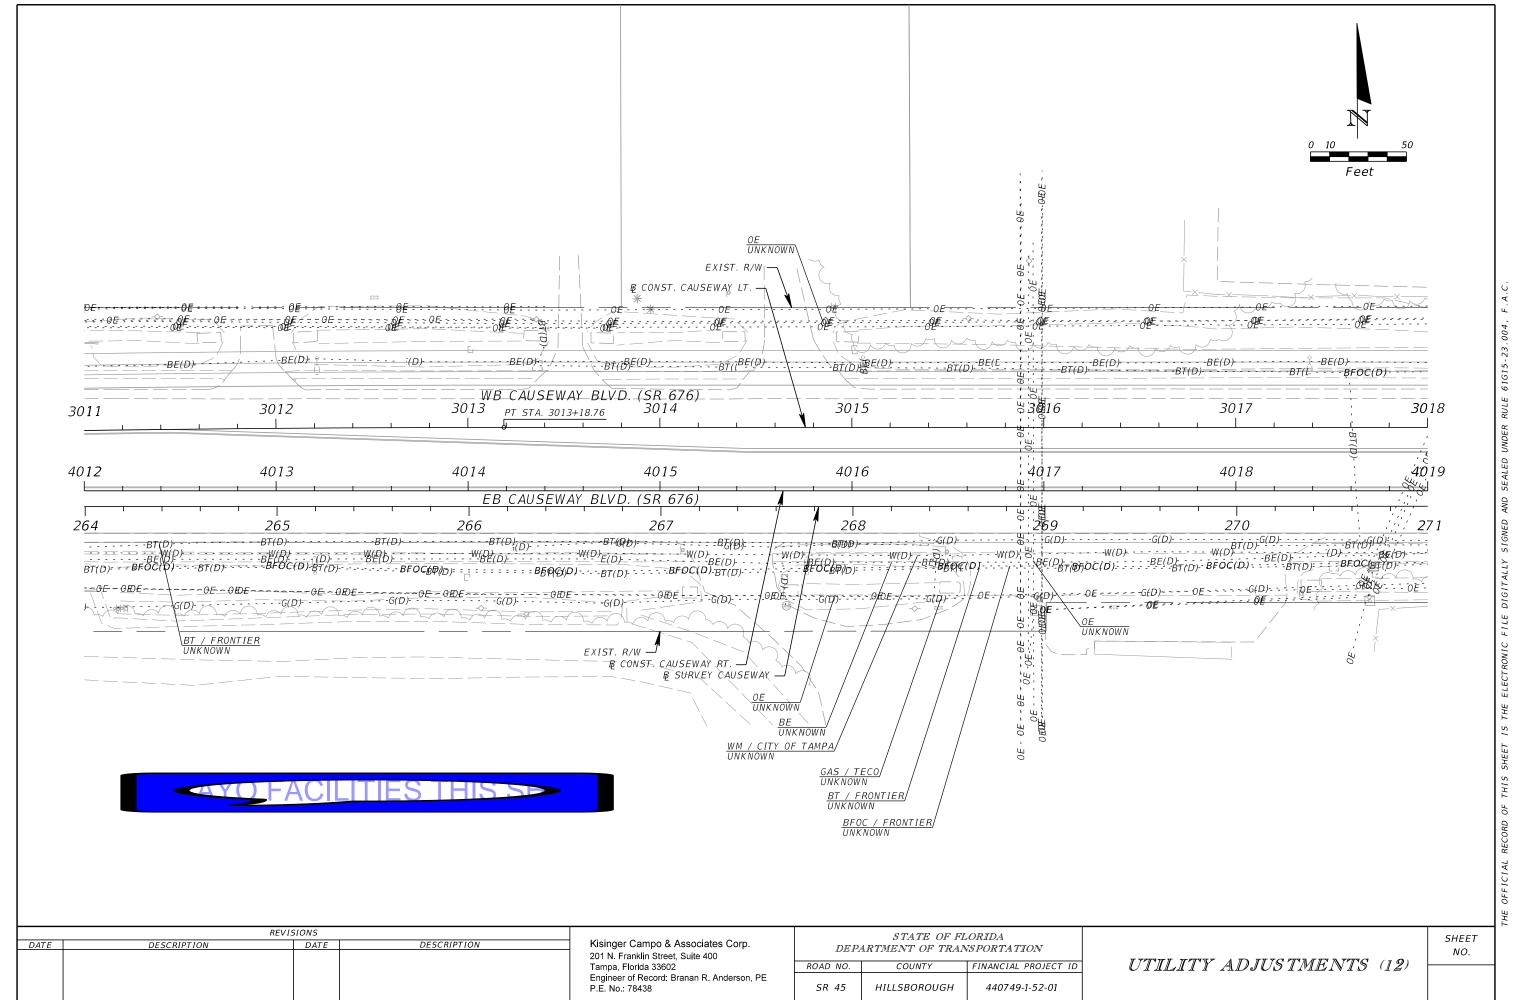


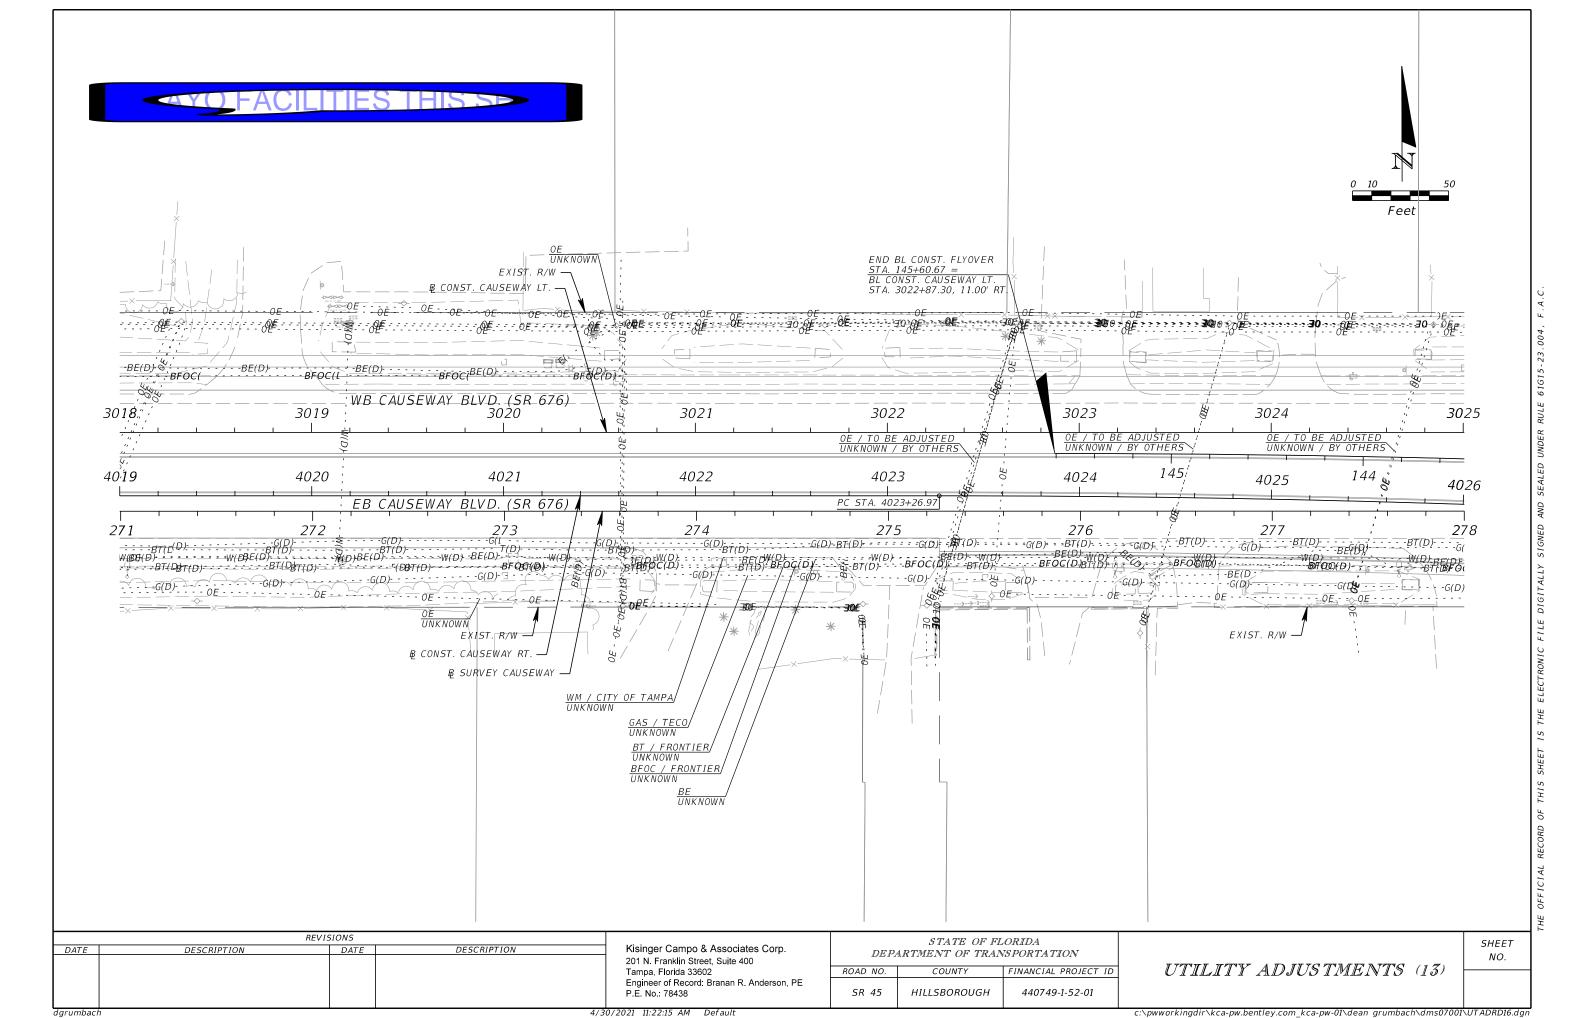


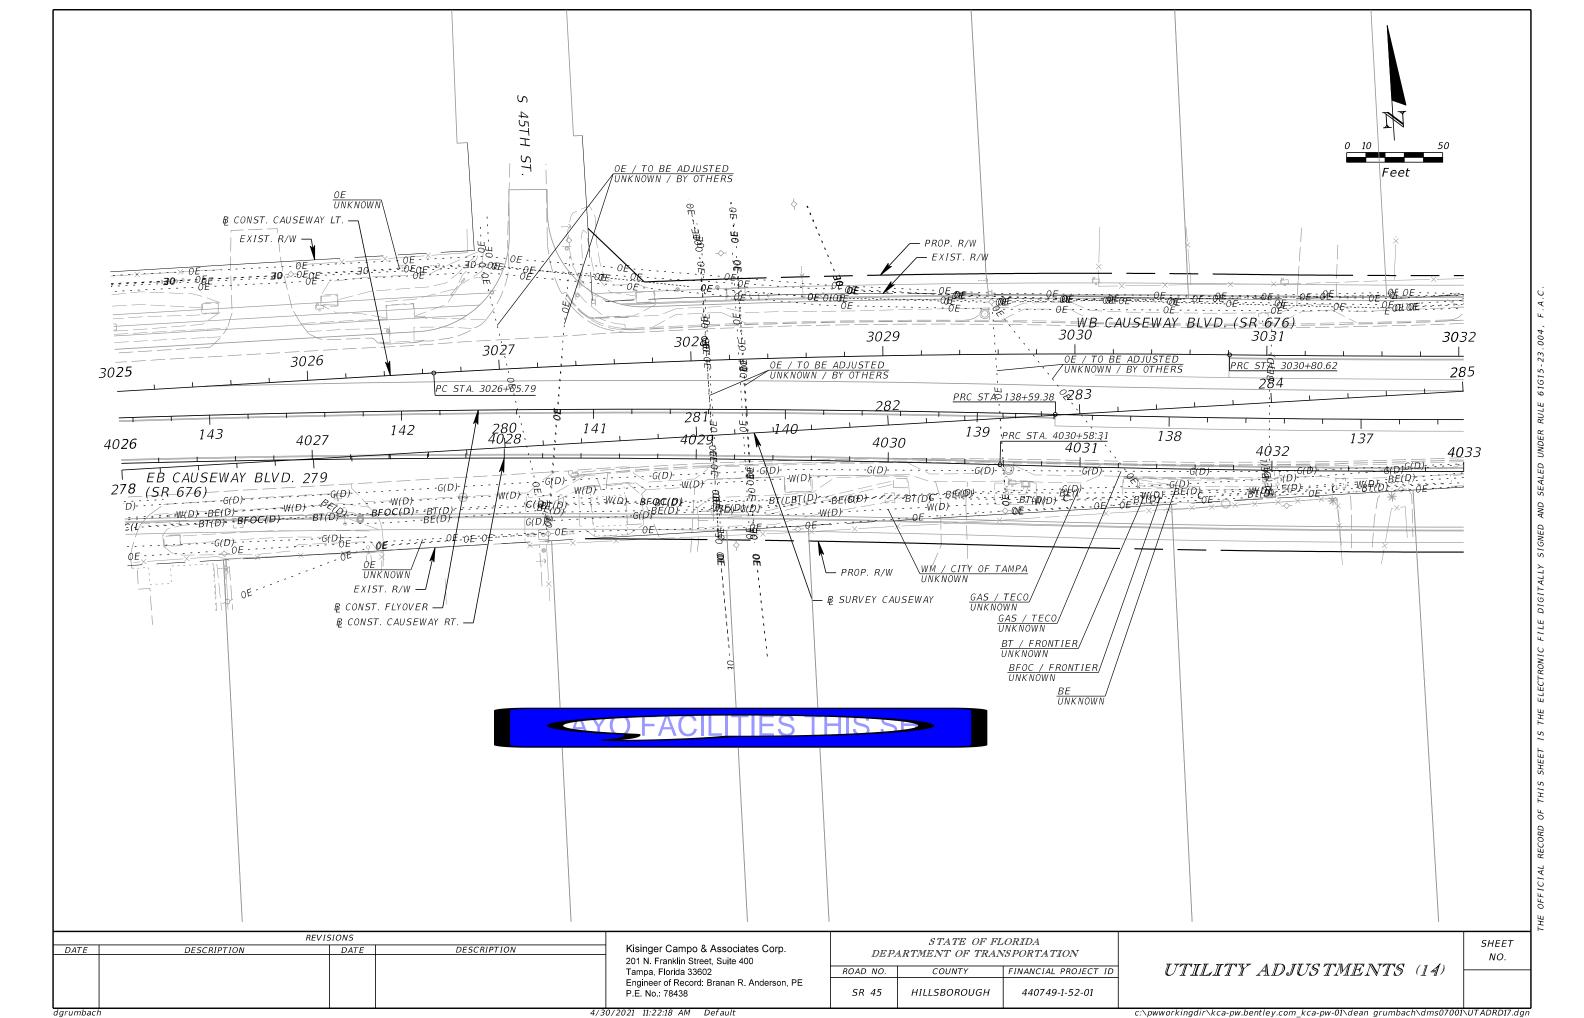

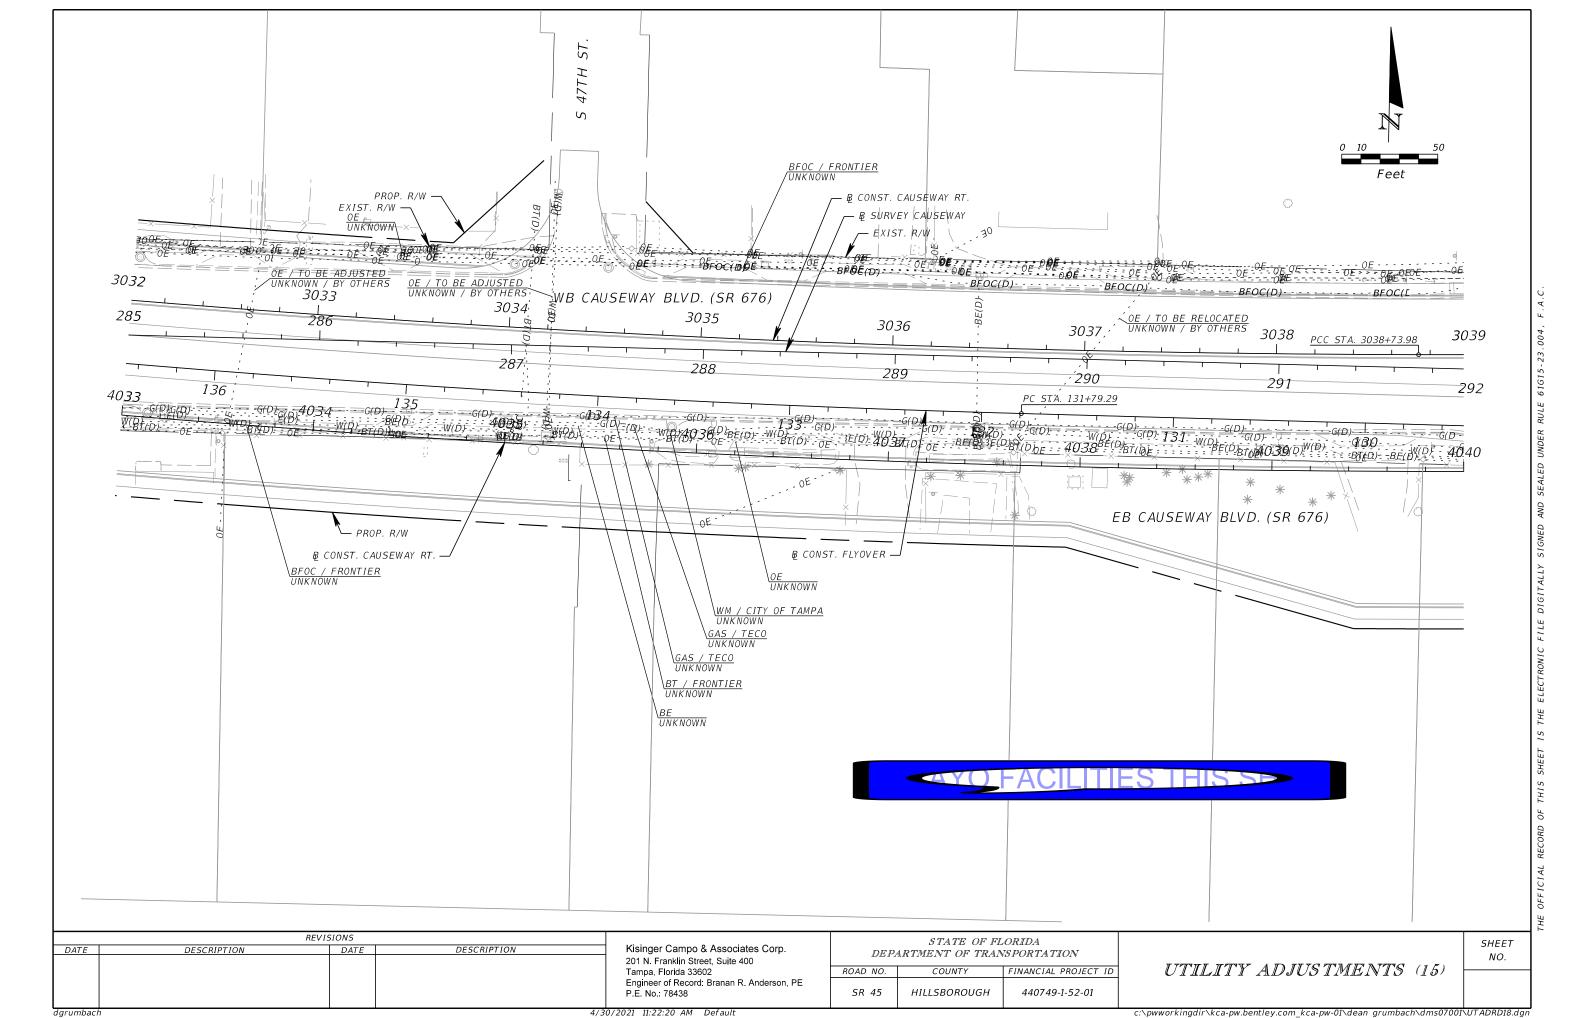

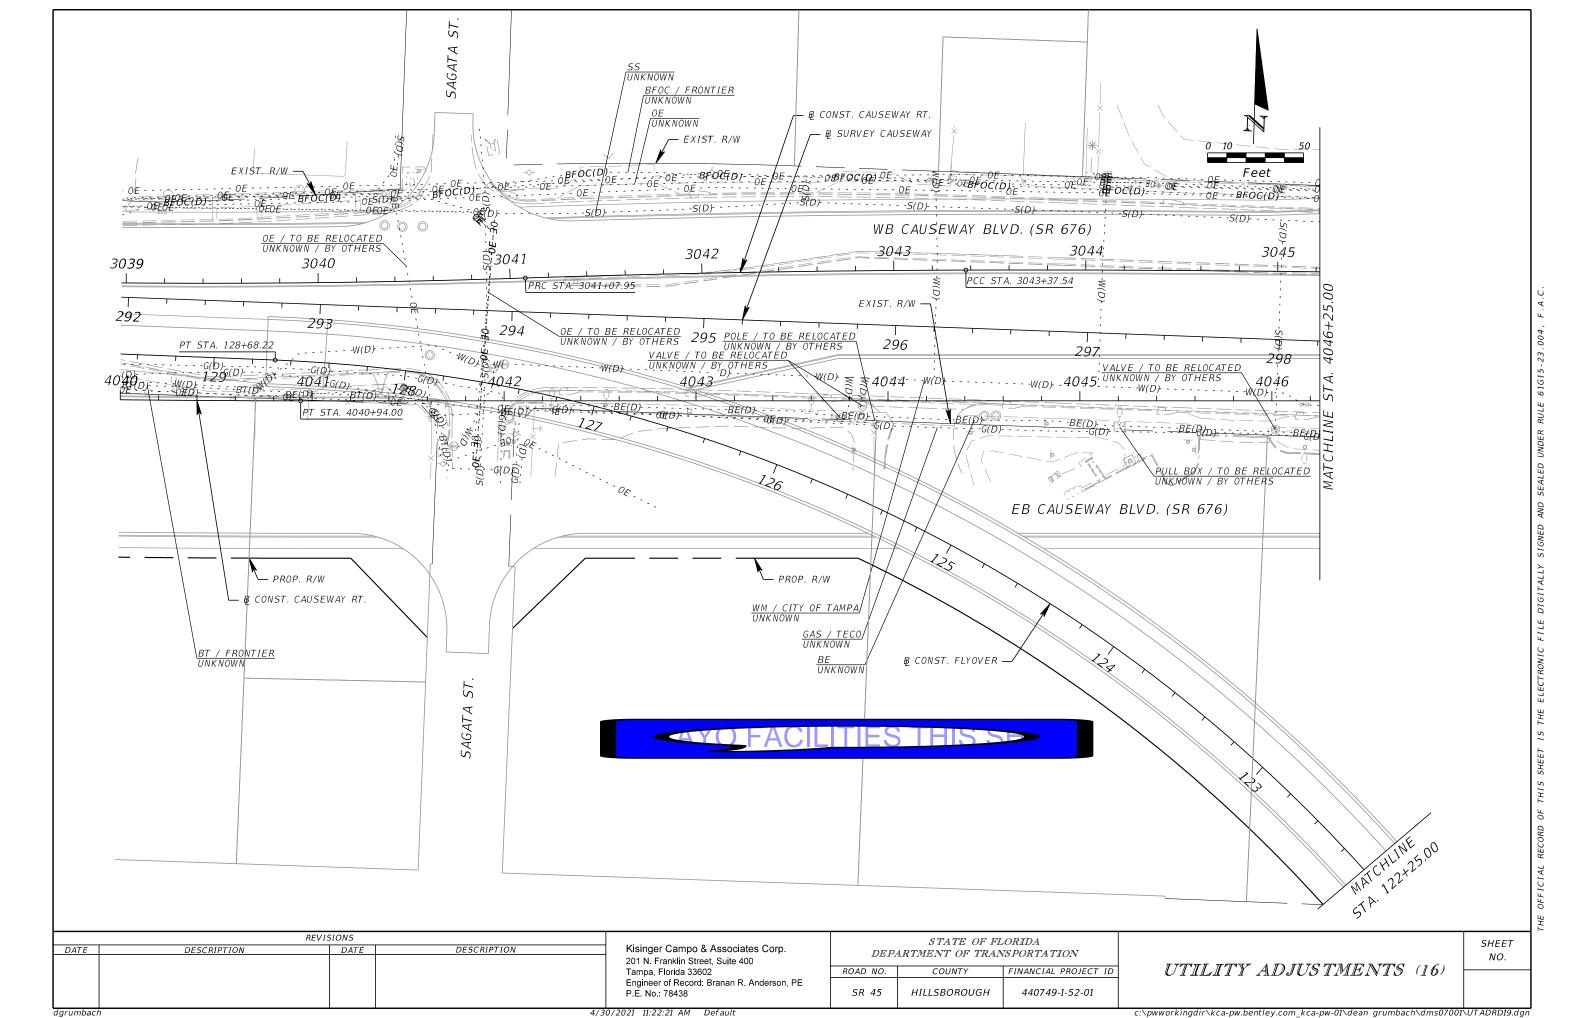

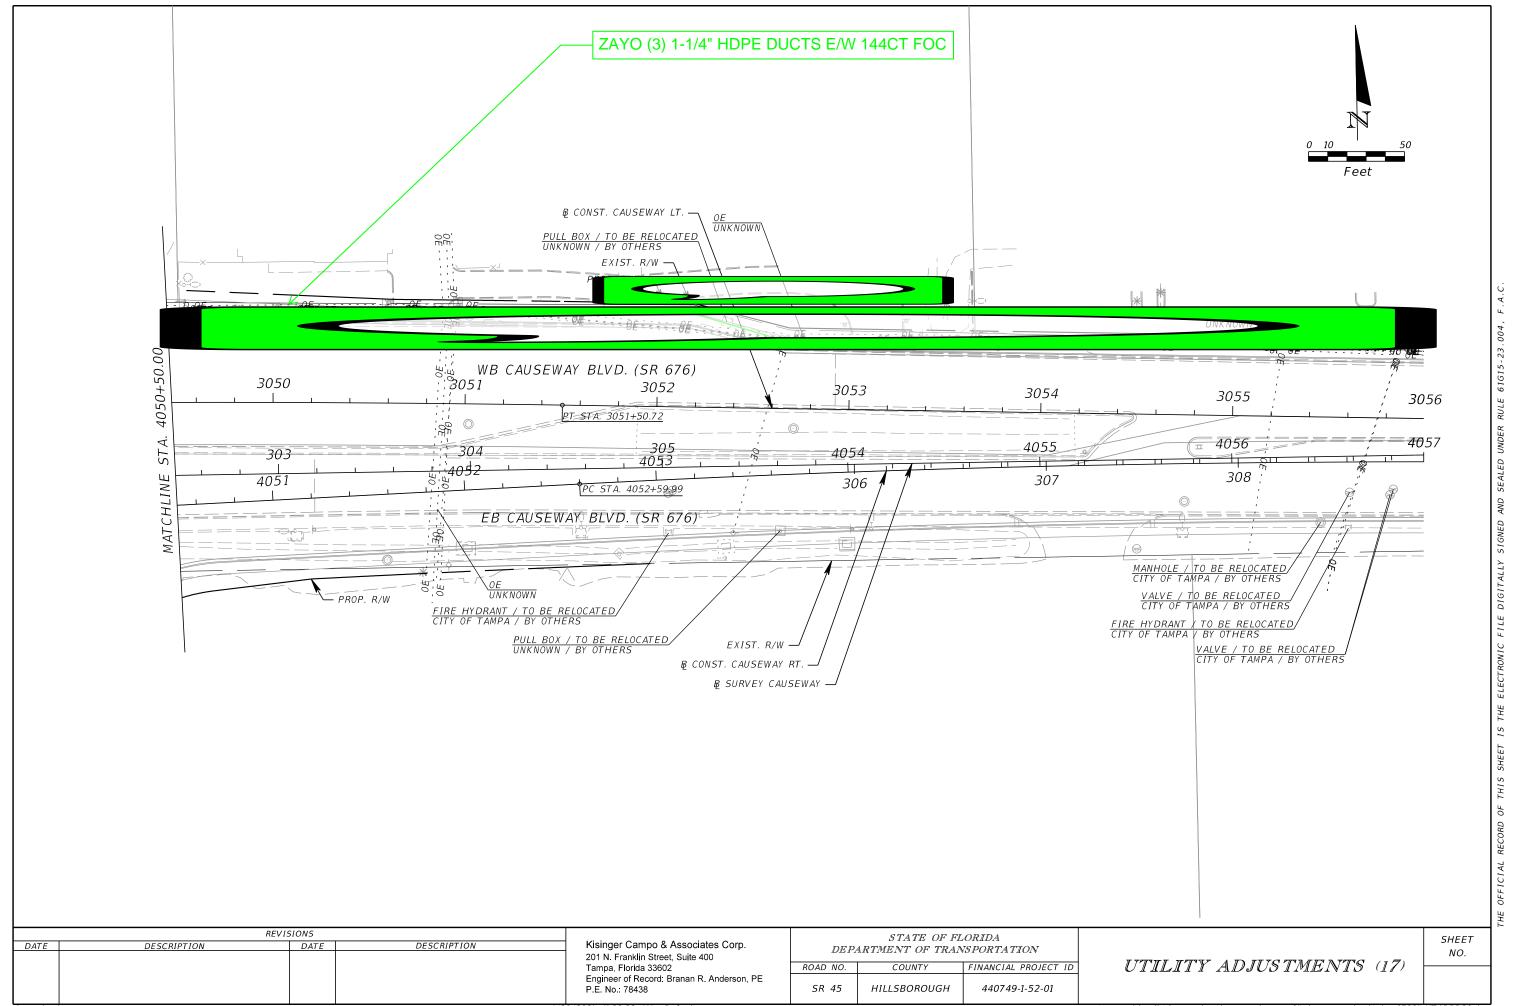

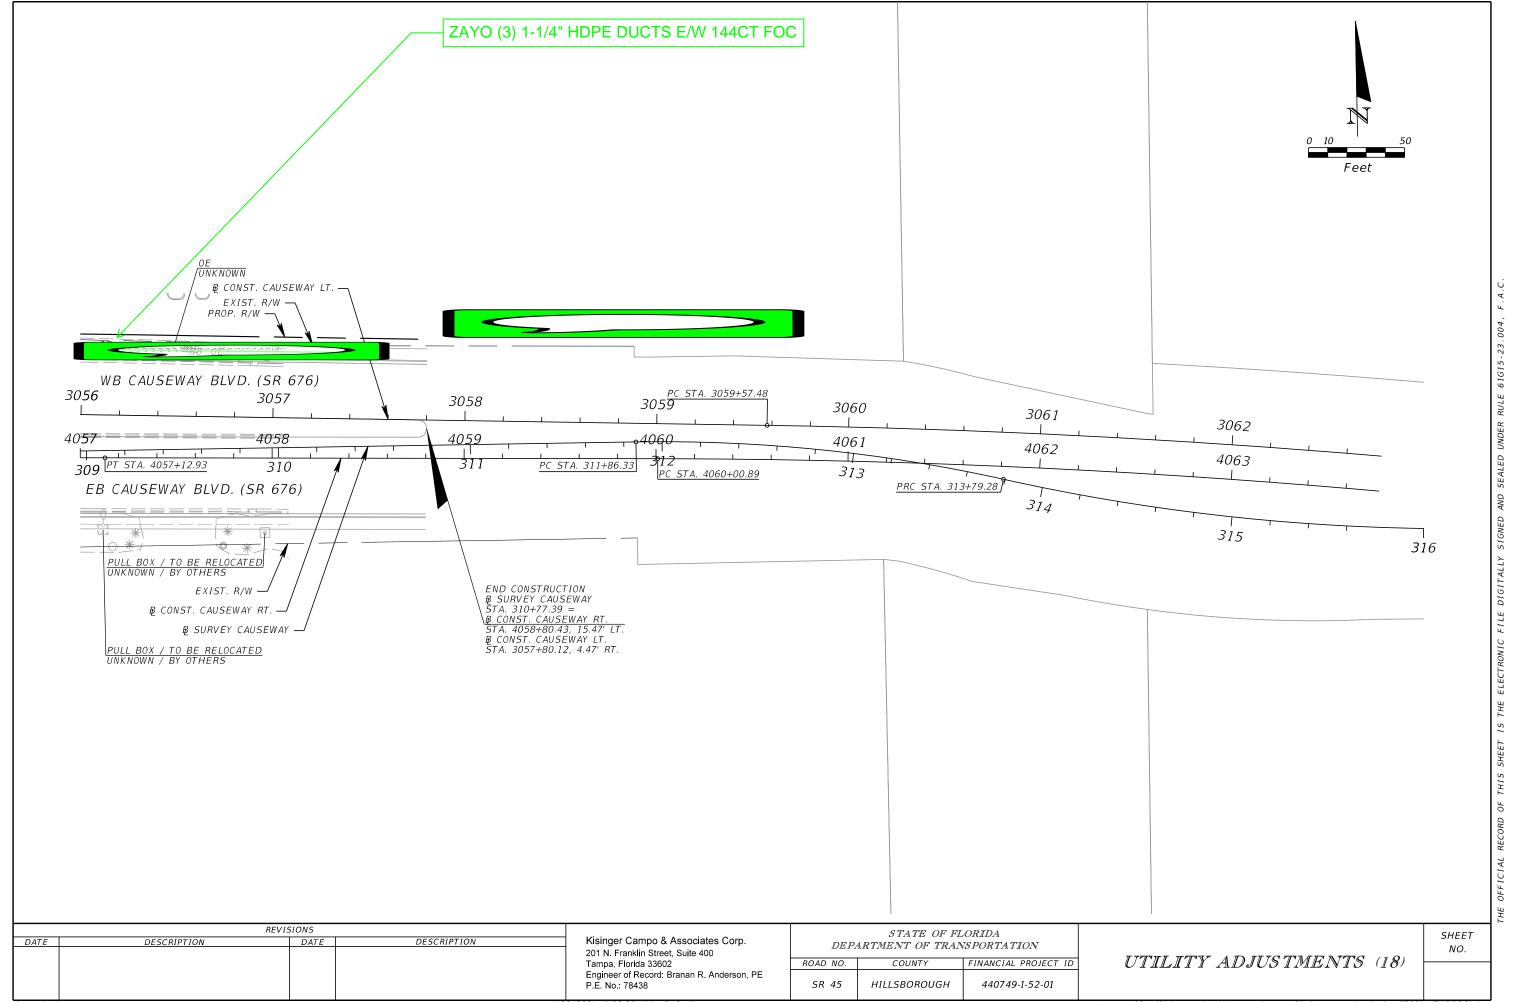

	Cre	w Memb	ers:		DW, TG						
	City	, State:		Ta	ampa, Florida						
	Ger	neral Loca	ation:		US 41						
NCE-	Coc	ordinate (Unit of Meas	ure: U	S Survey Fee						
		Abbrev	riations	Offset Measured From:							
	N/A	= Not Appl	icable	EP= Edge of Pavement							
HOLE"	NAD	= North A	merican	BC = Back of Cu	rb						
	Datu	ım		BL = Baseline of Survey							
	NAV	D = North	American	COORD = Surve	y Coordinates						
	Vert	ical Datum		CL = Centerline							
	UNK	= Unknow	m	HUB = Survey H	ub						
	COT	= City of T	ampa	RW = Right of W	/ay						
				ST = Swing Ties							
				X = "X" in Concr	ete						
	Hori	zontal:	NAD83/11								
	Vert	ical:	NAVD88	Ground	Utility						
ng		Е	asting	Elevation	Elevation						
4.90'			6413.67	7.51'	4.25'						
5.19'		526	416.74"	7.48'	4.18'						
4.95'		526	415.25'	7.48'	5.01'						
5.12'		526418.96'		7.36'	-1.44'						
1.11'	5264 5264 5264 5264		321.06'	6.85'	1.31'						
1.38'		526	417.02	6.84'	3.40'						
1.47'	Vertical: 524 524 524 524 524 524 524		6418.97	6.84'	4.42'						
0.12'		526	422.34'	6.83'	-3.23'						
0.56'		526	424.00'	6.49'	3.15'						
		_									
		Prepared L	by: EE	Date: 02/12/20	019						
		i e									

Truck No.:		l Do/Tol			ster Springs, Florida 32708 UTILITY ENGINEERING & SURVEY					- GROW, INSPIRE, M.	AKE A DIFFERENCE-	Coordinate Unit of Meas		
	U	Itility Type	e				y Material			Identif	ied By:	Abbreviations	Offset Mea	sured Fror
BE = Buried	Electrical	RW = Reclaimed Water			AC = Transite		FIBG = Fiberglass			HUB = Survey Hub		N/A = Not Applicable	EP= Edge of Pav	ement
GM = Gas M	1ain	SL = Street I	Light		CI= Cast Iron		HDPE = High	Density Polyet	thylene Pipe	IRC = Iron Rod & Cap	"ECHO TEST HOLE"	NAD = North American	BC = Back of Cu	rb
BT = Buried	Telephone	TS = Traffic	Signal		CP = Concrete f	Pipe	PE = Polyethy	ylene Pipe		NL = Nail & Disk "ECHO TEST HOLE"		Datum	BL = Baseline of Survey	
OC = Fiber	Optic Cable	FL = Fuel Lir	ne		DBC = Direct Bu	ıried Cable	PVC = Polyvir	PVC = Polyvinyl Chloride				NAVD = North American	COORD = Surve	y Coordinat
VM = Wate	r Main	GS = Gas Se	rvice		CMP = Corruga	ted Metal Pipe	STL = Steel			X = "X" in Concrete		Vertical Datum	CL = Centerline	
SAN = Sanita	ary Sewer	WS = Water	r Service		CONC = Concre	te	VCP = Vitrifie	d Clay Pipe		Surfac	е Туре	UNK = Unknown	HUB = Survey H	ub
STM = Storn	n Sewer	UNK = Unkr	nown Utility		CPP = Corrugat	ed Plastic Pipe	PCCP = Prest	ressed Cylinde	r Concrete	ASPH = Asphalt		COT = City of Tampa	RW = Right of V	/ay
CATV = Cabl	le Television	BED = Burie	d Electrical C	Duct	DCT = Duct		Pipe			CONC = Concrete			ST = Swing Ties	
FM = Force I	Main	BTD = Burie	d Telephone	Duct	DIP = Ductile Ire	on Pipe	RCP = Reinfo	rced Concrete	Pipe	NG = Natural Groun	d		X = "X" in Concr	ete
Test Hole	Utility Type	Utility Material	Utility Size Outside Diameter	Utility Manual Depth	Cross Sectional View	***	Identified By	Surface Type	Surface Thickness inches	Apparent Utility Owner	Datums: Northing	Horizontal: NAD83/11 Vertical: NAVD88	Ground Elevation	Utility Elevati
			inches	feet		Utility Direction			IIICIICS		Northing	Easting		
1-1	вт	PVC	2 - 4"	3.26'	00	<u></u>	IRC	NG	N/A	FRONTIER	1301204.90'	526413.67	7.51'	4.25'
1-2	WM	CI	6"	3.30'		<u></u>	IRC	NG	N/A	сот	1301205.19	526416.74'	7.48'	4.18'
1-3	FOC/BT	PVC	4"	2.47'	\circ		IRC	NG	N/A	FRONTIER	1301204.95'	526415.25'	7.48'	5.01'
1-4	FOC	PE	12 - 1.5"	8.80'	08888c	<u></u>	IRC	NG	N/A	FRONTIER	1301205.12'	526418.96'	7.36'	-1.44
1-5	CATV	PVC	2 - 2"	5.54'	00	\$	IRC	NG	N/A	SPECTRUM	1301181.11'	526321.06'	6.85'	1.31
1-6	вт	PVC	2 - 4"	3.44'		‡	IRC	NG	N/A	FRONTIER	1301811.38'	526417.02'	6.84'	3.40'
1-7	FOC/BT	PVC	4"	2.42'			IRC	NG	N/A	FRONTIER	1301811.47	526418.97"	6.84'	4.42'
1-8	WM	UNK	UNK	10.06'		\$	IRC	NG	N/A	сот	1301810.12'	526422.34'	6.83'	-3.23
1-9	FOC/BT	PVC	4"	3.34'	0	‡	IRC	NG	N/A	FRONTIER	1301810.56'	526424.00'	6.49'	3.15
Notes:	1-8 - Unable	to visually ve	erify size and	matterial du	ue to depth and	groundwater. Possi	ble 6" cast iro	n.				Prengred by: EE	Date: 02/12/2	019
												Prepared by: EE	Date: 02/12/20	
												Checked by: AB	Date: 02/12/	2019
	REVISION	5								Q et a et es	OF FLORIDA			

Test Hole Data Report

ECHO UES, Inc. www.echoues.com

888.778.ECHO

SHEET

4/30/2021 11:22:27 AM Default

Tampa, Florida 33602
Engineer of Record: Branan R. Anderson, PE
P.E. No.: 78438

ROAD NO.

SR 45

COUNTY

HILLSBOROUGH

FINANCIAL PROJECT ID

440749-1-52-01

UTILITY ADJUSTMENTS (19)

Date:

dgrumbach

ECHO Project #:

Financial Project #:

12/04/2018

18-252

N/A

16514 N. Dale Mabry Hwy.

Tampa, Florida 33618

1511 E. SR434, Ste. 2001, #252

Date:		12	2/05/2018				Test Hel	e Data Repo	art.			Crew Members:		DW, TG	
ECHO Pro	iect #:		18-252	16	5514 N. Dale Ma	ibry Hwy.			_	ECHO U	ES, Inc.		City, State: Tampa, Fl		
			N/A		Tampa, Florida	33618	 	CH		www.echo	-	General Location:	US 41		
Financial F	•			1511	l E. SR434, Ste.					888.778					
Truck No.:			D-3/T-2	Win	ter Springs, Flo	1108 32700	UTILITY ENGINEERING & SURVEY			- GROW, INSPIRE, MA		Coordinate Unit of Meas		S Survey Feet	
		Itility Type				Utilit	y Material			Identifi HUB = Survey Hub	ed By:	Abbreviations		sured From:	
BE = Buried		RW = Reclai			AC = Transite		ŭ	-				N/A = Not Applicable	EP= Edge of Pav		
GM = Gas M		SL = Street I	_		CI= Cast Iron				hylene Pipe	IRC = Iron Rod & Cap			BC = Back of Cu		
BT = Buried		TS = Traffic			CP = Concrete P		PE = Polyethy			NL = Nail & Disk "ECH	IO TEST HOLE"	Datum	BL = Baseline of		
FOC = Fiber		FL = Fuel Lir GS = Gas Se			DBC = Direct Bu		PVC = Polyvin	iyi Chloride		SLEEVE = Sleeve X = "X" in Concrete		NAVD = North American Vertical Datum	COORD = Surve CL = Centerline	y Coordinates	
WM = Wate SAN = Sanita		WS = Water			CMP = Corrugat CONC = Concret		STL = Steel VCP = Vitrifie	d Clay Dina		Surface	Tuno	UNK = Unknown	HUB = Survey H	ub	
SAN = Sanita STM = Storn		UNK = Unkr			CPP = Corrugate		†		r Constato	ASPH = Asphalt	: туре	COT = City of Tampa	RW = Right of W		
CATV = Cabl			d Electrical D	ouct	DCT = Duct	ed Flastic Fipe	Pipe Presti	ressed Cylinde	r concrete	CONC = Concrete		cor – city or rampa	ST = Swing Ties	, uy	
FM = Force I			d Telephone		DIP = Ductile Iro	on Pipe		rced Concrete	Pipe	NG = Natural Ground			X = "X" in Concr	ete	
			Utility Size	Utility		Ņ			Surface			Horizontal: NAD83/11			
Test Hole	Utility Type	Utility	Outside	Manual	Cross	+	Identified By	Surface Tyne	Thickness	Apparent Utility	Datums:	Vertical: NAVD88		Utility	
100011010	ounty type	Material	Diameter	Depth	Sectional View	¥↓¾ Utility Direction	raciiciica by	dentified By Surface Type Thickness inches		Owner Northing		Easting	Elevation	Elevation	
1-10	FOC	PE	inches 12 - 1.5"	feet 3.96'	000 0000 0000	A A	IRC	NG	N/A	FRONTIER	1302430.03	526421.52'	6.62'	2.66'	
1-11	ВТ	PVC	2 - 4"	2.50'	000000	*	IRC	NG	N/A	FRONTIER	1302430.50	526424.77'	6.68'	4.18'	
1-12	FOC/BT	PVC	4"	1.90'		<u> </u>	IRC	NG	N/A	FRONTIER	1302430.47'	526425.15'	6.69'	4.79'	
						<u> </u>									
1-13	ВТ	DBC	2"	1.56'	0	\	IRC	NG	N/A	FRONTIER	1302430.15'	526428.11'	6.81'	5.25'	
1-14	WM	DIP	6"	3.40"		<u> </u>	IRC	NG	N/A	СОТ	1302428.62	526446.38'	8.20'	4.80'	
1-15	GM	STL	4"	3.00'		Ţ	IRC	NG	N/A	сот	1302488.18'	526318.06'	6.08'	3.08'	
1-16	ВТ	PVC	4"	3.50'			IRC	NG	N/A	FRONTIER	1301205.22'	526417.96'	7.50'	4.00'	
1-17	ВТ	DBC	2"	3.00'	0	<u></u>	IRC	NG	N/A	FRONTIER	1301810.09'	526422.72'	6.80'	3.80'	
Notes:															
												Prepared by: EE	Date: 02/12/20	019	
												Checked by: AB	Date: 02/12/	2019	

REVISIONS STATE OF FLORIDA Kisinger Campo & Associates Corp. 201 N. Franklin Street, Suite 400 DESCRIPTION DATE DESCRIPTION DATE DEPARTMENT OF TRANSPORTATION Tampa, Florida 33602
Engineer of Record: Branan R. Anderson, PE
P.E. No.: 78438 ROAD NO. COUNTY SR 45 HILLSBOROUGH 440749-1-52-01

FINANCIAL PROJECT ID

UTILITY ADJUSTMENTS (20)

SHEET NO.

c:\pwworkingdir\kca-pw.bentley.com_kca-pw-01\dean grumbach\dms07001\UTADRD00.dgn

Date:		12	2/06/2018				Test Hol	e Data Repo	ort			Crew Members:		DW, TG, MAJ
ECHO Proj	ject #:		18-252	16	5514 N. Dale Ma	abry Hwy.				ECHO U	IES, Inc.	City, State:	Т	ampa, Florida
Financial F	•		N/A		Tampa, Florida	33618	≫⊩	ECH		www.ech		General Location:		US 41
Truck No.:			D-3/T-2		L E. SR434, Ste.					888.778 - GROW, INSPIRE, M		Coordinate Unit of Meas	uro:	S Survey Feet
TTUCK NO		IATIDA - Trans	,	Win	ter Springs, Flo	nida SE700		INEERING &	SURVET					· ·
DE D 41.41		Itility Type			A.C. Turning	Utilit	y Material	l		Identified By:		Abbreviations		sured From:
BE = Buried I		RW = Reclai			AC = Transite		FIBG = Fiberg		hulana Bina	HUB = Survey Hub	PECHO TEST HOLE!	N/A = Not Applicable NAD = North American	EP= Edge of Pay	
GM = Gas M BT = Buried		SL = Street TS = Traffic	ŭ		CI= Cast Iron	lino	PE = Polyethy		nylene Pipe	IRC = Iron Rod & Cap NL = Nail & Disk "ECI		Datum	BC = Back of Cu BL = Baseline of	
FOC = Fiber		FL = Fuel Lir			CP = Concrete Pipe DBC = Direct Buried Cable		PVC = Polyetny			SLEEVE = Sleeve	HO TEST HOLE	NAVD = North American	COORD = Surve	,
WM = Water		GS = Gas Se			CMP = Corrugat		STL = Steel	iyi cilionde		X = "X" in Concrete		Vertical Datum	CL = Centerline	
SAN = Sanita		WS = Water			CONC = Concre		VCP = Vitrifie	d Clay Bina		Surfac	o Typo	UNK = Unknown	HUB = Survey H	
STM = Storm	•	UNK = Unkr			CPP = Corrugate		1		v Consusta	ASPH = Asphalt	етуре	COT = City of Tampa	RW = Right of V	
CATV = Cable			d Electrical D	huct	DCT = Duct	eu riasuc ripe	Pipe Prest	ressed Cylinde	r Concrete	CONC = Concrete		COT - City of Tampa	ST = Swing Ties	
FM = Force N			d Telephone		DIP = Ductile Iro	n Pine		rced Concrete	Pine	NG = Natural Ground	4		X = "X" in Conci	
rivi – roice	viaiii	BTB - Burie	Utility Size	Utility	DIF - Ductile II C	N N	KCF - Kellilo	rcea concrete		NG - Natural Ground		Horizontal: NAD83/11	X = X III conci	
Took Upla	I IAIlian Tono	Utility	tility Outside	Manual	Cross	*	uda asida ad no.	Conferentian	Surface	Apparent Utility	Datums:	Vertical: NAVD88	Ground	Utility
lest Hole	Utility Type	Material	Diameter	Depth	Sectional View	▼	identified by	Surface Type	Thickness inches	Owner	Northina		Elevation	Elevation
			inches	feet		Utility Direction			inches		Northing	Easting		
1-18	вт	PVC	2 - 4"	3.82'	00		IRC	NG	N/A	FRONTIER	1303091.15'	526425.13'	7.04'	3.22'
1-19	FOC/BT	PVC	4"	2.54'			IRC	NG	N/A	FRONTIER	1303091.17	526425.73"	6.99'	4.45'
1-20	вт	LEAD	2 - 2"	3.00'	00	\^	IRC	NG	N/A	FRONTIER	1303091.09'	526427.92'	6.86'	3.86'
1-21	FOC	UNK	12 - 1.5"	9.22'	888888	‡	IRC	NG	N/A	FRONTIER	1303091.01	526430.76'	6.58'	-2.64'
1-22	вт	LEAD	2 - 2"	2.00'	00		IRC	NG	N/A	FRONTIER	1303695.15'	526432.46'	6.77'	4.77'
1-23	вт	PVC	2 - 4"	2.76'	00		IRC	NG	N/A	FRONTIER	1303695.20'	526433.46'	6.70'	3.94'
1-24	ВТ	LEAD	2 - 2"	2.74'	00	‡	IRC	NG	N/A	FRONTIER	1304500.45	526435.53'	7.28'	4.54'
Notes:	1-21 - Unable	e to visually v	erify size and	d material du	ue to depth and g	groundwater. Possil	bly 12 - 1.5" p	olyethylene pi	pes.					
												Prepared by: EE	Date: 02/12/2	019
												Checked by: AB	Date: 02/12/	2019

REVISIONS DESCRIPTION DESCRIPTION DATE

Kisinger Campo & Associates Corp. 201 N. Franklin Street, Suite 400 Tampa, Florida 33602 Engineer of Record: Branan R. Anderson, PE P.E. No.: 78438

STATE OF FLORIDA DEPARTMENT OF TRANSPORTATION ROAD NO. COUNTY FINANCIAL PROJECT ID SR 45 HILLSBOROUGH 440749-1-52-01


UTILITY ADJUSTMENTS (21)

SHEET NO.

STATE OF FLORIDA DEPARTMENT OF TRANSPORTATION

CONTRACT PLANS

FINANCIAL PROJECT ID 440749-1-52-01

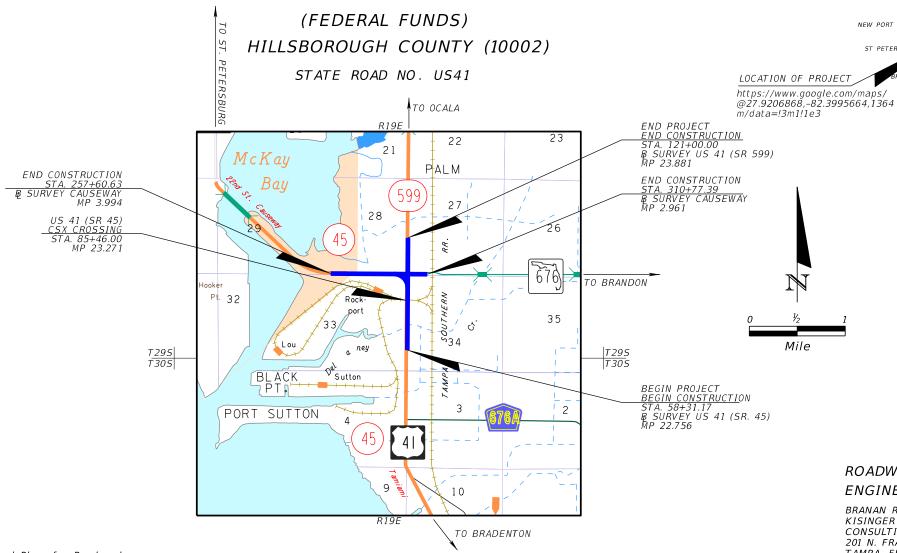

GOVERNING STANDARD PLANS:

Florida Department of Transportation, FY2021-22 Standard Plans for Road and Bridge Construction and applicable Interim Revisions (IRs).

Standard Plans for Road Construction and associated IRs are available at the following website: http://www.fdot.gov/design/standardplans

APPLICABLE IRs: N/A

Standard Plans for Bridge Construction are included in the Structures Plans Component

GOVERNING STANDARD SPECIFICATIONS:

Florida Department of Transportation, July 2022 Standard Specifications for Road and Bridge Construction at the following website: http://www.fdot.gov/programmanagement/Implemented/SpecBooks

ROADWAY PLANS ENGINEER OF RECORD:

TAME

NAPLE

BRANAN R. ANDERSON, P.E. NO.: 78438 KISINGER CAMPO AND ASSOCIATES CORP. CONSULTING ENGINEERS & PLANNERS 201 N. FRANKLIN STREET, SUITE 400 TAMPA, FLORIDA 33602 (813) 871-5331 VENDOR NUMBER.: F59-1677145

FDOT PROJECT MANAGER:

TIM O'BRIEN P.E.


Mile


CONSTRUCTION	FISCAL	SHEET
CONTRACT NO.	YEAR	NO.
TBD	21	1


AYTONA BEACH


PIERCE


4/13/2021 2:47:16 PM dgrumbach Def aul

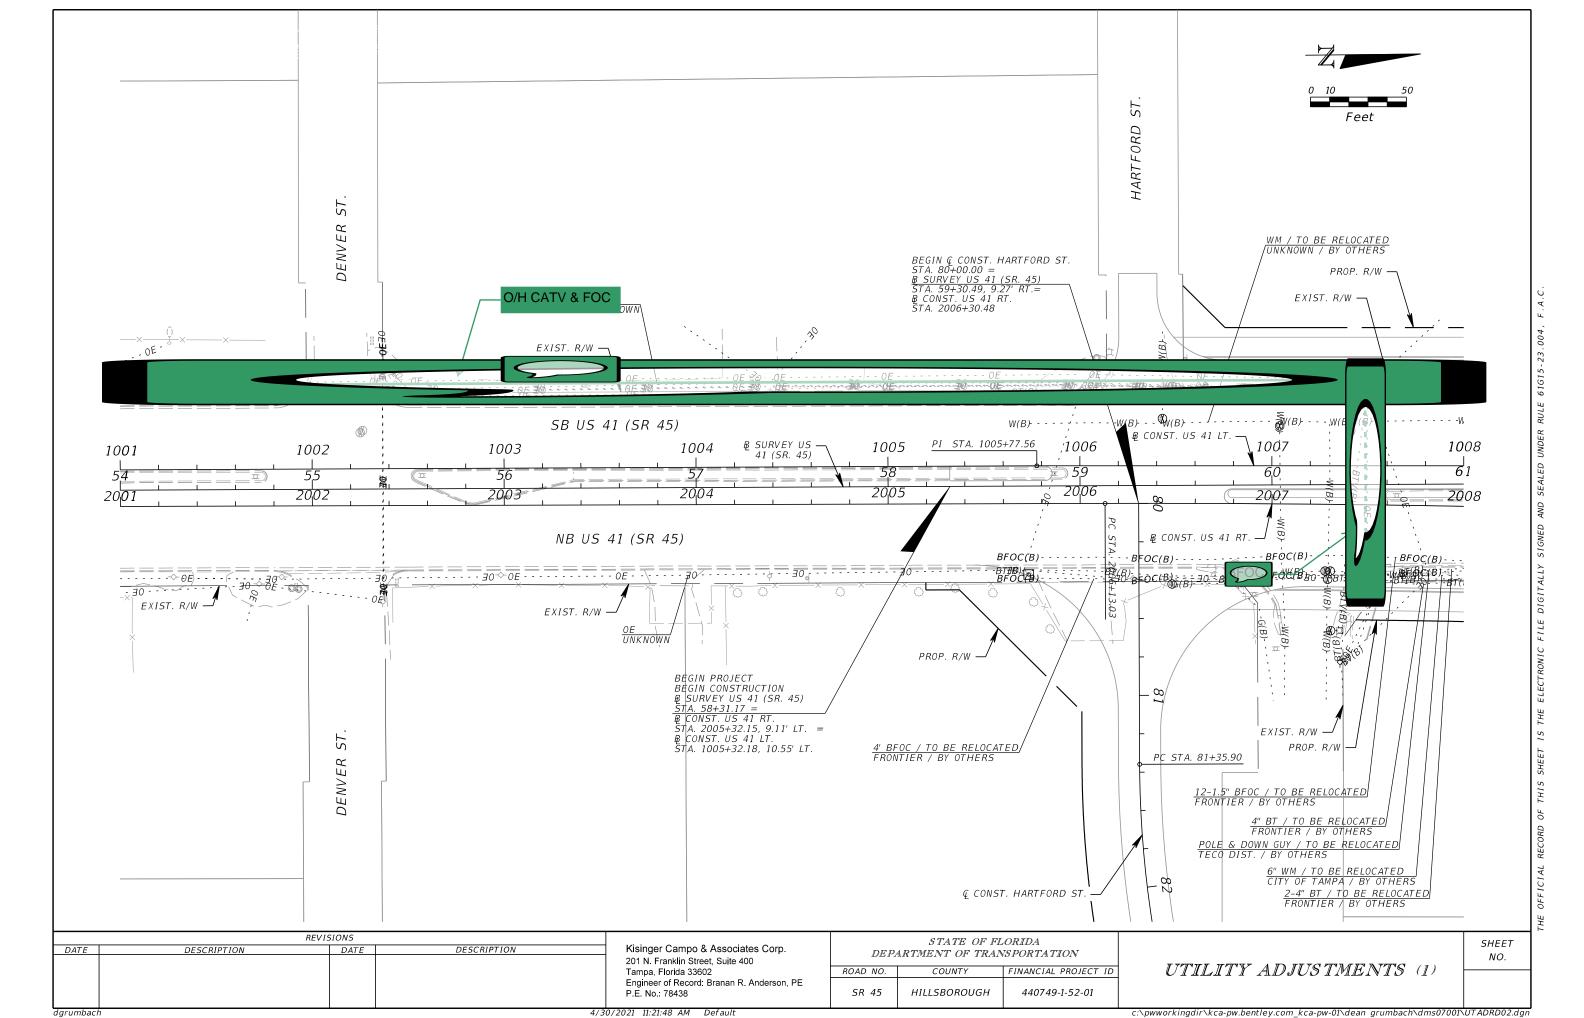


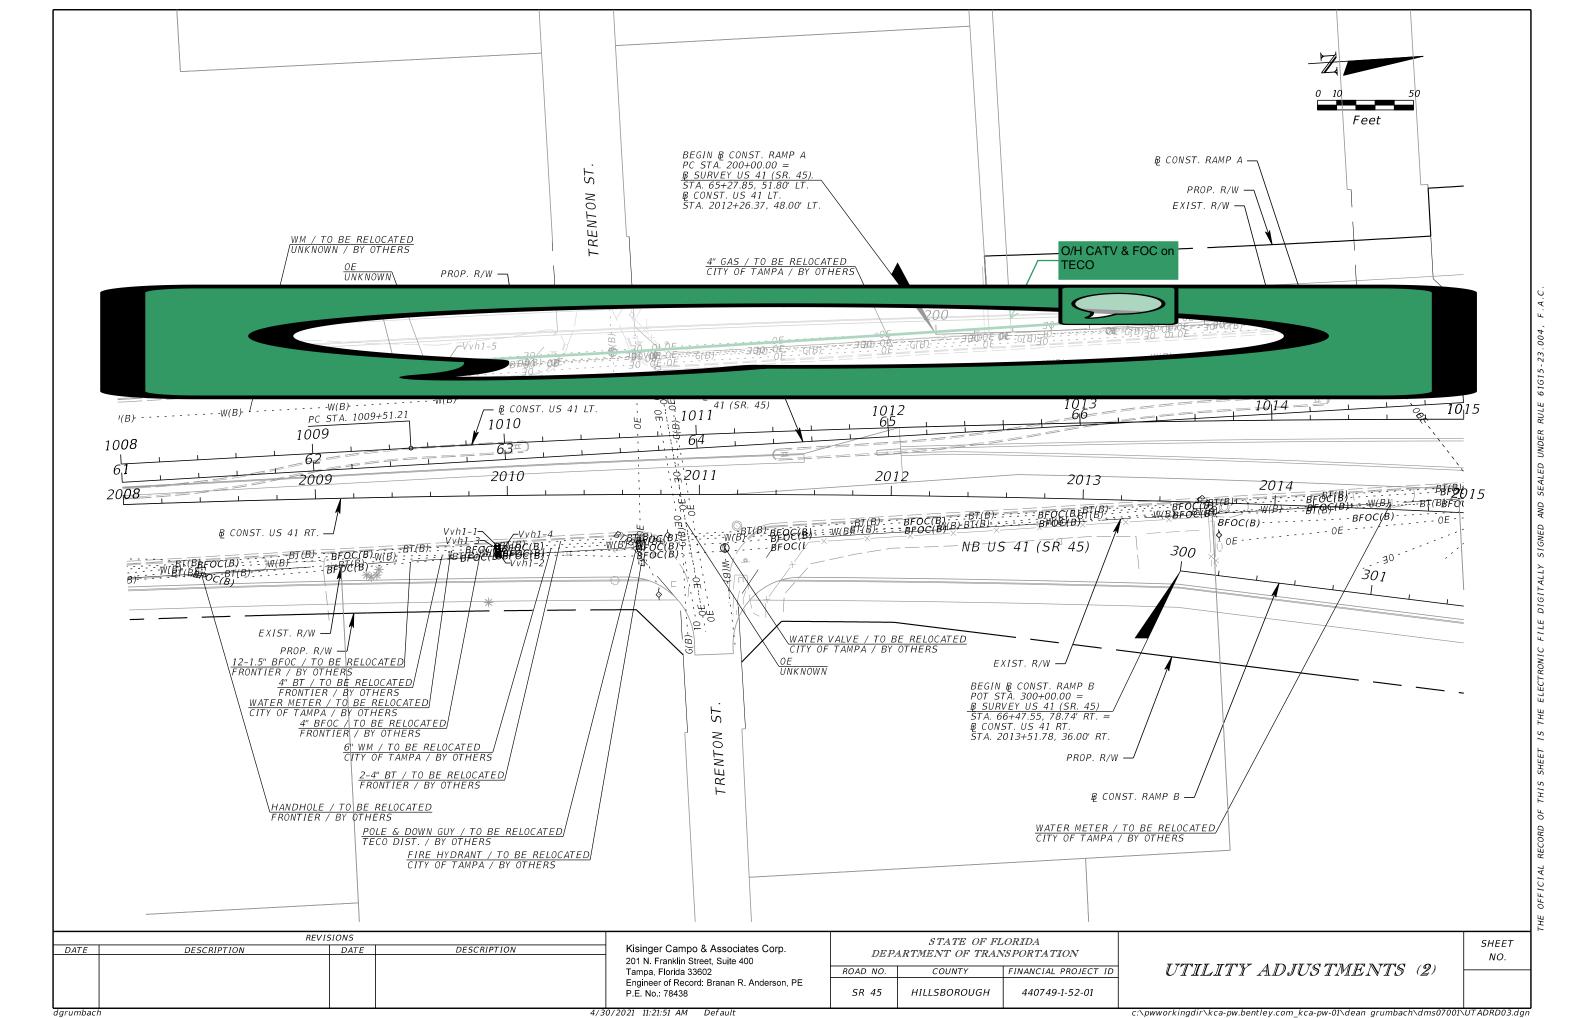


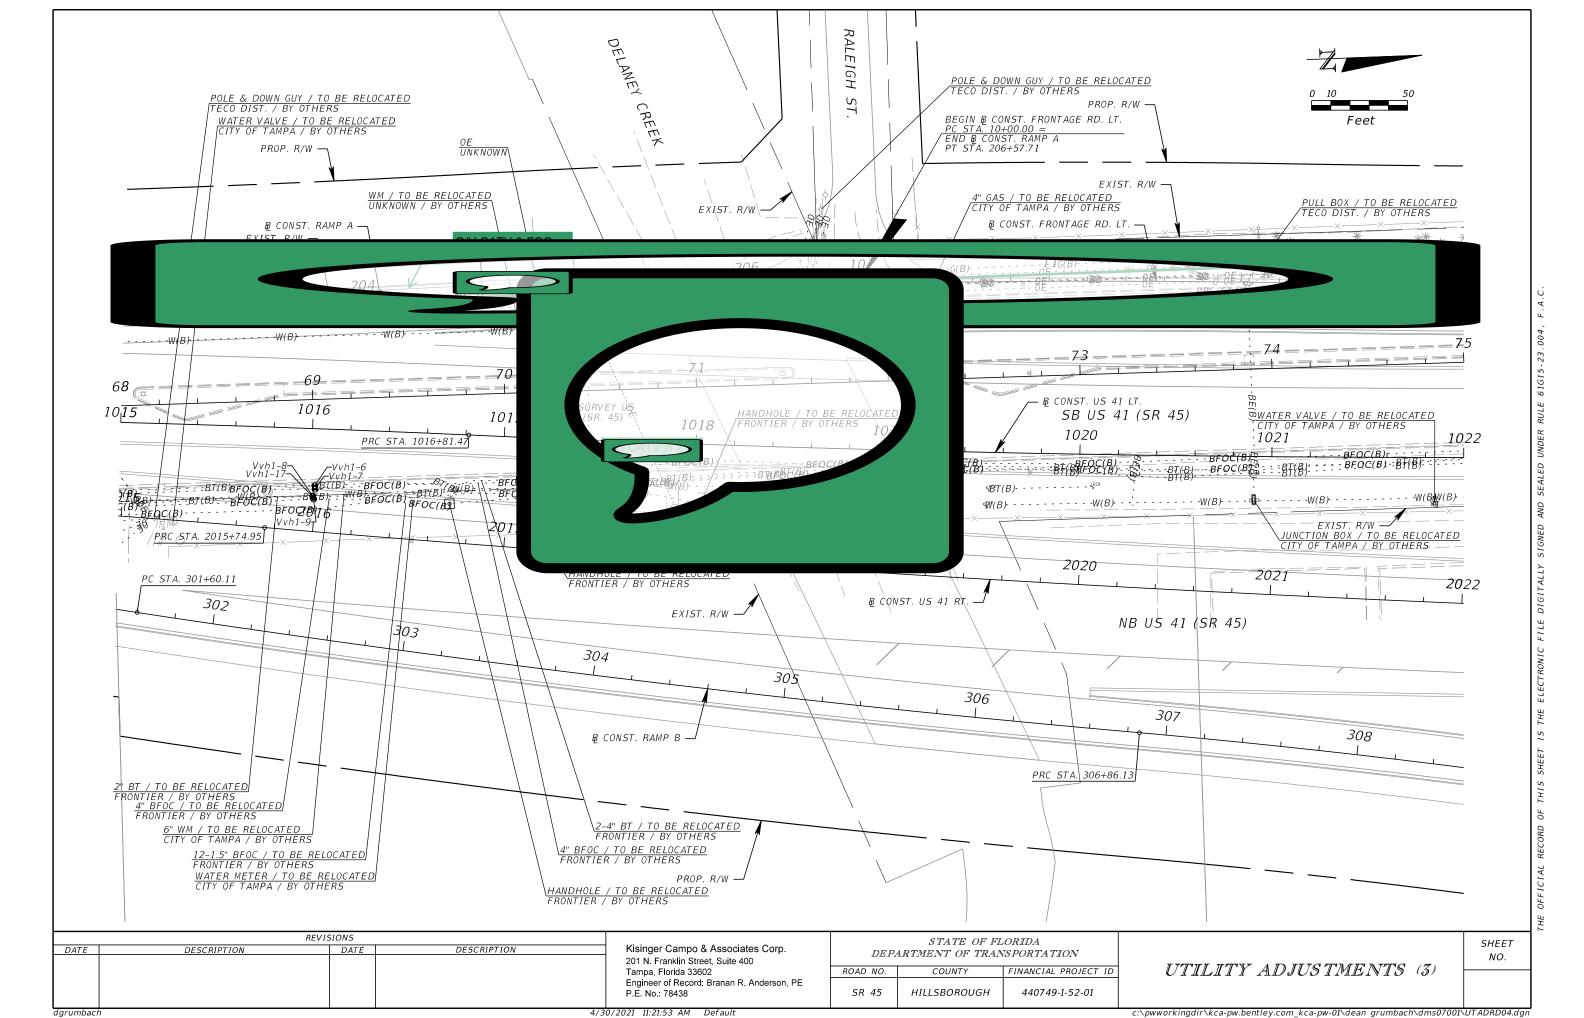


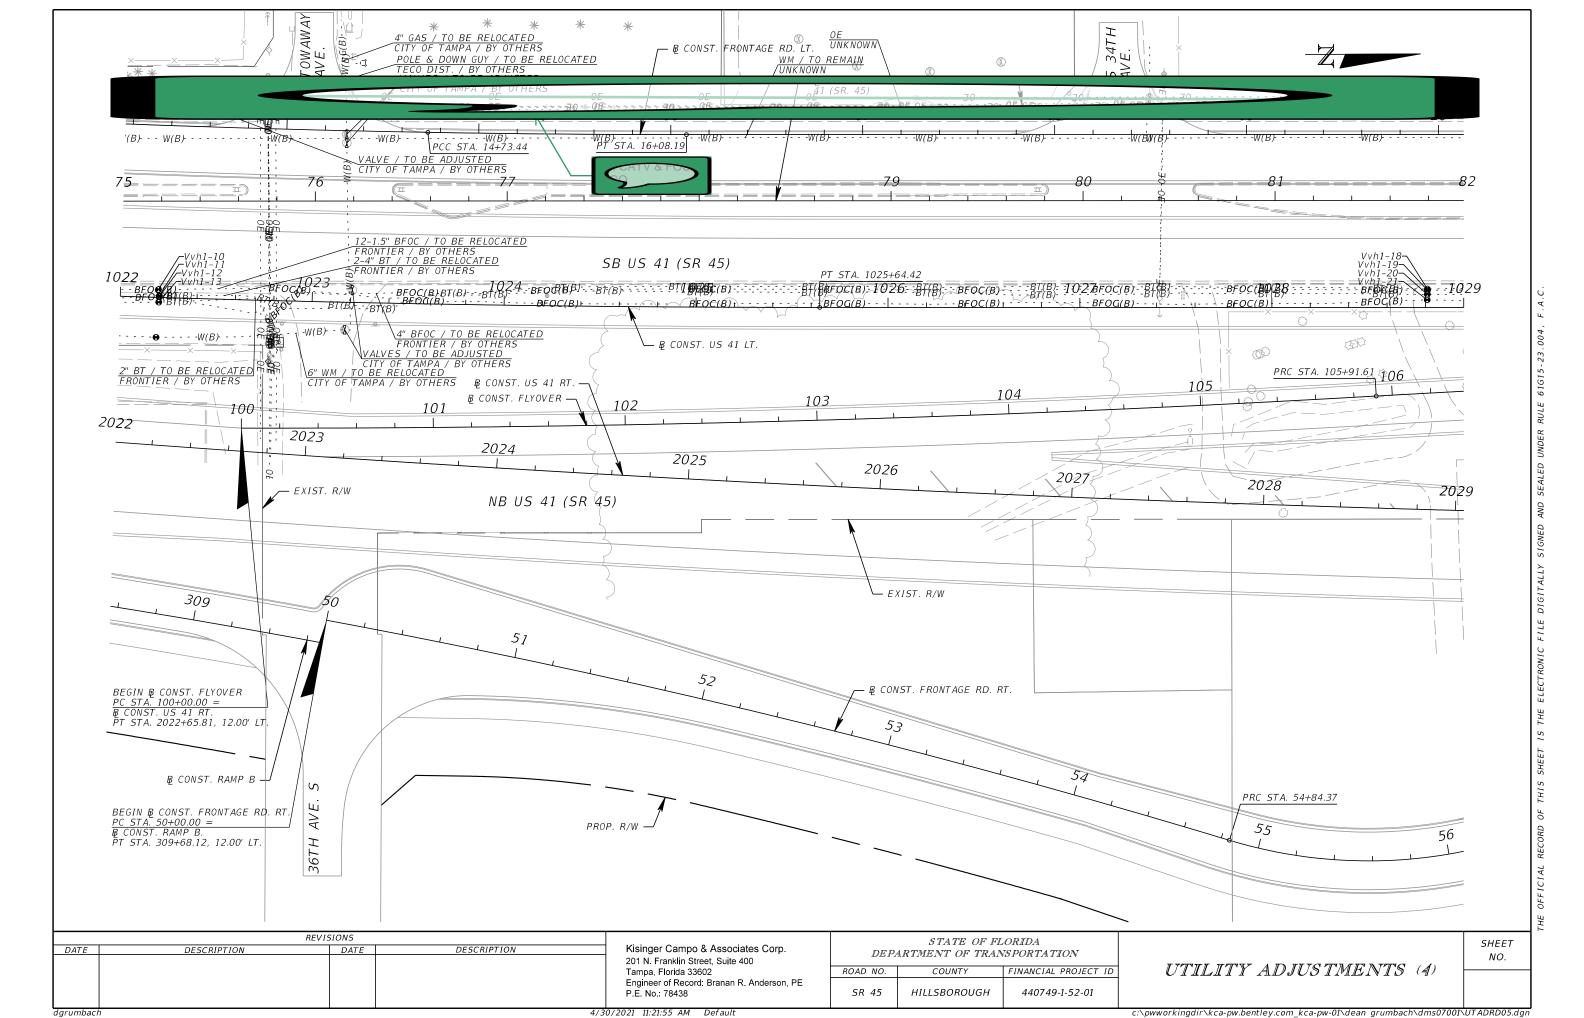


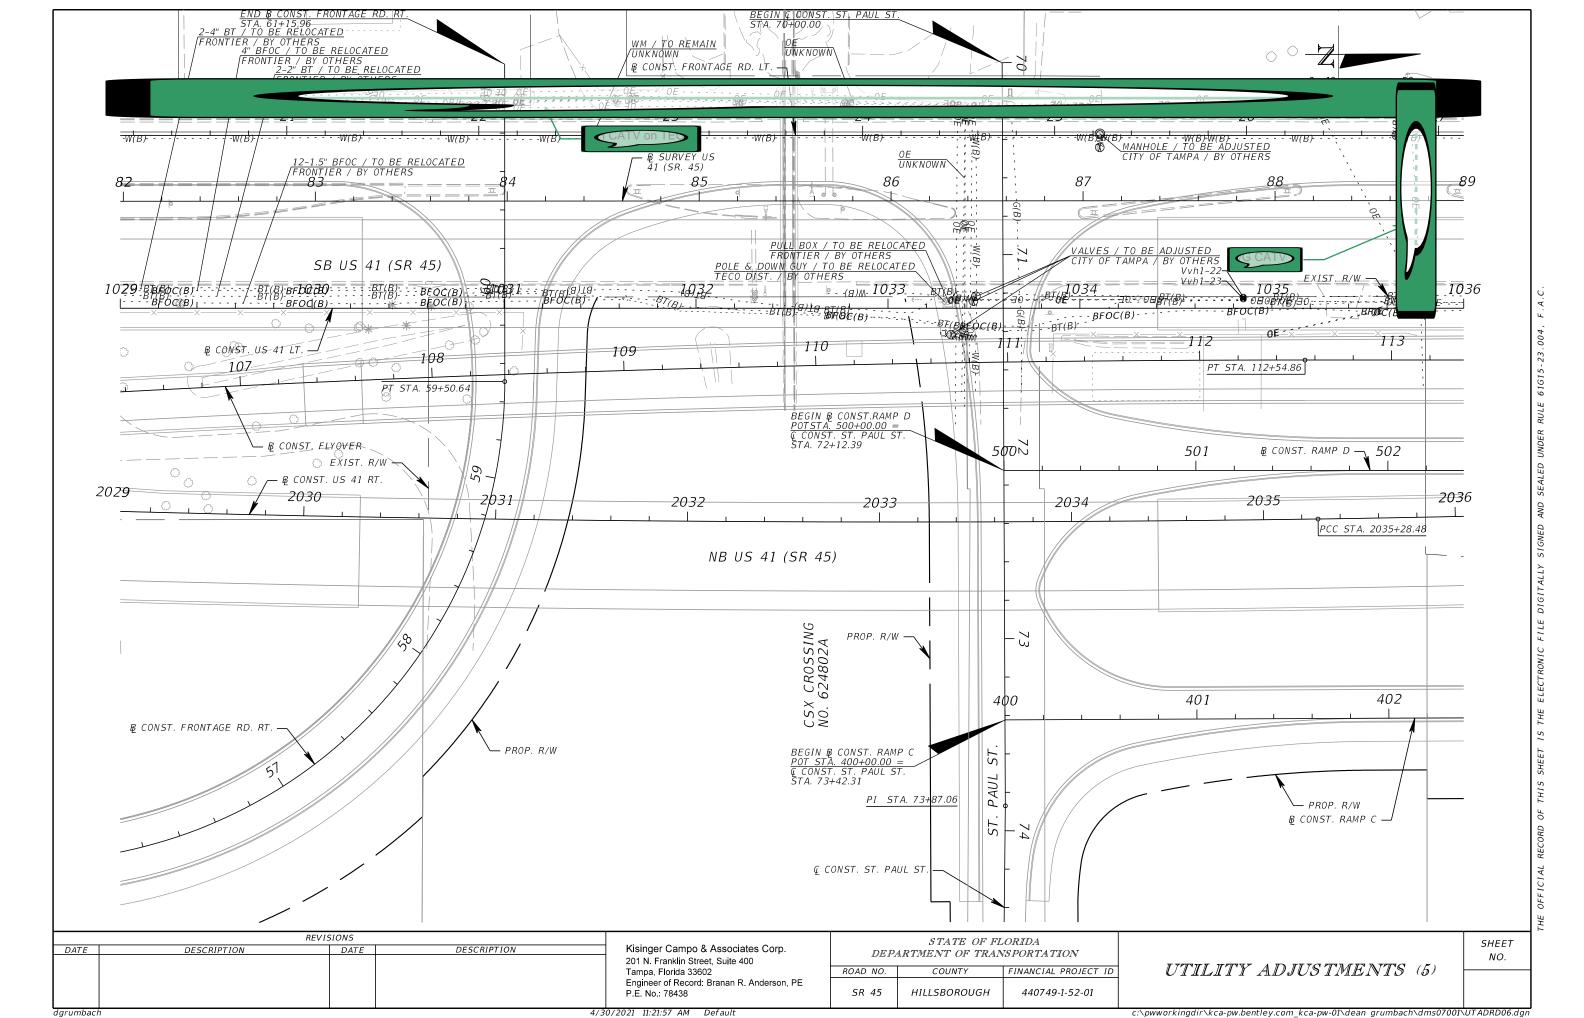


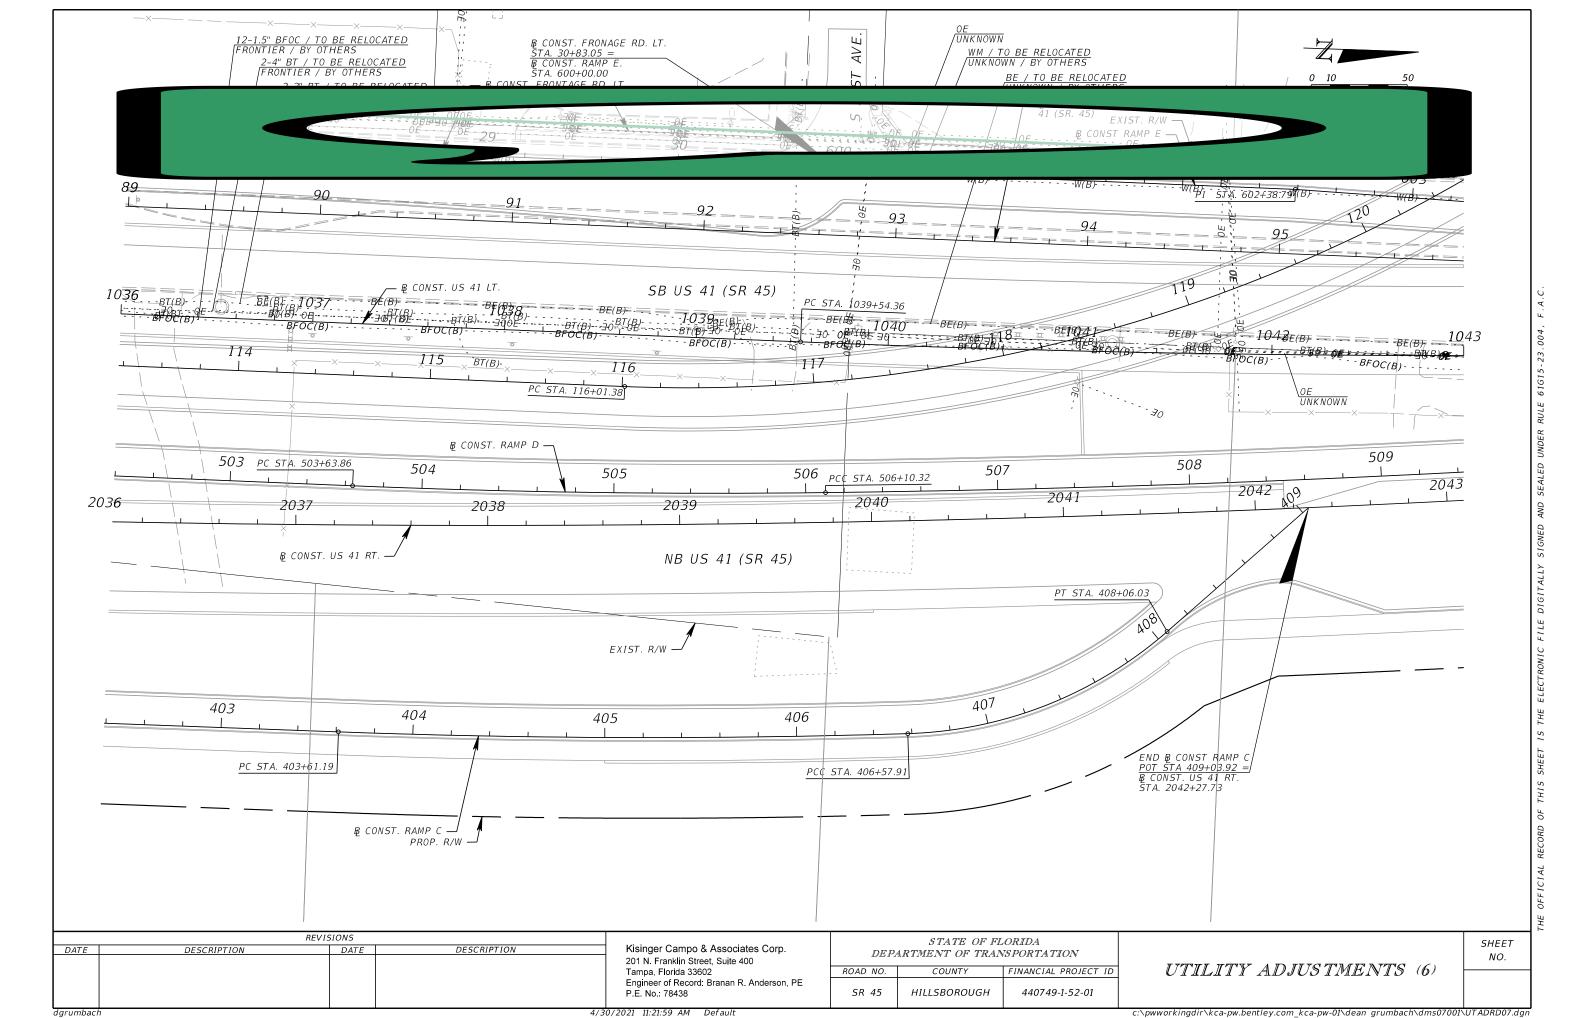

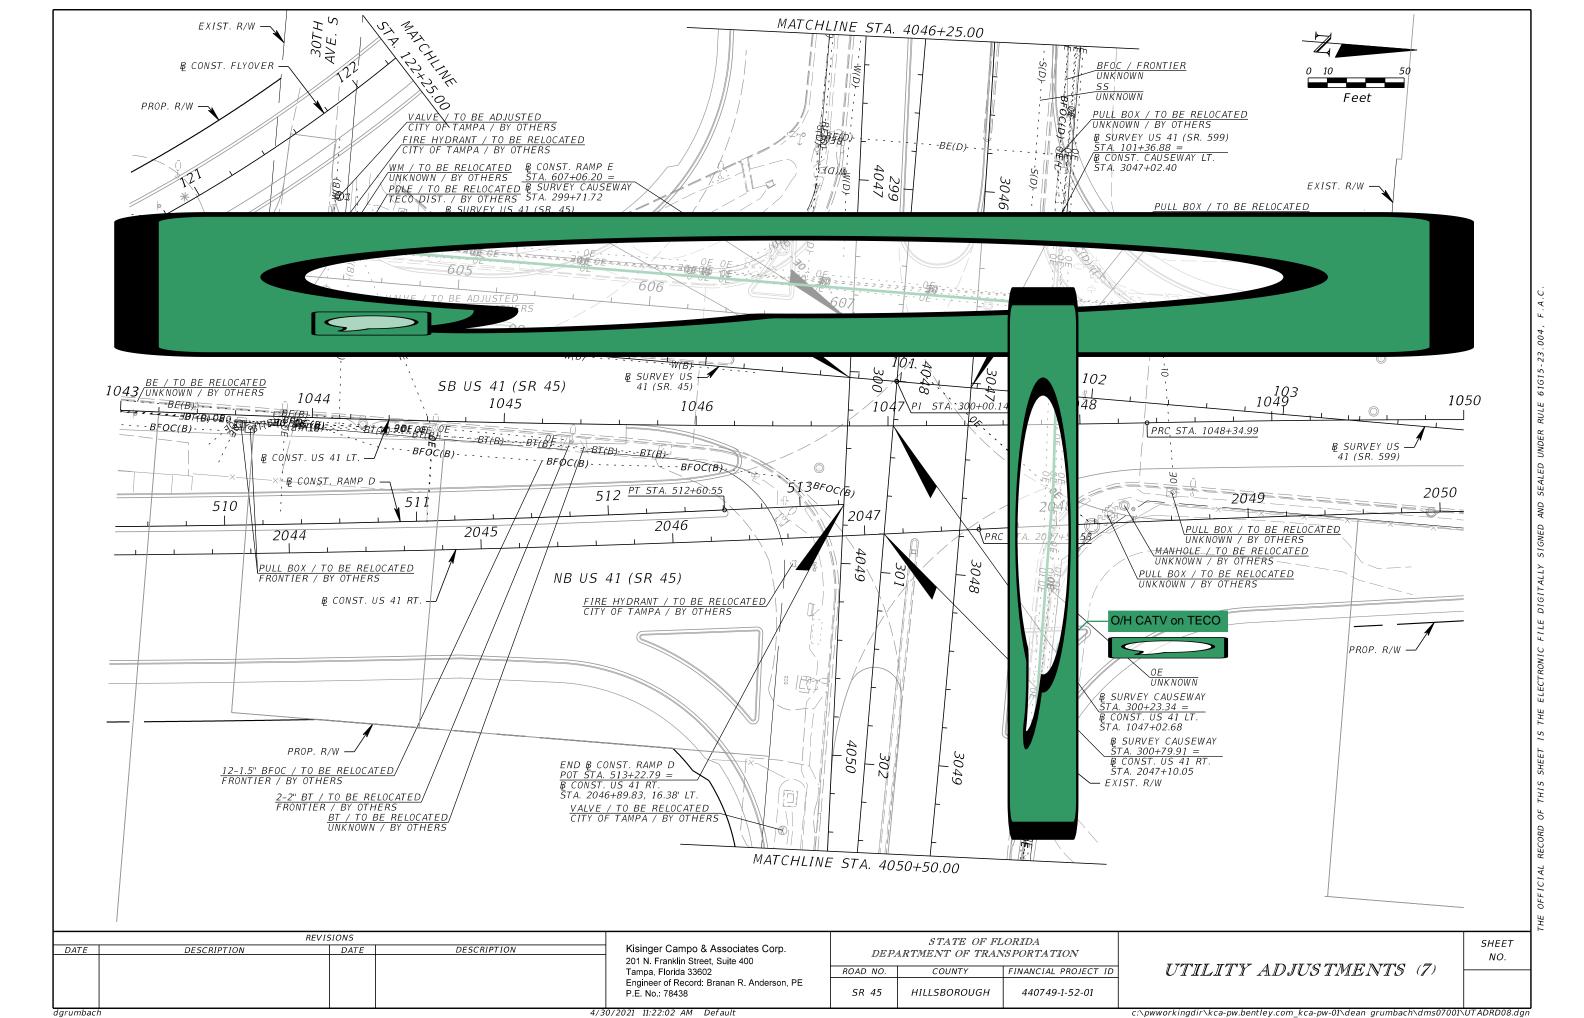


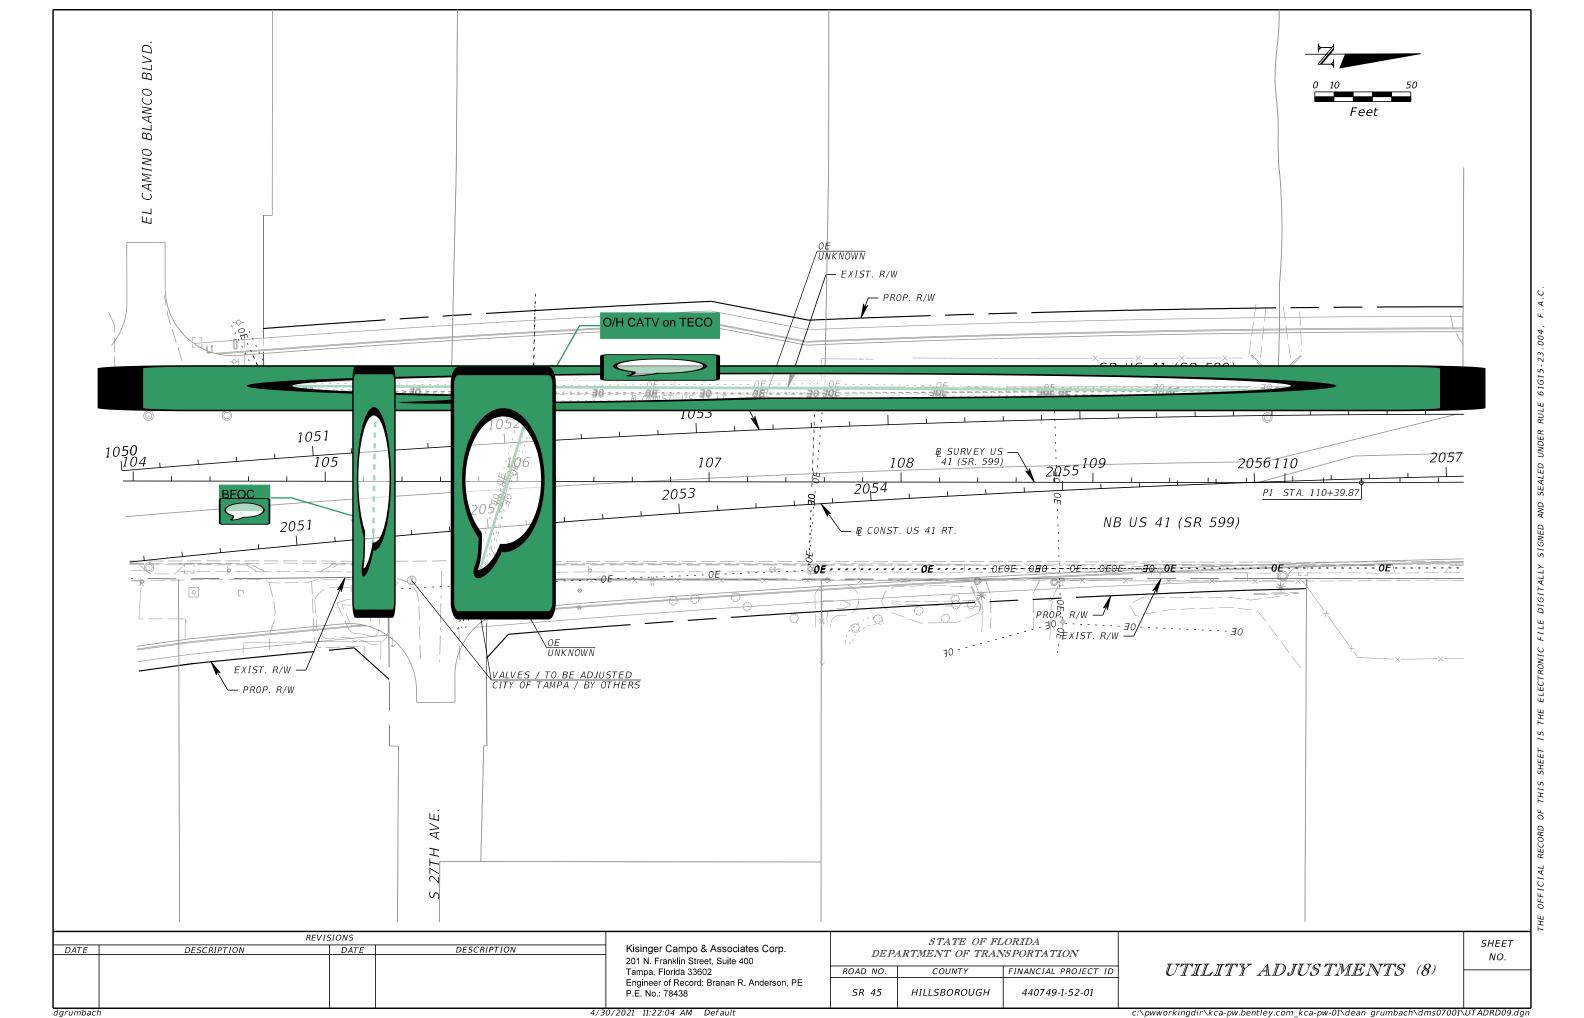


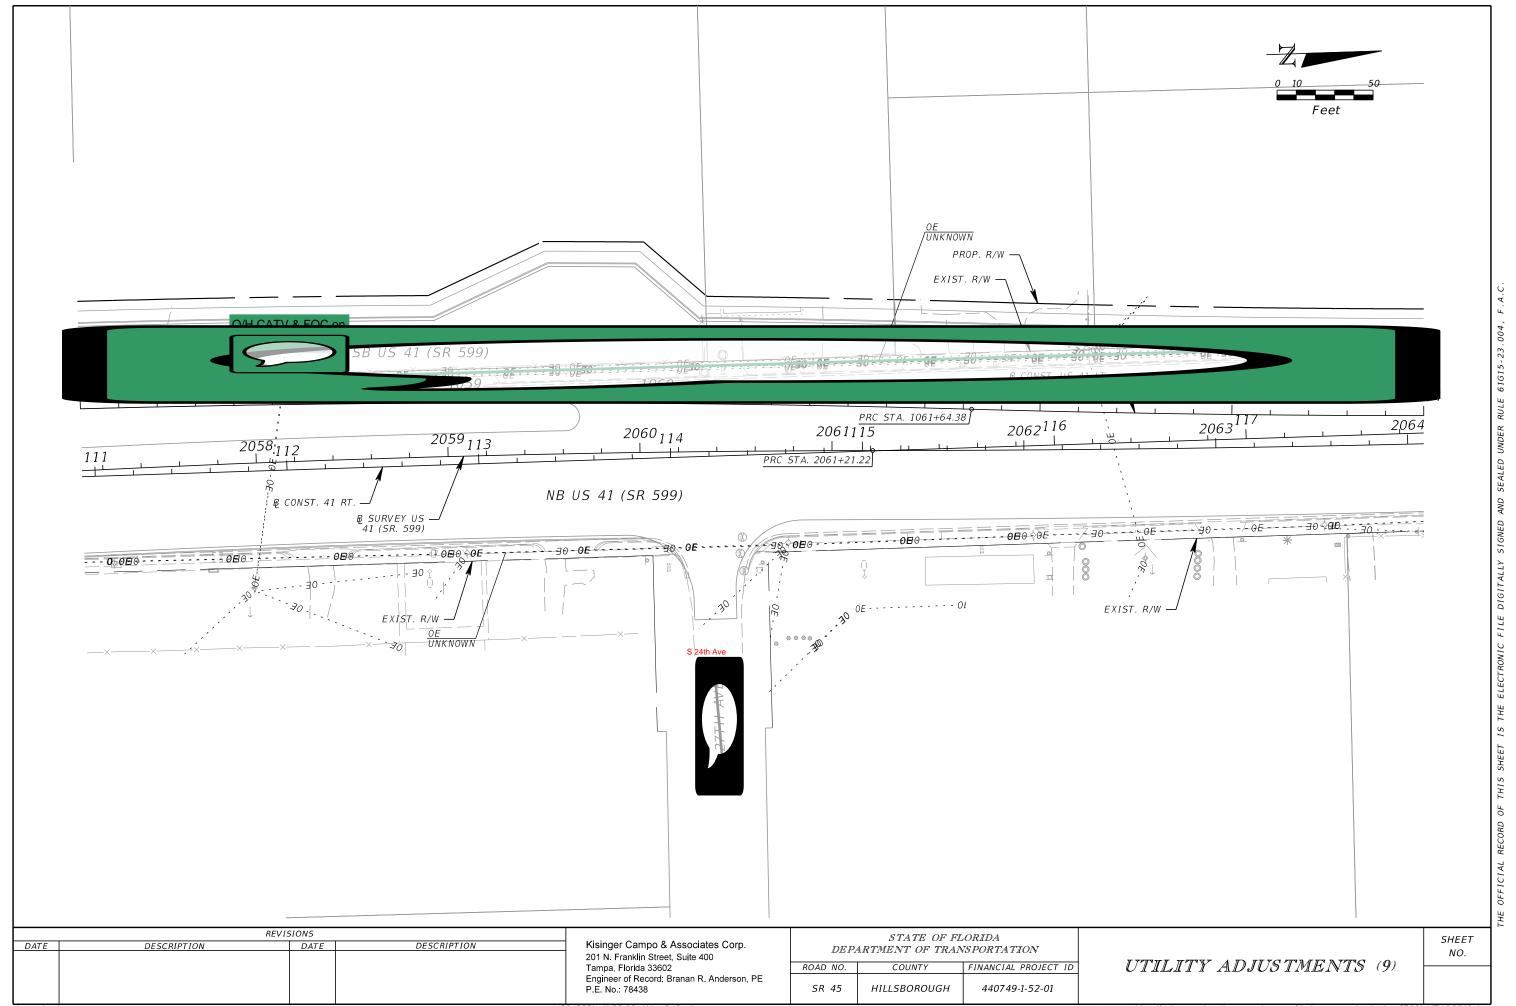

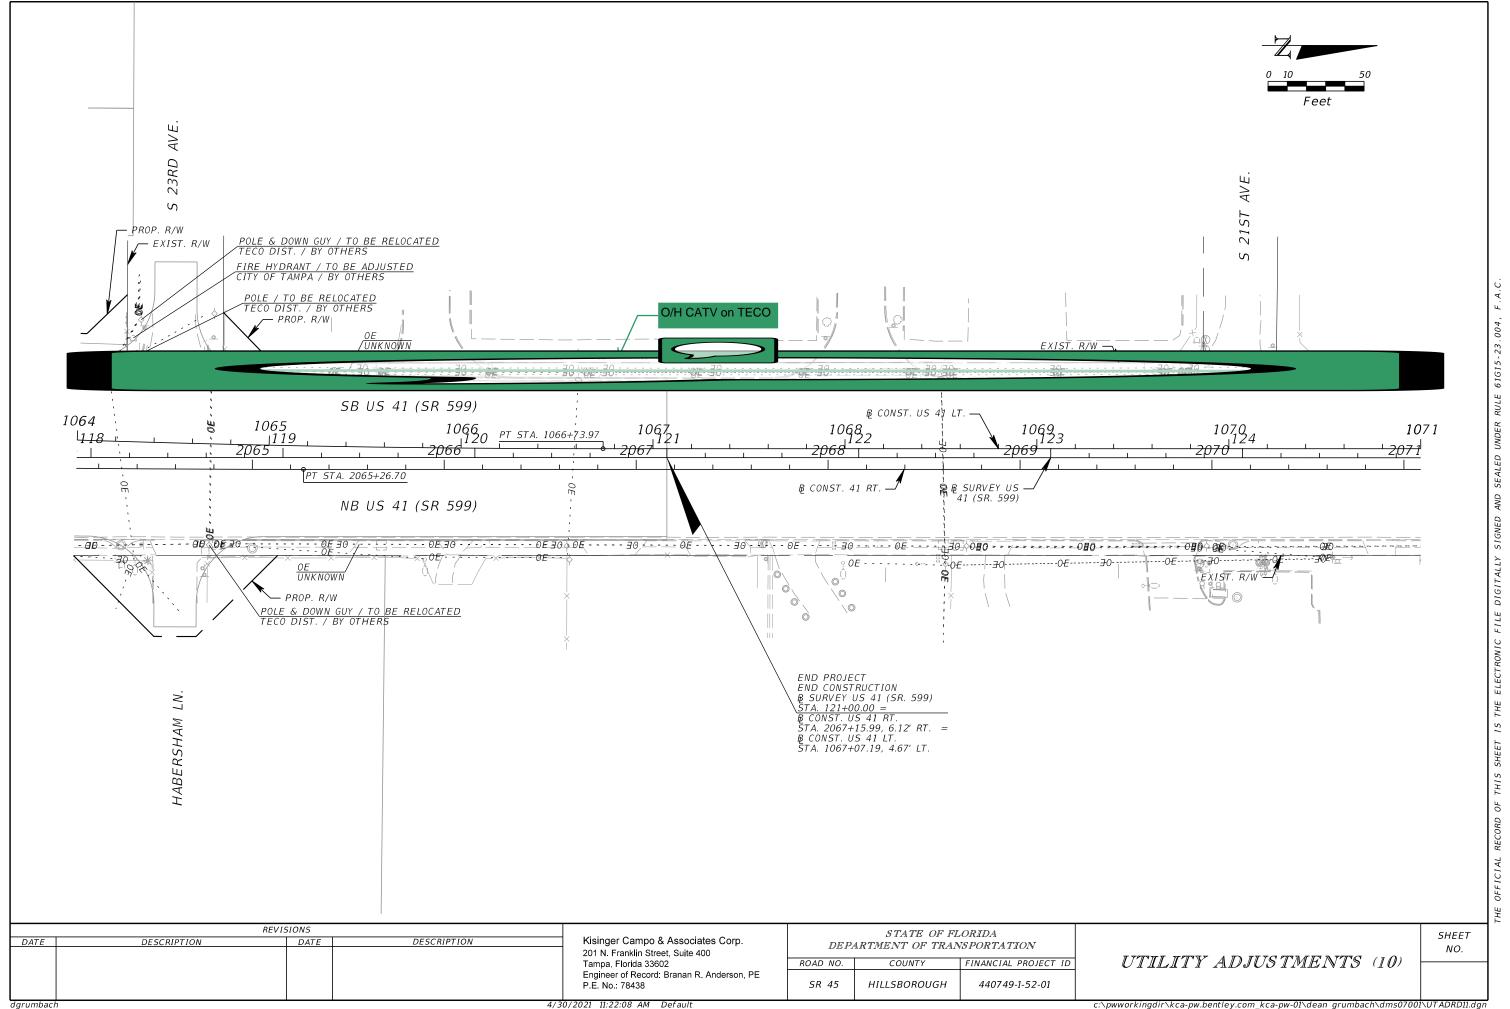

dgrumbach

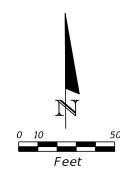

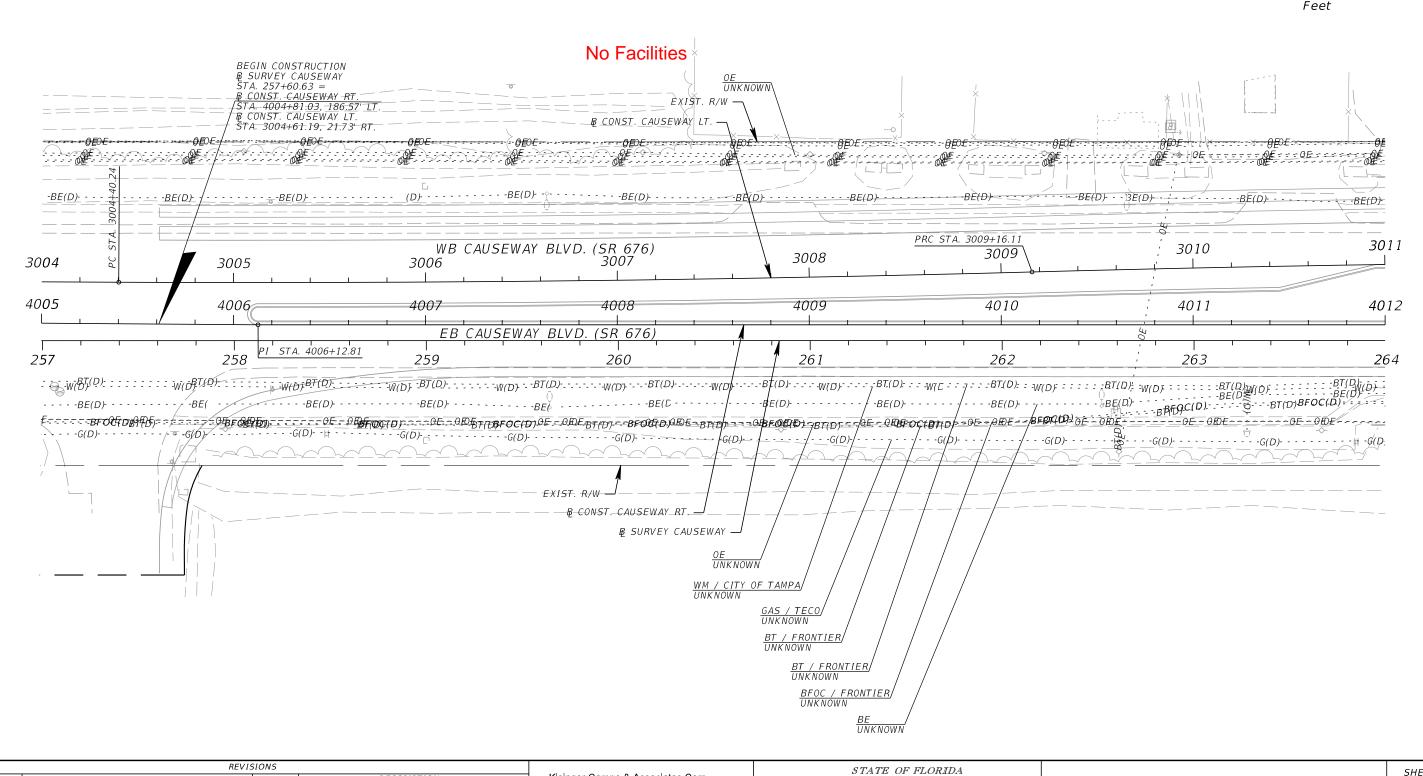

DEPARTMENT OF TRANSPORTATION

FINANCIAL PROJECT ID

440749-1-52-01

COUNTY

HILLSBOROUGH

ROAD NO.

Kisinger Campo & Associates Corp.

Engineer of Record: Branan R. Anderson, PE

201 N. Franklin Street, Suite 400

Tampa, Florida 33602

P.E. No.: 78438

UTILITY ADJUSTMENTS (11)


SHEET


DATE


DATE


DESCRIPTION


DESCRIPTION

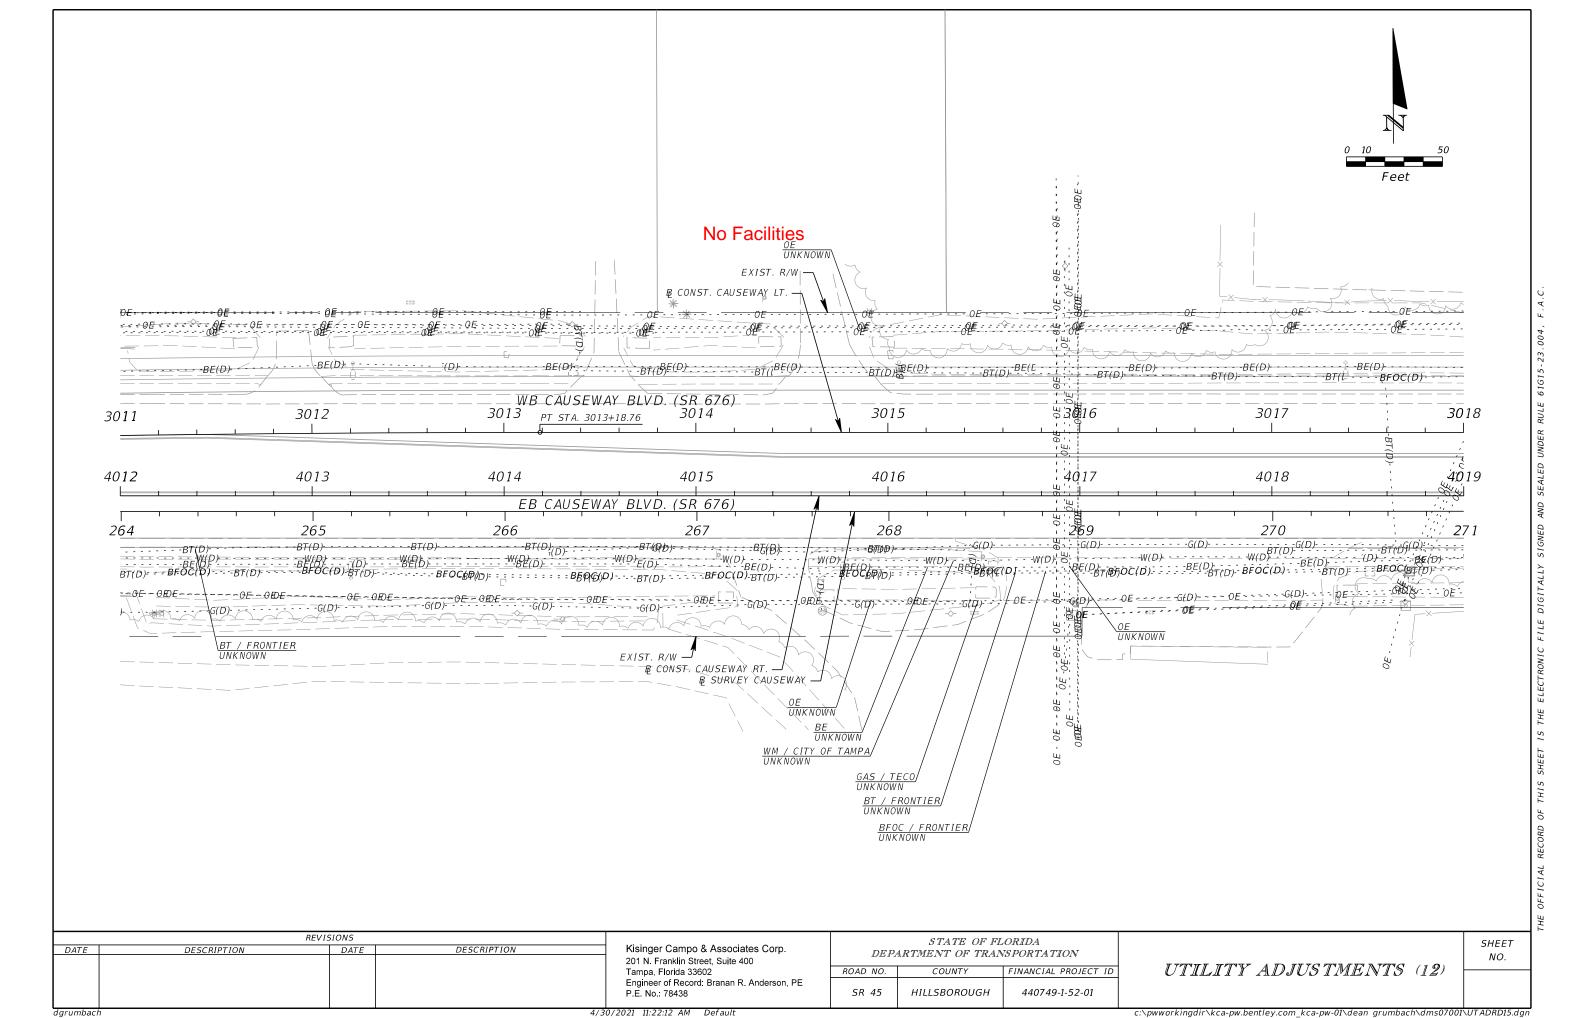


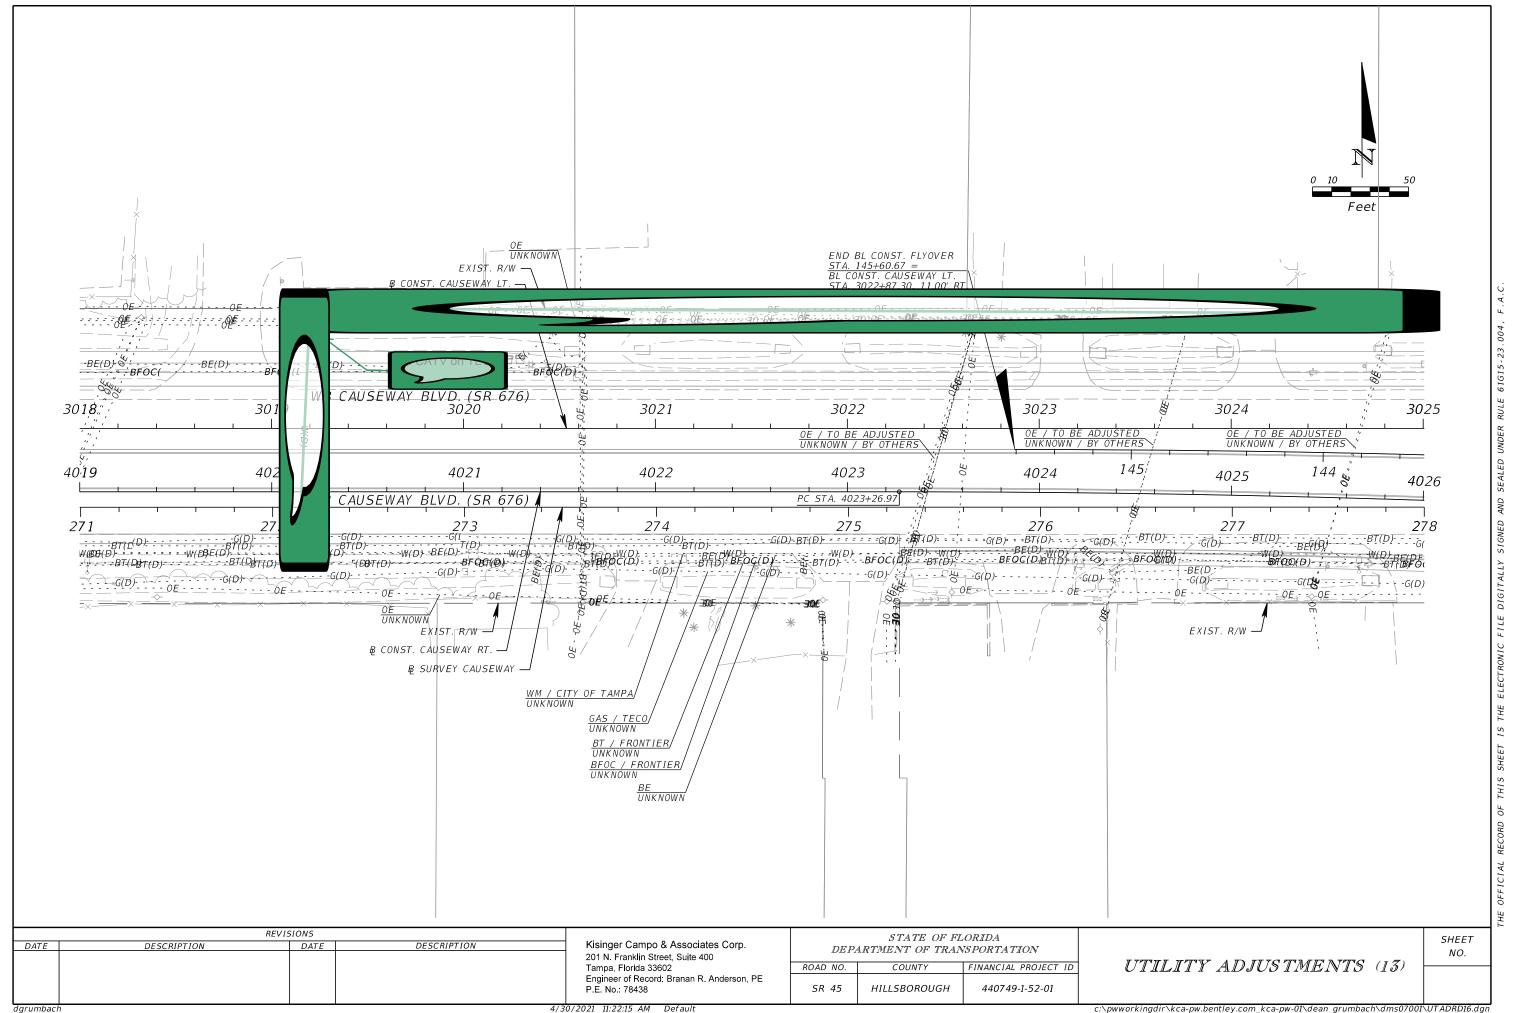


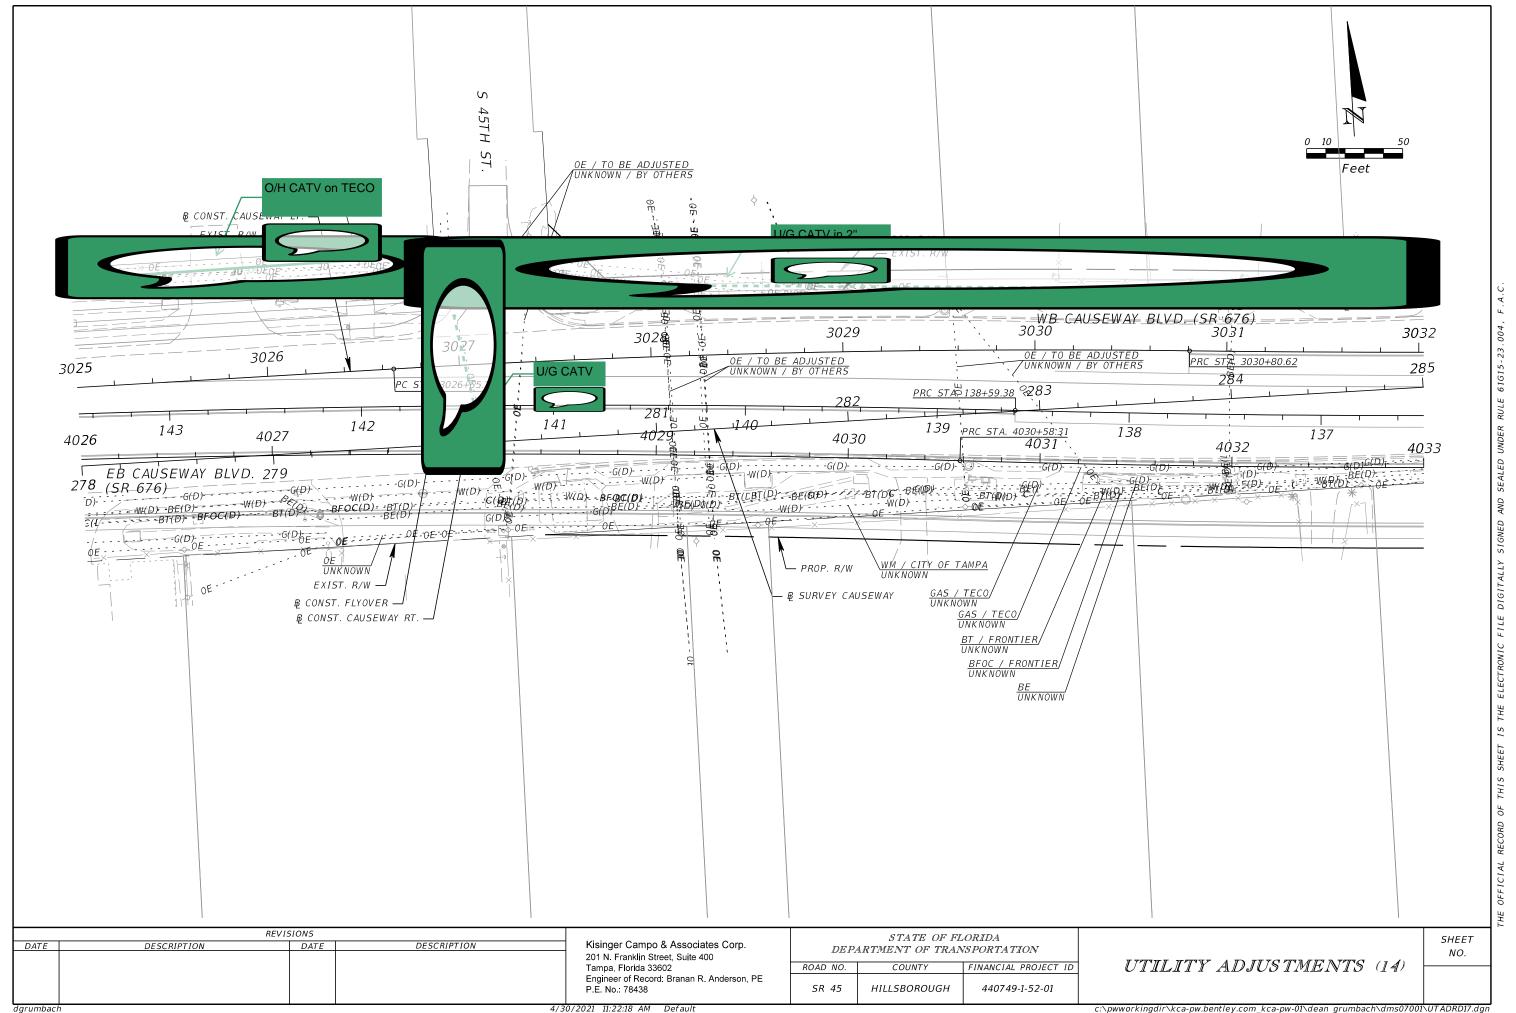

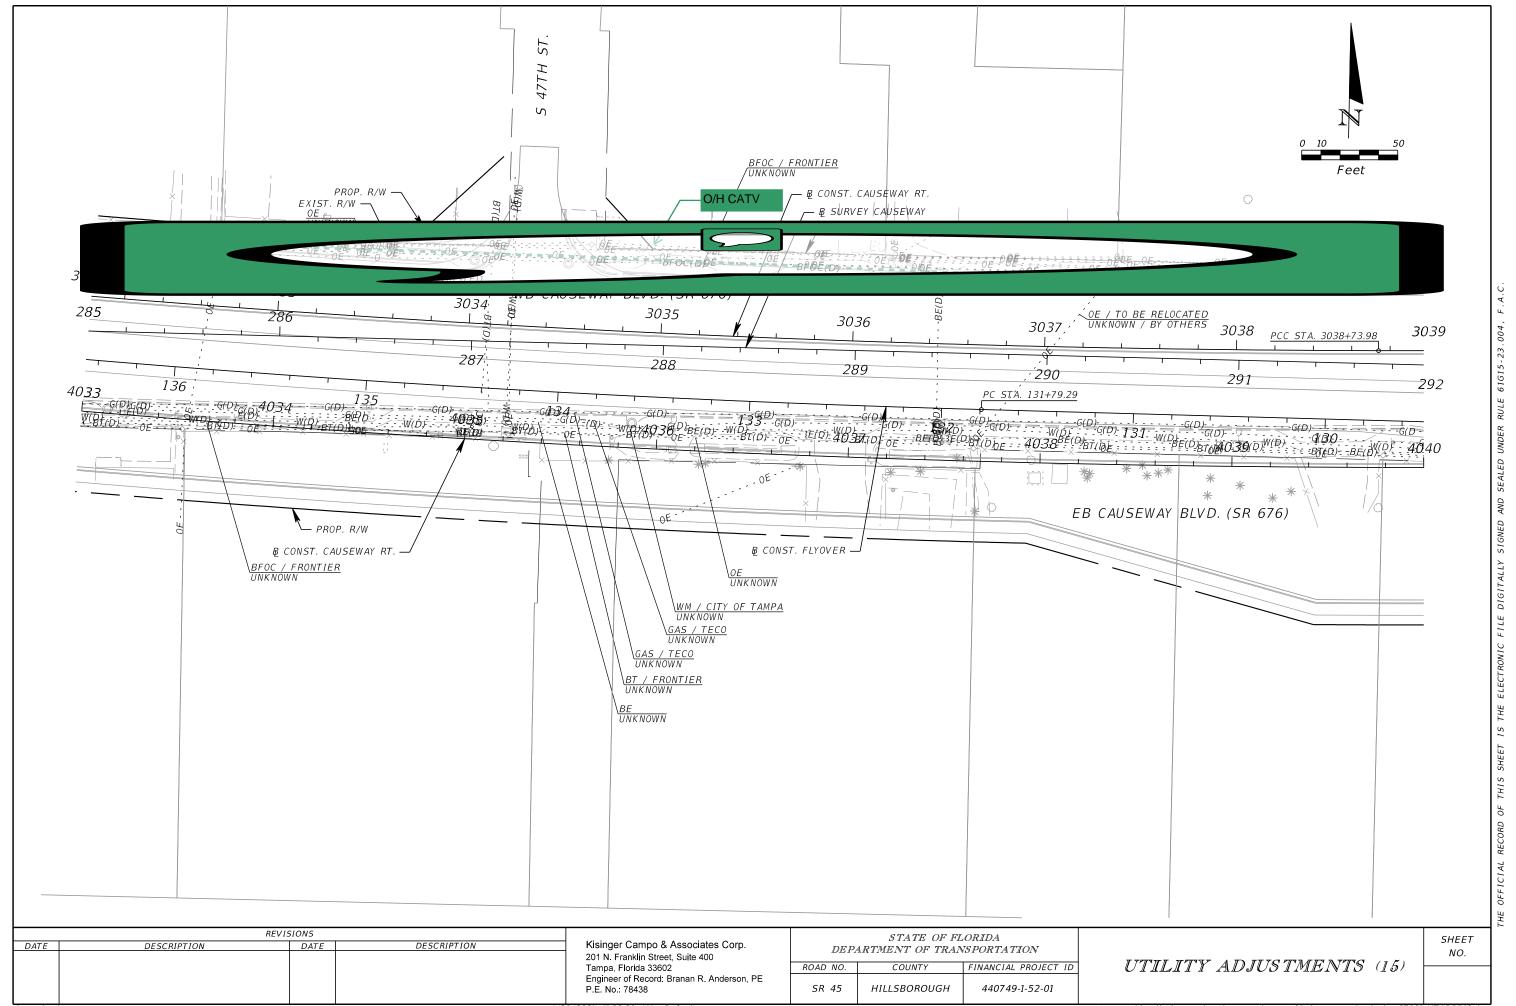

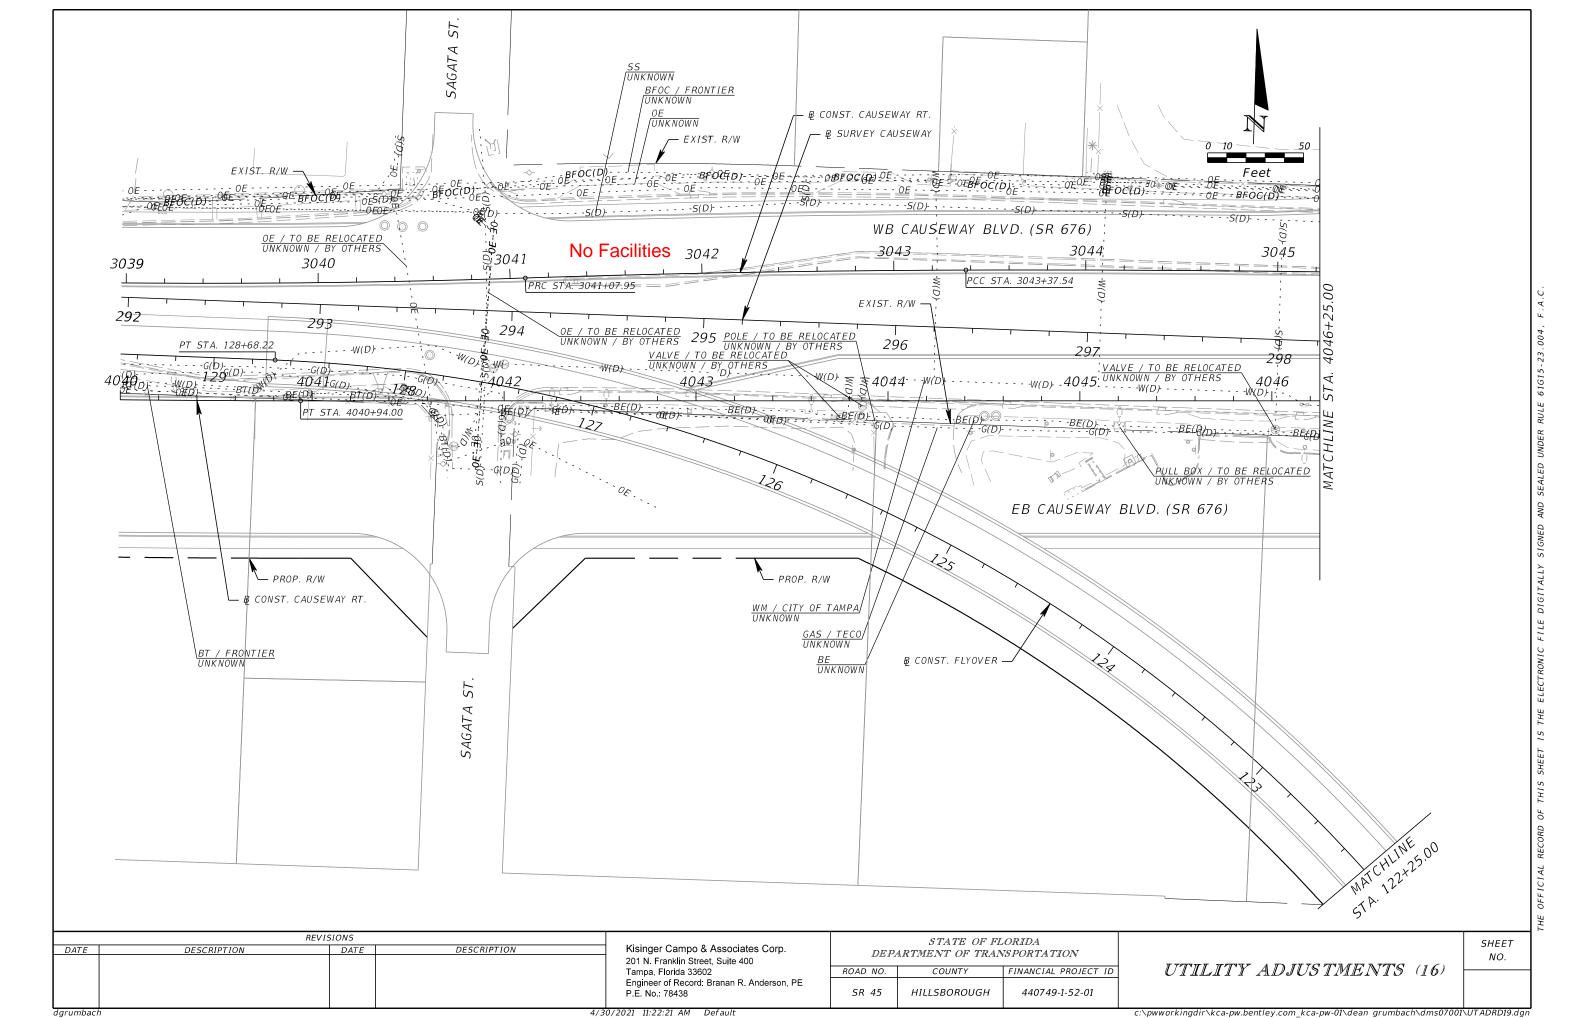

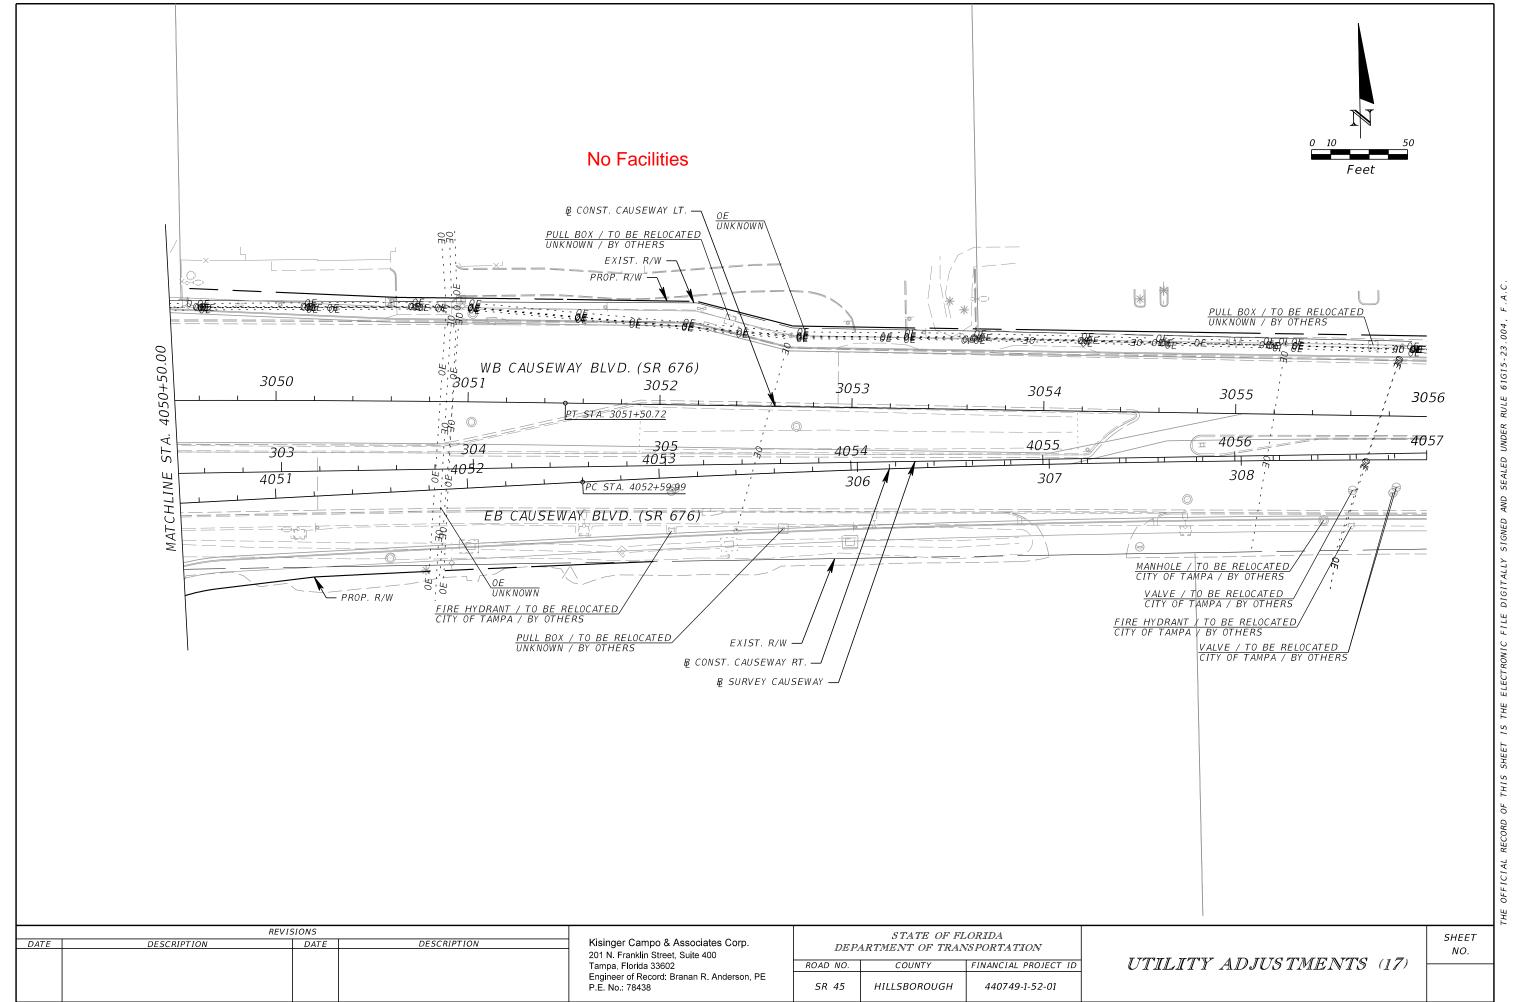

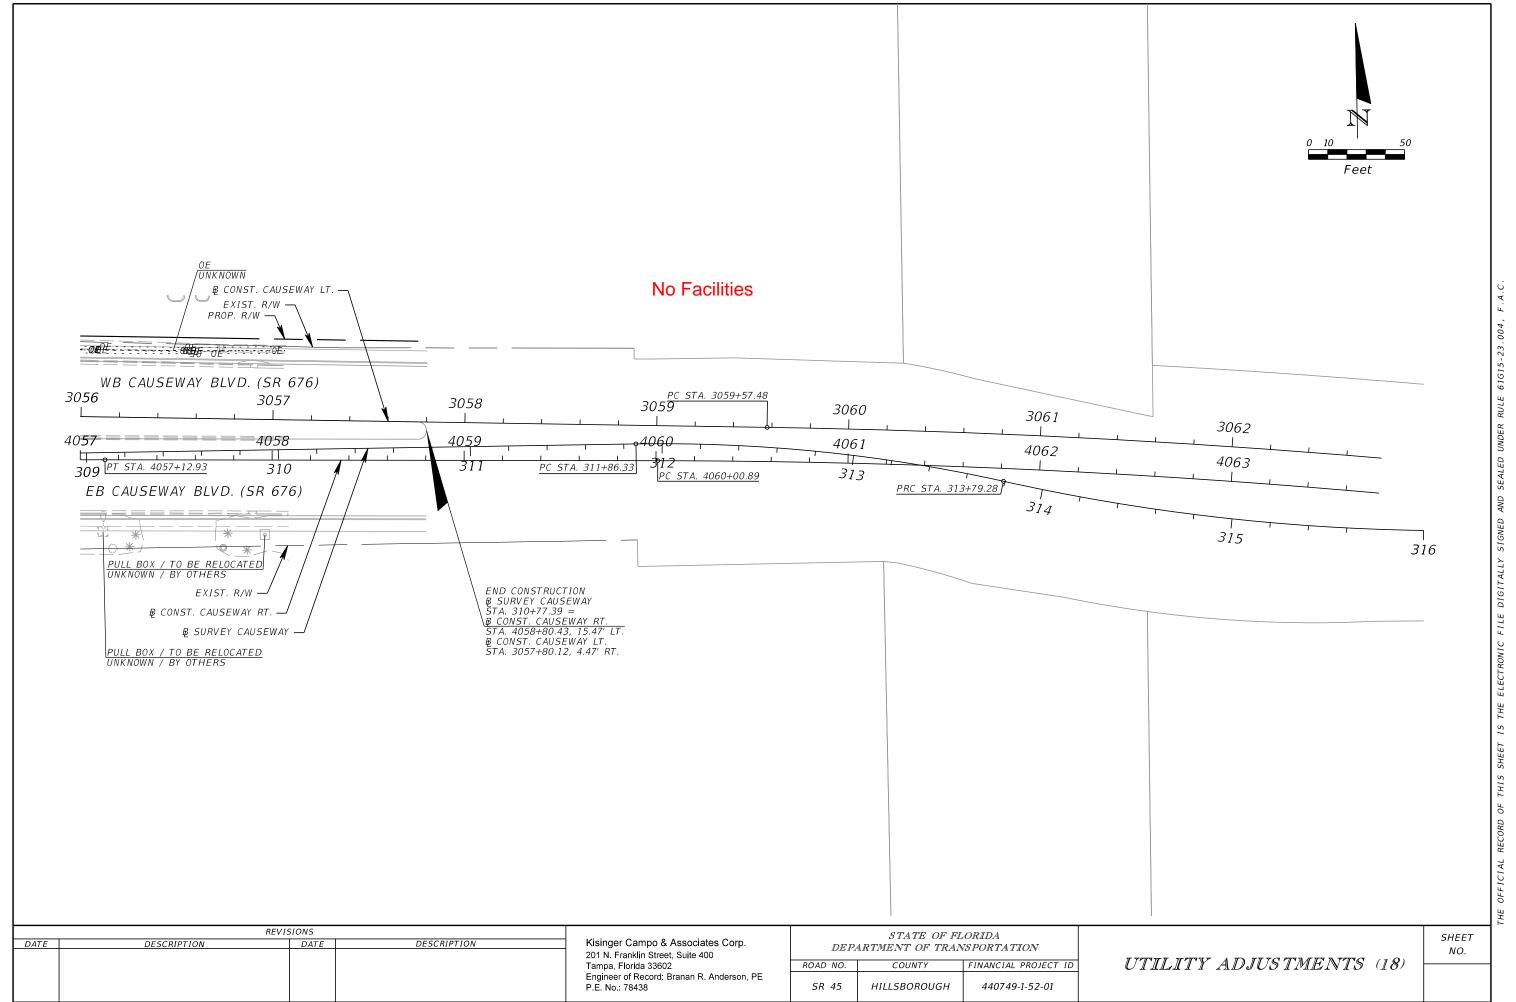

	Cre	w Memb	ers:		DW, TG						
	City	, State:		Ta	ampa, Florida						
	Ger	neral Loca	ation:		US 41						
NCE-	Coc	ordinate (Unit of Meas	ure: U	S Survey Fee						
		Abbrev	riations	Offset Measured From:							
	N/A	= Not Appl	icable	EP= Edge of Pavement							
HOLE"	NAD	= North A	merican	BC = Back of Cu	rb						
	Datu	ım		BL = Baseline of Survey							
	NAV	D = North	American	COORD = Surve	y Coordinates						
	Vert	ical Datum		CL = Centerline							
	UNK	= Unknow	m	HUB = Survey H	ub						
	COT	= City of T	ampa	RW = Right of W	/ay						
				ST = Swing Ties							
				X = "X" in Concr	ete						
	Hori	zontal:	NAD83/11								
	Vert	ical:	NAVD88	Ground	Utility						
ng		Е	asting	Elevation	Elevation						
4.90'			6413.67	7.51'	4.25'						
5.19'		526	416.74"	7.48'	4.18'						
4.95'		526	415.25'	7.48'	5.01'						
5.12'		526418.96'		7.36'	-1.44'						
1.11'	5264 5264 5264 5264		321.06'	6.85'	1.31'						
1.38'		526	417.02	6.84'	3.40'						
1.47'	Vertical: 524 524 524 524 524 524 524		6418.97	6.84'	4.42'						
0.12'		526	422.34'	6.83'	-3.23'						
0.56'		526	424.00'	6.49'	3.15'						
		_									
		Prepared L	by: EE	Date: 02/12/20	019						
		i e									

Truck No.:		l Do/Tol			ster Springs, Florida 32708 UTILITY ENGINEERING & SURVEY					- GROW, INSPIRE, M.	AKE A DIFFERENCE-	Coordinate Unit of Meas		
	U	Itility Type	e				y Material			Identif	ied By:	Abbreviations	Offset Mea	sured Fror
BE = Buried	Electrical	RW = Reclaimed Water			AC = Transite		FIBG = Fiberglass			HUB = Survey Hub		N/A = Not Applicable	EP= Edge of Pav	ement
GM = Gas M	1ain	SL = Street I	Light		CI= Cast Iron		HDPE = High	Density Polyet	thylene Pipe	IRC = Iron Rod & Cap	"ECHO TEST HOLE"	NAD = North American	BC = Back of Cu	rb
BT = Buried	Telephone	TS = Traffic	Signal		CP = Concrete f	Pipe	PE = Polyethy	ylene Pipe		NL = Nail & Disk "ECHO TEST HOLE"		Datum	BL = Baseline of Survey	
OC = Fiber	Optic Cable	FL = Fuel Lir	ne		DBC = Direct Bu	ıried Cable	PVC = Polyvir	PVC = Polyvinyl Chloride				NAVD = North American	COORD = Surve	y Coordinat
NM = Wate	r Main	GS = Gas Se	rvice		CMP = Corruga	ted Metal Pipe	STL = Steel			X = "X" in Concrete		Vertical Datum	CL = Centerline	
SAN = Sanita	ary Sewer	WS = Water	r Service		CONC = Concre	te	VCP = Vitrifie	d Clay Pipe		Surfac	е Туре	UNK = Unknown	HUB = Survey H	ub
STM = Storn	n Sewer	UNK = Unkr	nown Utility		CPP = Corrugat	ed Plastic Pipe	PCCP = Prest	ressed Cylinde	r Concrete	ASPH = Asphalt		COT = City of Tampa	RW = Right of V	/ay
CATV = Cabl	le Television	BED = Burie	d Electrical C	Duct	DCT = Duct		Pipe			CONC = Concrete			ST = Swing Ties	
FM = Force I	Main	BTD = Burie	d Telephone	Duct	DIP = Ductile Ire	on Pipe	RCP = Reinfo	rced Concrete	Pipe	NG = Natural Groun	d		X = "X" in Concr	ete
Test Hole	Utility Type	Utility Material	Utility Size Outside Diameter	Utility Manual Depth	Cross Sectional View	***	Identified By	Surface Type	Surface Thickness inches	Apparent Utility Owner	Datums: Northing	Horizontal: NAD83/11 Vertical: NAVD88	Ground Elevation	Utility Elevati
			inches	feet		Utility Direction			IIICIICS		Northing	Easting		
1-1	вт	PVC	2 - 4"	3.26'	00	<u></u>	IRC	NG	N/A	FRONTIER	1301204.90'	526413.67	7.51'	4.25'
1-2	WM	CI	6"	3.30'		<u></u>	IRC	NG	N/A	сот	1301205.19	526416.74'	7.48'	4.18'
1-3	FOC/BT	PVC	4"	2.47'	\circ		IRC	NG	N/A	FRONTIER	1301204.95'	526415.25'	7.48'	5.01'
1-4	FOC	PE	12 - 1.5"	8.80'	08888c	<u></u>	IRC	NG	N/A	FRONTIER	1301205.12'	526418.96'	7.36'	-1.44
1-5	CATV	PVC	2 - 2"	5.54'	00	\$	IRC	NG	N/A	SPECTRUM	1301181.11'	526321.06'	6.85'	1.31
1-6	вт	PVC	2 - 4"	3.44'		‡	IRC	NG	N/A	FRONTIER	1301811.38'	526417.02'	6.84'	3.40'
1-7	FOC/BT	PVC	4"	2.42'			IRC	NG	N/A	FRONTIER	1301811.47	526418.97"	6.84'	4.42'
1-8	WM	UNK	UNK	10.06'		\$	IRC	NG	N/A	сот	1301810.12'	526422.34'	6.83'	-3.23
1-9	FOC/BT	PVC	4"	3.34'	0	‡	IRC	NG	N/A	FRONTIER	1301810.56'	526424.00'	6.49'	3.15
Notes:	1-8 - Unable	to visually ve	erify size and	matterial du	ue to depth and	groundwater. Possi	ble 6" cast iro	n.				Prengred by: EE	Date: 02/12/2	019
												Prepared by: EE	Date: 02/12/20	
												Checked by: AB	Date: 02/12/	2019
	REVISION	5								Q et a et es	OF FLORIDA			

Test Hole Data Report

ECHO UES, Inc. www.echoues.com

888.778.ECHO

SHEET

4/30/2021 11:22:27 AM Default

Tampa, Florida 33602
Engineer of Record: Branan R. Anderson, PE
P.E. No.: 78438

ROAD NO.

SR 45

COUNTY

HILLSBOROUGH

FINANCIAL PROJECT ID

440749-1-52-01

UTILITY ADJUSTMENTS (19)

Date:

dgrumbach

ECHO Project #:

Financial Project #:

12/04/2018

18-252

N/A

16514 N. Dale Mabry Hwy.

Tampa, Florida 33618

1511 E. SR434, Ste. 2001, #252

Date:		12	2/05/2018				Test Hol	e Data Repo	ort			Crew Members:		DW, TG	
ECHO Pro	iect #:		18-252		5514 N. Dale Ma	ibry Hwy.				ECHO U	ES, Inc.	City, State: Tampa, Florid			
Financial I			N/A		Tampa, Florida	33618	≫F	CH		www.ech	oues.com	General Location:			
			D-3/T-2		l E. SR434, Ste.					888.778				US 41	
Truck No.				Win	ter Springs, Flo	1100 32700		INEERING &	SURVEY	- GROW, INSPIRE, MA		Coordinate Unit of Meas		S Survey Feet	
		Itility Type				Utilit	y Material	-		Identifi	ied By:	Abbreviations		sured From:	
BE = Buried		RW = Reclai			AC = Transite		FIBG = Fiberg			HUB = Survey Hub		N/A = Not Applicable	EP= Edge of Pav		
GM = Gas N		SL = Street I	-		CI= Cast Iron				hylene Pipe	IRC = Iron Rod & Cap		=	BC = Back of Cu		
BT = Buried	-	TS = Traffic			CP = Concrete P DBC = Direct Bu		PE = Polyethy			NL = Nail & Disk "ECH SLEEVE = Sleeve	HO TEST HOLE"	NAVD = North American	BL = Baseline of	·	
FOC = Fiber WM = Wate	<u>'</u>	FL = Fuel Lir GS = Gas Se			CMP = Corrugat		PVC = Polyvir STL = Steel	iyi Chioride		X = "X" in Concrete		Vertical Datum	COORD = Surve CL = Centerline	y Coordinates	
SAN = Sanita		WS = Water			CONC = Concret		VCP = Vitrifie	d Clay Pino		Surface	a Type	UNK = Unknown	HUB = Survey H	ub	
STM = Storn	-		nown Utility		CPP = Corrugate				r Constata	ASPH = Asphalt	етуре	COT = City of Tampa	RW = Right of W		
CATV = Cabl			d Electrical D	ouct	DCT = Duct	eu riasuc ripe	Pipe Prest	ressed Cylinde	r concrete	CONC = Concrete		COT - City of Tallipa	ST = Swing Ties		
FM = Force			d Telephone		DIP = Ductile Iro	n Pine	_	rced Concrete	Pine	NG = Natural Ground	1		X = "X" in Concr		
1101 - 10106	Vidili	DTD - Darie	Utility Size	Utility	Dir - Dacdie ire	N N	Nor - Kellilo	rcea concrete		NG - Natural Ground	<u>'</u>	Horizontal: NAD83/11	X = X III coller		
Test Hole	Utility Type	Utility	Outside	Manual	Cross	-	Identified Bu	Surface Type	Surface Thickness	Apparent Utility	Datums:	Vertical: NAVD88	Ground	Utility	
rest note	Othicy Type	Material	Diameter	Depth	Sectional View	▼	identified by	Surface Type	inches	Owner	Northing	Easting	Elevation	Elevation	
			inches	feet		Utility Direction				Northing		Lusting			
1-10	FOC	PE	12 - 1.5"	3.96'		Ţ	IRC	NG	N/A	FRONTIER	1302430.03'	526421.52"	6.62'	2.66'	
1-11	ВТ	PVC	2 - 4"	2.50'	00	_	IRC	NG	N/A	FRONTIER	1302430.50'	526424.77"	6.68'	4.18'	
1-12	FOC/BT	PVC	4"	1.90'	\circ		IRC	NG	N/A	FRONTIER	1302430.47	526425.15'	6.69'	4.79'	
1-13	ВТ	DBC	2"	1.56'	0	\(\bar{1}\)	IRC	NG	N/A	FRONTIER	1302430.15'	526428.11'	6.81'	5.25'	
1-14	WM	DIP	6"	3.40'		1	IRC	NG	N/A	СОТ	1302428.62'	526446.38"	8.20'	4.80'	
1-15	GM	STL	4"	3.00'	\circ	\$	IRC	NG	N/A	сот	1302488.18'	526318.06'	6.08'	3.08'	
1-16	ВТ	PVC	4"	3.50'	\circ		IRC	NG	N/A	FRONTIER	1301205.22'	526417.96	7.50'	4.00'	
1-17	вт	DBC	2"	3.00'	0	‡	IRC	NG	N/A	FRONTIER	1301810.09'	526422.72'	6.80'	3.80'	
Notes:															
												Prepared by: EE	Date: 02/12/20	019	
												Checked by: AB	Date: 02/12/	2019	

DEPARTMENT OF TRANSPORTATION FINANCIAL PROJECT ID 440749-1-52-01

STATE OF FLORIDA

COUNTY

HILLSBOROUGH

ROAD NO.

SR 45

UTILITY ADJUSTMENTS (20)

SHEET NO.

DATE

REVISIONS

DATE

DESCRIPTION

DESCRIPTION

Kisinger Campo & Associates Corp. 201 N. Franklin Street, Suite 400

Tampa, Florida 33602
Engineer of Record: Branan R. Anderson, PE
P.E. No.: 78438

Date:		12	2/06/2018	Test Hole Data Report Cre								Crew Members: DW, To		
ECHO Proj	ject #:		18-252	16	5514 N. Dale Ma	abry Hwy.	FOLIO LICE Inc.				City, State: Tampa, FI			
Financial F	•	Towns Florida 23619				www.ech		General Location:		US 41				
Truck No.:			D-3/T-2		L E. SR434, Ste.					888.778 - GROW, INSPIRE, M		Coordinate Unit of Meas	uro:	S Survey Feet
TTUCK NO		IATIDA - Trans	,	Win	ter Springs, Flo	nida SE700		INEERING &	SURVET					· ·
DE D 41.41		Itility Type			A.C. Turning	Utilit	y Material	l		Identif	iea By:	Abbreviations		sured From:
BE = Buried I		RW = Reclai			AC = Transite		FIBG = Fiberg		hulana Bina	HUB = Survey Hub	PECHO TEST HOLE!	N/A = Not Applicable NAD = North American	EP= Edge of Pay	
GM = Gas M BT = Buried		SL = Street TS = Traffic	ŭ		CI= Cast Iron CP = Concrete P	lino	PE = Polyethy		nylene Pipe	IRC = Iron Rod & Cap NL = Nail & Disk "ECI		Datum	BC = Back of Cu BL = Baseline of	
FOC = Fiber		FL = Fuel Lir			DBC = Direct Bu		PVC = Polyetny			SLEEVE = Sleeve	HO TEST HOLE	NAVD = North American	COORD = Surve	,
WM = Water		GS = Gas Se			CMP = Corrugat		STL = Steel	iyi cilionde		X = "X" in Concrete		Vertical Datum	CL = Centerline	
SAN = Sanita		WS = Water			CONC = Concre		VCP = Vitrifie	d Clay Pino		Surfac	a Tuna	UNK = Unknown	HUB = Survey H	
STM = Storm	•	UNK = Unkr			CPP = Corrugate		1		v Consusta	ASPH = Asphalt	етуре	COT = City of Tampa	RW = Right of V	
CATV = Cable			d Electrical D	huct	DCT = Duct	eu riasuc ripe	Pipe Prest	ressed Cylinde	r Concrete	CONC = Concrete		COT - City of Tampa	ST = Swing Ties	
FM = Force N			d Telephone		DIP = Ductile Iro	n Pine		rced Concrete	Pine	NG = Natural Ground	4		X = "X" in Conci	
rivi – roice	viaiii	BTB - Burie	Utility Size	Utility	DIF - Ductile II C	N N	KCF - Kellilo	rcea concrete		NG - Natural Ground		Horizontal: NAD83/11	X = X III conci	
Took Upla	I IAIlian Tono	Utility	Outside	Manual	Cross	*	uda asida ad no.	Confess Tons	Surface	Apparent Utility	Datums:	Vertical: NAVD88	Ground	Utility
lest Hole	Utility Type	Material	Diameter	Depth	Sectional View	▼	Identified By	Surface Type	Thickness inches	Owner	Northina		Elevation	Elevation
			inches	feet		Utility Direction			inches		Northing	Easting		
1-18	вт	PVC	2 - 4"	3.82'	00		IRC	NG	N/A	FRONTIER	1303091.15'	526425.13'	7.04'	3.22'
1-19	FOC/BT	PVC	4"	2.54'			IRC	NG	N/A	FRONTIER	1303091.17	526425.73"	6.99'	4.45'
1-20	вт	LEAD	2 - 2"	3.00'	00	\^	IRC	NG	N/A	FRONTIER	1303091.09'	526427.92'	6.86'	3.86'
1-21	FOC	UNK	12 - 1.5"	9.22'	888888	‡	IRC	NG	N/A	FRONTIER	1303091.01	526430.76'	6.58'	-2.64'
1-22	вт	LEAD	2 - 2"	2.00'	00		IRC	NG	N/A	FRONTIER	1303695.15'	526432.46'	6.77'	4.77'
1-23	вт	PVC	2 - 4"	2.76'	00		IRC	NG	N/A	FRONTIER	1303695.20'	526433.46'	6.70'	3.94'
1-24	ВТ	LEAD	2 - 2"	2.74'	00	‡	IRC	NG	N/A	FRONTIER	1304500.45	526435.53'	7.28'	4.54'
Notes:	1-21 - Unable	e to visually v	erify size and	d material du	ue to depth and g	groundwater. Possil	bly 12 - 1.5" p	olyethylene pi	pes.					
												Prepared by: EE	Date: 02/12/2	019
												Checked by: AB	Date: 02/12/	2019

REVISIONS DESCRIPTION DESCRIPTION DATE

Kisinger Campo & Associates Corp. 201 N. Franklin Street, Suite 400 Tampa, Florida 33602 Engineer of Record: Branan R. Anderson, PE P.E. No.: 78438

STATE OF FLORIDA DEPARTMENT OF TRANSPORTATION ROAD NO. COUNTY FINANCIAL PROJECT ID SR 45 HILLSBOROUGH 440749-1-52-01

UTILITY ADJUSTMENTS (21)

SHEET NO.


STATE OF FLORIDA DEPARTMENT OF TRANSPORTATION


CONTRACT PLANS

FINANCIAL PROJECT ID 440749-1-52-01

(FEDERAL FUNDS)

HILLSBOROUGH COUNTY (10002)

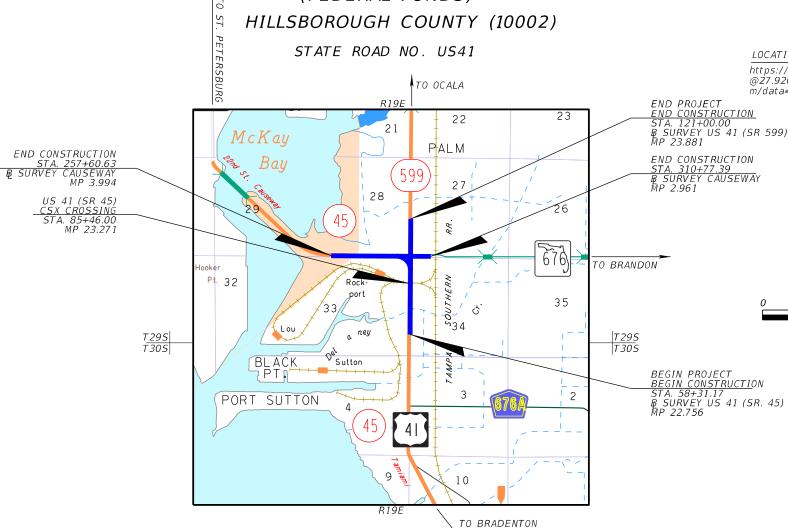

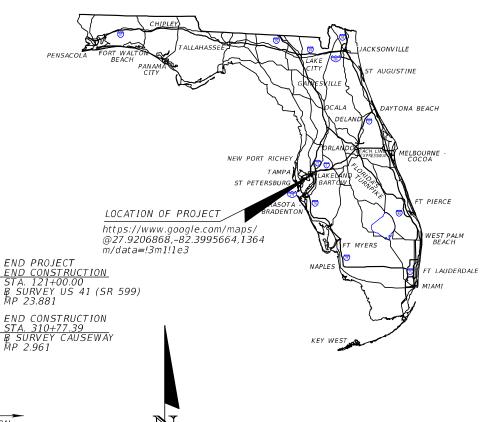

ROADWAY PLANS ENGINEER OF RECORD:

BRANAN R. ANDERSON, P.E. NO.: 78438 KISINGER CAMPO AND ASSOCIATES CORP. CONSULTING ENGINEERS & PLANNERS 201 N. FRANKLIN STREET, SUITE 400 TAMPA, FLORIDA 33602 (813) 871-5331 VENDOR NUMBER.: F59-1677145

FDOT PROJECT MANAGER:

TIM O'BRIEN P.E.

CONSTRUCTION	FISCAL	SHEET
CONTRACT NO.	YEAR	NO.
TBD	21	1

GOVERNING STANDARD PLANS:

Florida Department of Transportation, FY2021-22 Standard Plans for Road and Bridge Construction and applicable Interim Revisions (IRs).

Standard Plans for Road Construction and associated IRs are available at the following website: http://www.fdot.gov/design/standardplans

APPLICABLE IRs: N/A

Standard Plans for Bridge Construction are included in the Structures Plans Component


GOVERNING STANDARD SPECIFICATIONS:


Florida Department of Transportation, July 2022 Standard Specifications for Road and Bridge Construction at the following website: http://www.fdot.gov/programmanagement/Implemented/SpecBooks





FRONTIER COMMUNICATIONS 3712 W WALNUT ST TAMPA FL 33607


dgrumbach 4/13/2021 2:47:16 PM Default

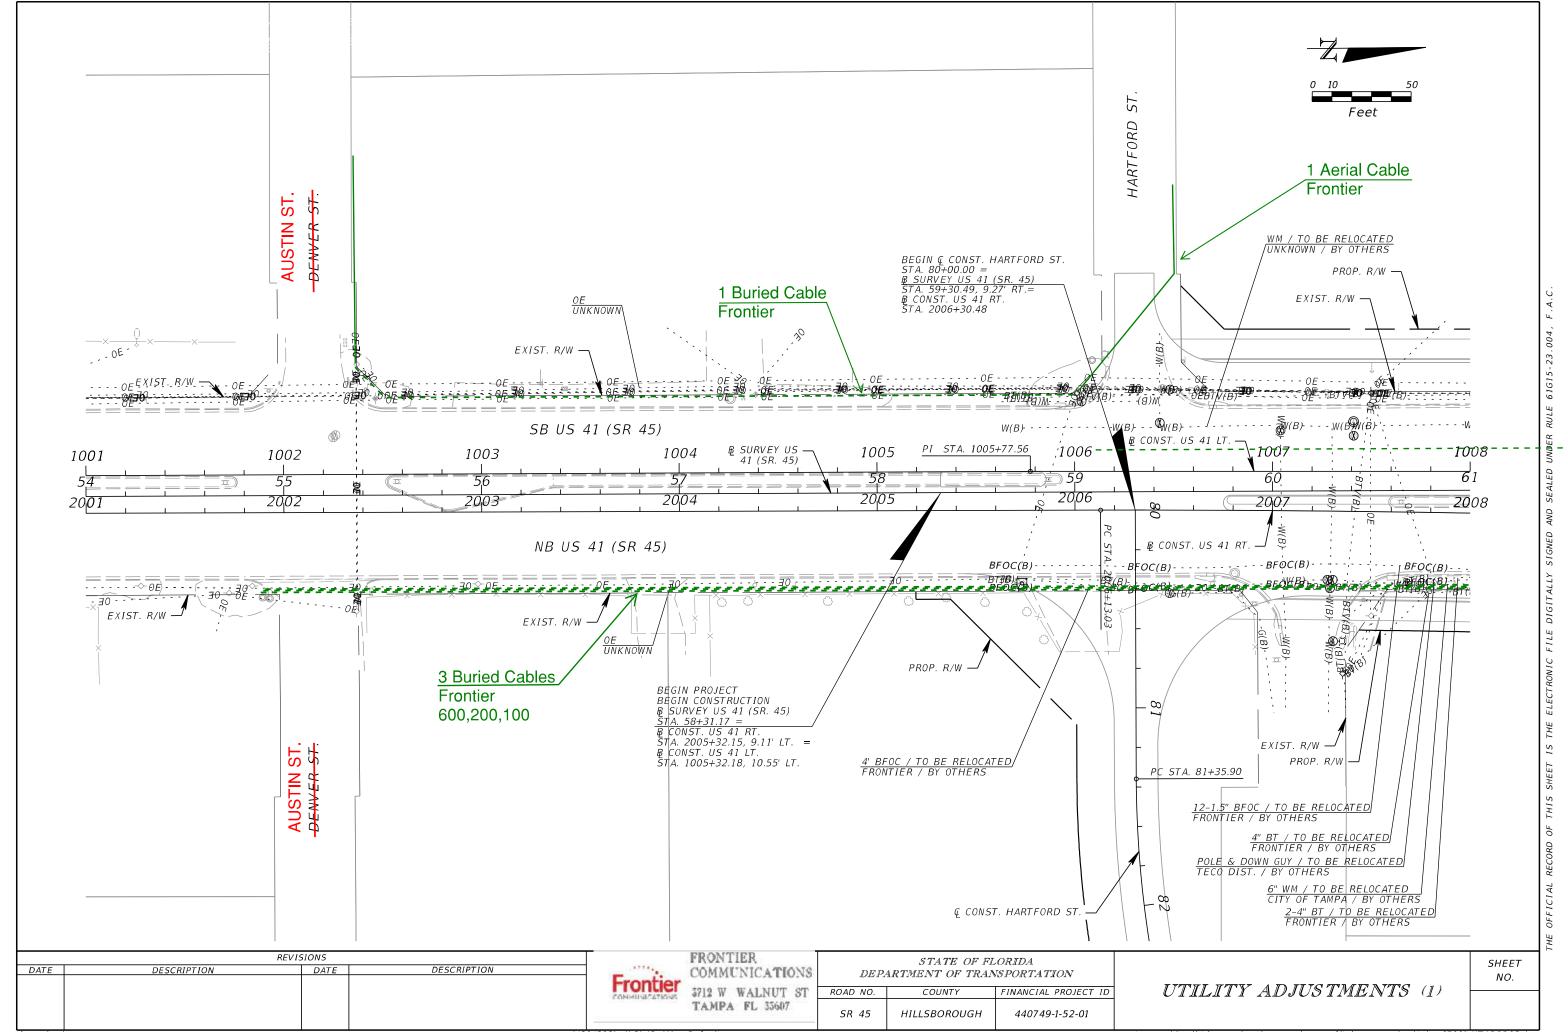


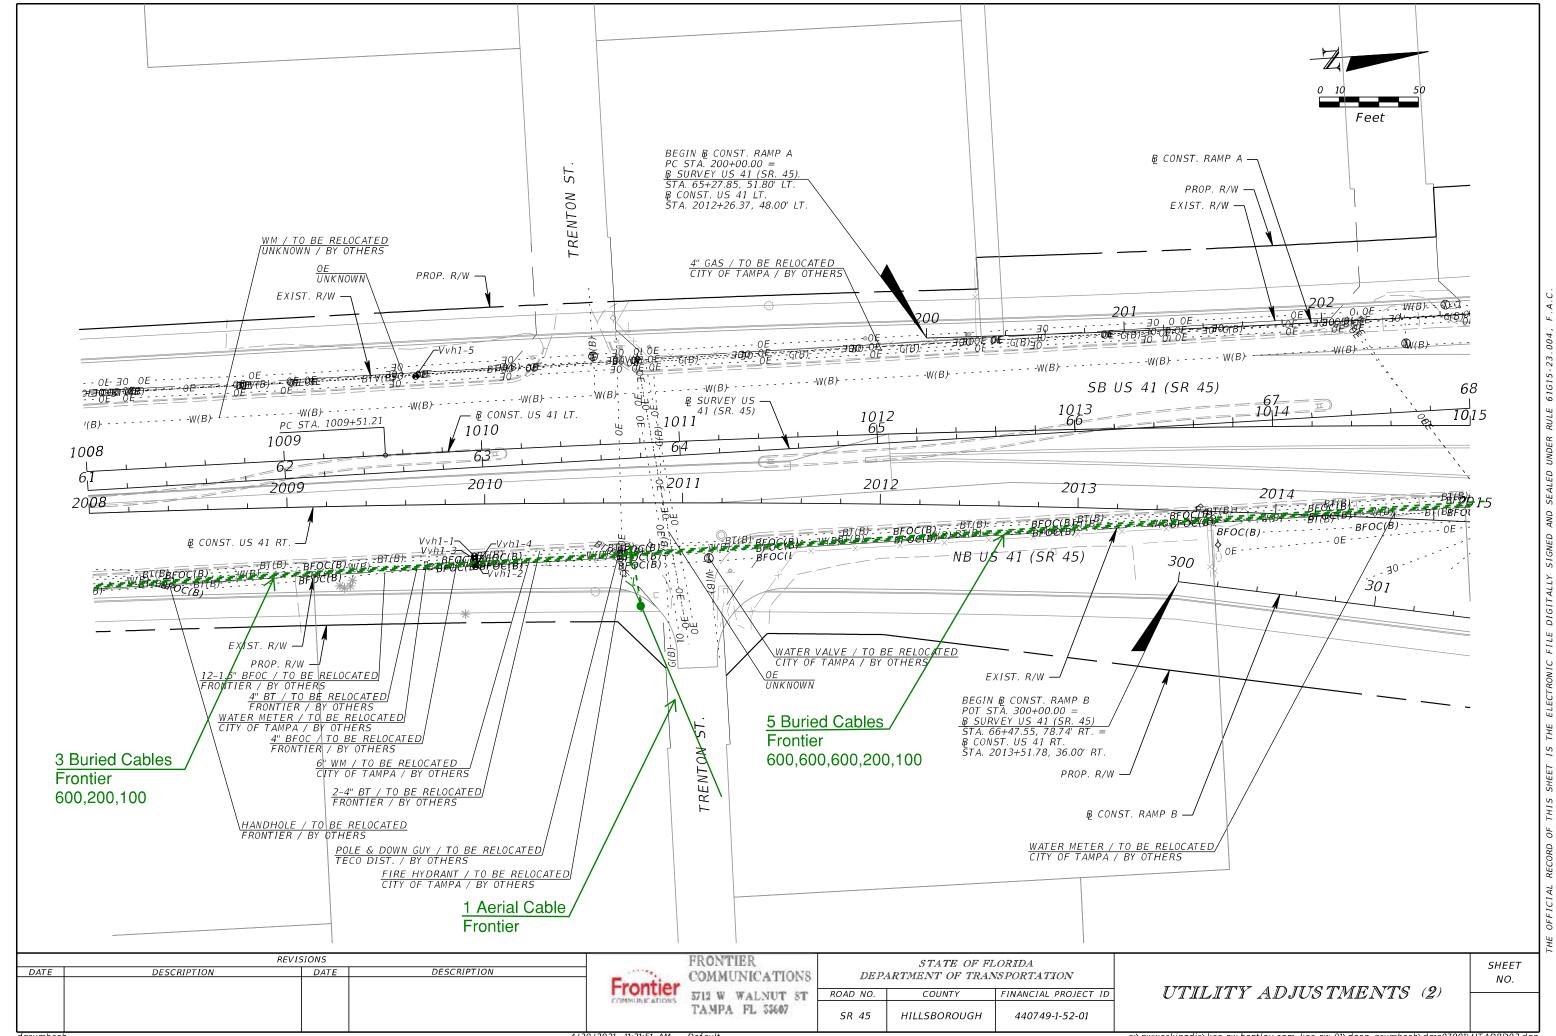


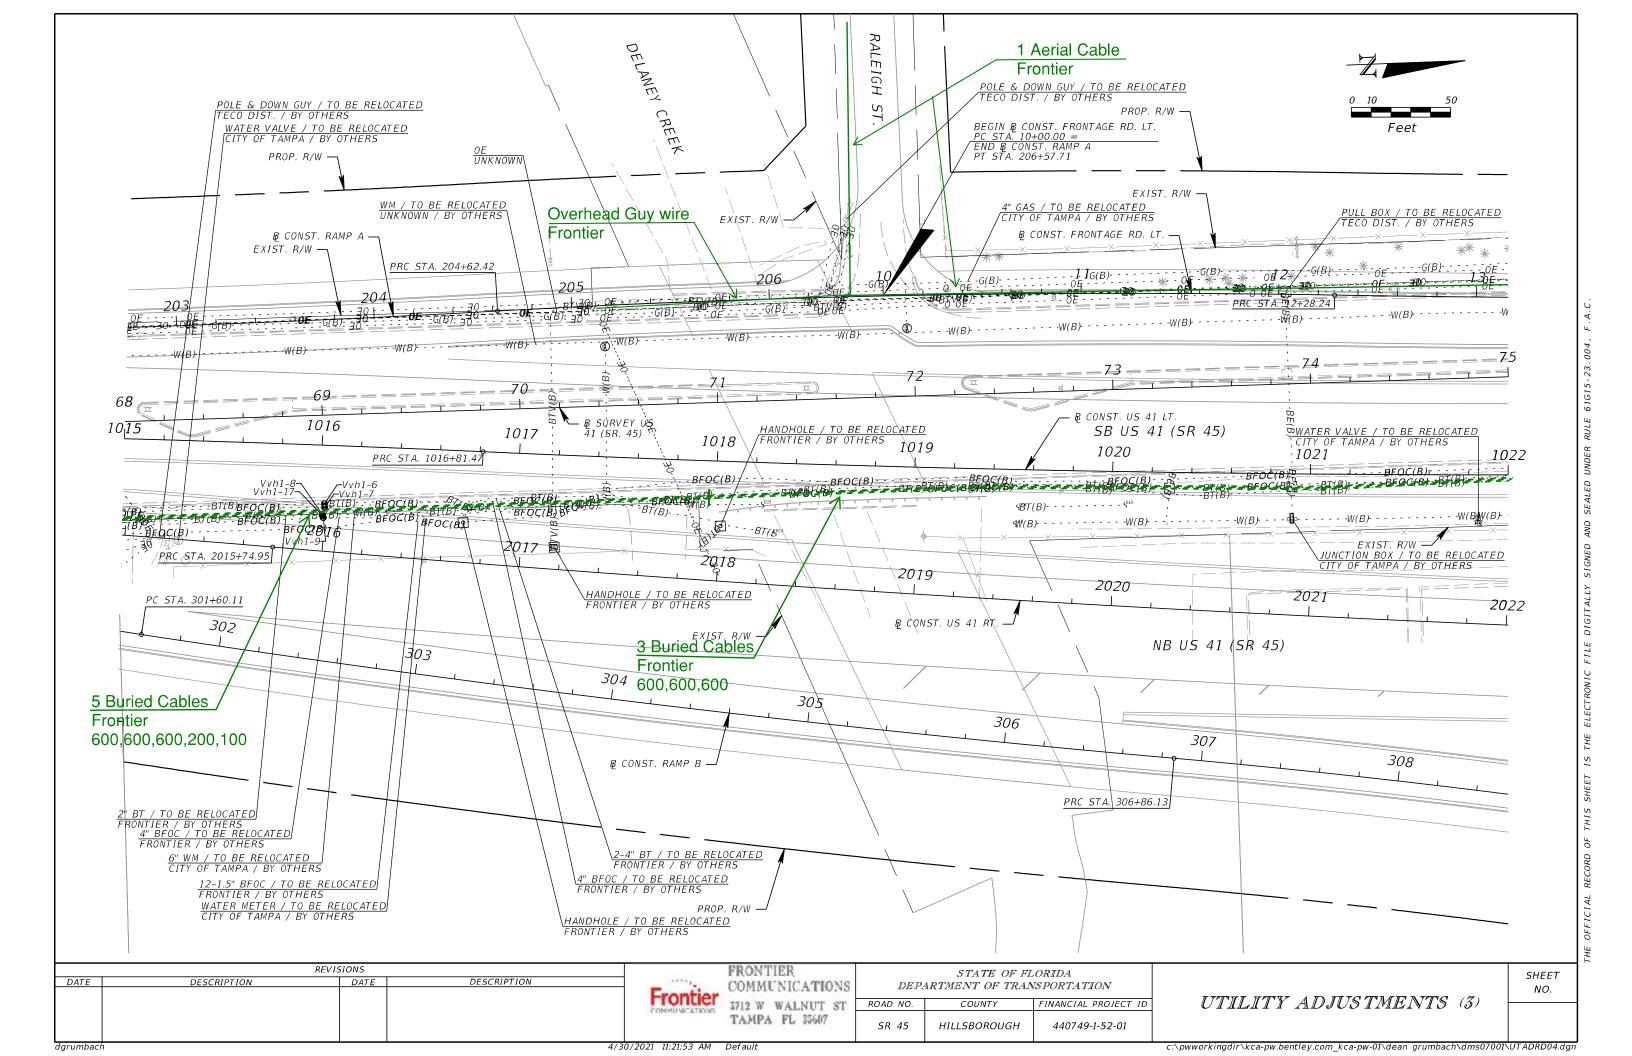


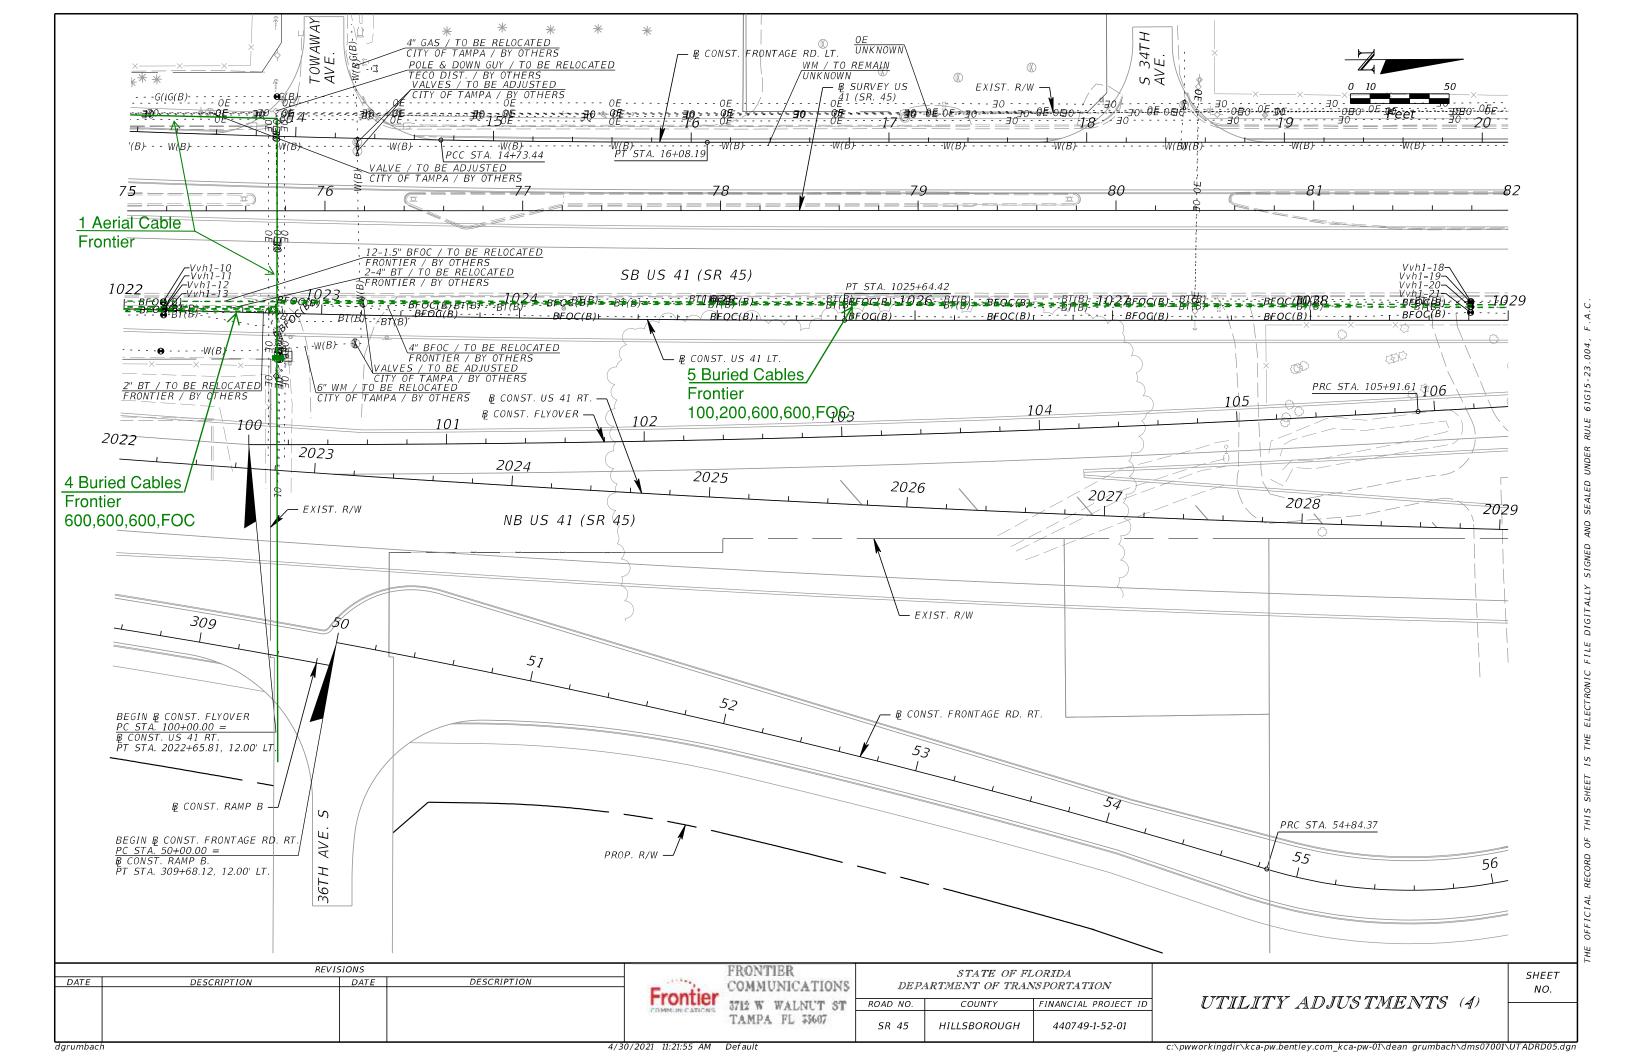


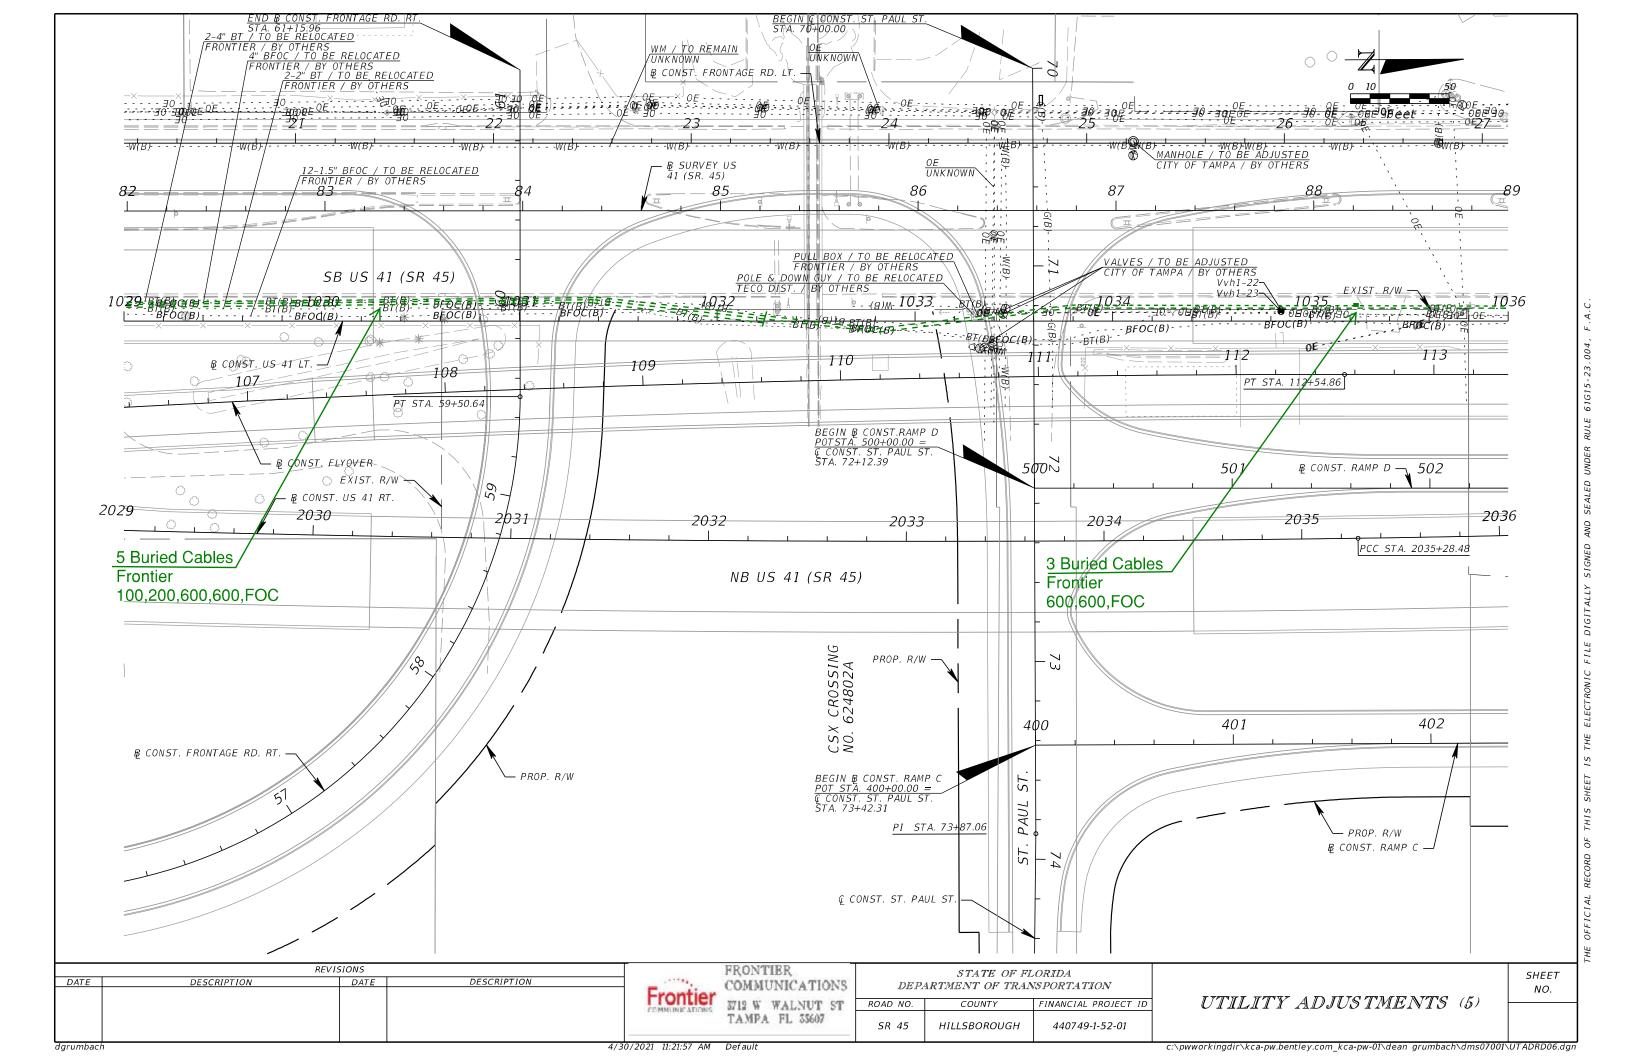


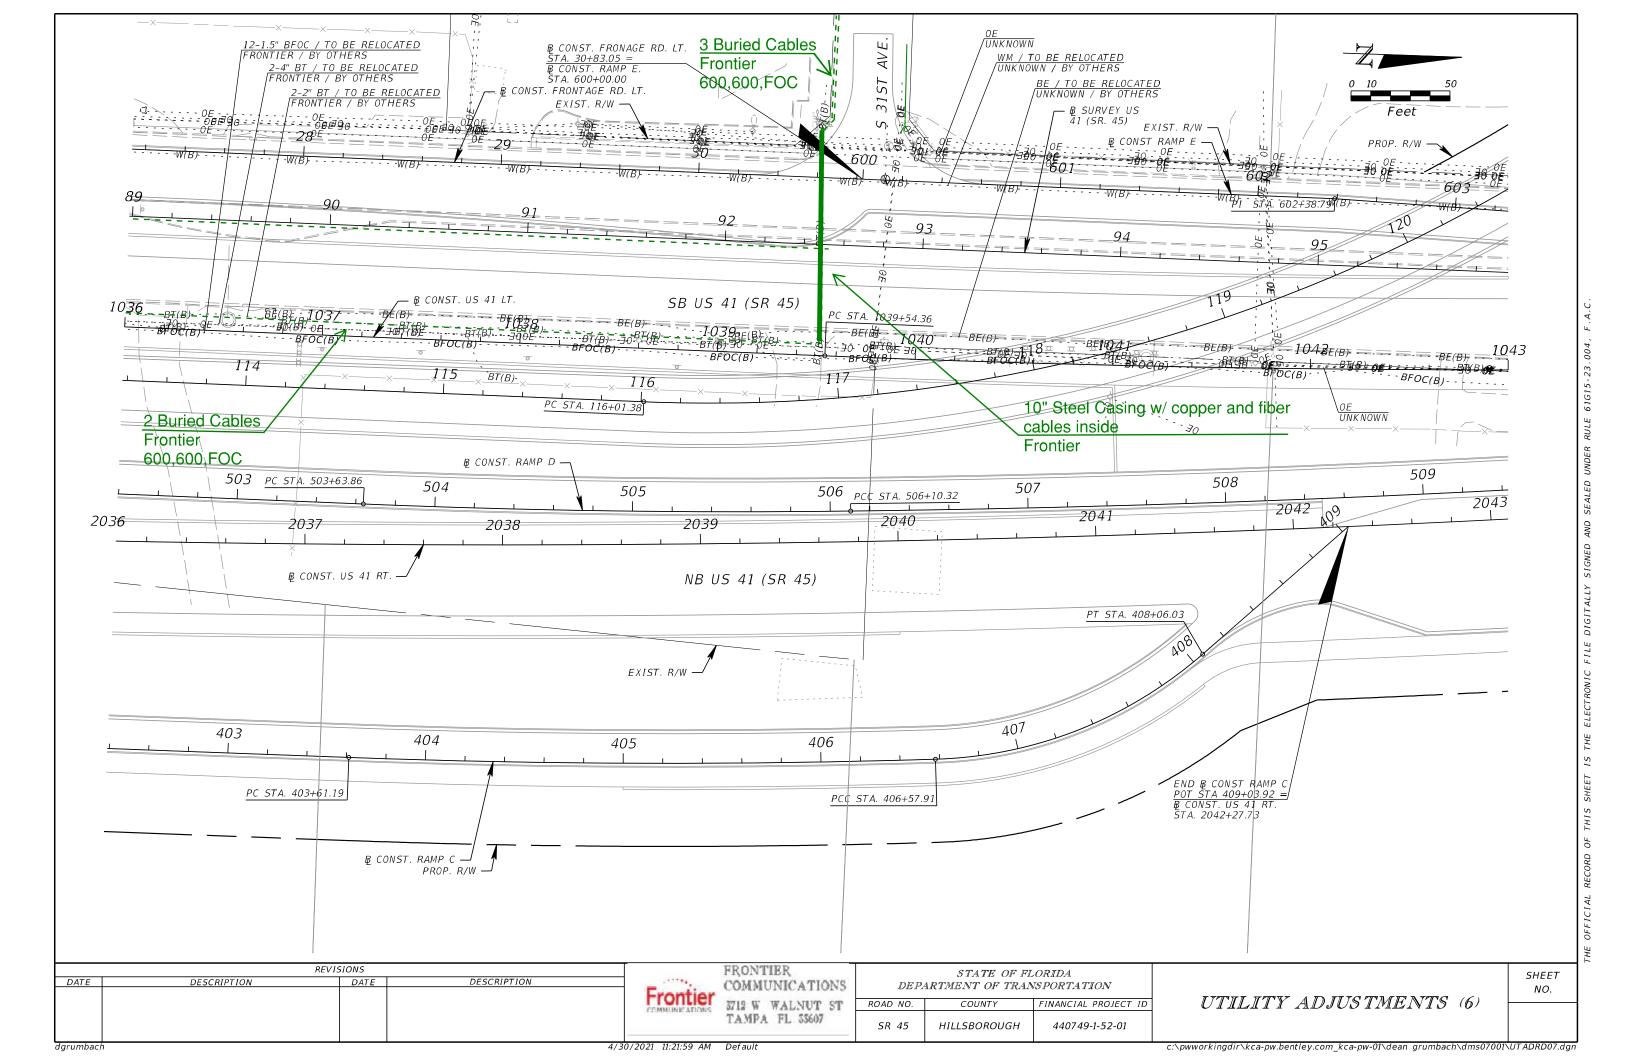


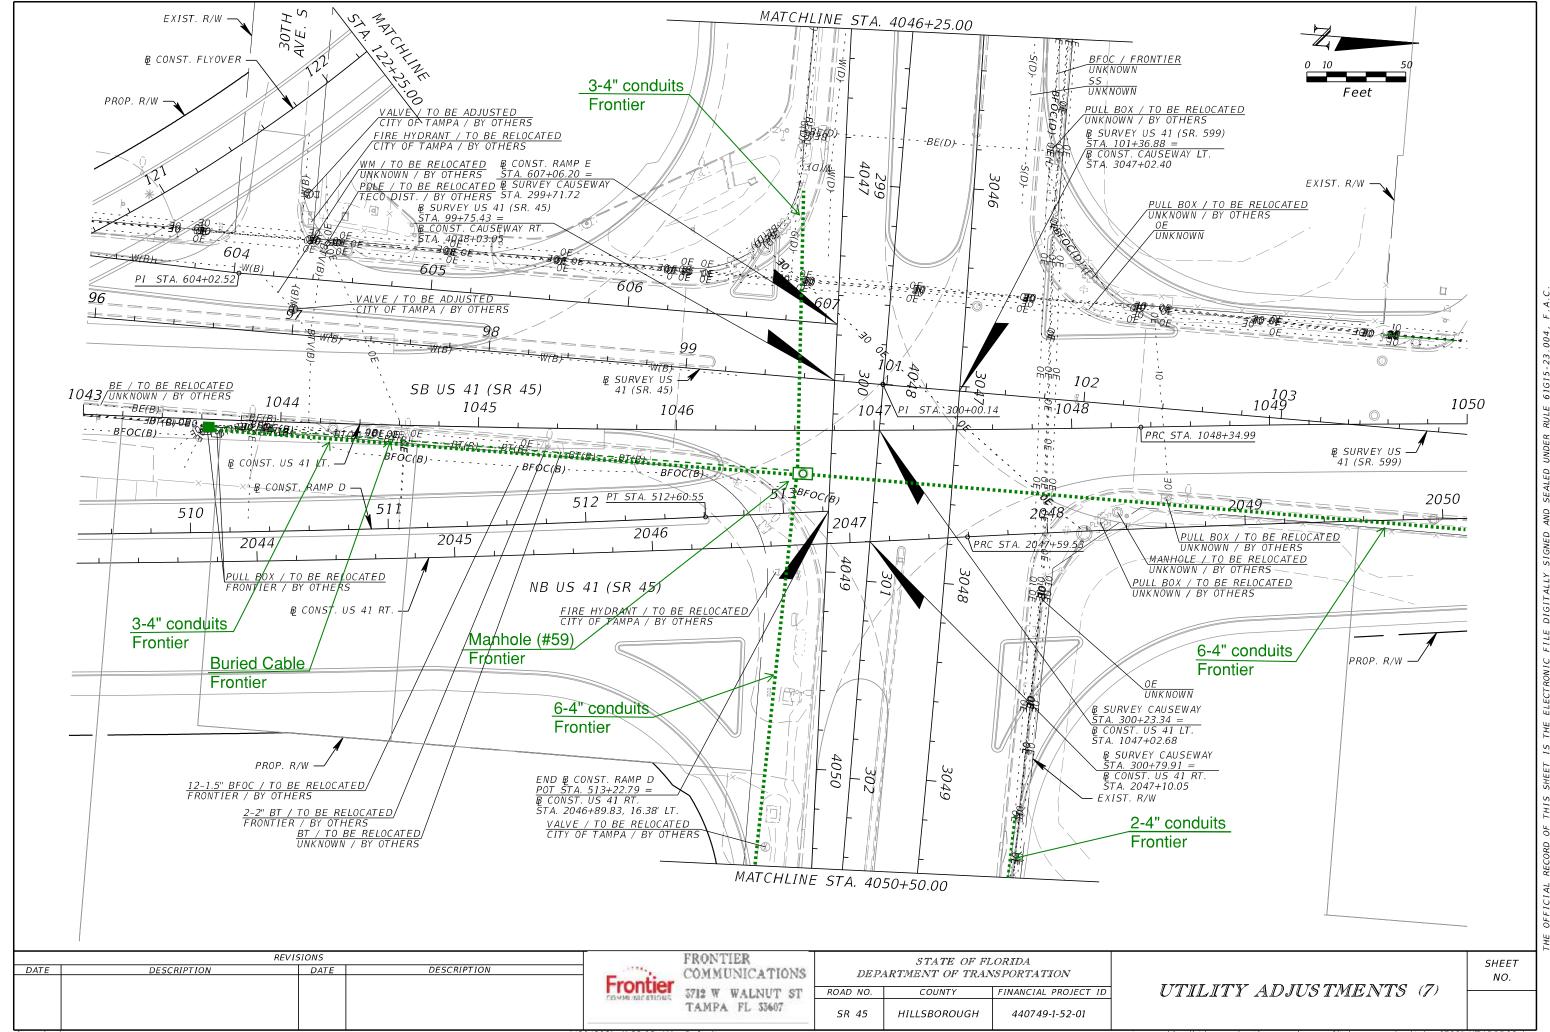


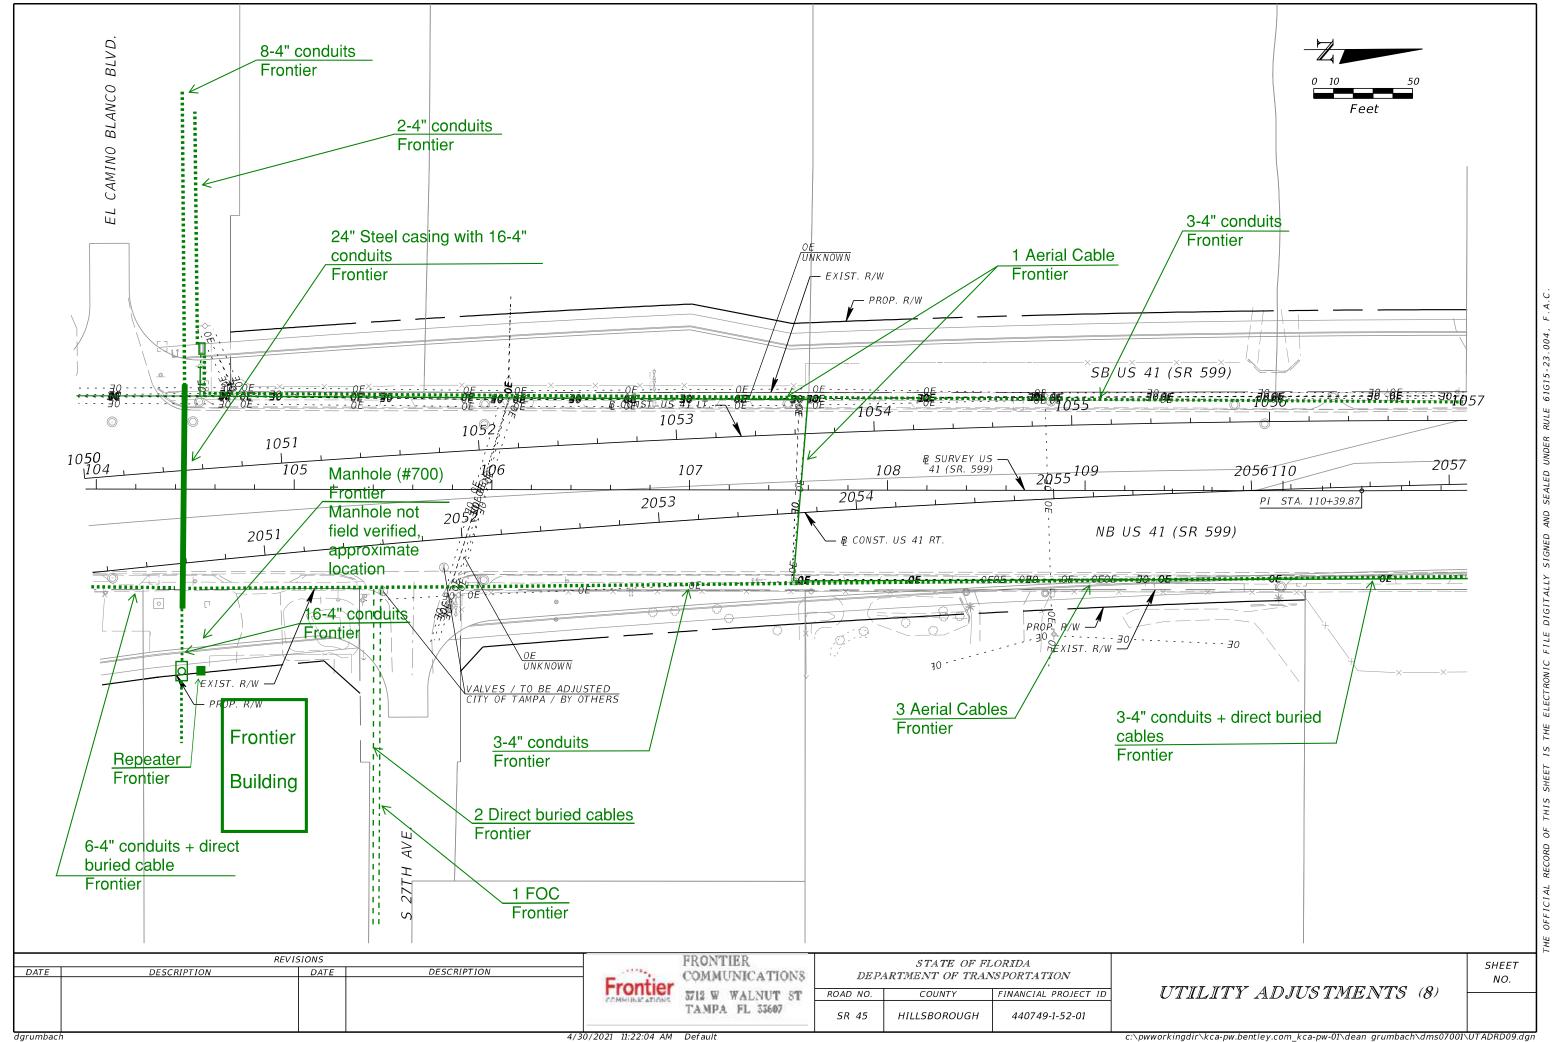


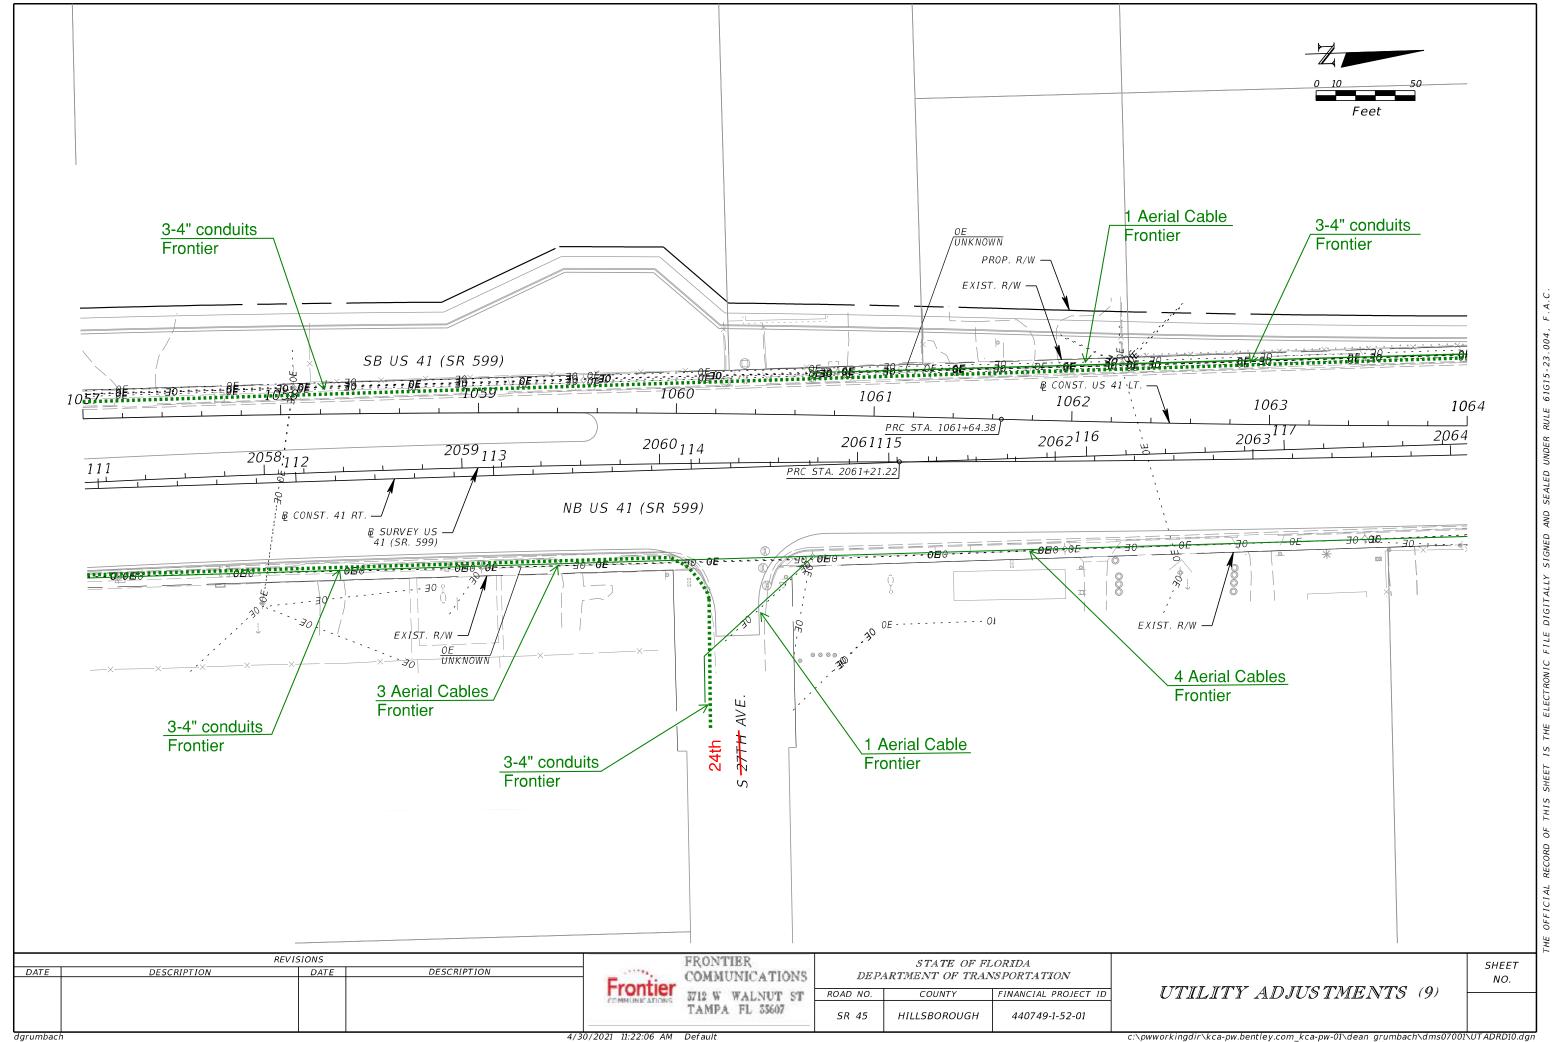


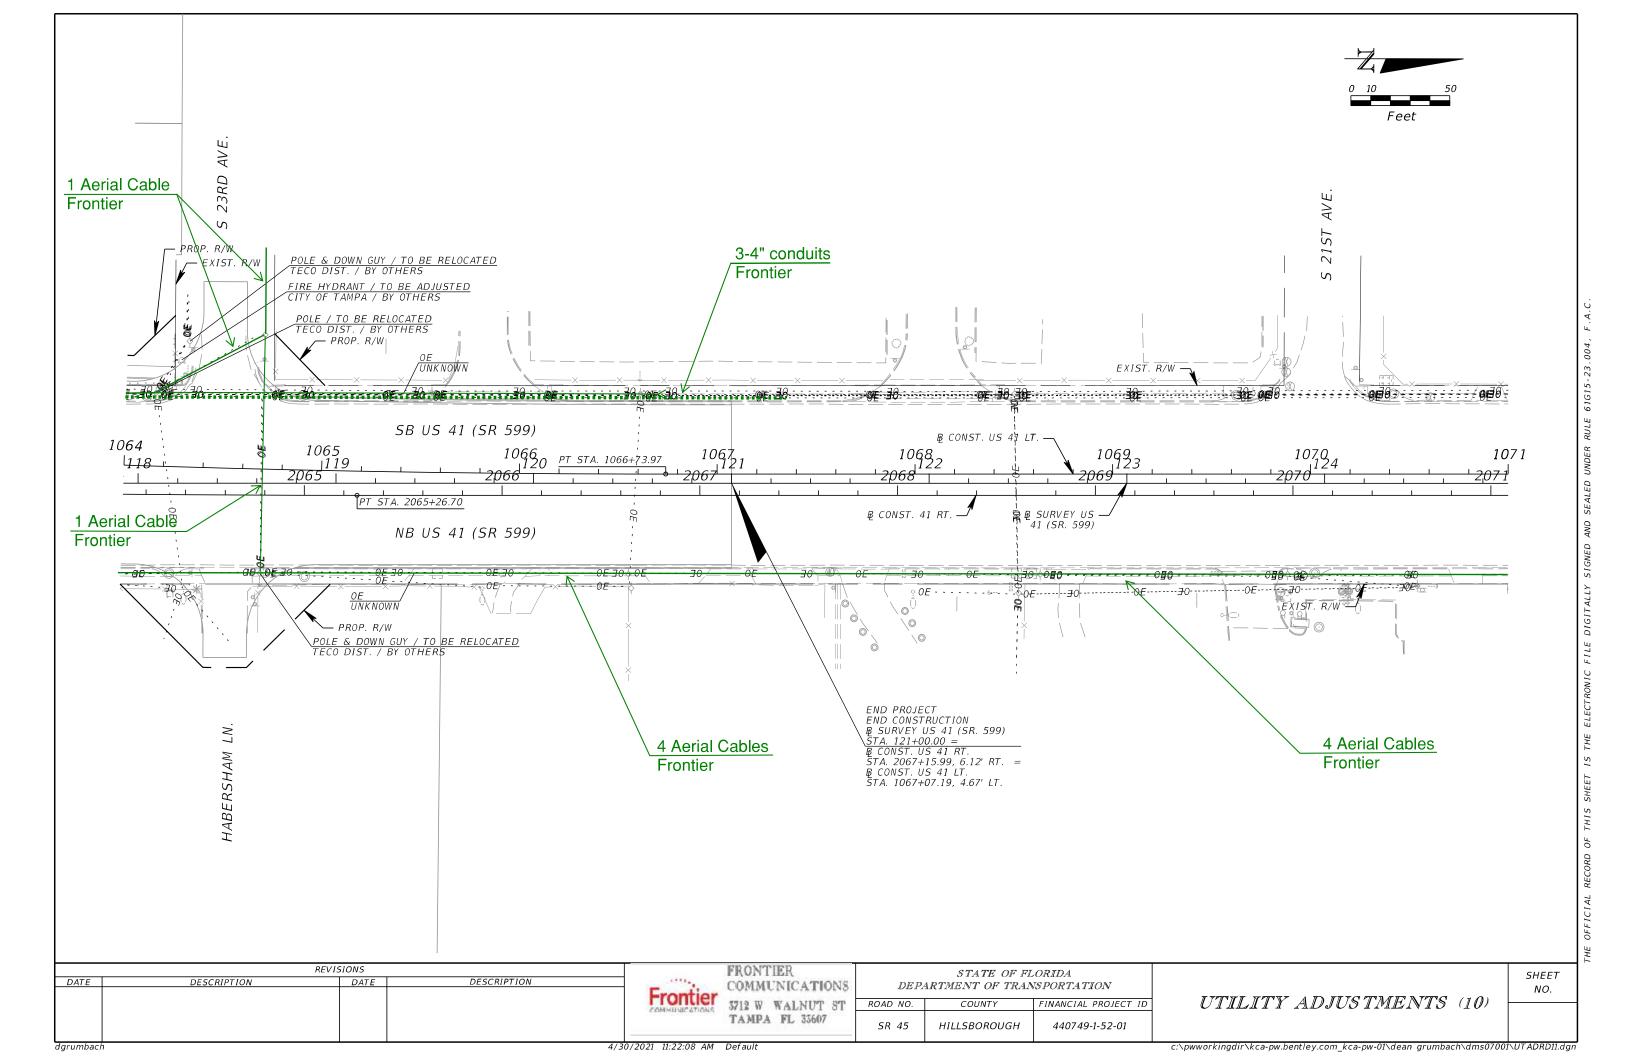


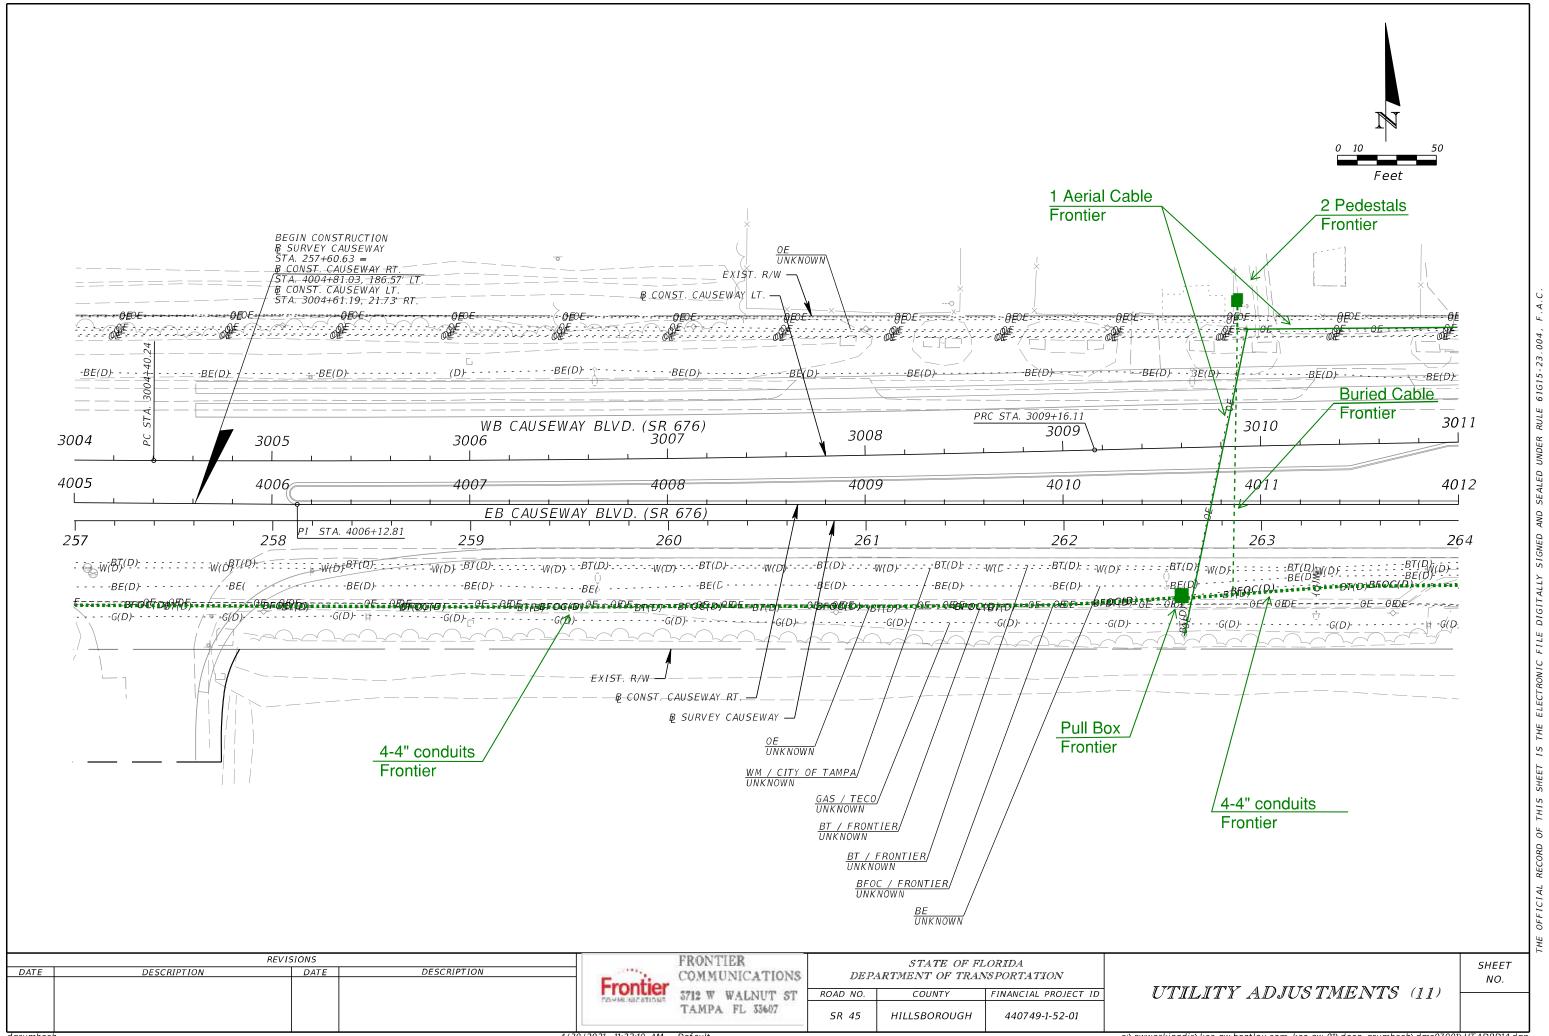


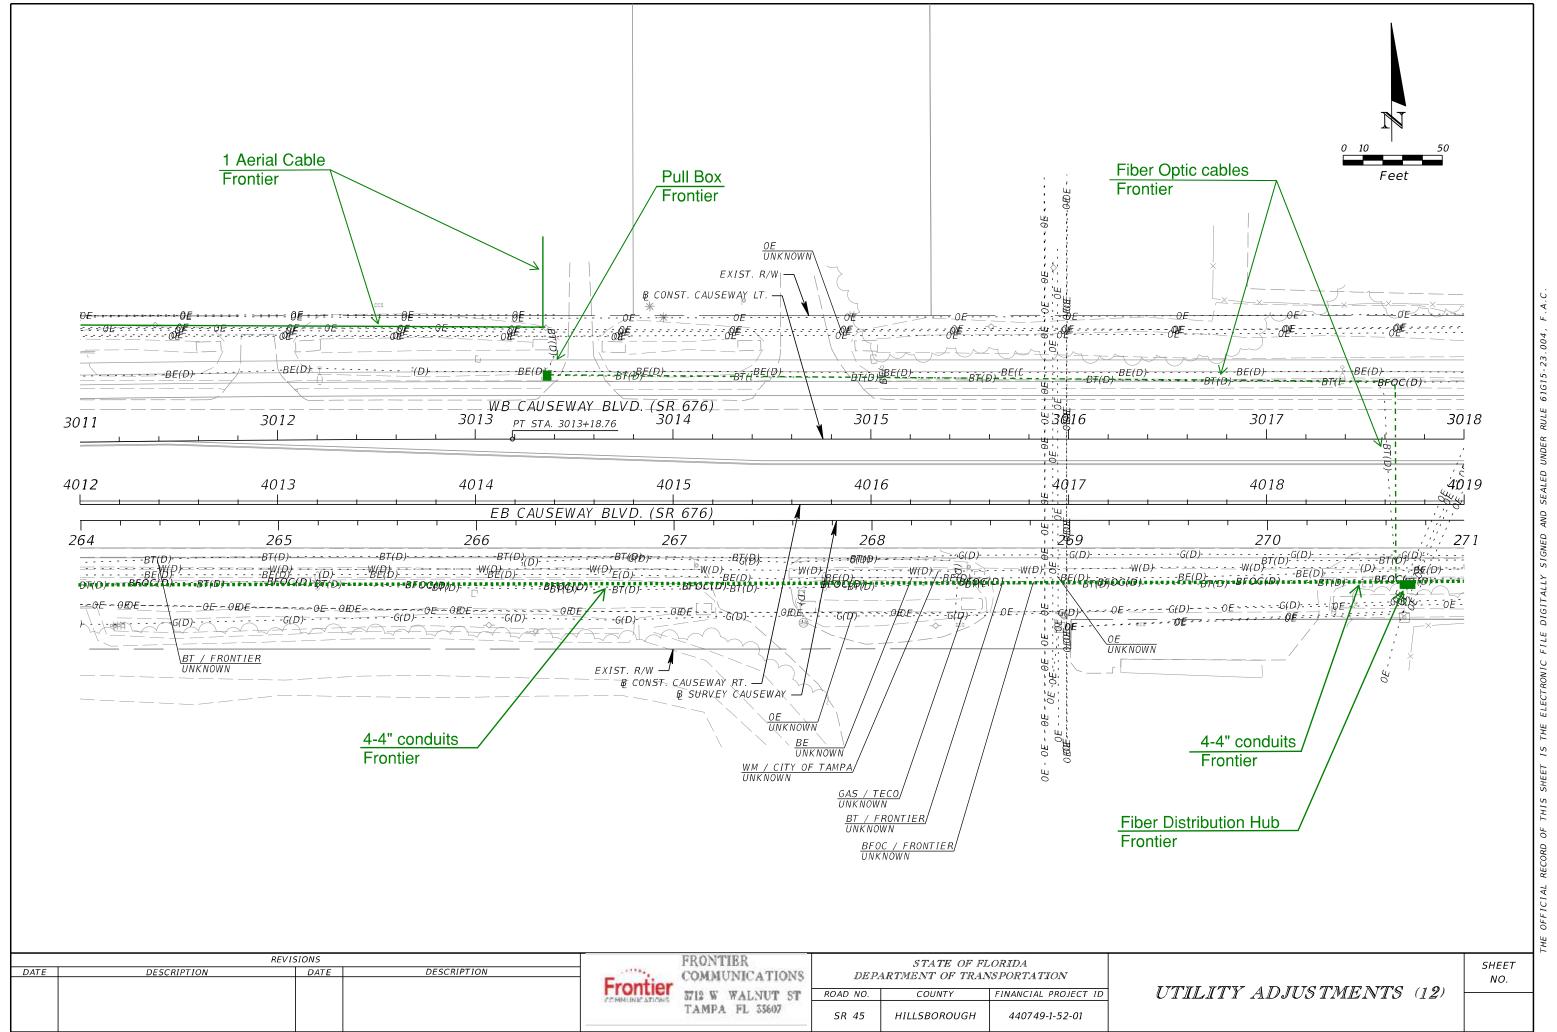


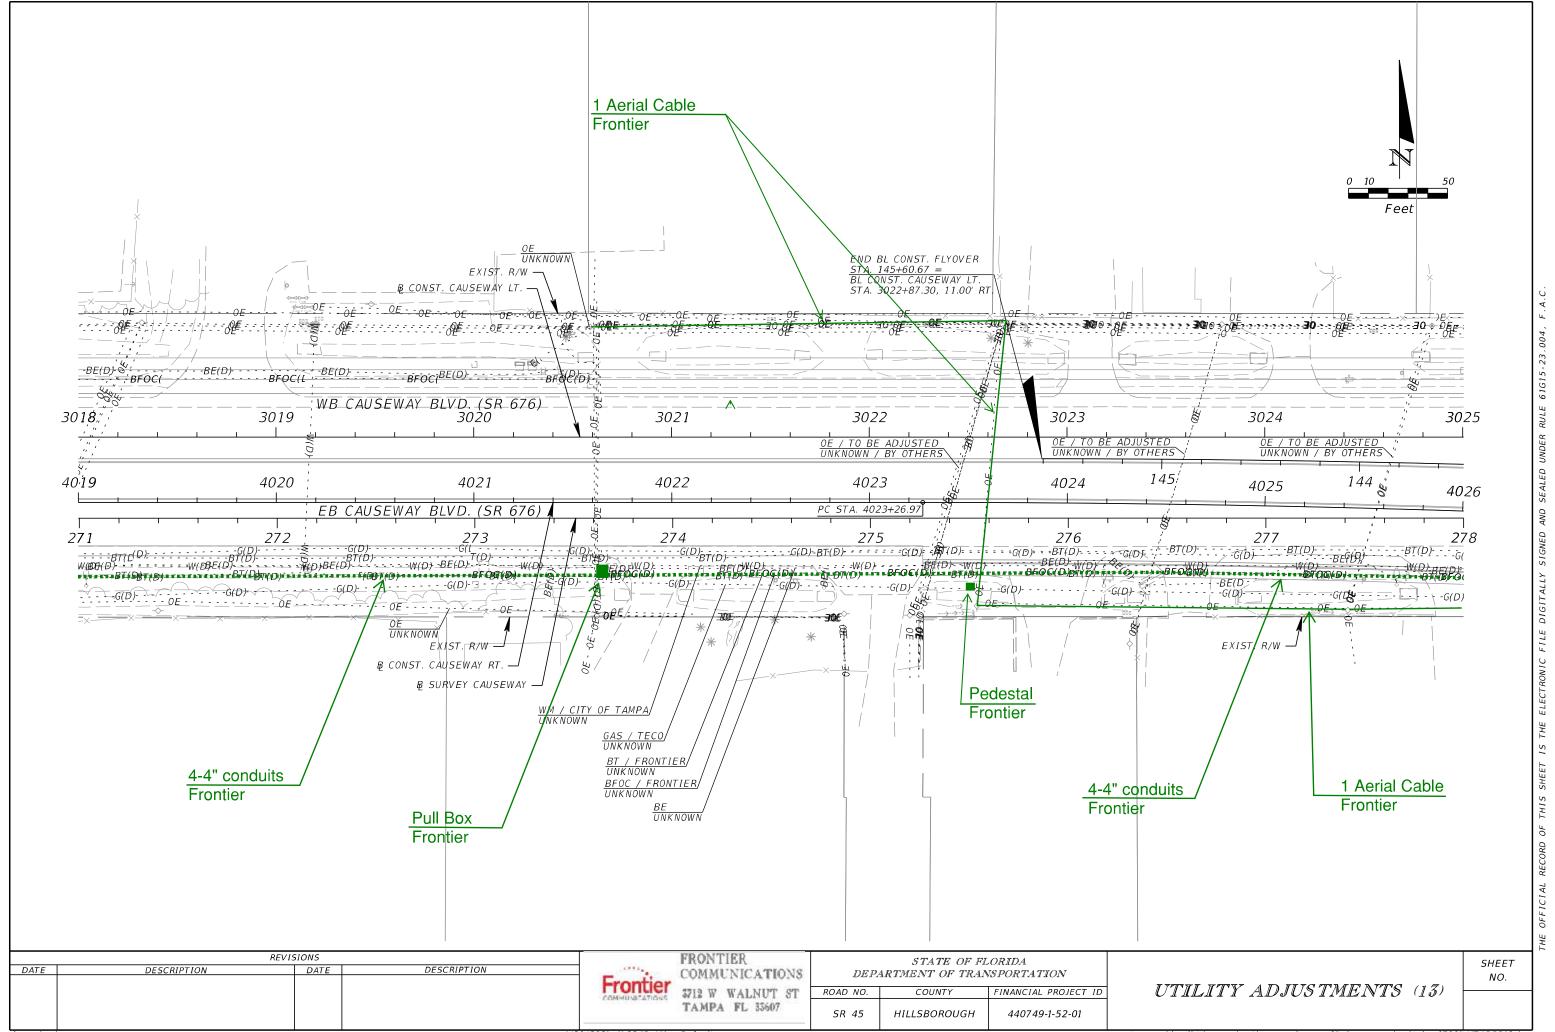


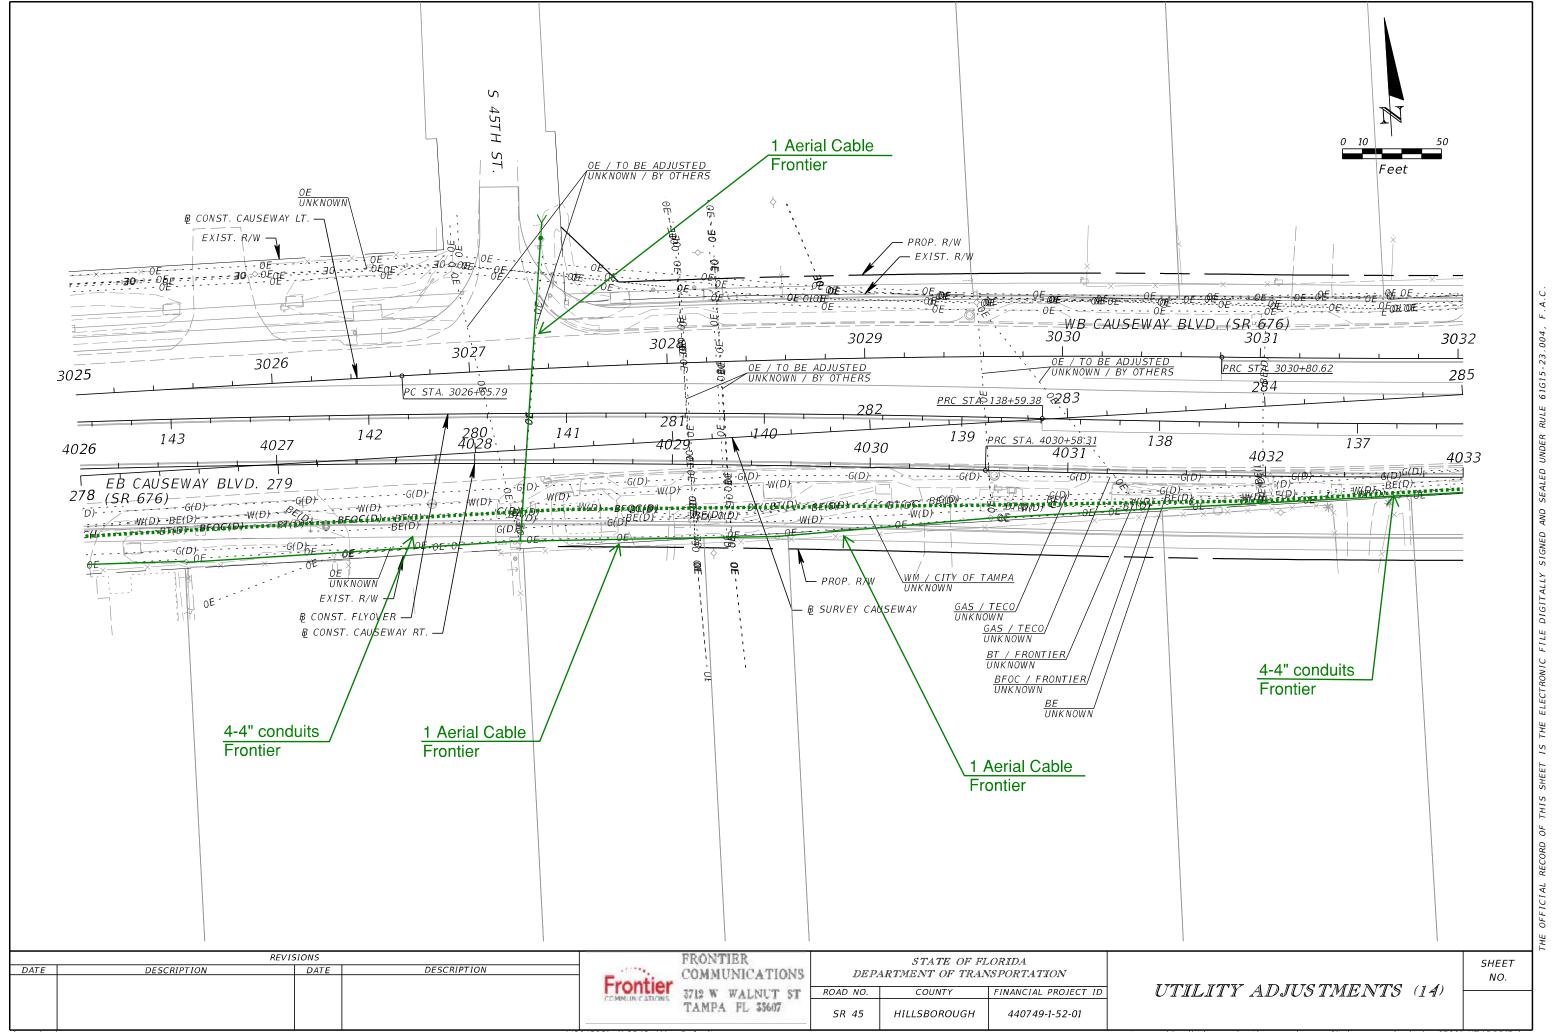

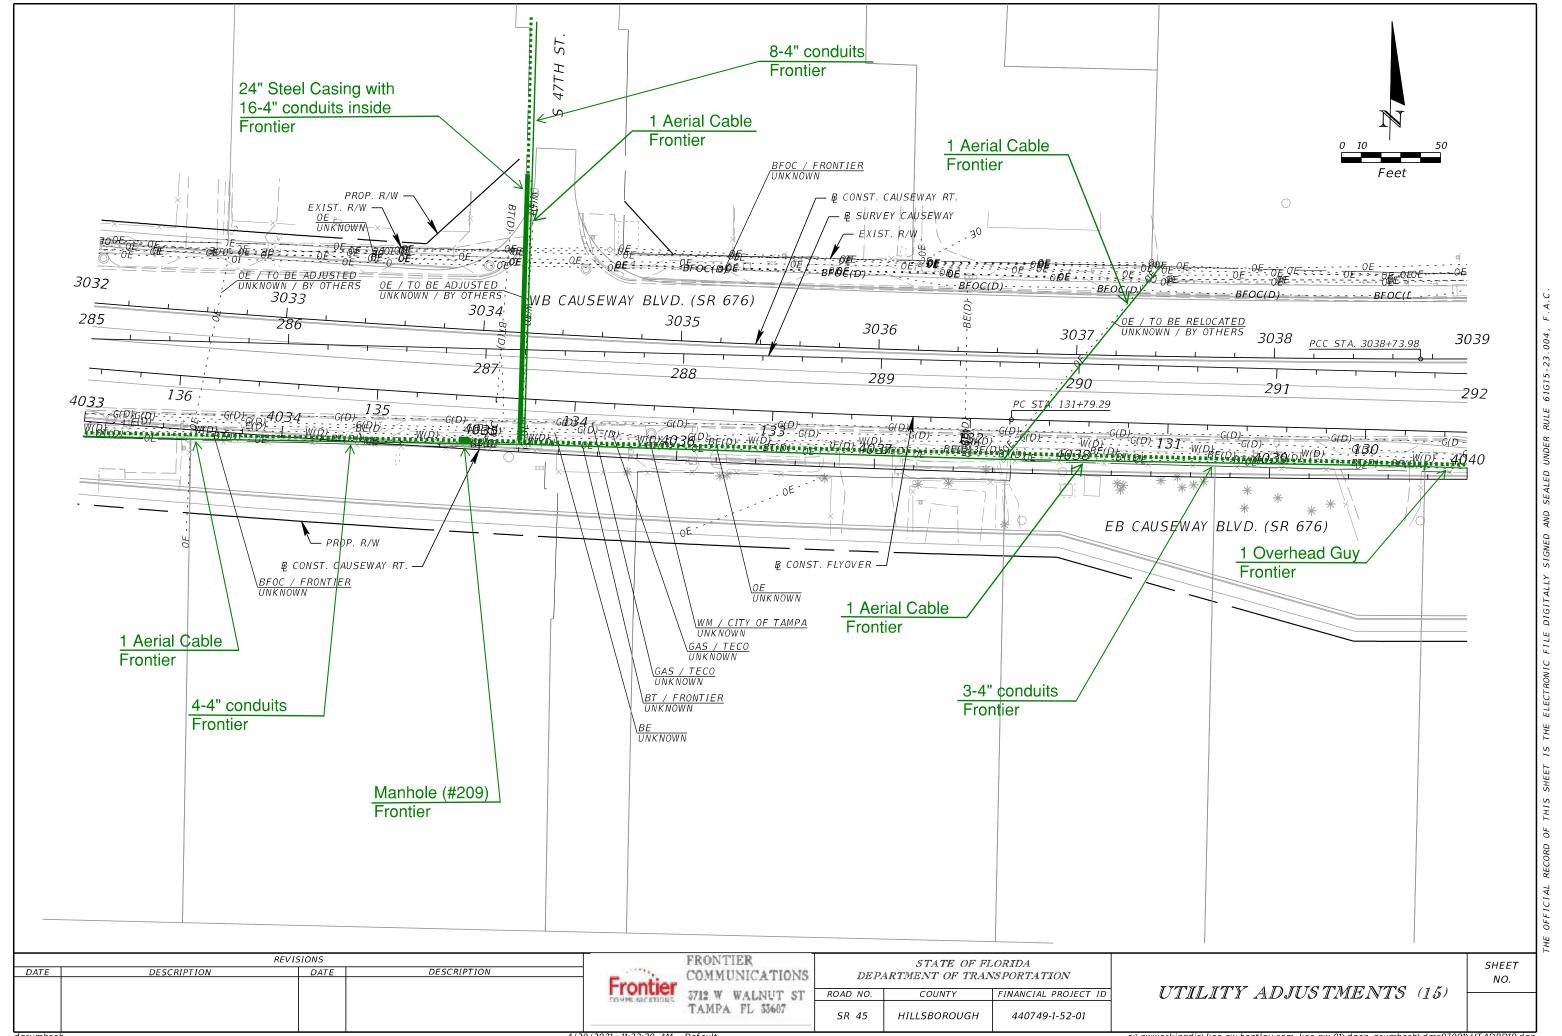

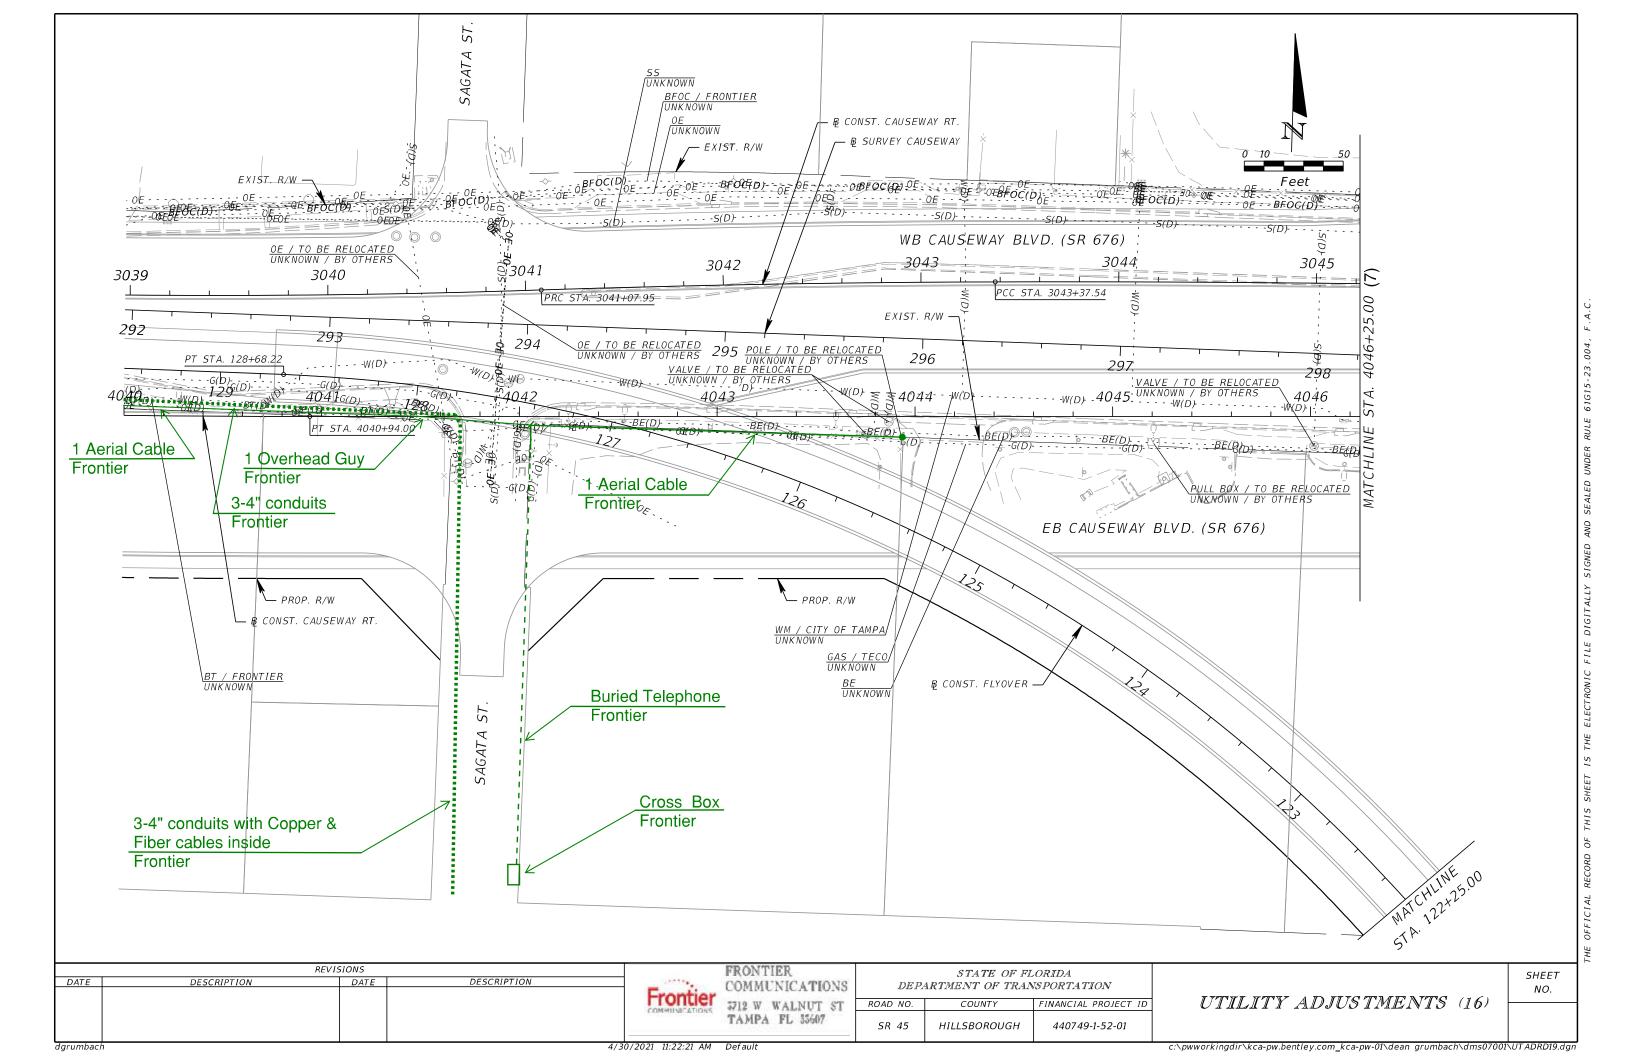

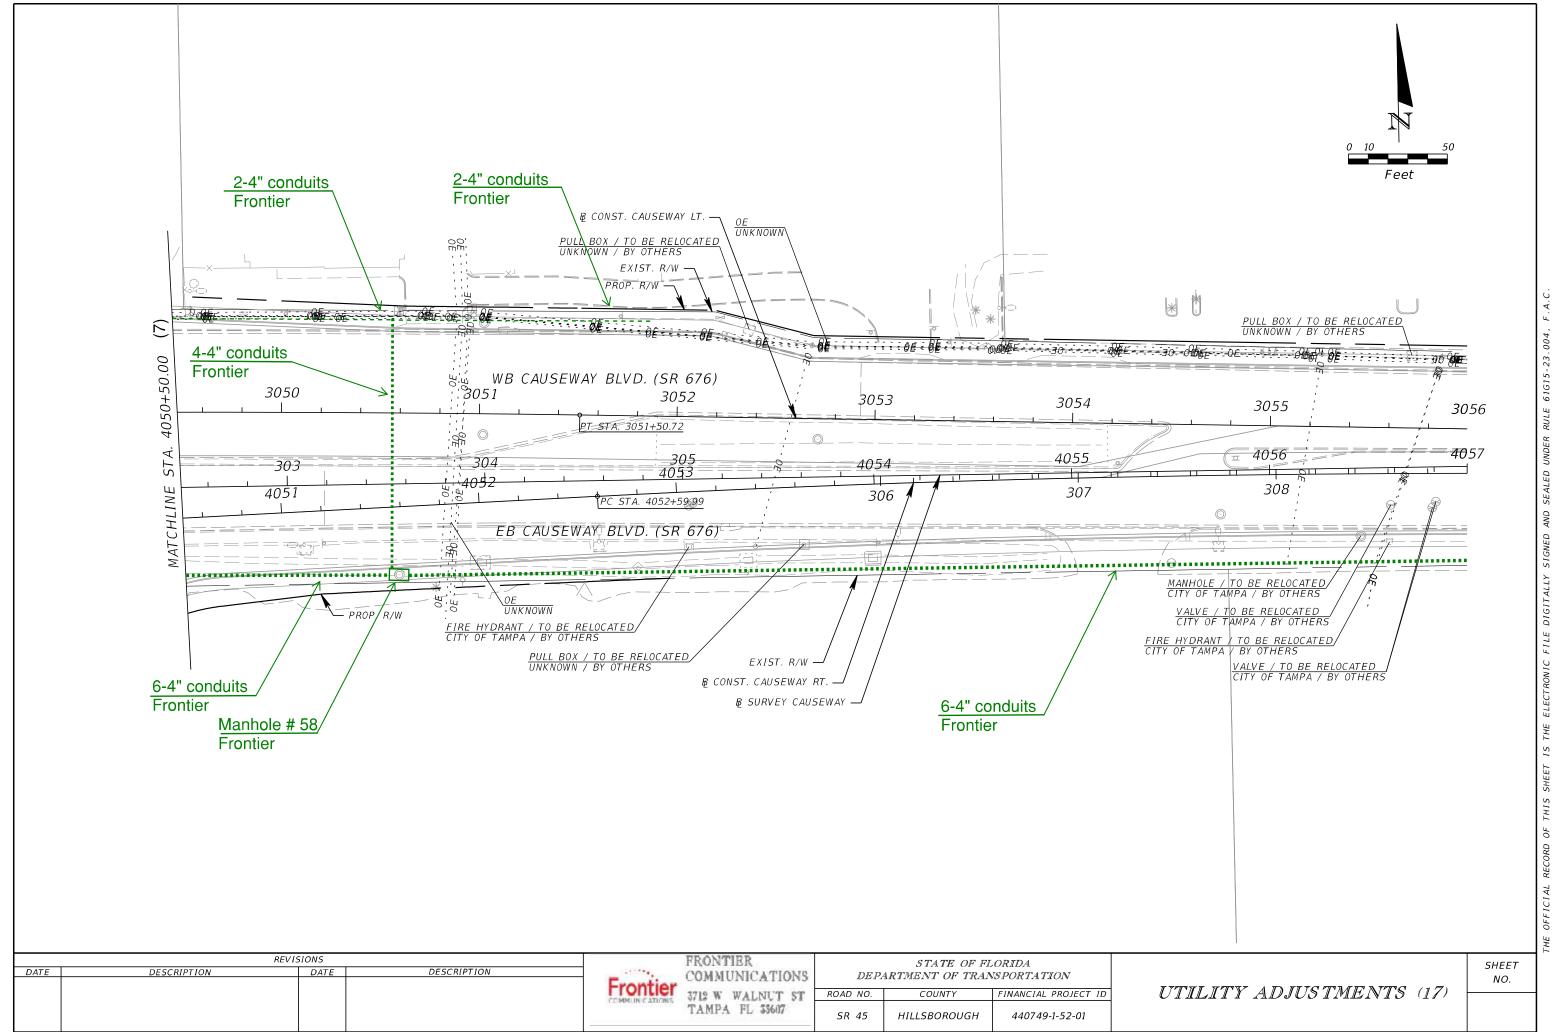

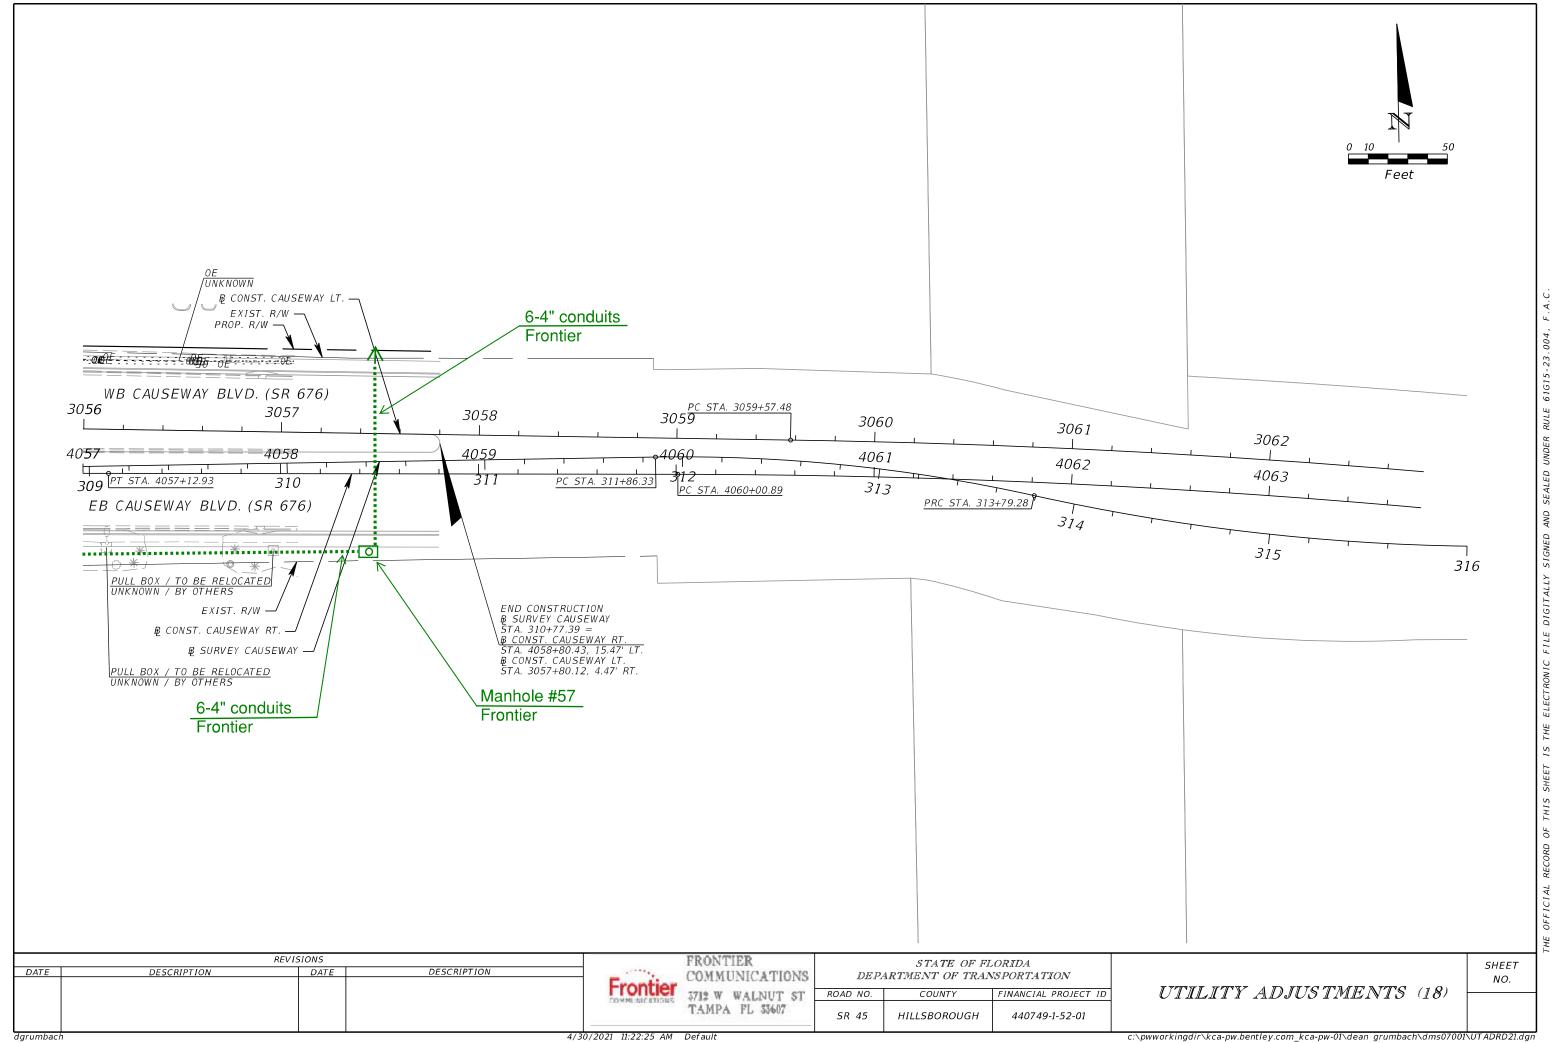

	Cre	w Members:	DW, TG					
	City	y, State:	Tampa, Florida					
	Gei	neral Location:	US 41					
ICE-	Cod	ordinate Unit of Meas	ure: U	S Survey Feet				
		Abbreviations	Offset Mea	sured From:				
	N/A	= Not Applicable	EP= Edge of Pav	ement				
OLE"	NAD) = North American	BC = Back of Cur	rb				
	Dati	um	BL = Baseline of	Survey				
		/D = North American	COORD = Survey	y Coordinates				
		tical Datum	CL = Centerline					
	_	(= Unknown	HUB = Survey H					
	СОТ	= City of Tampa	RW = Right of W	/ay				
	\vdash		ST = Swing Ties X = "X" in Concre					
	U 1	nontol. NADONA	x = "x" in Concr	etë				
		izontal: NAD83/11 tical: NAVD88	Ground	Utility				
	ven		Elevation	Elevation				
ng		Easting						
.90'		526413.67'	7.51'	4.25'				
.19'		526416.74"	7.48'	4.18'				
.95'		526415.25'	7.48'	5.01'				
.12'		526418.96'	7.36'	-1.44'				
.11'		526321.06'	6.85'	1.31'				
.38'		526417.02'	6.84'	3.40'				
.47'		526418.97	6.84'	4.42'				
.12'		526422.34'	6.83'	-3.23'				
.56'		526424.00°	6.49'	3.15'				
		Prepared by: EE	Date: 02/12/20	019				

i ilialiciai i	Toject m.	11/1		1511	F SR434 Sto	2001 #252			1511 E. SR434, Ste. 2001, #252 888.778.ECHO		B.ECHO	General Location.		03 41
Truck No.:	:		D-3/T-2		ter Springs, Flo	2001, 11232		INEERING &		A MODELLA PROPERTY OF THE STATE		Coordinate Unit of Meas	oordinate Unit of Measure: US Su	
	Utility Type			Utility Material					Identified By:		Abbreviations	Offset Measured From:		
BE = Buried									The state of the s		N/A = Not Applicable	EP= Edge of Pavement		
GM = Gas M		SL = Street			CI= Cast Iron HDPE = High Density Polyet			hylene Pipe		"ECHO TEST HOLE"	NAD = North American	BC = Back of Curb		
BT = Buried	Telephone	TS = Traffic	Signal		CP = Concrete F	Pipe				NL = Nail & Disk "ECI	HO TEST HOLE"	Datum	BL = Baseline of Survey	
FOC = Fiber	Optic Cable	FL = Fuel Lir	ne		DBC = Direct Bu	ıried Cable	PVC = Polyvir	nyl Chloride		SLEEVE = Sleeve		NAVD = North American	COORD = Surve	y Coordinates
WM = Wate	r Main	GS = Gas Se	ervice		CMP = Corrugat	ted Metal Pipe	STL = Steel			X = "X" in Concrete		Vertical Datum	CL = Centerline	
SAN = Sanita	ary Sewer	WS = Wate	r Service		CONC = Concre	te	VCP = Vitrifie	d Clay Pipe		Surfac	е Туре	UNK = Unknown	HUB = Survey H	ub
STM = Storn	n Sewer	UNK = Unki	nown Utility		CPP = Corrugate	ed Plastic Pipe	PCCP = Prest	ressed Cylinde	r Concrete	ASPH = Asphalt		COT = City of Tampa	RW = Right of W	Vay
CATV = Cabl	e Television	BED = Burie	ed Electrical D	Duct	DCT = Duct	-	Pipe	,		CONC = Concrete			ST = Swing Ties	
FM = Force I	Main	BTD = Burie	ed Telephone	Duct	DIP = Ductile Ire	on Pipe		rced Concrete	Pipe	NG = Natural Ground	d		X = "X" in Concr	ete
			Utility Size	Utility		Ņ			Surface		5.	Horizontal: NAD83/11		
Test Hole	Utility Type	Utility	Outside	Manual	Cross	+	Identified By	Surface Type	Thickness	Apparent Utility	Datums:	Vertical: NAVD88	Ground	Utility
restriore	ouncy type	Material	Diameter	Depth	Sectional View	*	identified by	Sarrace Type	inches	Owner	Northing	Easting	Elevation	Elevation
			inches	feet		Utility Direction					HOTEIMIG	casting		
1-1	ВТ	PVC	2 - 4"	3.26'	00	Ĵ	IRC	NG	N/A	FRONTIER	1301204.90'	526413.67'	7.51'	4.25'
1-2	WM	CI	6"	3.30'		\updownarrow	IRC	NG	N/A	сот	1301205.19	526416.74'	7.48'	4.18'
1-3	FOC/BT	PVC	4"	2.47'	\circ	ightharpoons	IRC	NG	N/A	FRONTIER	1301204.95'	526415.25'	7.48'	5.01'
1-4	FOC	PE	12 - 1.5"	8.80'	~88888°	\$	IRC	NG	N/A	FRONTIER	1301205.12	526418.96'	7.36'	-1.44'
1-5	CATV	PVC	2 - 2"	5.54'	00	1	IRC	NG	N/A	SPECTRUM	1301181.11'	526321.06'	6.85'	1.31'
1-6	вт	PVC	2 - 4"	3.44'	00	1	IRC	NG	N/A	FRONTIER	1301811.38'	526417.02'	6.84'	3.40'
1-7	FOC/BT	PVC	4"	2.42'	\circ	1	IRC	NG	N/A	FRONTIER	1301811.47	526418.97	6.84'	4.42'
1-8	WM	UNK	UNK	10.06"		Ì	IRC	NG	N/A	сот	1301810.12'	526422.34'	6.83'	-3.23'
1-9	FOC/BT	PVC	4"	3.34'	O	1	IRC	NG	N/A	FRONTIER	1301810.56	526424.00"	6.49'	3.15'
						·								
Notes:	1-8 - Unable	to visually v	erify size and	matterial du	ie to depth and (groundwater. Possil	ole 6" cast iron	n.				•		
	l													
	ı													
												Prepared by: EE	Date: 02/12/20	019
	T											Checked by: AB	Date: 02/12/	2019
	Î													
	REVISIONS	<u> </u>					ED ONTO	TEND OF THE						

Test Hole Data Report

DESCRIPTION DATE DESCRIPTION DATE

dgrumbach



FRONTIER 3712 W WALNUT ST TAMPA FL 53607

STATE OF FLORIDA DEPARTMENT OF TRANSPORTATION ROAD NO. COUNTY FINANCIAL PROJECT ID SR 45 HILLSBOROUGH 440749-1-52-01

ECHO UES, Inc. www.echoues.com

888.778.ECHO

UTILITY ADJUSTMENTS (19)

12/04/2018

18-252

N/A

16514 N. Dale Mabry Hwy.

Tampa, Florida 33618

Date:

ECHO Project #:

Financial Project #:

Date:	ļ.	12/05/2018 Test Ho							ort		Crew Members: DW, TO			
Y .					6514 N. Dale Ma	abry Hwy.								ampa, Florida
				Tampa, Florida 33618 1511 F. SR434. Ste. 2001. #252						oues.com	General Location:	US 41		
				151:	1 E. SR434, Ste.	LOUZ, NEUL	-				8.ECHO	TO LEGIT COMMITTED AND CONTROL OF SIN HORSE WITH CONTROL OF SIN CO		
Truck No.			D-3/T-2	Wir	nter Springs, Flo	// Ida 32/00		INEERING &	SURVEY		AKE A DIFFERENCE-	Coordinate Unit of Meas		S Survey Feet
		Itility Type				Utilit	y Material				fied By:	Abbreviations		sured From:
BE = Buried		RW = Recla			AC = Transite		FIBG = Fiberg			HUB = Survey Hub		N/A = Not Applicable	EP= Edge of Pav	
GM = Gas N		SL = Street	-		CI= Cast Iron	L+		Density Polyet	hylene Pipe	IRC = Iron Rod & Cap			BC = Back of Cu	
BT = Buried		TS = Traffic	-		CP = Concrete F DBC = Direct Bu		PE = Polyethy			NL = Nail & Disk "EC SLEEVE = Sleeve	HO JEST HOLE.	NAVD = North American	BL = Baseline of	
WM = Wate		FL = Fuel Lin GS = Gas Se			CMP = Corruga		PVC = Polyvir STL = Steel	iyi Chioride		X = "X" in Concrete			COORD = Surve CL = Centerline	
SAN = Sanit		WS = Water			CONC = Concre	*	VCP = Vitrifie	d Clay Pine			е Туре	UNK = Unknown	HUB = Survey H	
STM = Storr		UNK = Unkr			CPP = Corrugat			ressed Cylinde	r Concrete	ASPH = Asphalt	стурс	THE RESIDENCE OF THE PERSON OF	RW = Right of V	
CATV = Cab		.	d Electrical D	Duct	DCT = Duct	ed Flosere Fipe	Pipe	resseu cymrue	Concrete	CONC = Concrete		and any or rainpa	ST = Swing Ties	
FM = Force			d Telephone		DIP = Ductile Ire	on Pipe	<u> </u>	rced Concrete	Pipe	NG = Natural Ground	d		X = "X" in Conci	
Test Hole	Utility Type	Utility Material	Utility Size Outside Diameter	Utility Manual Depth	Cross Sectional View	*	Identified By	Surface Type	Surface Thickness inches	Apparent Utility Owner	Datums:	Horizontal: NAD83/11 Vertical: NAVD88	Ground Elevation	Utility Elevation
			inches	feet	000	Utility Direction	10.0			50 ONTISS	Northing	Easting		
1-10	FOC	PE	12 - 1.5"	3.96'		→	IRC	NG	N/A	FRONTIER	1302430.03'	526421.52'	6.62'	2.66'
1-11	ВТ	PVC	2 - 4"	2.50'	Û	<u> </u>	IRC	NG	N/A	FRONTIER	1302430.50'	526424.77'	6.68'	4.18'
1-12	FOC/BT	PVC	4"	1.90'	\circ	Ţ	IRC	NG	N/A	FRONTIER	1302430.47'	526425.15'	6.69'	4.79'
1-13	вт	DBC	2"	1.56'	0	\$	IRC	NG	N/A	FRONTIER	1302430.15'	526428.11'	6.81'	5.25'
1-14	WM	DIP	6"	3.40"		\$	IRC	NG	N/A	сот	1302428.62'	526446.38'	8.20'	4.80'
1-15	GM	STL	4"	3.00'	0	1	IRC	NG	N/A	сот	1302488.18'	526318.06'	6.08'	3.08'
1-16	ВТ	PVC	4"	3.50'	0	1	IRC	NG	N/A	FRONTIER	1301205.22'	526417.96'	7.50'	4.00'
1-17	вт	DBC	2"	3.00'	0	‡	IRC	NG	N/A	FRONTIER	1301810.09'	526422.72'	6.80'	3.80'
Notes:														
	'													
	"													
	1											Prepared by: EE	Date: 02/12/2	019
	T											Checked by: AB	Date: 02/12/	2019

REVISIONS DESCRIPTION DATE DESCRIPTION DATE

FRONTIER Frontier
5712 W WALNUT ST
TAMPA FL 33607

STATE OF FLORIDA DEPARTMENT OF TRANSPORTATION ROAD NO. COUNTY FINANCIAL PROJECT ID SR 45 HILLSBOROUGH 440749-1-52-01

UTILITY ADJUSTMENTS (20)

Date:		12/06/2018 Test Hole Data Report Cre								Crew Members: DW, TG, M					
ECHO Project #: 18-252					514 N. Dale Ma	abry Hwy.				ECHO L	IES, Inc.	City, State: Tampa, Florid			
Financial Project #: N/A				Tampa, Florida	33618	 ● ECHO			www.echoues.com		General Location:	US 41			
Truck No.:			D-3/T-2		E. SR434, Ste.						8.ECHO	SHEEDWICH STATE DOOR WANT CONTINUE SHEED S			
Truck No.:				Win	ter Springs, Flo	// Ida 32/00		INEERING &	SURVEY	- GROW, INSPIRE, M		Coordinate Unit of Mea		S Survey Feet	
		Itility Type				Utilit	y Material				ied By:	Abbreviations		sured From:	
BE = Buried	-	RW = Recla			AC = Transite		FIBG = Fiberg			HUB = Survey Hub		N/A = Not Applicable	EP= Edge of Pay		
GM = Gas M		SL = Street	-		CI= Cast Iron	×		Density Polyet	hylene Pipe	IRC = Iron Rod & Cap		NAD = North American	BC = Back of Cu		
BT = Buried		TS = Traffic			CP = Concrete P		PE = Polyethy			NL = Nail & Disk "EC	HO TEST HOLE"	Datum	BL = Baseline of		
FOC = Fiber WM = Wate		FL = Fuel Lir GS = Gas Se			DBC = Direct Bu CMP = Corrugat		PVC = Polyvir STL = Steel	nyi Chioride		SLEEVE = Sleeve X = "X" in Concrete		NAVD = North American Vertical Datum	COORD = Surve		
						*	VCP = Vitrifie	d Clay Dino			е Туре	UNK = Unknown	HUB = Survey H		
SAN = Sanita STM = Storm		WS = Water UNK = Unkr			CONC = Concre CPP = Corrugate				n Comonata	ASPH = Asphalt	етуре	COT = City of Tampa	RW = Right of V		
CATV = Cable			d Electrical D	ouct	DCT = Duct	ed Flastic Fipe	Pipe Prest	ressed Cylinde	r concrete	CONC = Concrete		cor - city or rampa	ST = Swing Ties		
FM = Force f			d Telephone		DIP = Ductile Iro	on Pine		rced Concrete	Pine	NG = Natural Ground	d		X = "X" in Conci		
	-	Utility	Utility Size Outside		Cross	N			Surface	Apparent Utility	Datums:	Horizontal: NAD83/11 Vertical: NAVD88		Utility	
Test Hole	Utility Type	Material	Diameter inches	Depth feet	Sectional View	Utility Direction	Identified By	Surface Type	Thickness inches	Owner	Northing	Vertical: NAVD88 Easting	Elevation	Elevation	
1-18	ВТ	PVC	2 - 4"	3.82'	00	\^	IRC	NG	N/A	FRONTIER	1303091.15	526425.13'	7.04'	3.22'	
1-19	FOC/BT	PVC	4"	2.54'	\circ	1	IRC	NG	N/A	FRONTIER	1303091.17	526425.73"	6.99'	4.45'	
1-20	вт	LEAD	2 - 2"	3.00'	00	‡	IRC	NG	N/A	FRONTIER	1303091.09	526427.92'	6.86'	3.86'	
1-21	FOC	UNK	12 - 1.5"	9.22'	888888	1	IRC	NG	N/A	FRONTIER	1303091.01	526430.76'	6.581	-2.64'	
1-22	ВТ	LEAD	2 - 2"	2.00'	00	1	IRC	NG	N/A	FRONTIER	1303695.15	526432.46"	6.77'	4.77'	
1-23	ВТ	PVC	2 - 4"	2.76'	00	\$	IRC	NG	N/A	FRONTIER	1303695.20	526433.46'	6.70'	3.94'	
1-24	ВТ	LEAD	2 - 2"	2.74'	00	\$	IRC	NG	N/A	FRONTIER	1304500.45'	526435.53'	7.28'	4.54'	
Notes:	1-21 - Unable	to visually v	erify size and	d material du	e to depth and	groundwater. Possi	bly 12 - 1.5" p	olyethylene pi	pes.			•			
	1														
	1														
	1														
												Prepared by: EE	Date: 02/12/2	019	
												Checked by: AB	Date: 02/12/	2019	

Kisinger Campo & Associates Corp. 201 N. Franklin Street, Suite 400 Tampa, Florida 33602 Engineer of Record: Branan R. Anderson, PE P.E. No.: 78438 STATE OF FLORIDA
DEPARTMENT OF TRANSPORTATION

ROAD NO. COUNTY FINANCIAL PROJECT ID

SR 45 HILLSBOROUGH 440749-1-52-01


UTILITY ADJUSTMENTS (21)

STATE OF FLORIDA DEPARTMENT OF TRANSPORTATION

CONTRACT PLANS

(FEDERAL FUNDS) HILLSBOROUGH COUNTY (10002)

FINANCIAL PROJECT ID 440749-1-52-01

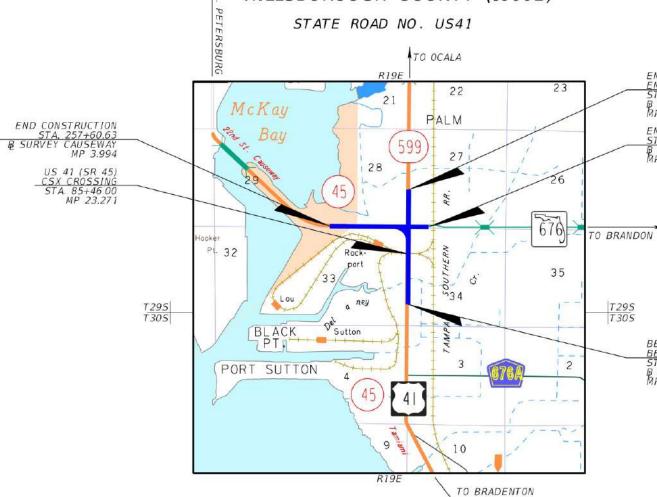

ROADWAY PLANS ENGINEER OF RECORD:

BRANAN R. ANDERSON, P.E. NO.: 78438 KISINGER CAMPO AND ASSOCIATES CORP. CONSULTING ENGINEERS & PLANNERS 201 N. FRANKLIN STREET, SUITE 400 TAMPA, FLORIDA 33602 (813) 871-5331 VENDOR NUMBER:: F59-1677145

NAPLES

KEY WEST

FDOT PROJECT MANAGER:

TIM O'BRIEN P.E.

LOCATION OF PROJECT https://www.google.com/maps/ @27.9206868,-82.3995664,1364

m/data=!3m1!1e3

END PROJECT END CONSTRUCTION STA. 121+00.00 B SURVEY US 41 (SR 599) MP 23.881

END CONSTRUCTION STA. 310+77.39 B SURVEY CAUSEWAY MP 2.961

BEGIN PROJECT BEGIN CONSTRUCTION STA. 58+31.17

B SURVEY US 41 (SR. 45) MP 22.756

CONSTRUCTION CONTRACT NO.	FISCAL YEAR	SHEET NO.
TBD	21	1

AUGUSTINE

PIERCE

LAUDERDALE

GOVERNING STANDARD PLANS:

Florida Department of Transportation, FY2021-22 Standard Plans for Road and Bridge Construction and applicable Interim Revisions (IRs).

Standard Plans for Road Construction and associated IRs are available at the following website: http://www.fdot.gov/design/standardplans


APPLICABLE IRS: N/A


Standard Plans for Bridge Construction are included in the Structures Plans Component


GOVERNING STANDARD SPECIFICATIONS:


Florida Department of Transportation, July 2022 Standard Specifications for Road and Bridge Construction at the following website: http://www.fdot.gov/programmanagement/Implemented/SpecBooks


rumbach 4/13/2021 2:47:16 PM Default

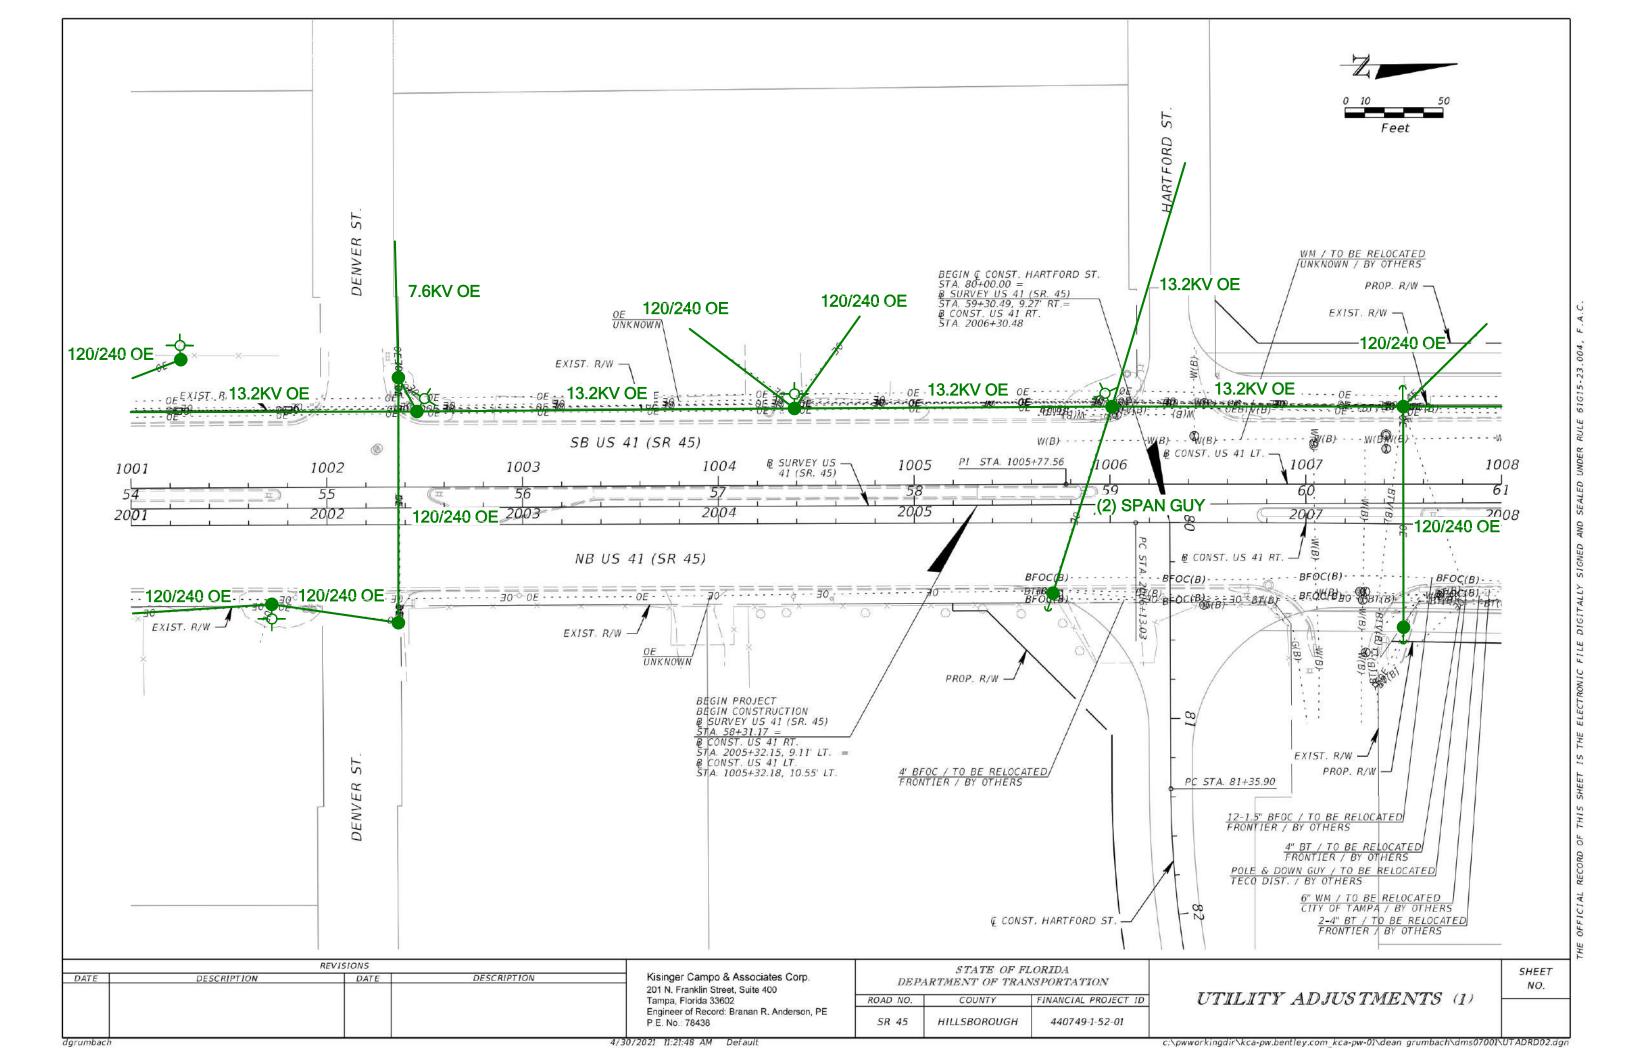


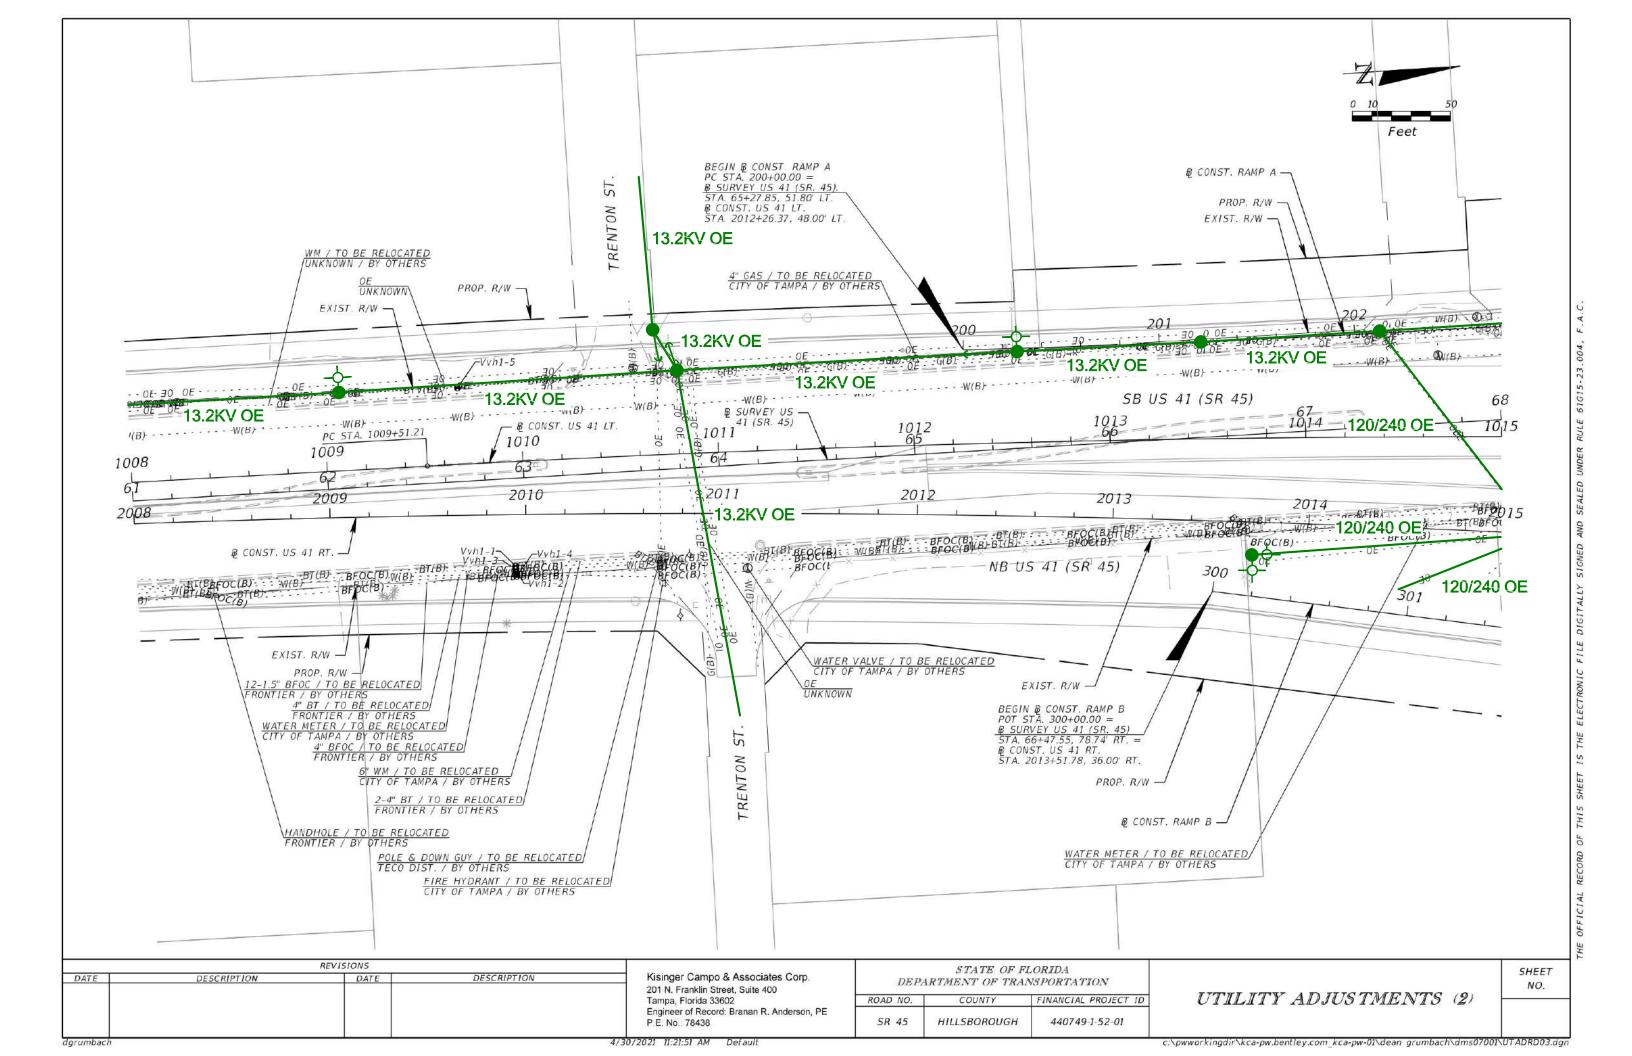


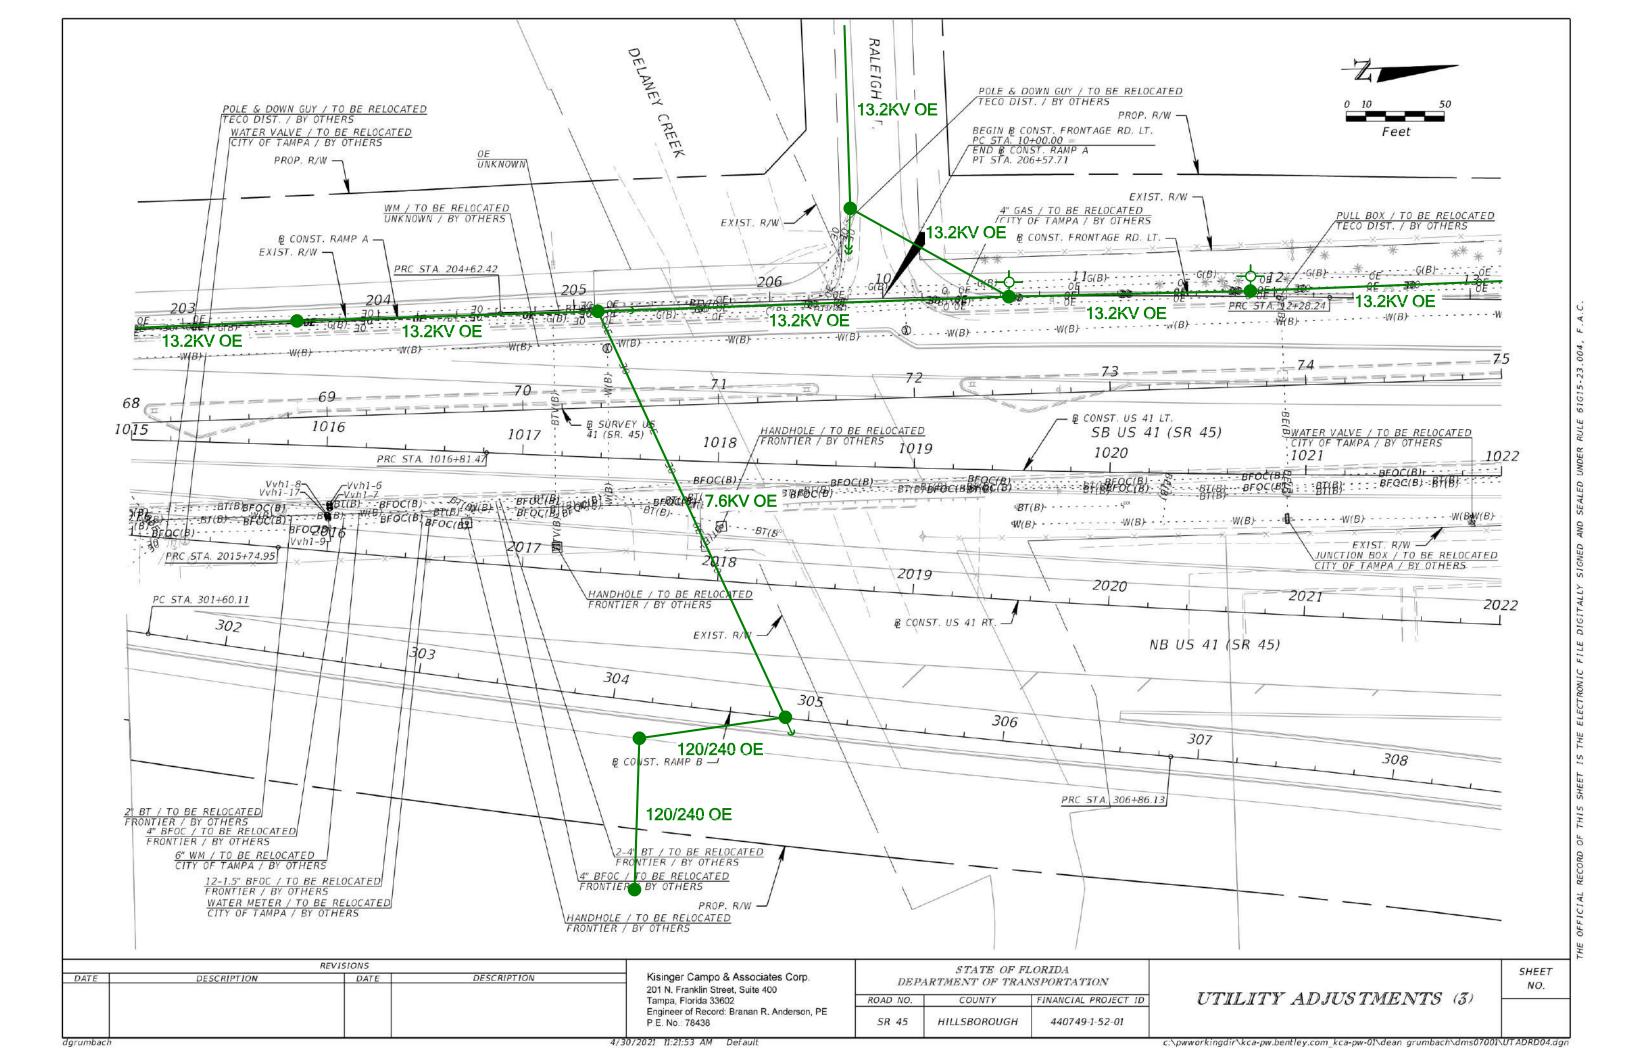


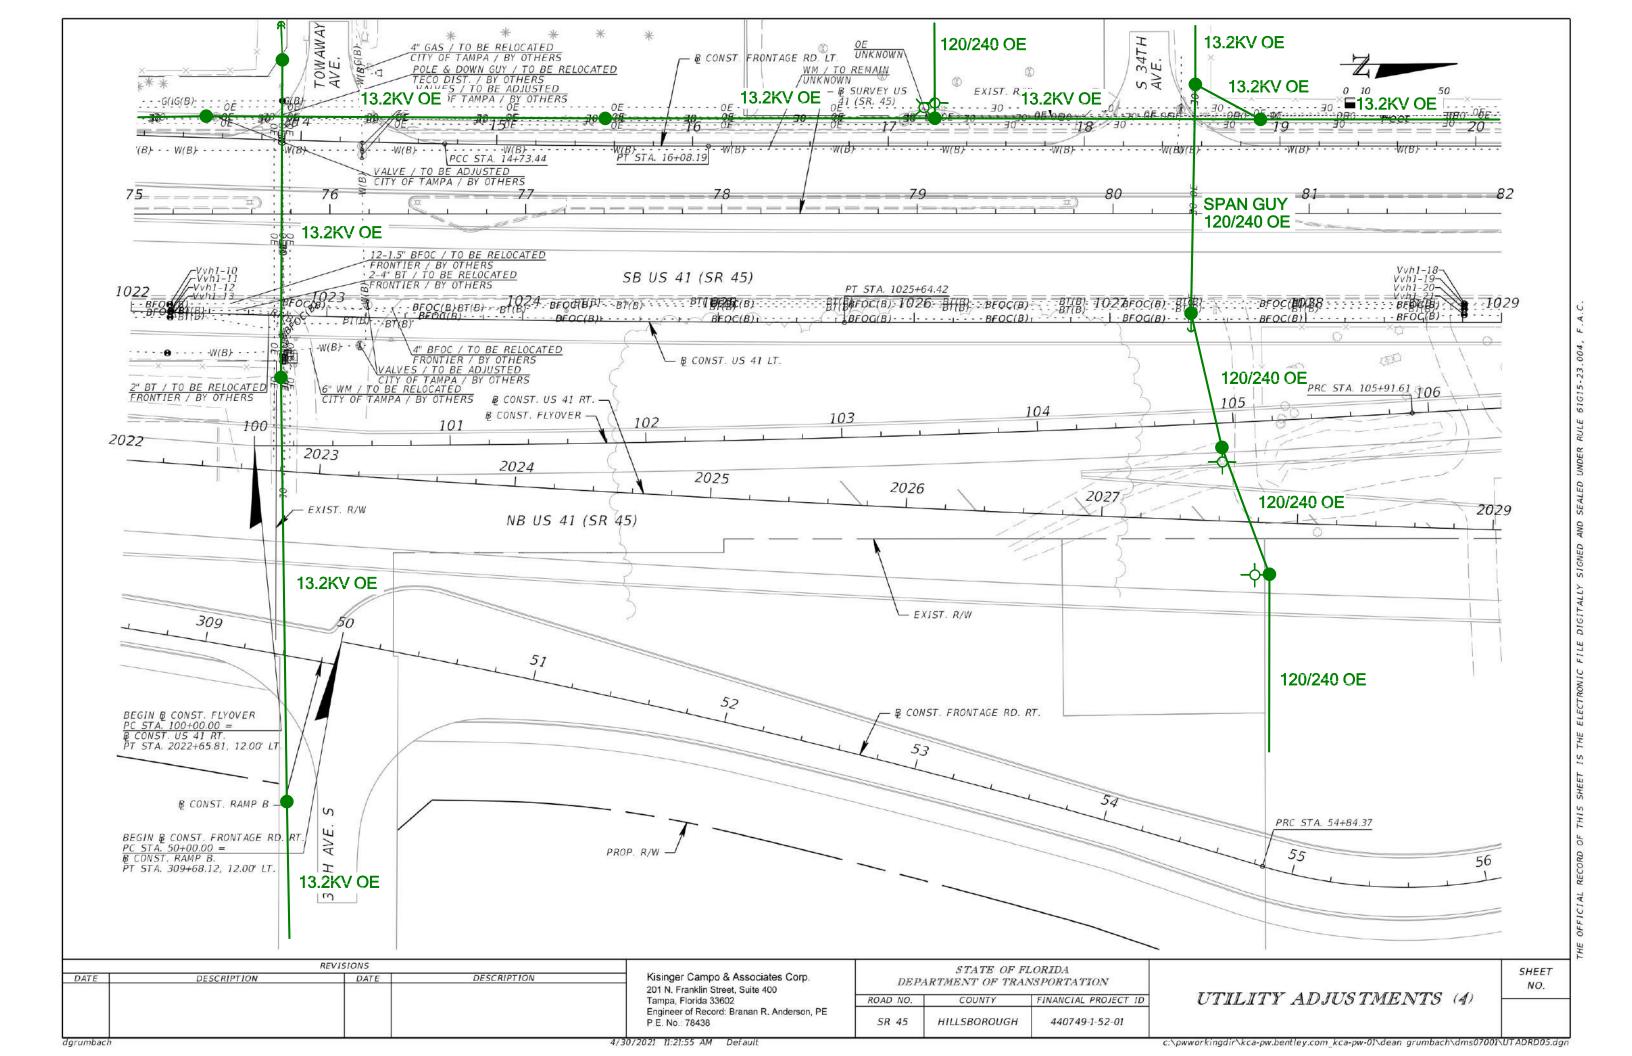


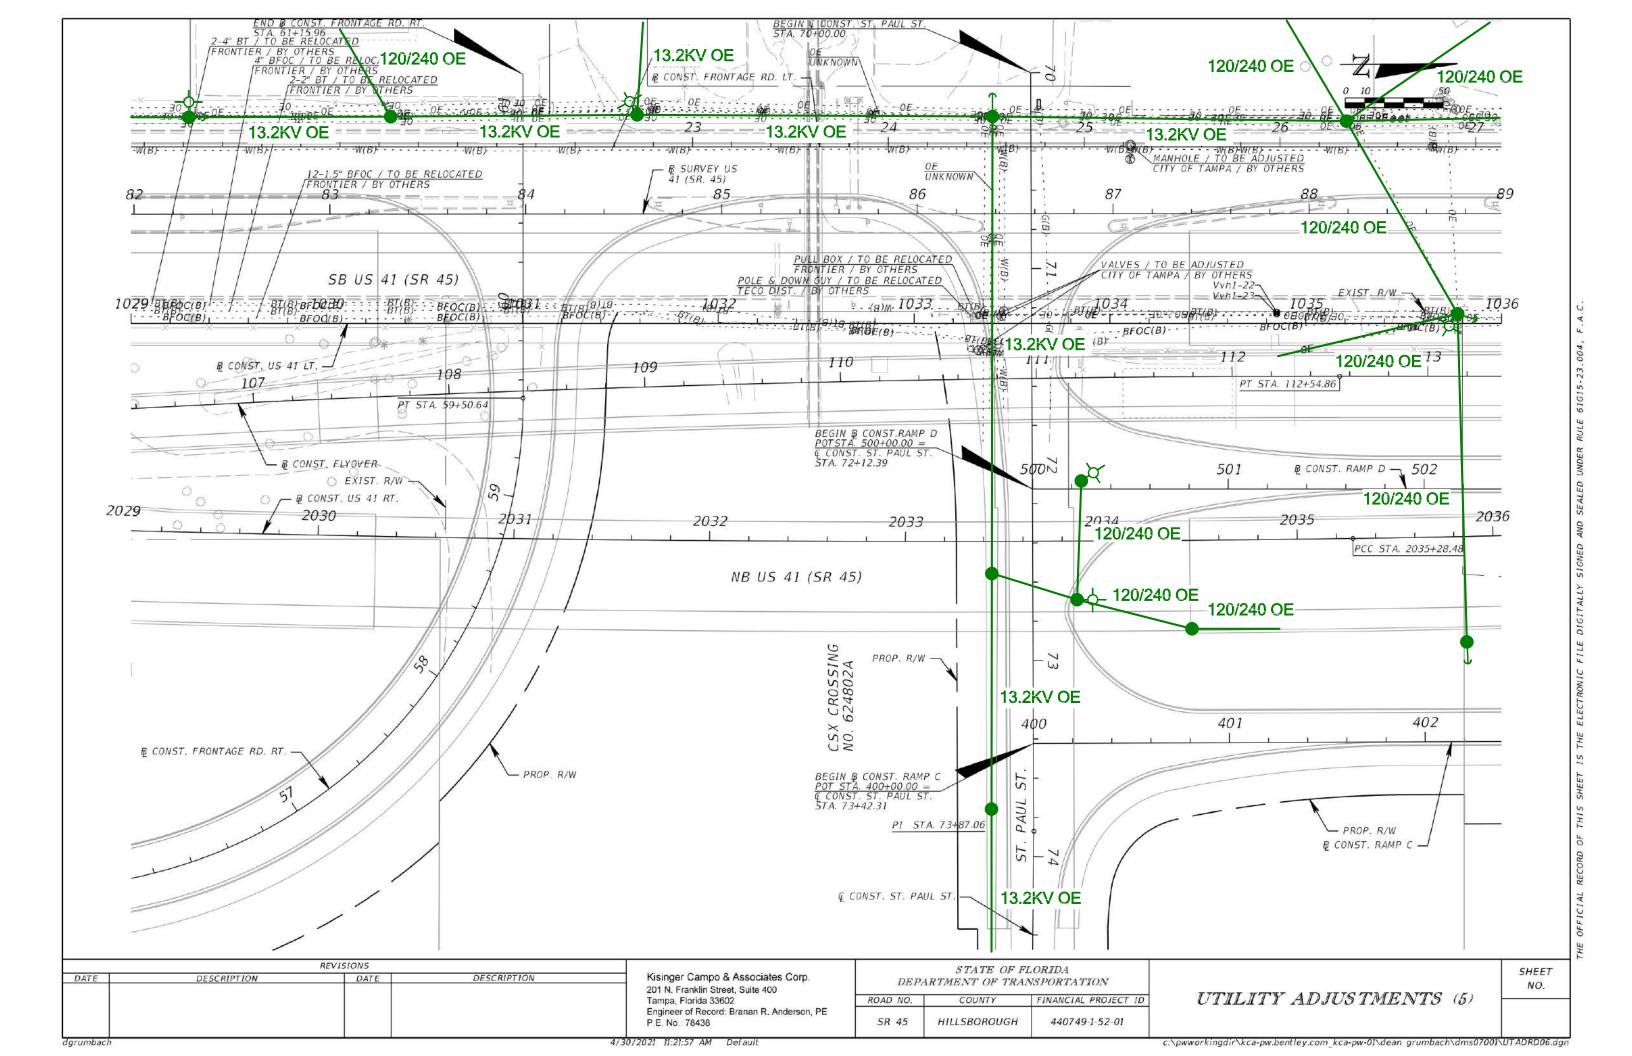


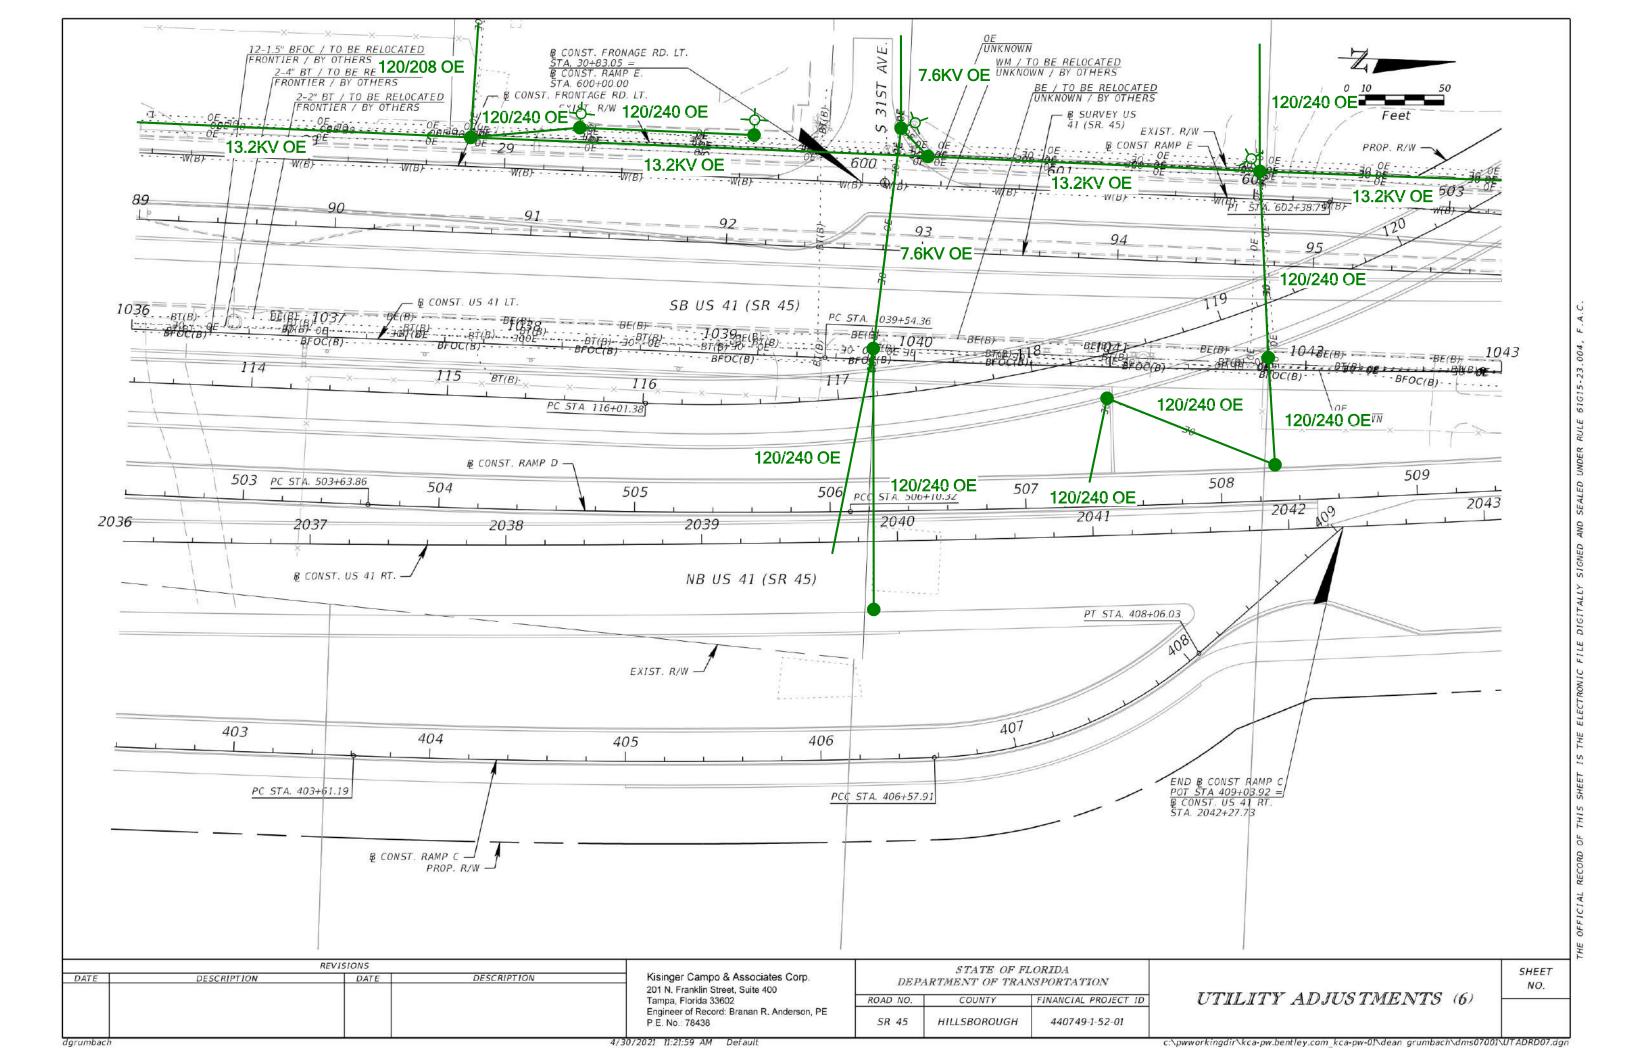


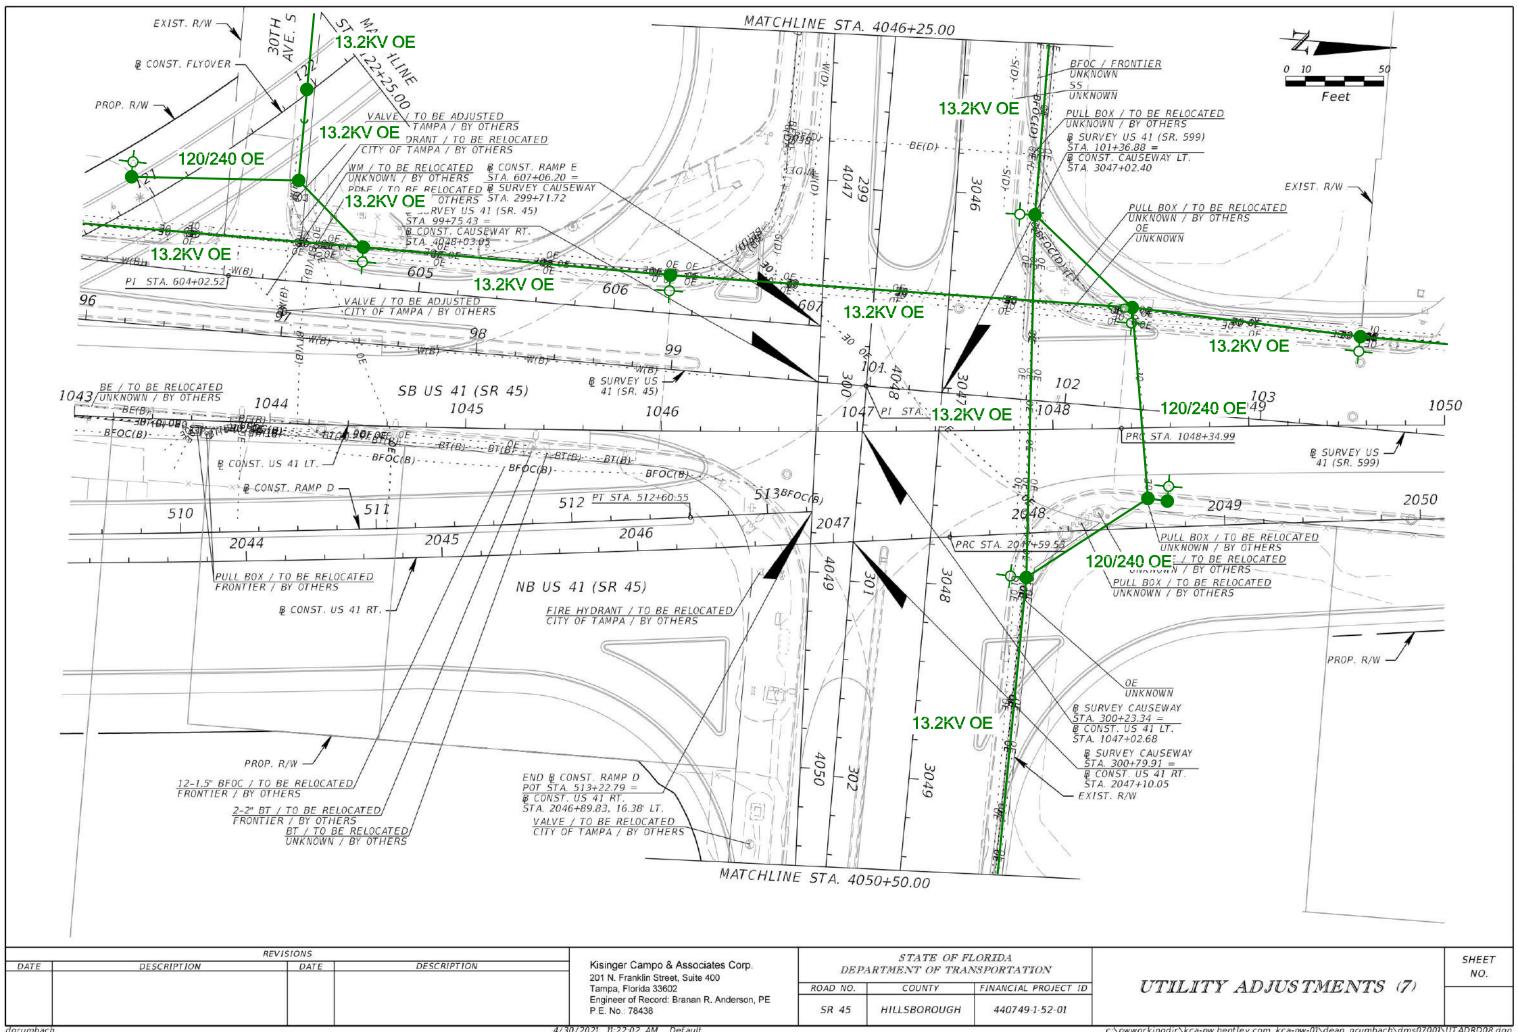


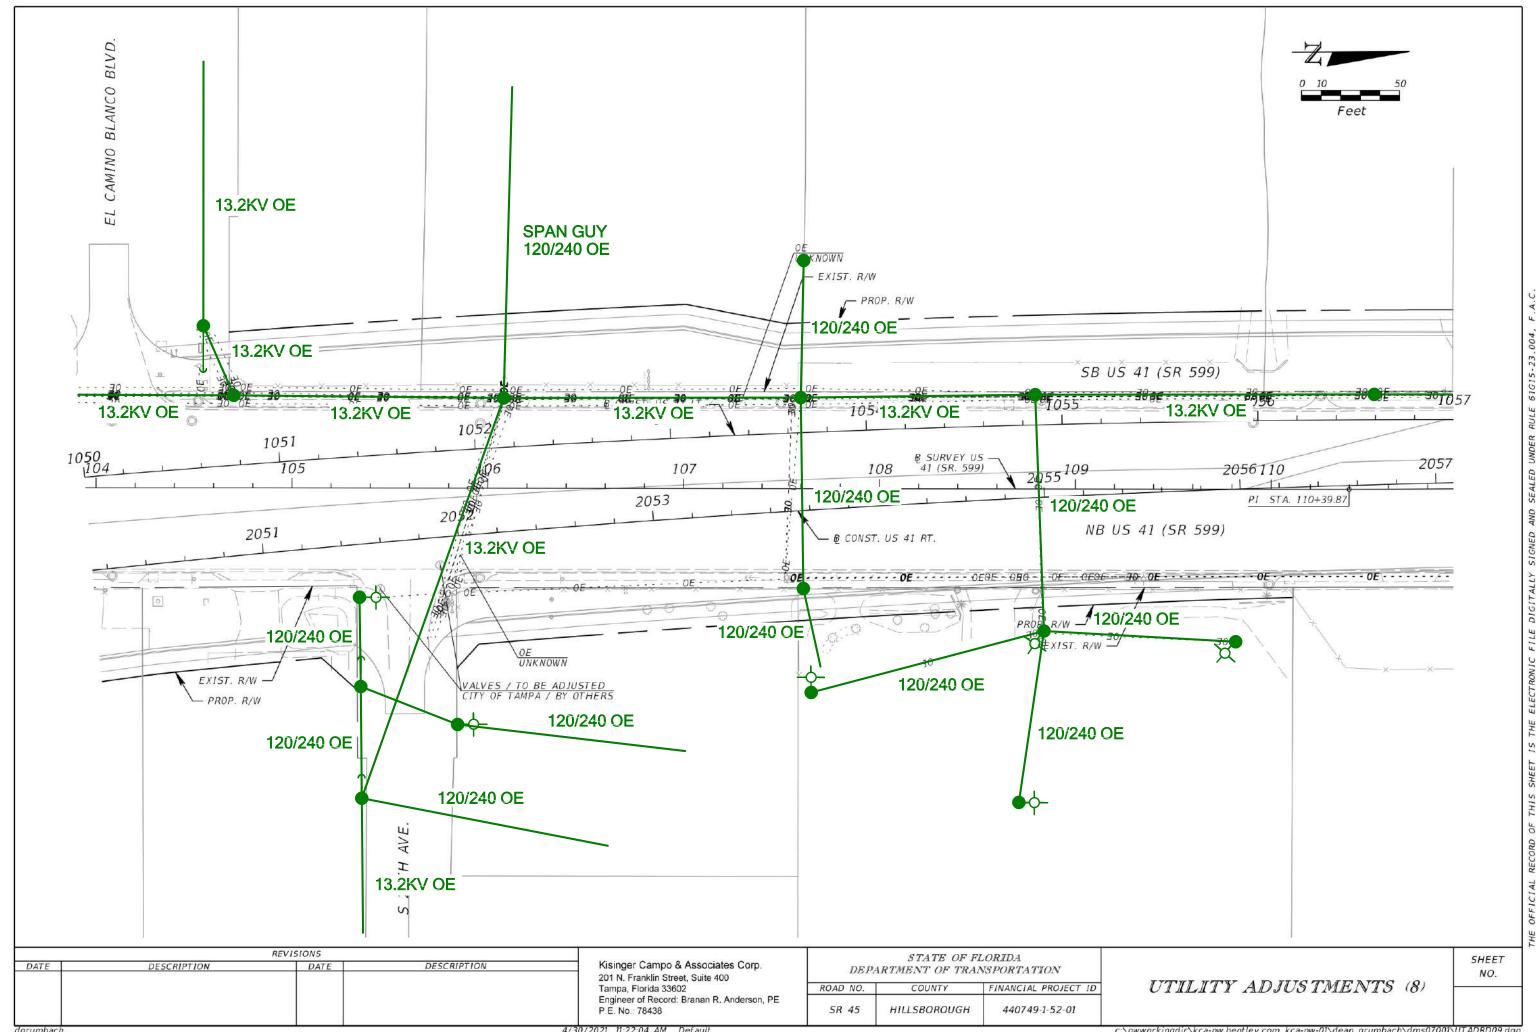

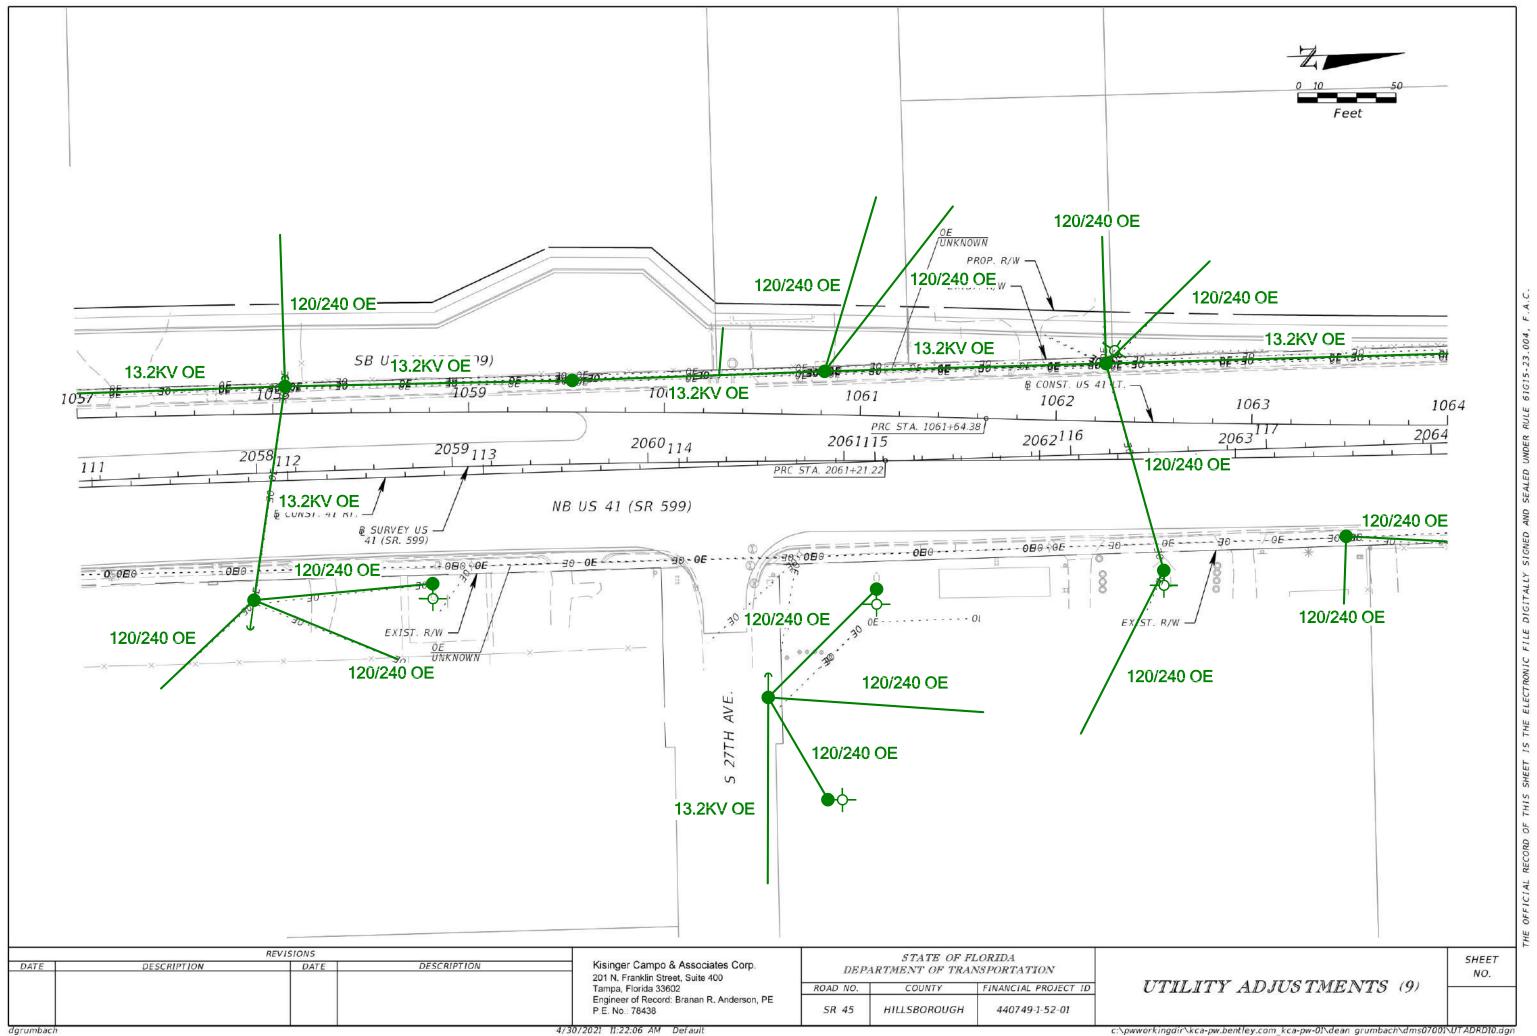

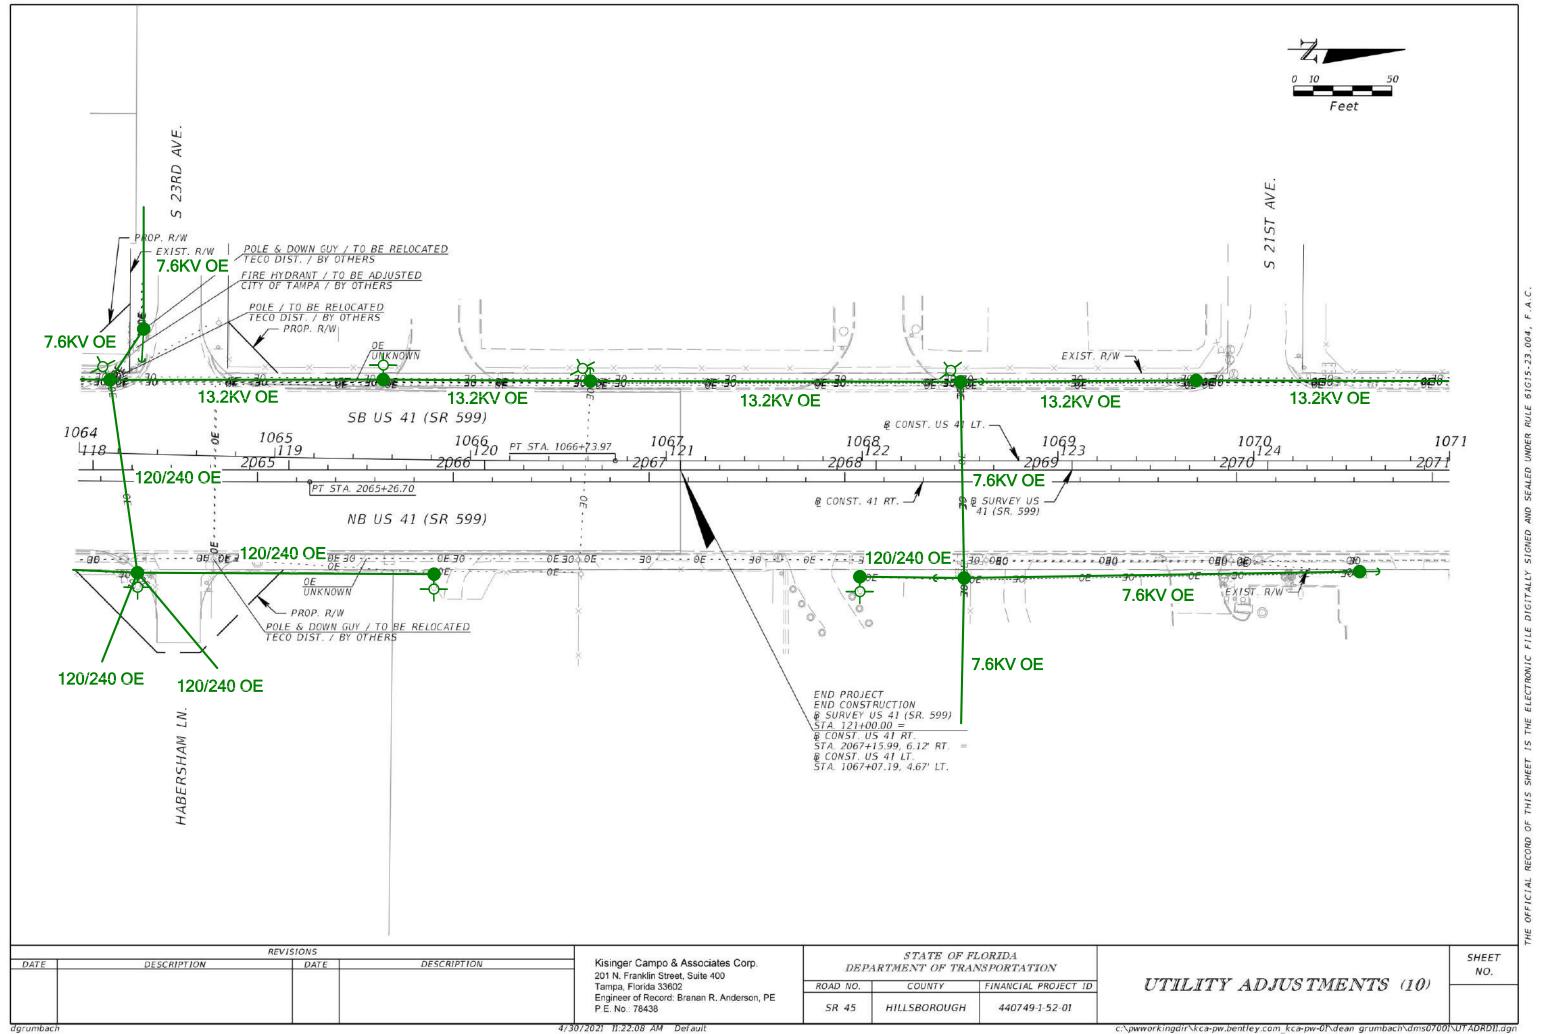


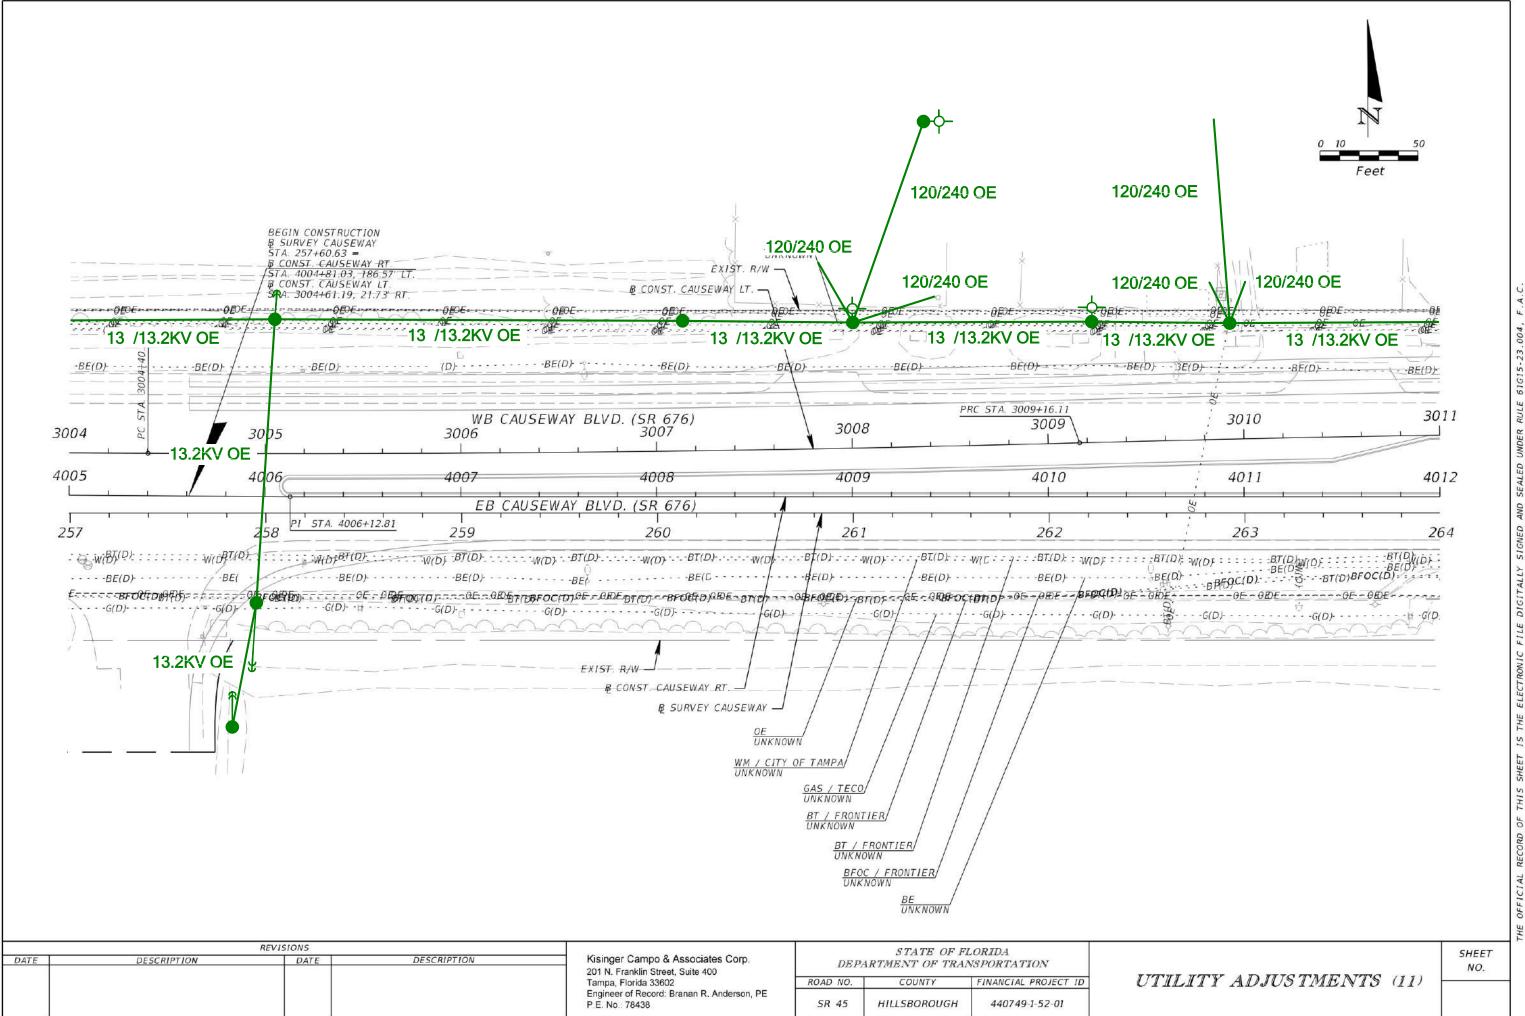


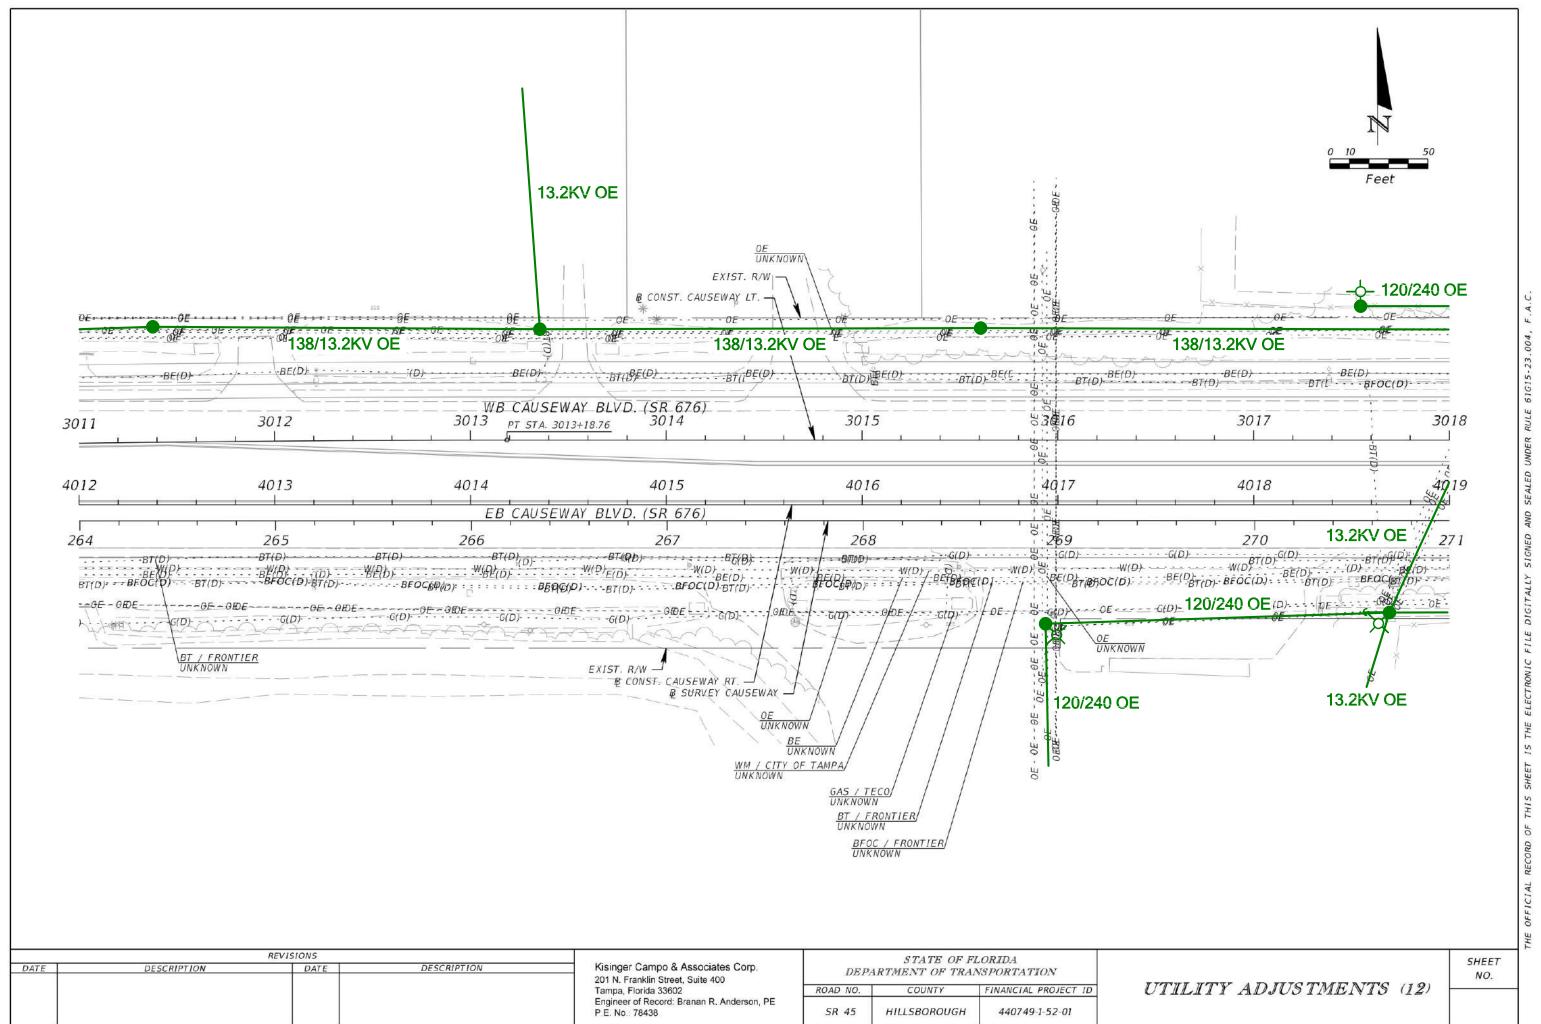



4/30/2021 11:22:12 AM Default


c:\pwworkingdir\kca-pw.bentley.com_kca-pw-01\dean_grumbach\dms07001\UTADRD15.dg

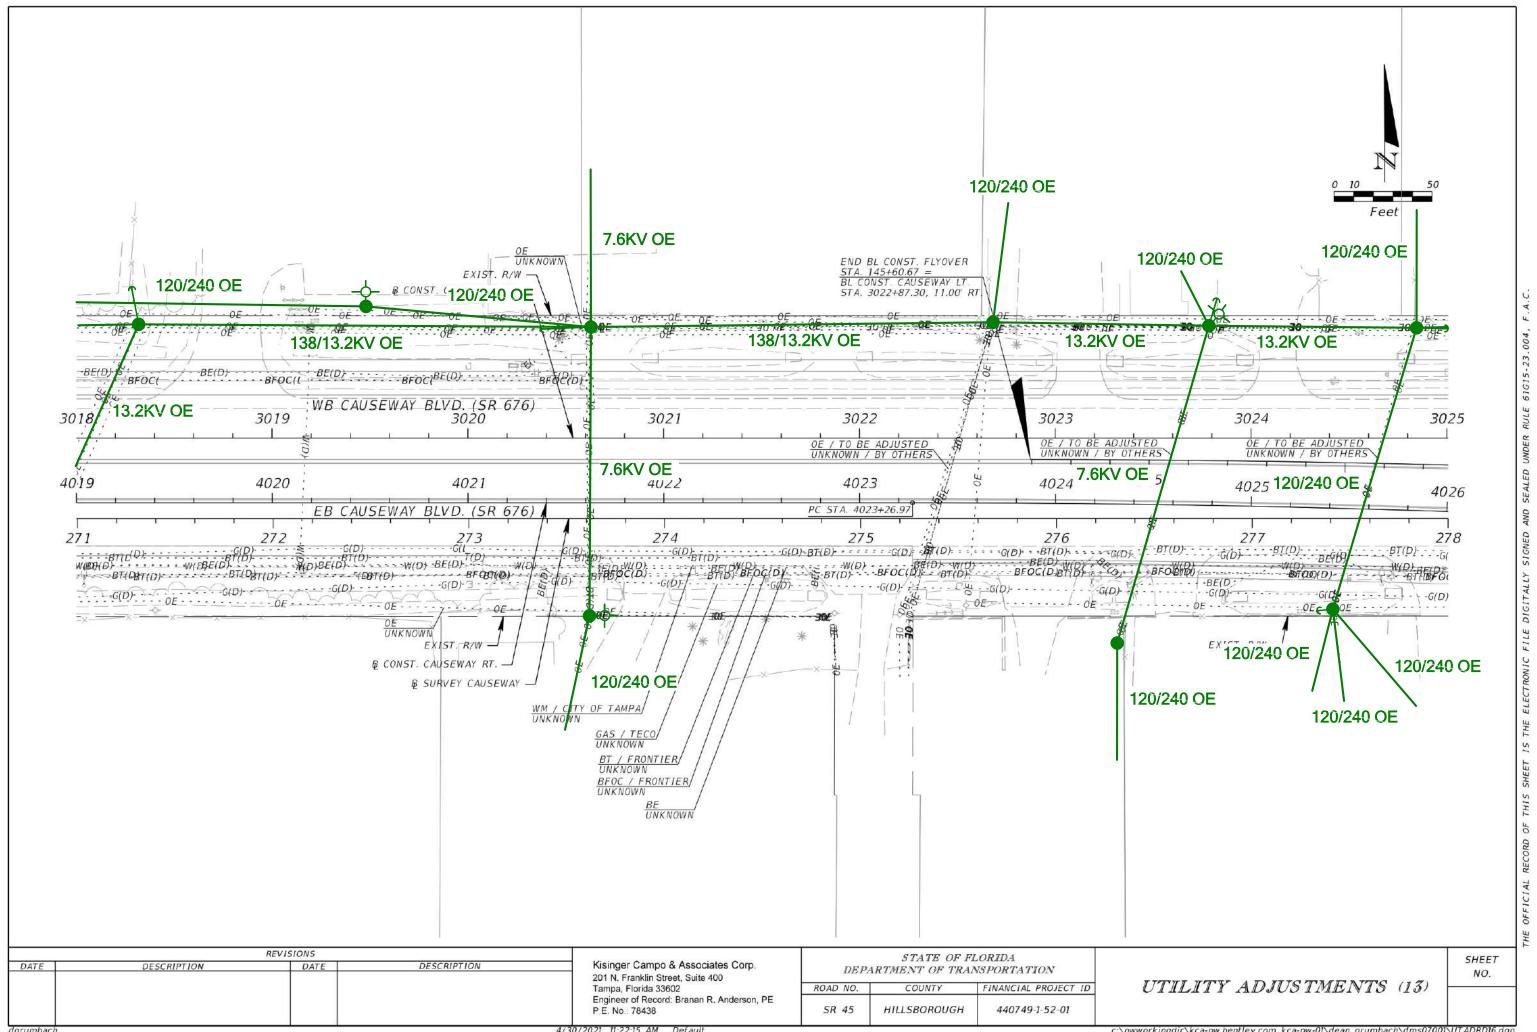


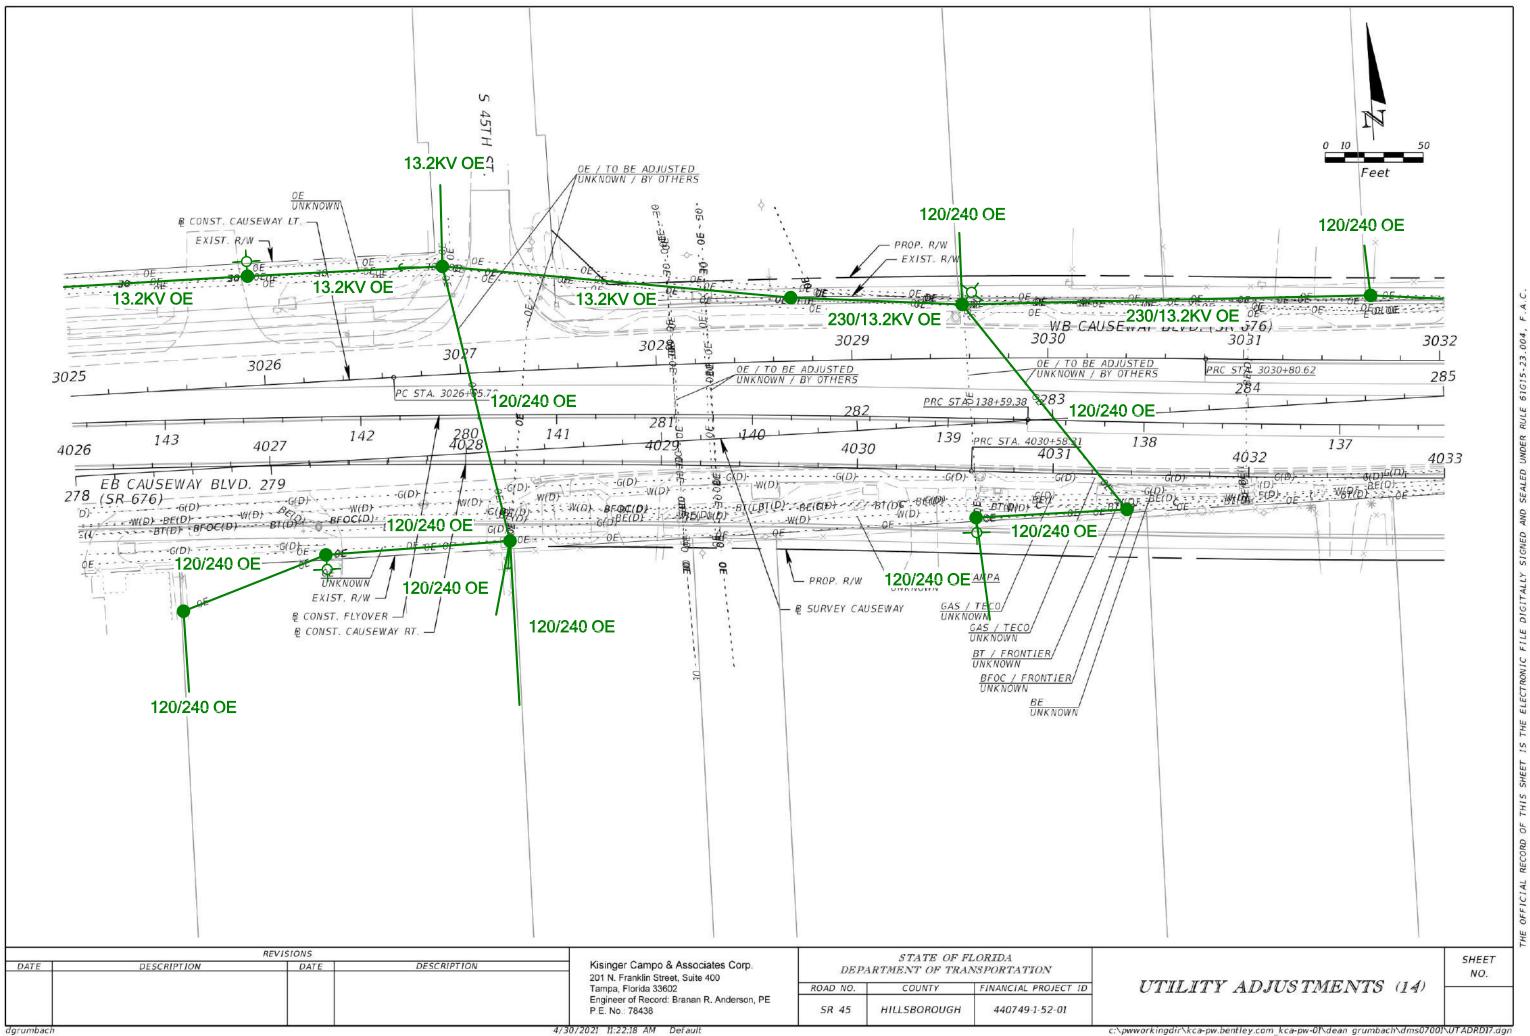

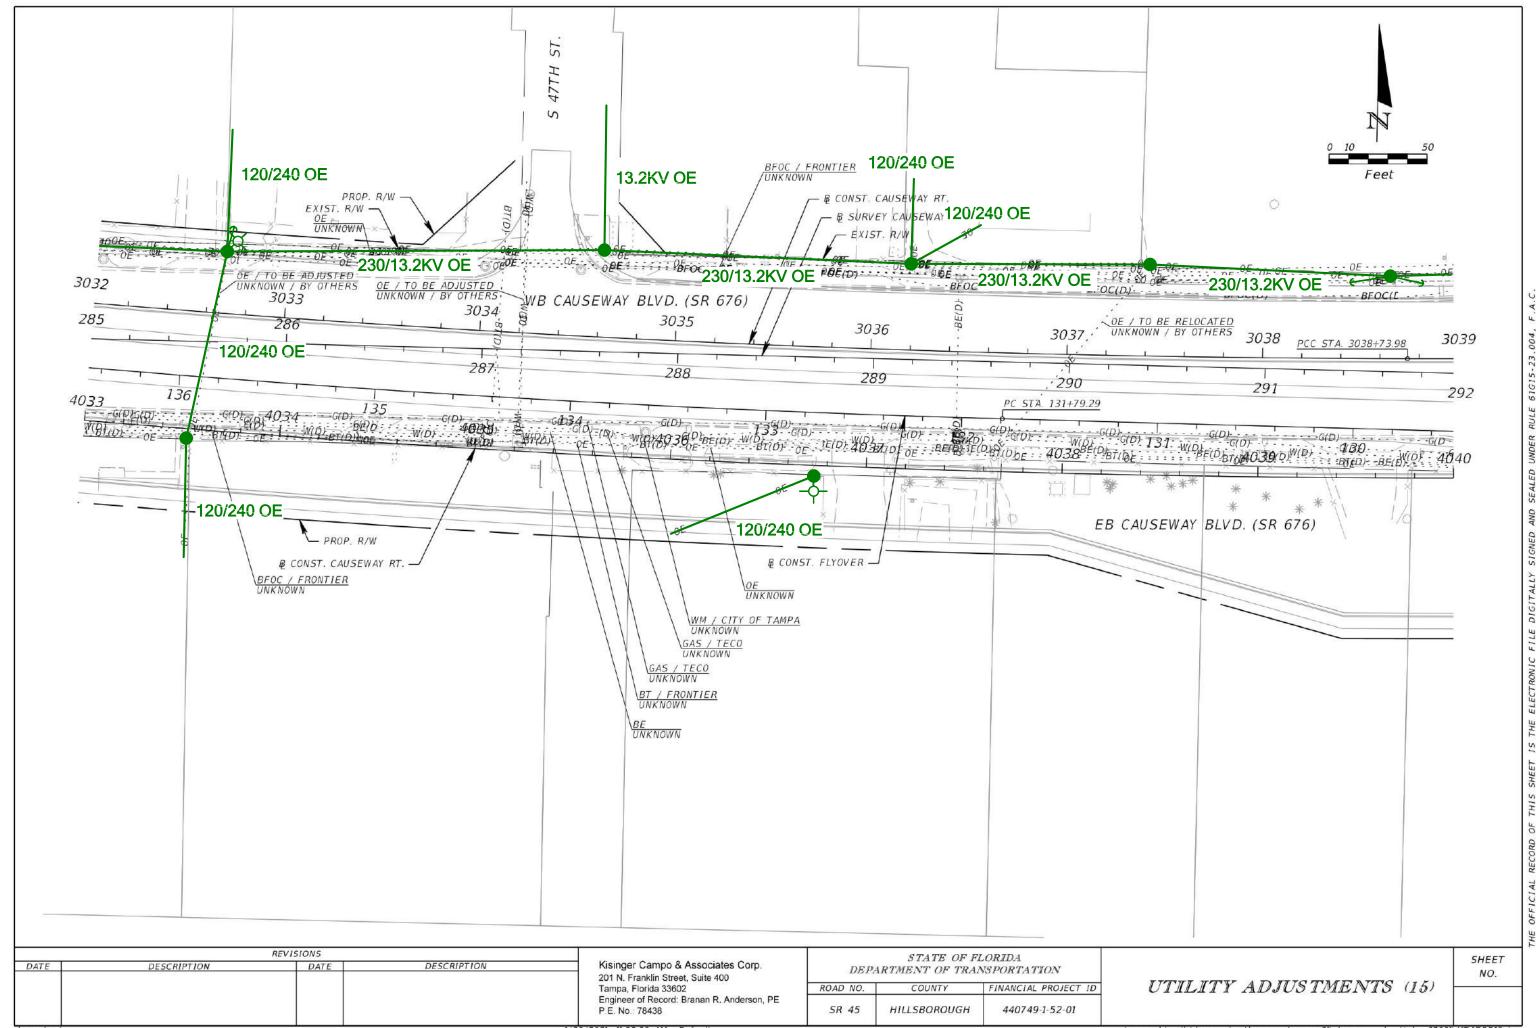

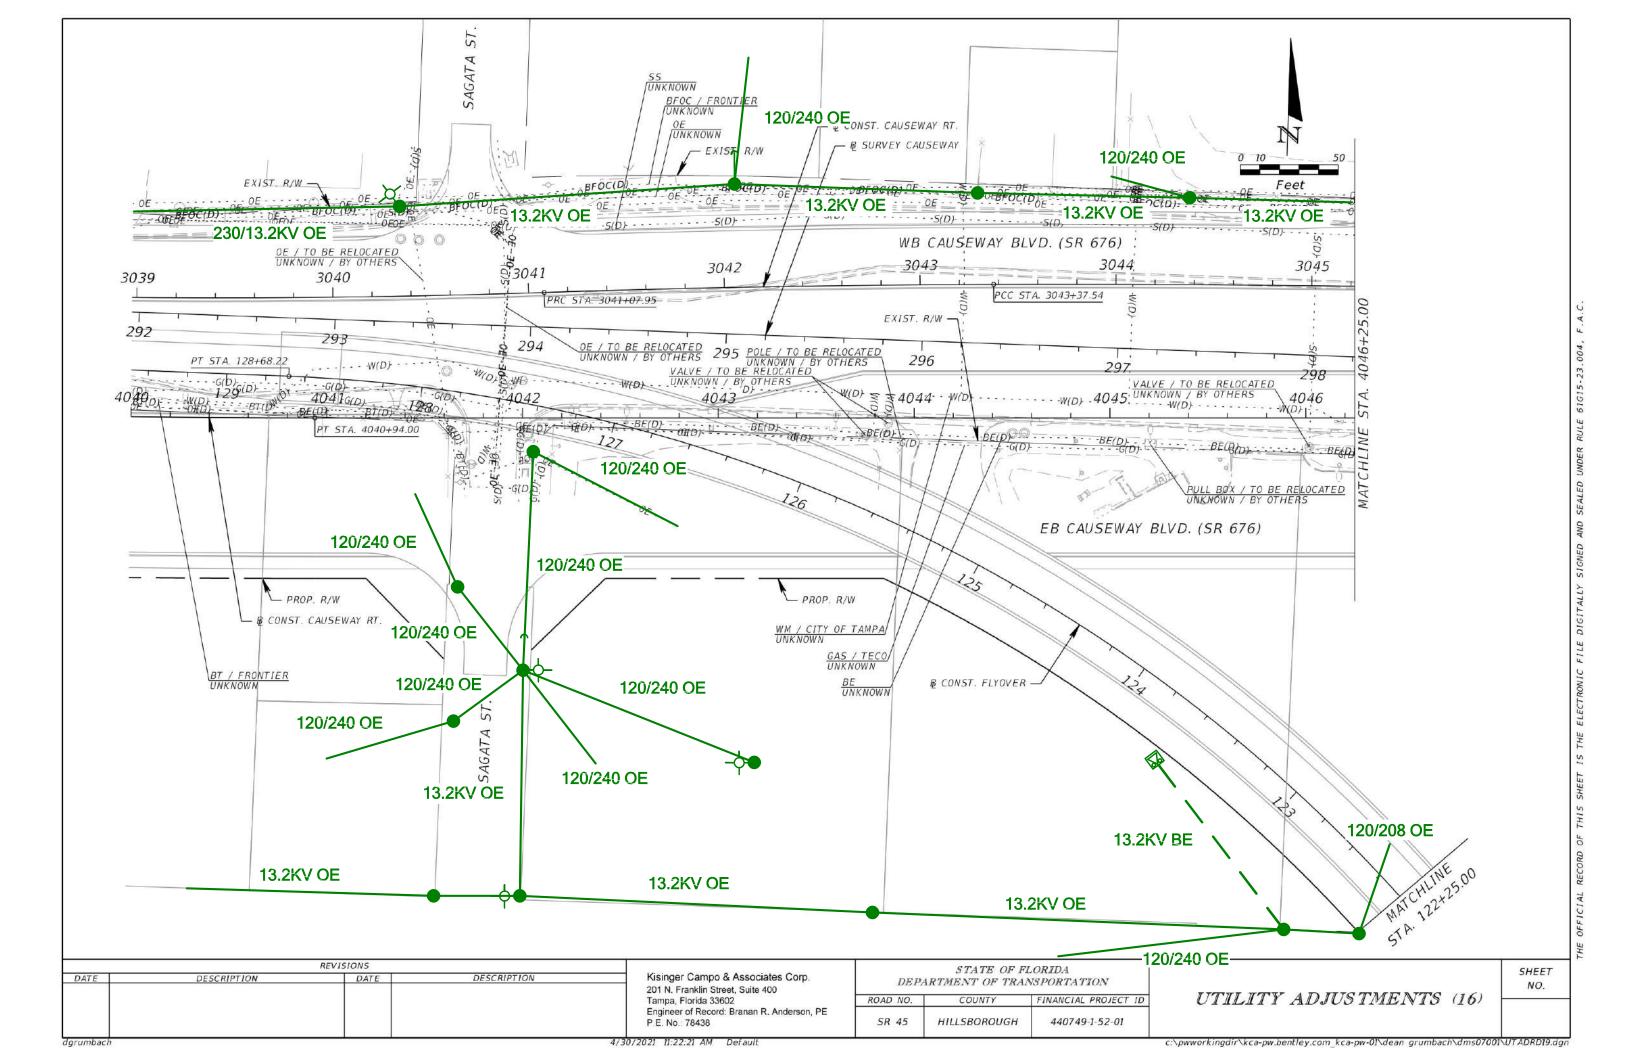

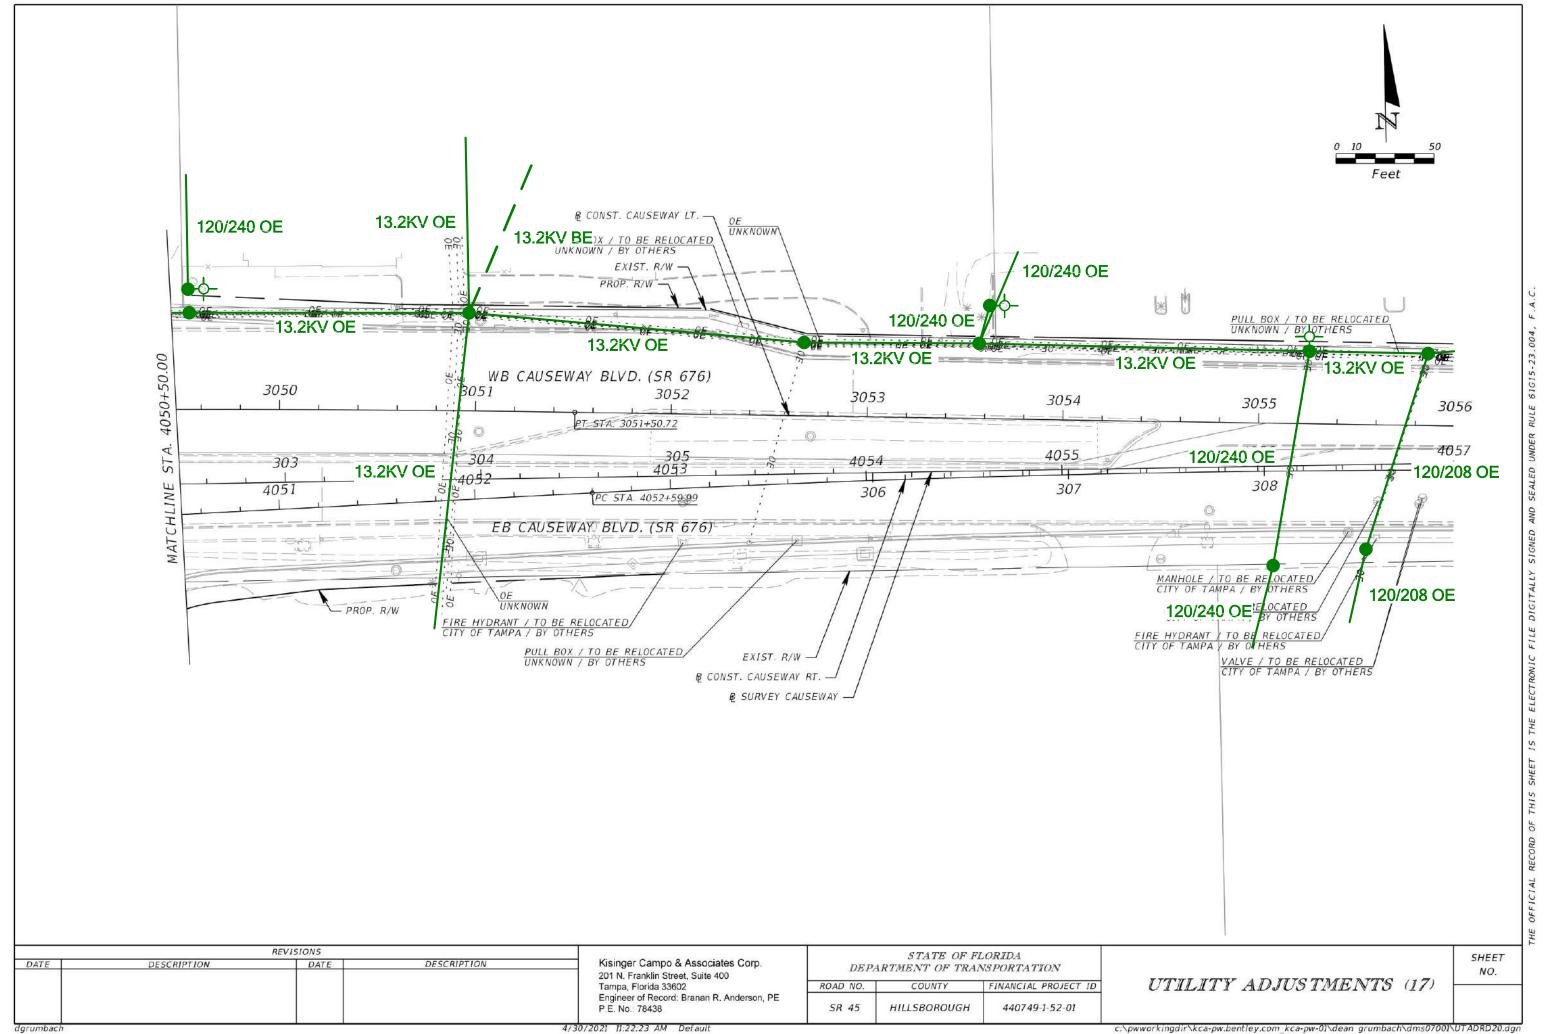


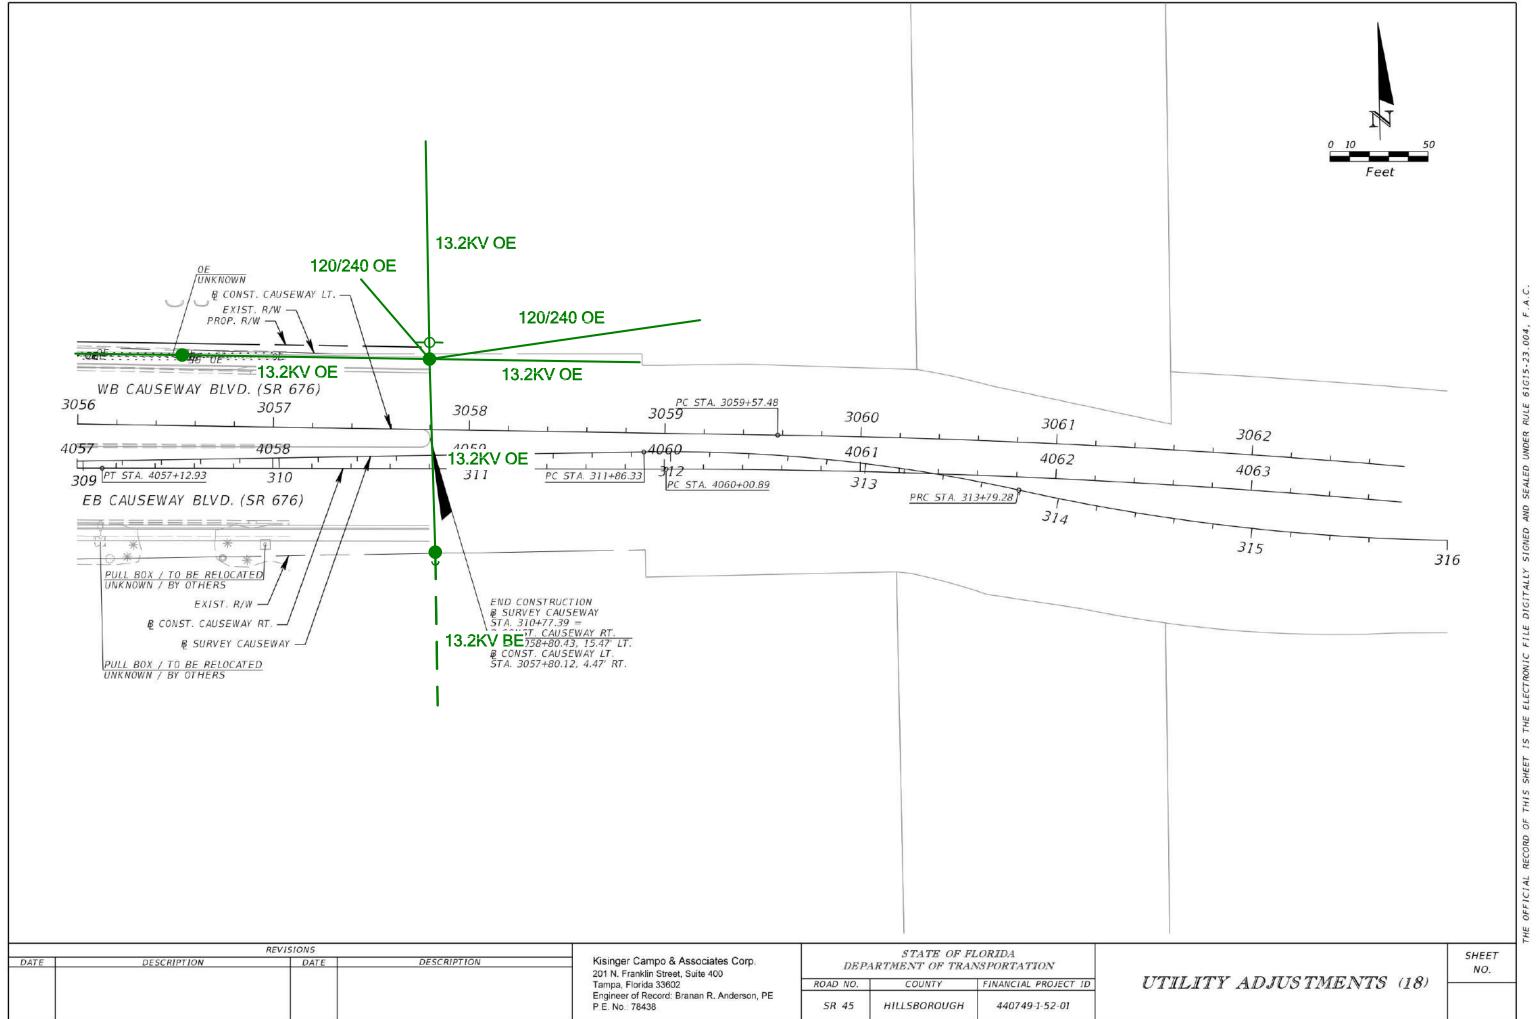

STATE OF FLORIDA DEPARTMENT OF TRANSPORTATION

CONTRACT PLANS

FINANCIAL PROJECT ID 440749-1-52-01

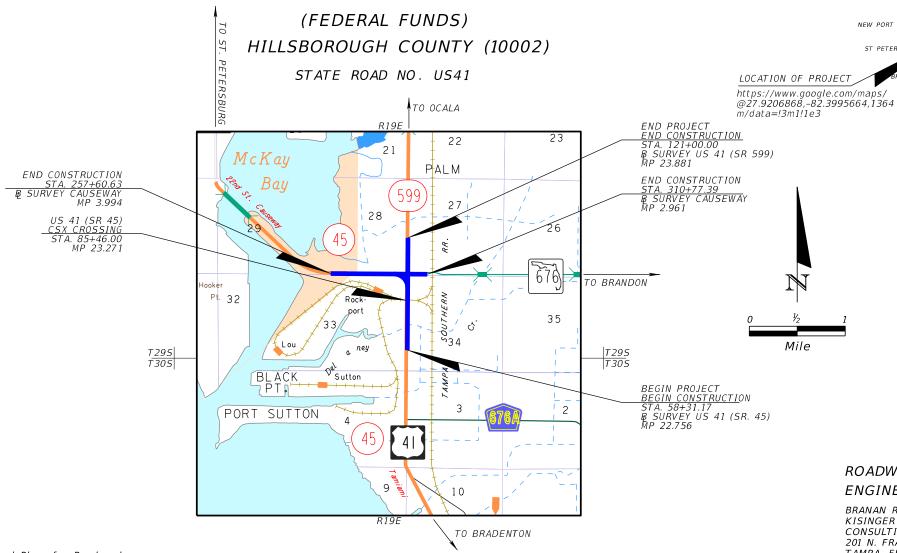

GOVERNING STANDARD PLANS:

Florida Department of Transportation, FY2021-22 Standard Plans for Road and Bridge Construction and applicable Interim Revisions (IRs).

Standard Plans for Road Construction and associated IRs are available at the following website: http://www.fdot.gov/design/standardplans

APPLICABLE IRs: N/A

Standard Plans for Bridge Construction are included in the Structures Plans Component

GOVERNING STANDARD SPECIFICATIONS:

Florida Department of Transportation, July 2022 Standard Specifications for Road and Bridge Construction at the following website: http://www.fdot.gov/programmanagement/Implemented/SpecBooks

ROADWAY PLANS ENGINEER OF RECORD:

TAME

NAPLE

BRANAN R. ANDERSON, P.E. NO.: 78438 KISINGER CAMPO AND ASSOCIATES CORP. CONSULTING ENGINEERS & PLANNERS 201 N. FRANKLIN STREET, SUITE 400 TAMPA, FLORIDA 33602 (813) 871-5331 VENDOR NUMBER.: F59-1677145

FDOT PROJECT MANAGER:

TIM O'BRIEN P.E.


Mile


CONSTRUCTION	FISCAL	SHEET
CONTRACT NO.	YEAR	NO.
TBD	21	1


AYTONA BEACH


PIERCE


4/13/2021 2:47:16 PM dgrumbach Def aul

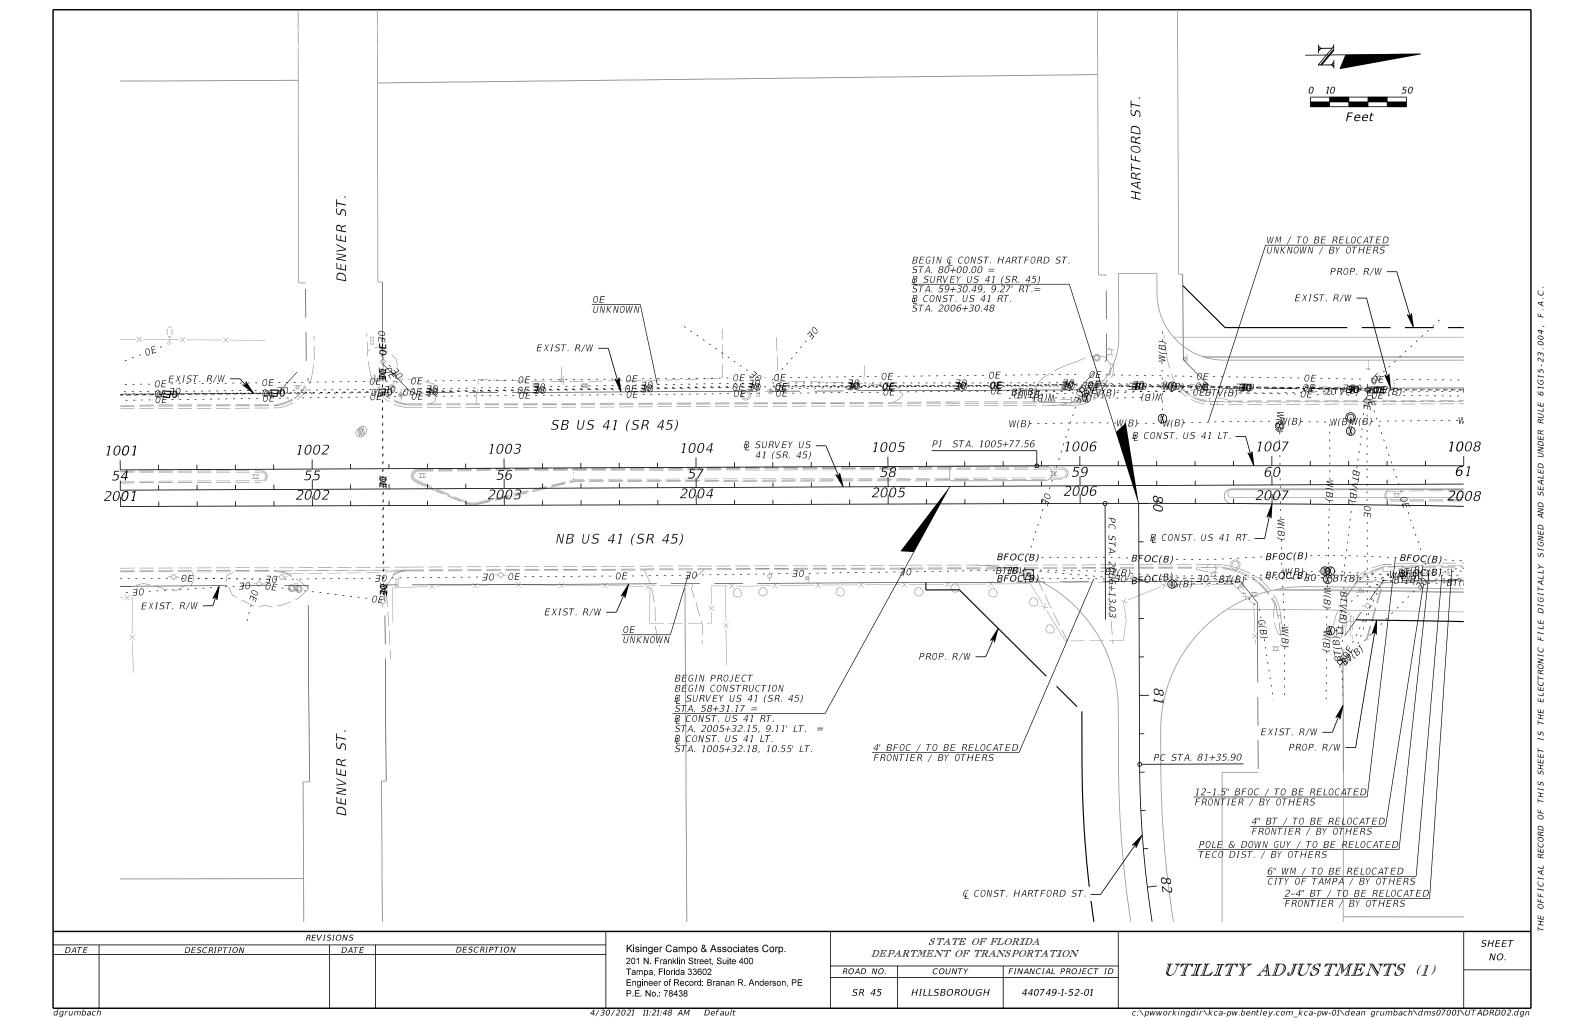


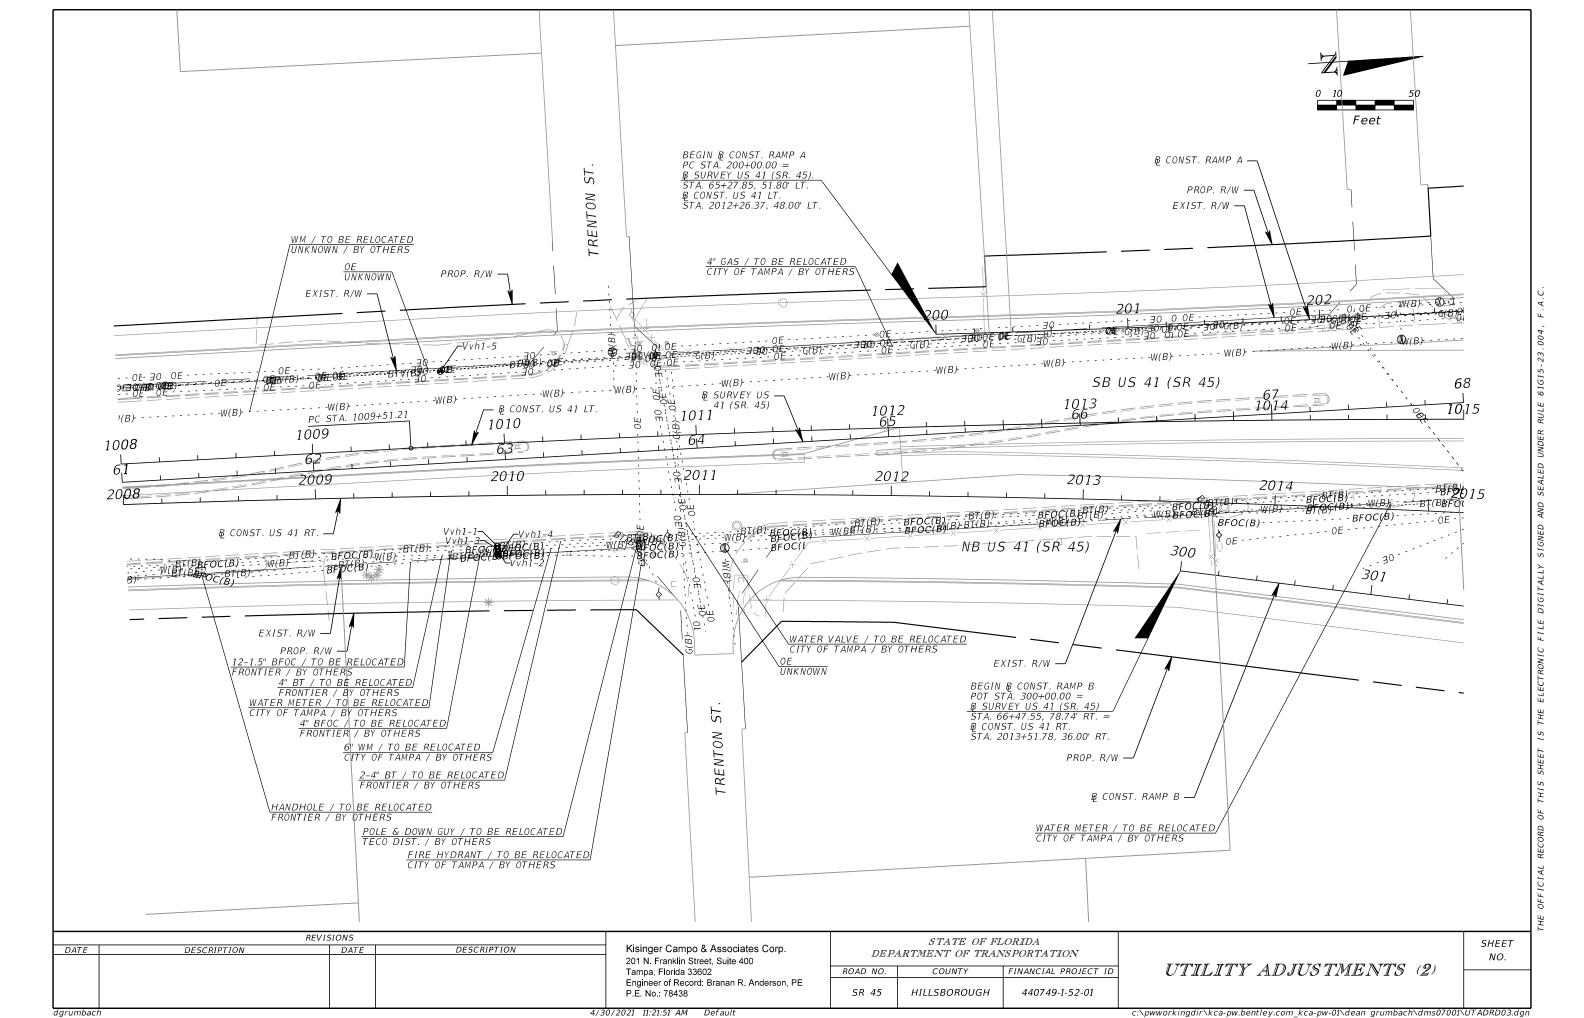


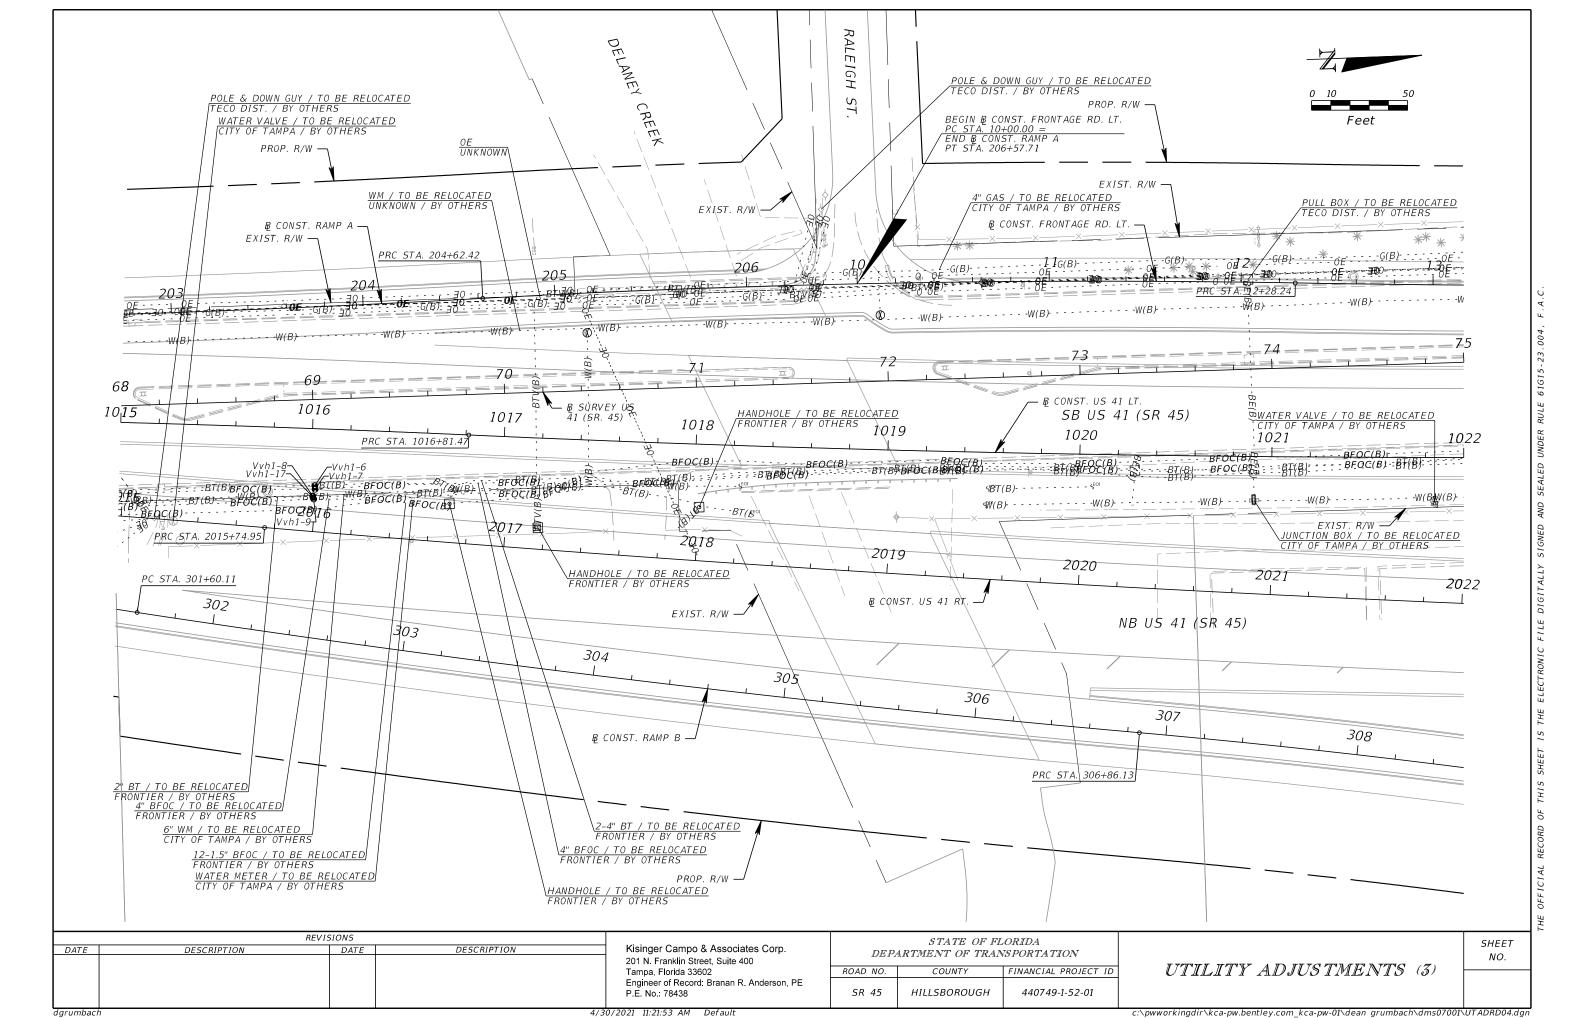


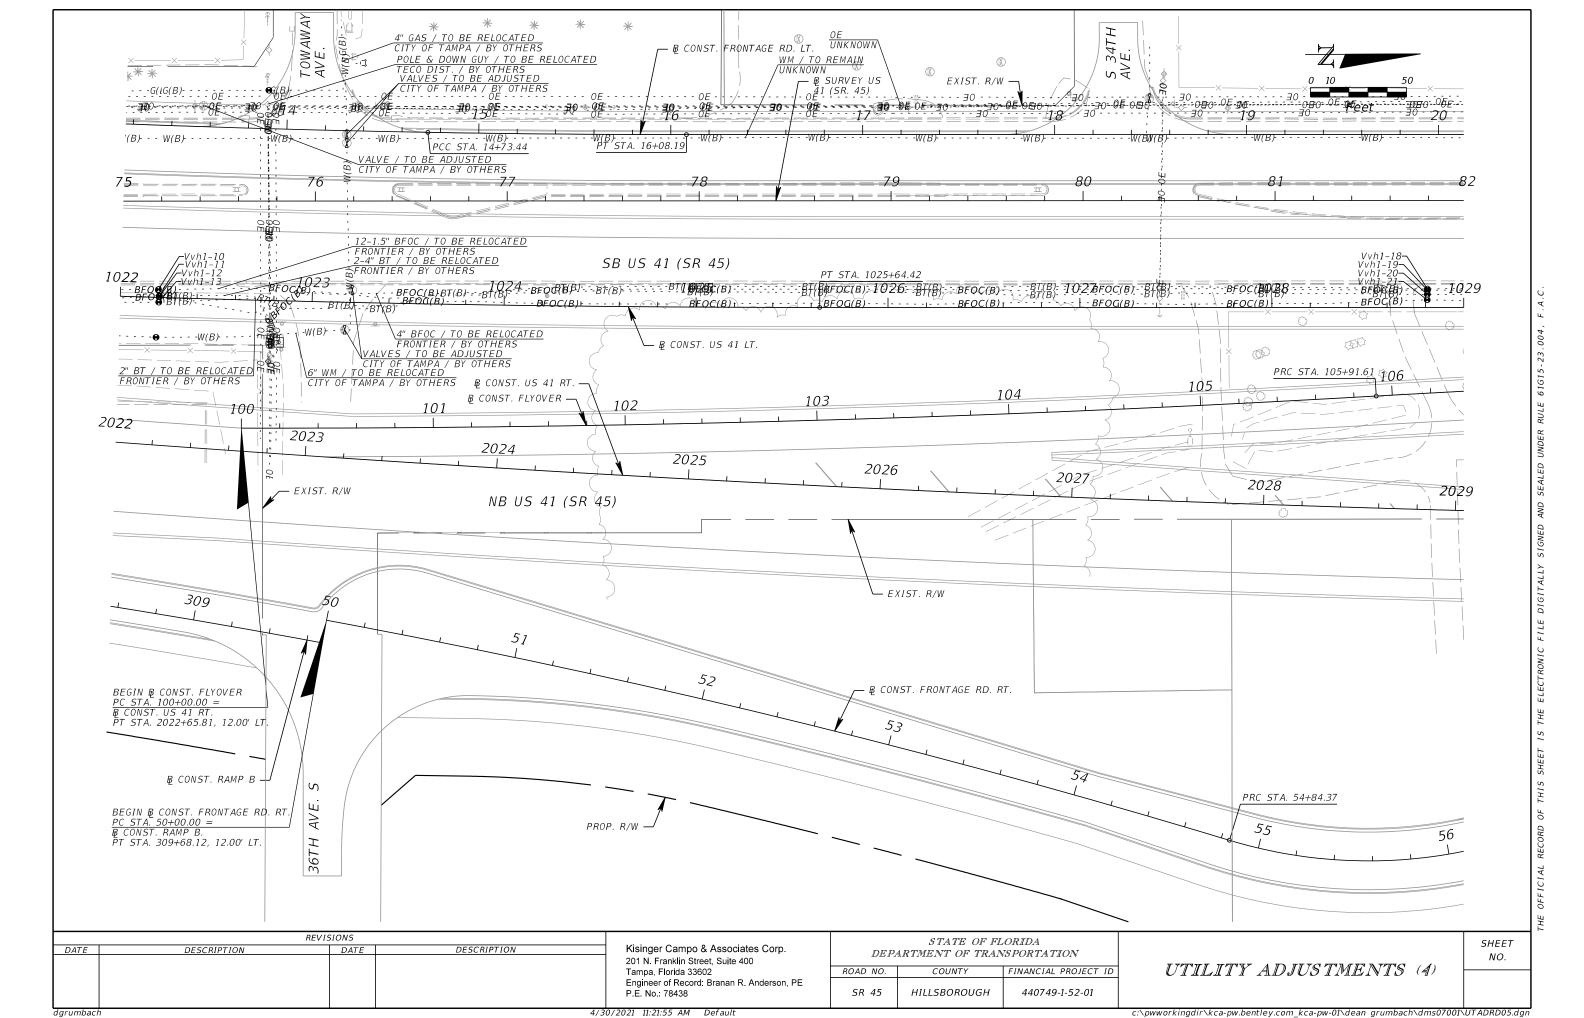


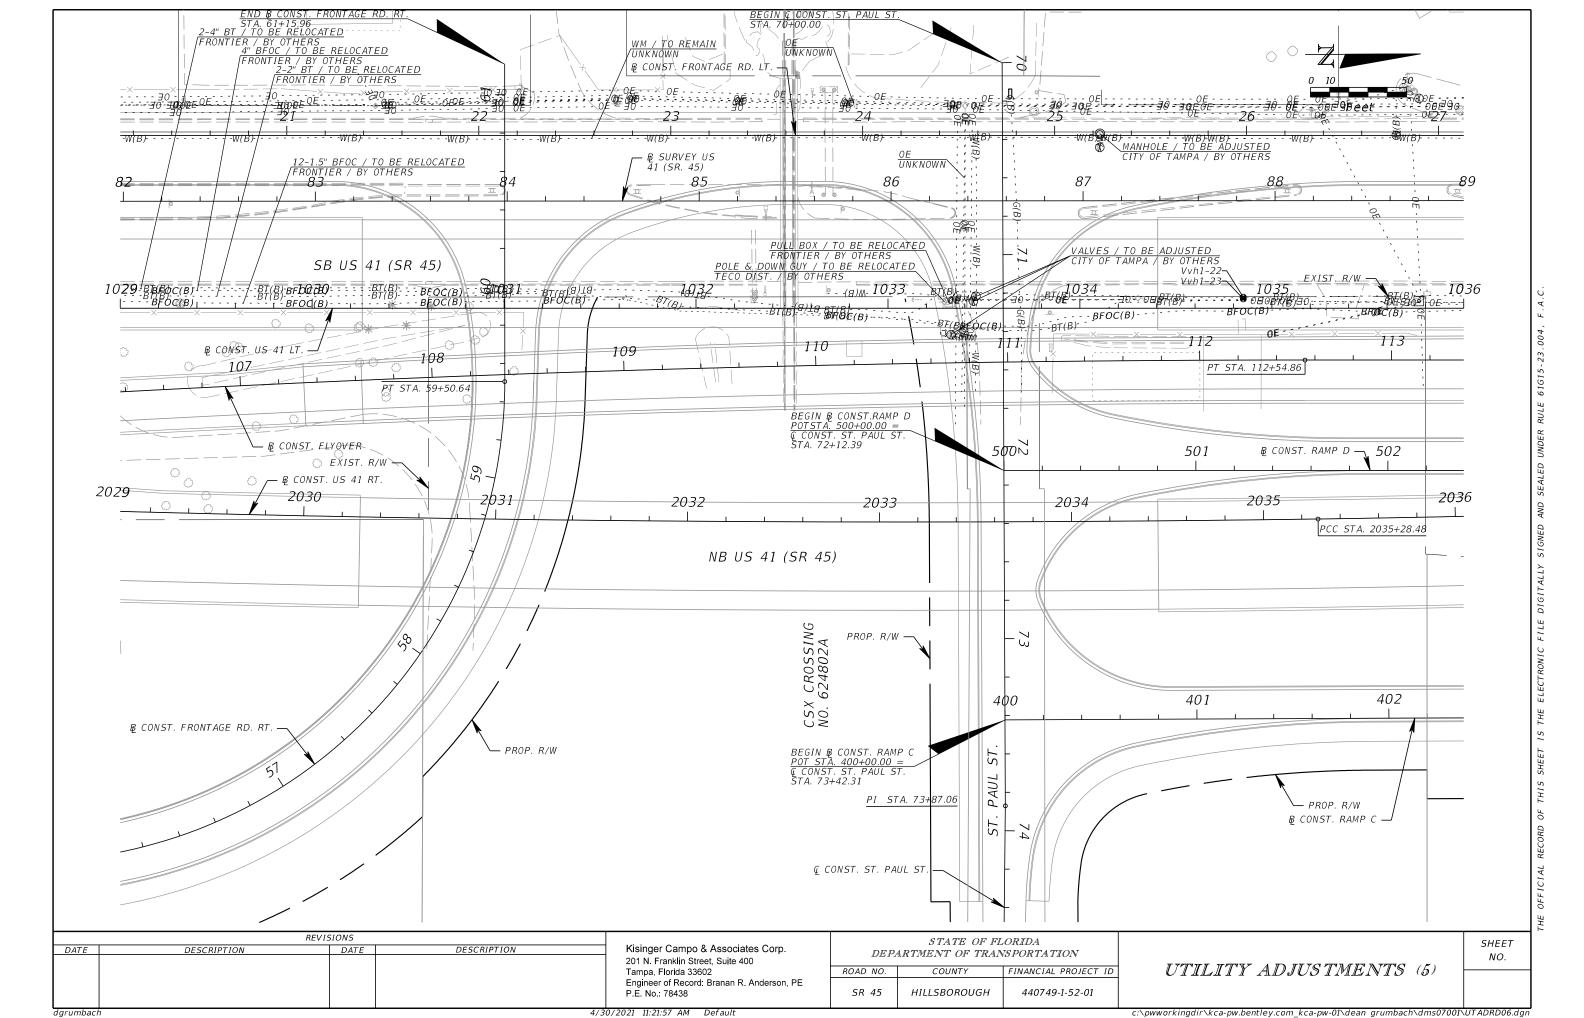


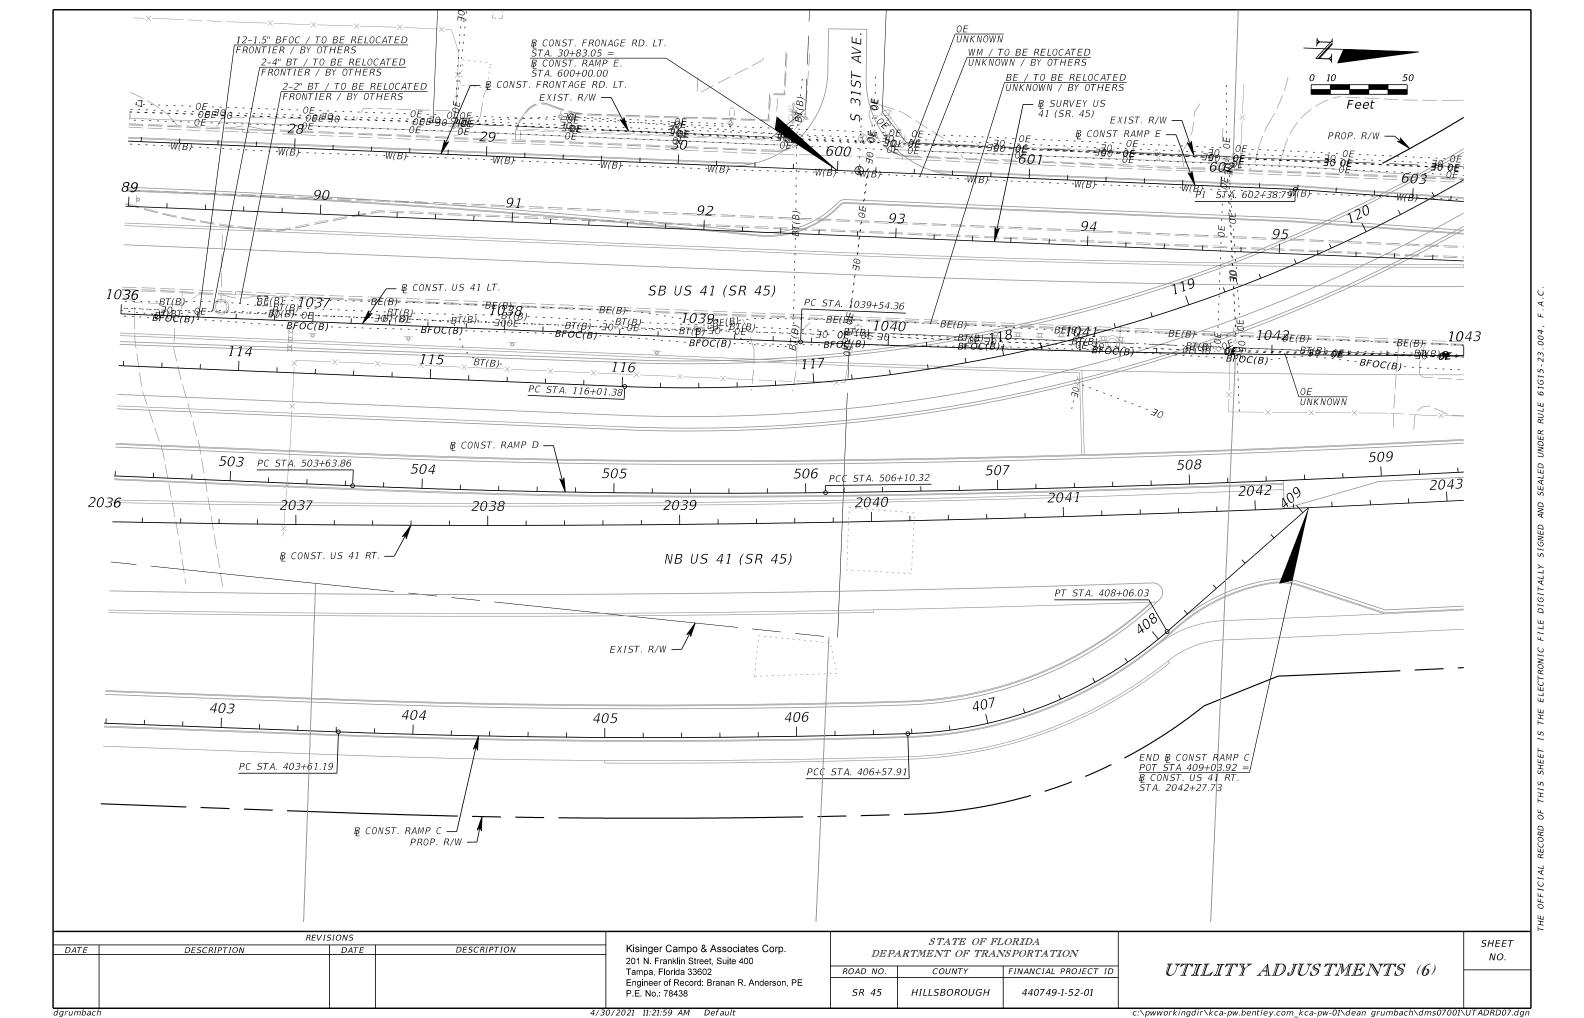


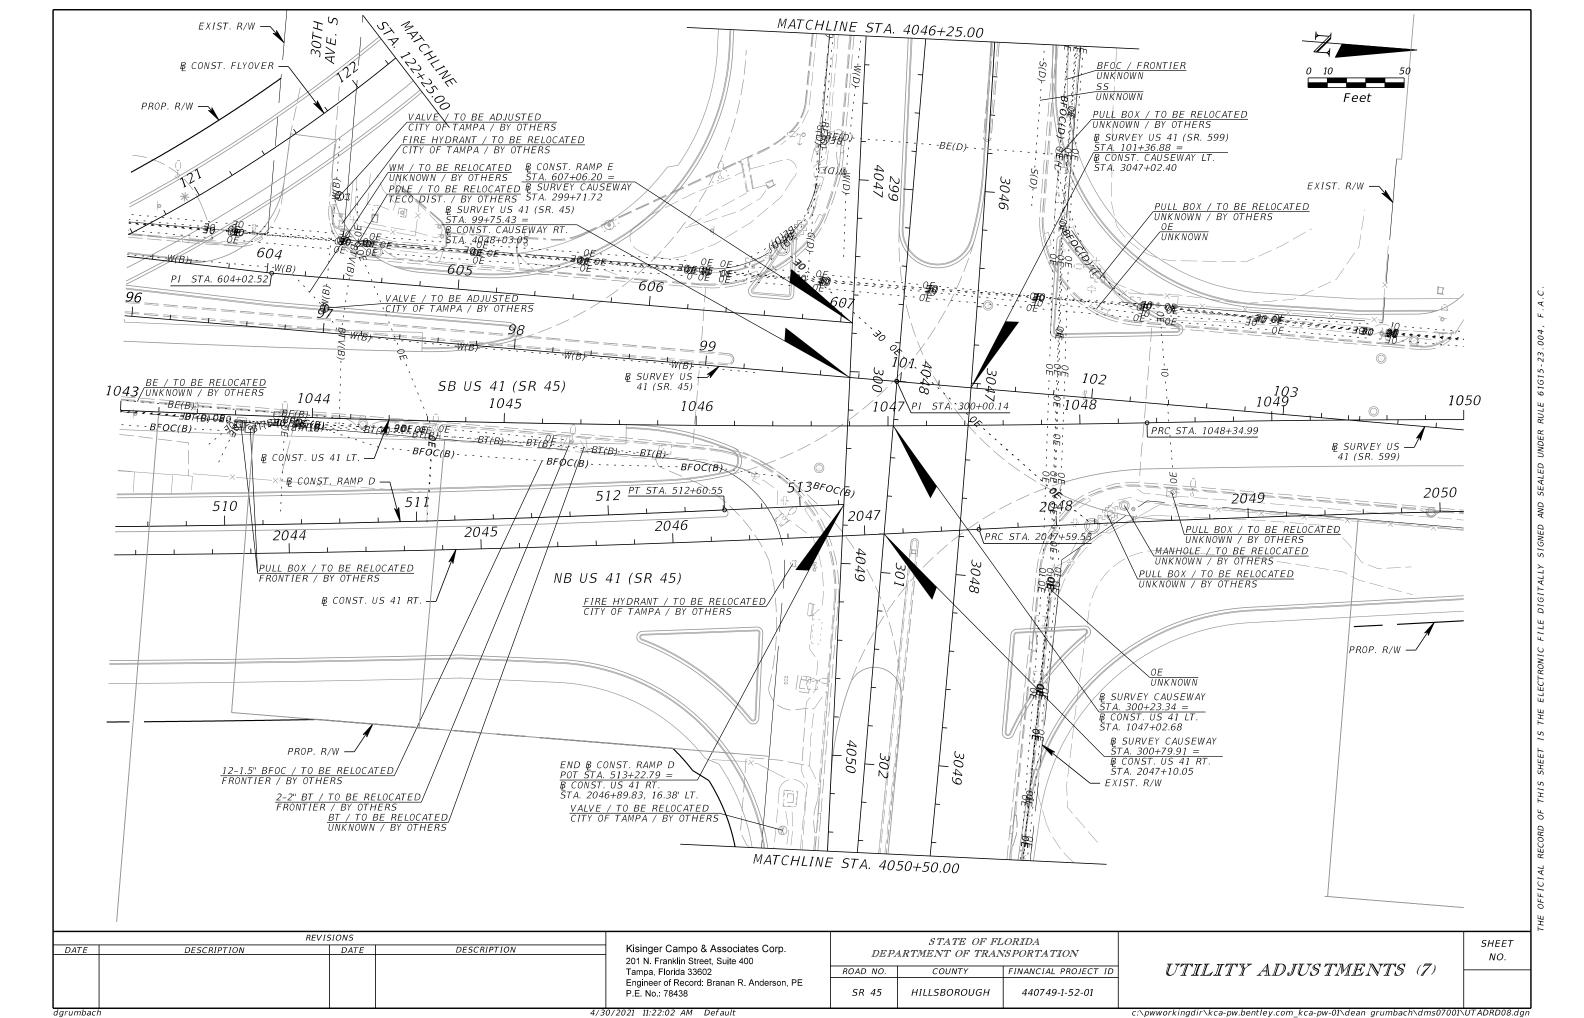


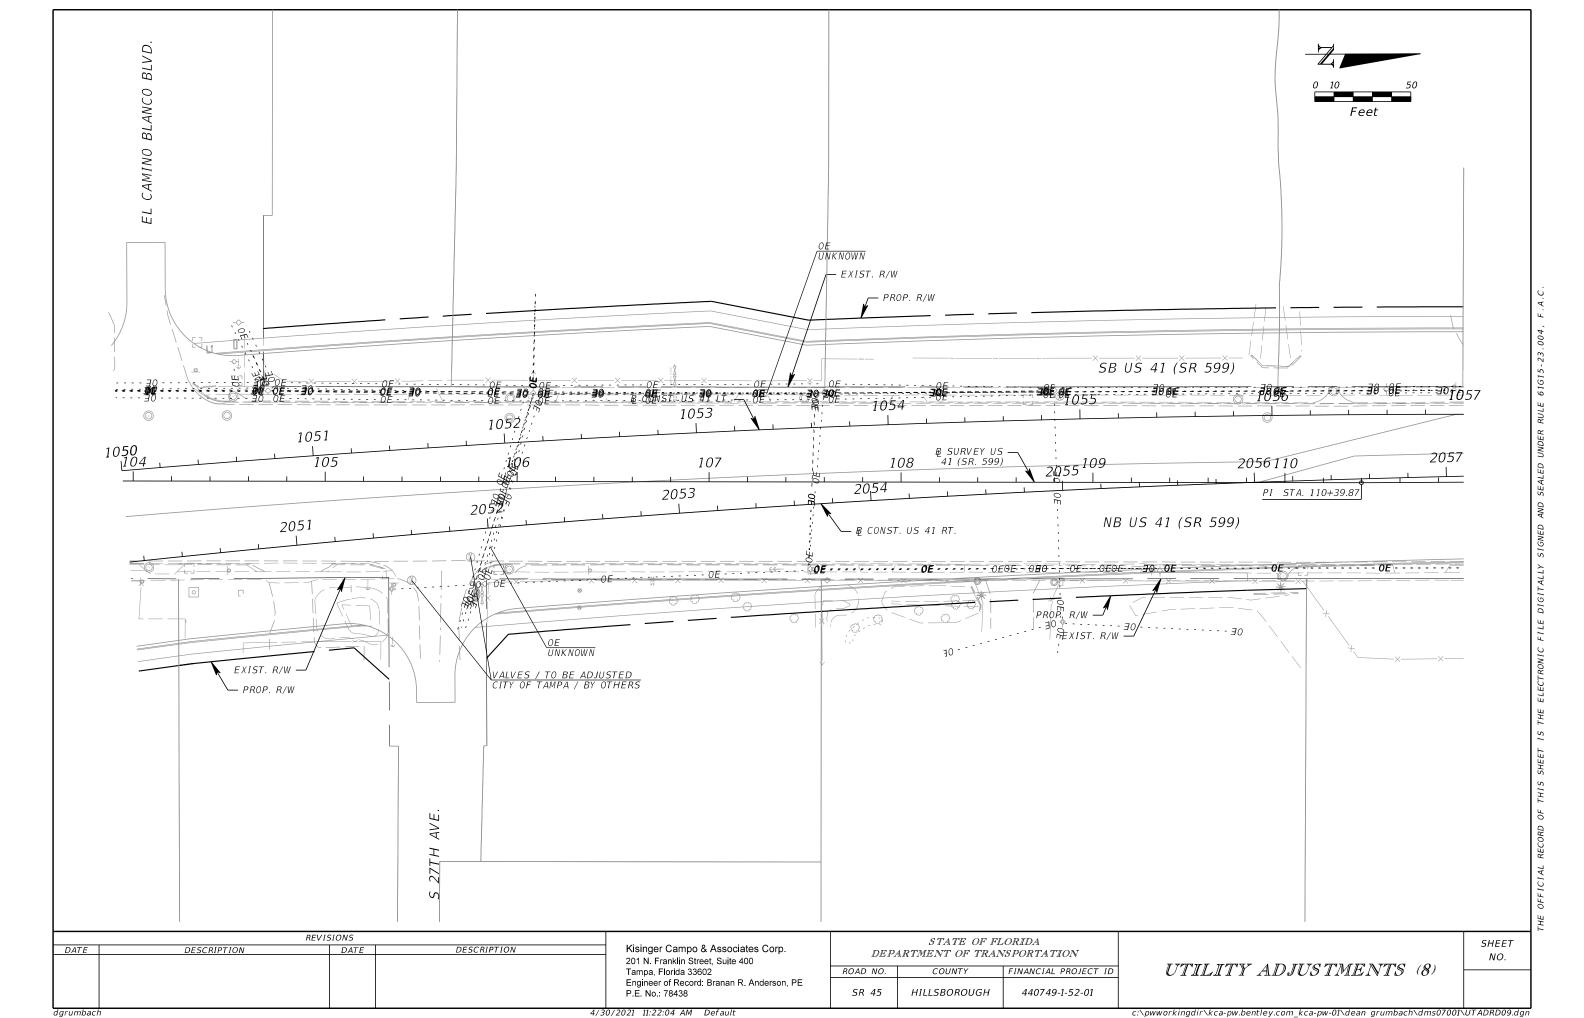


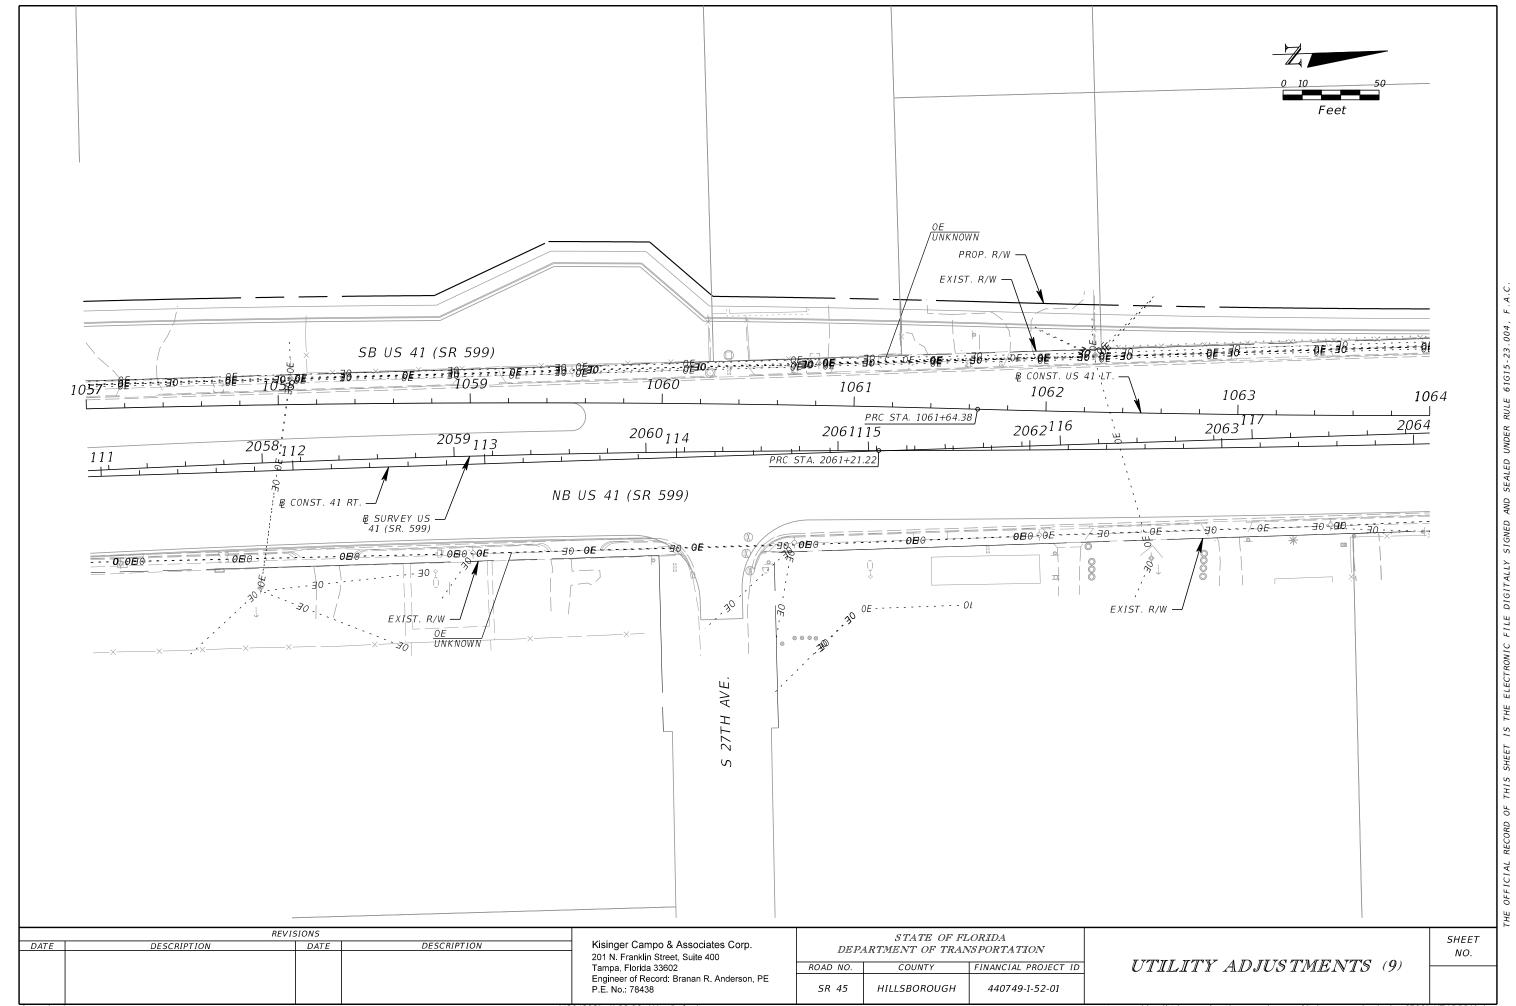


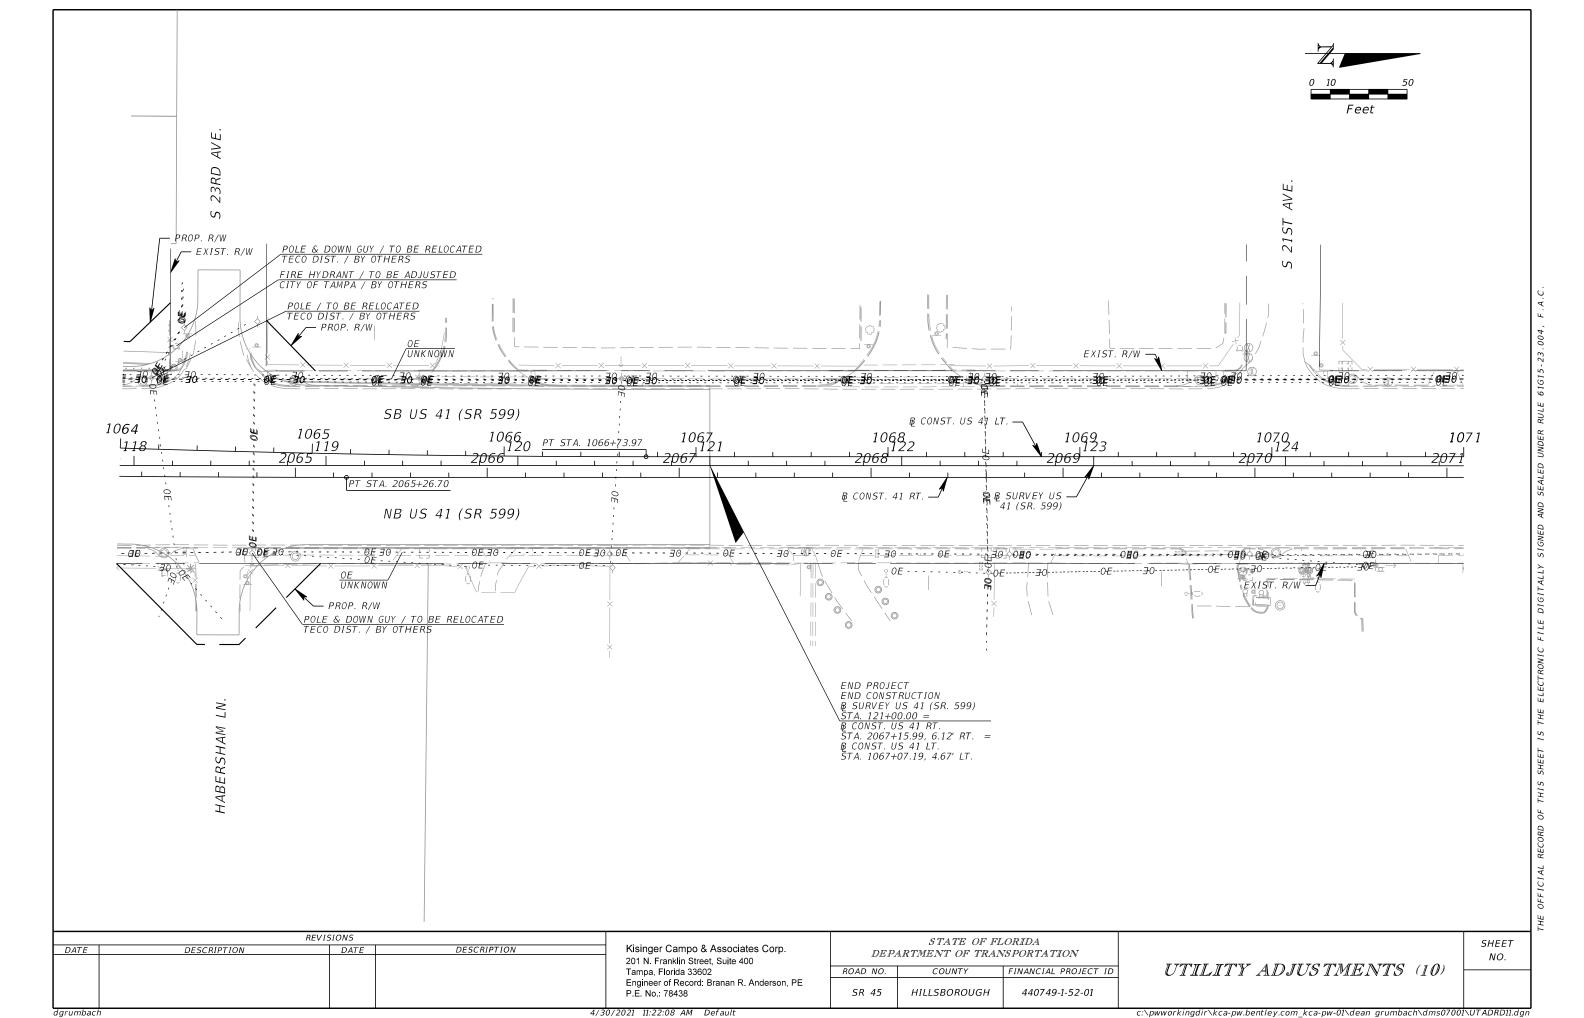


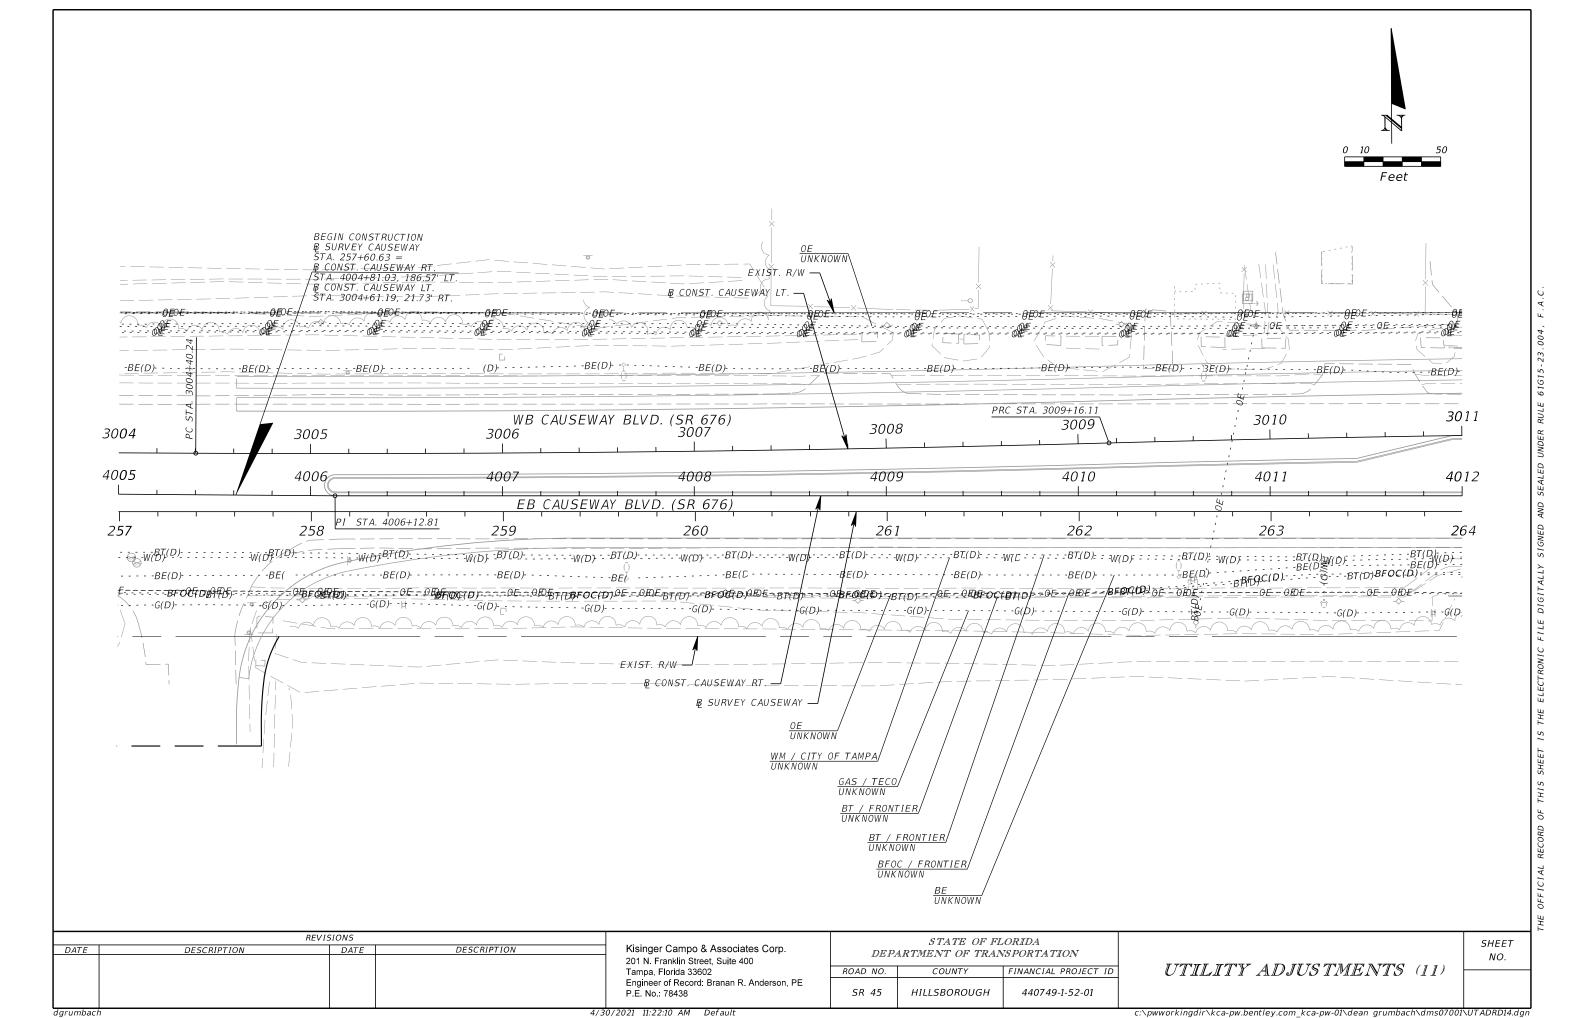


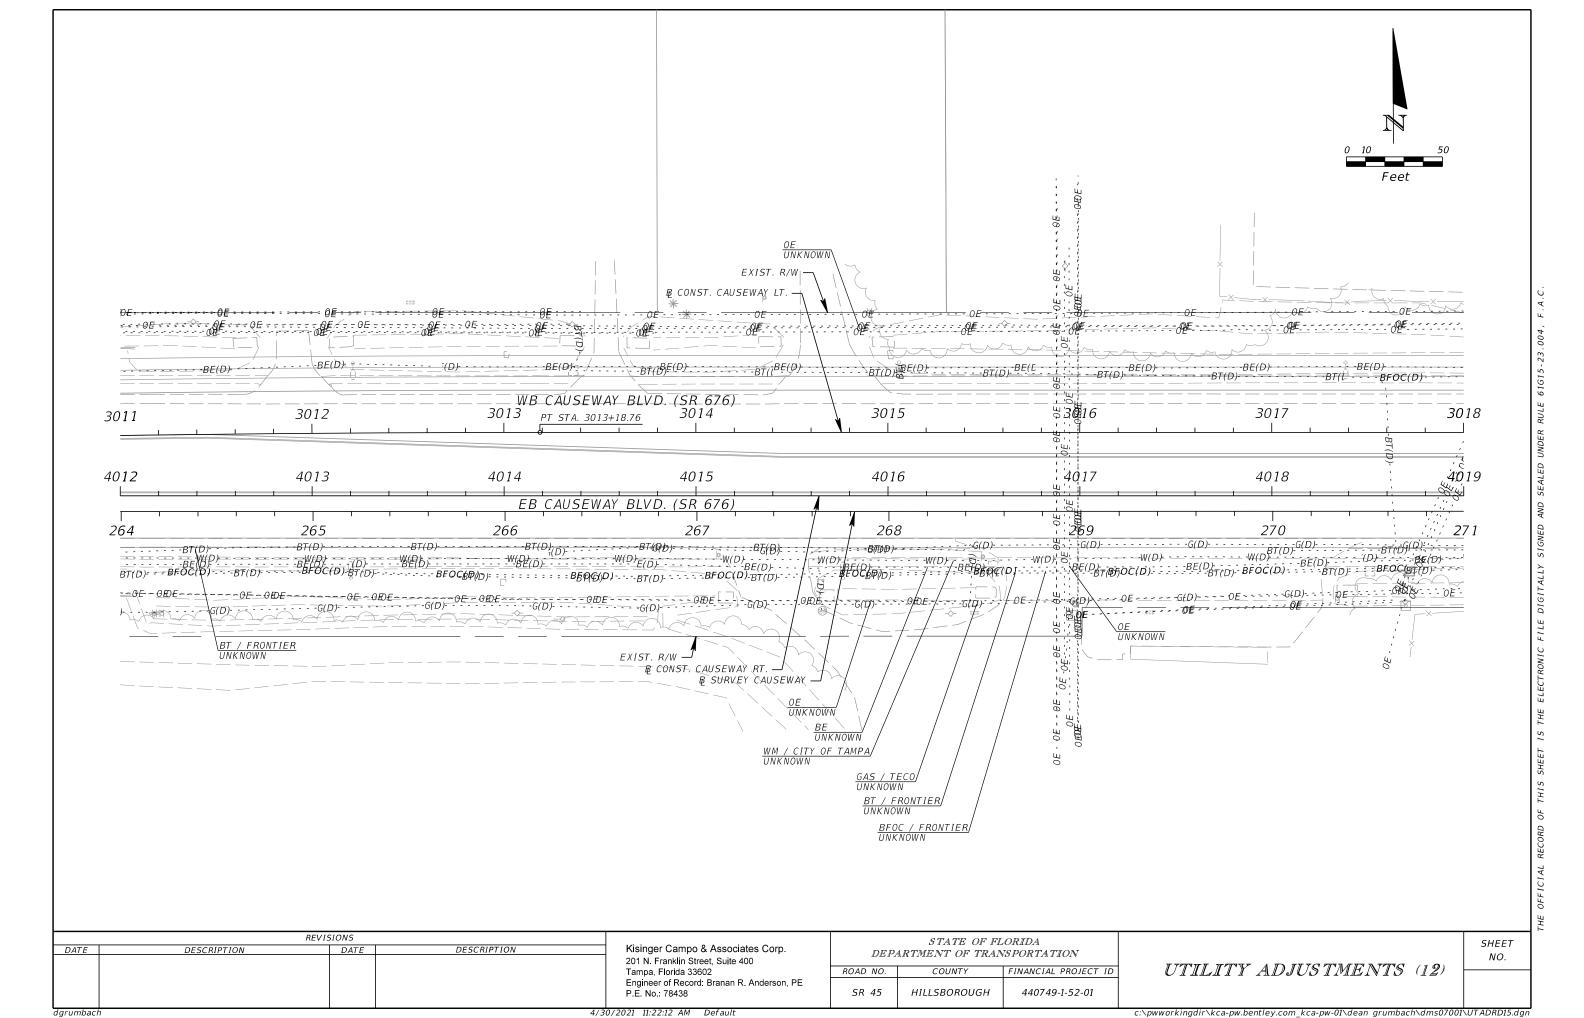


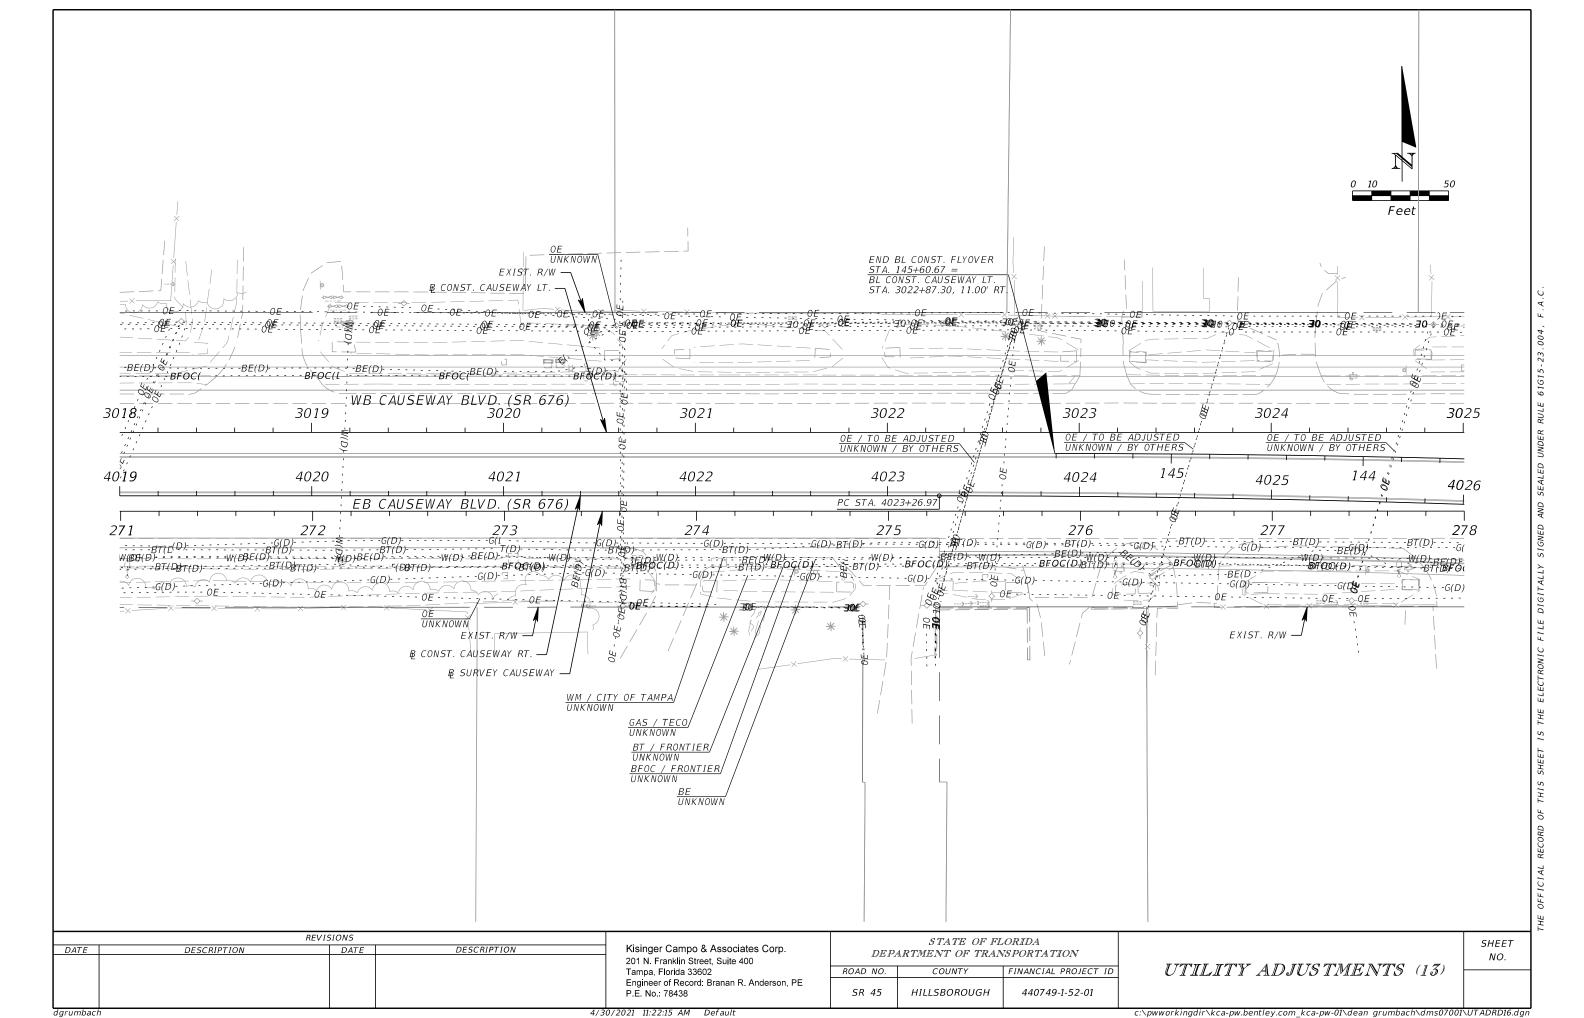


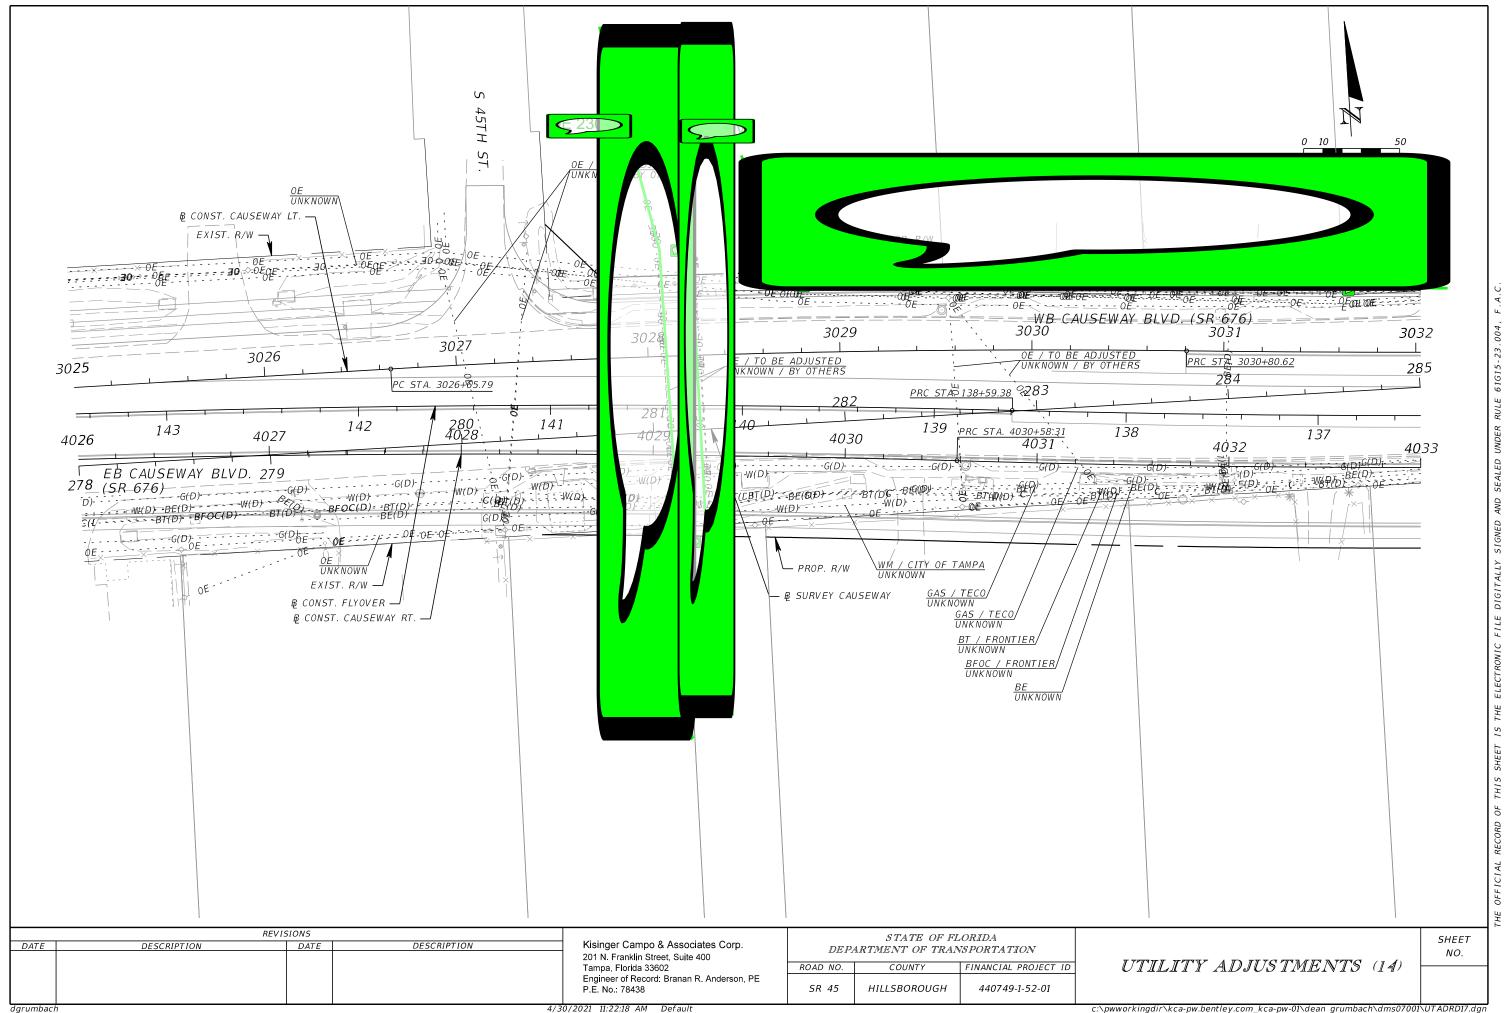

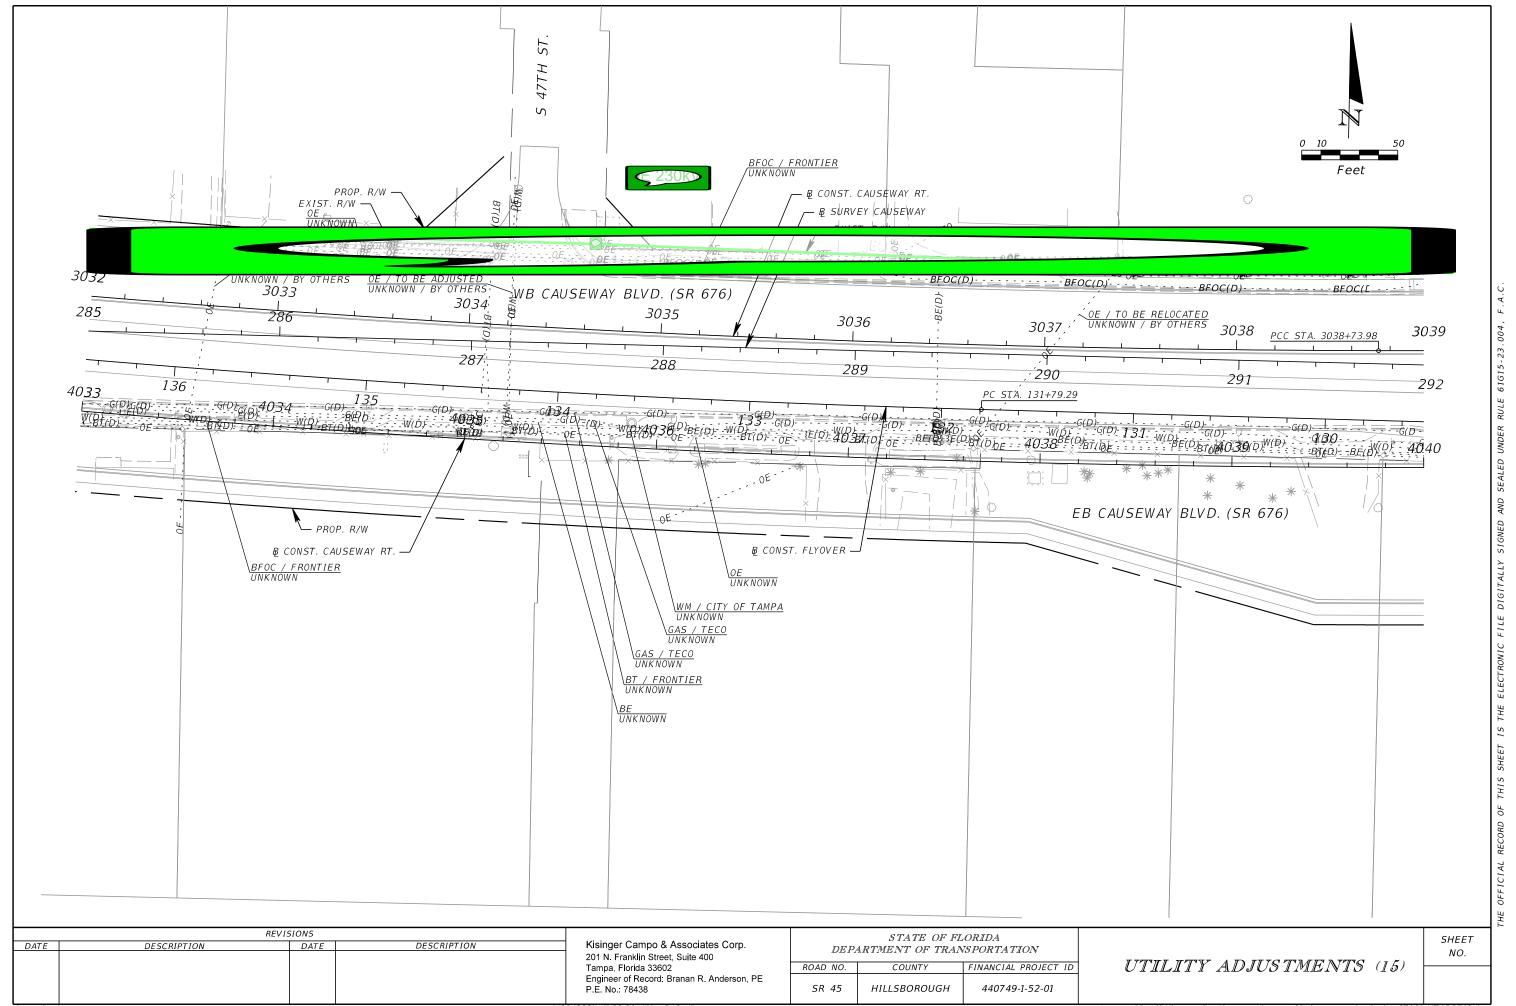

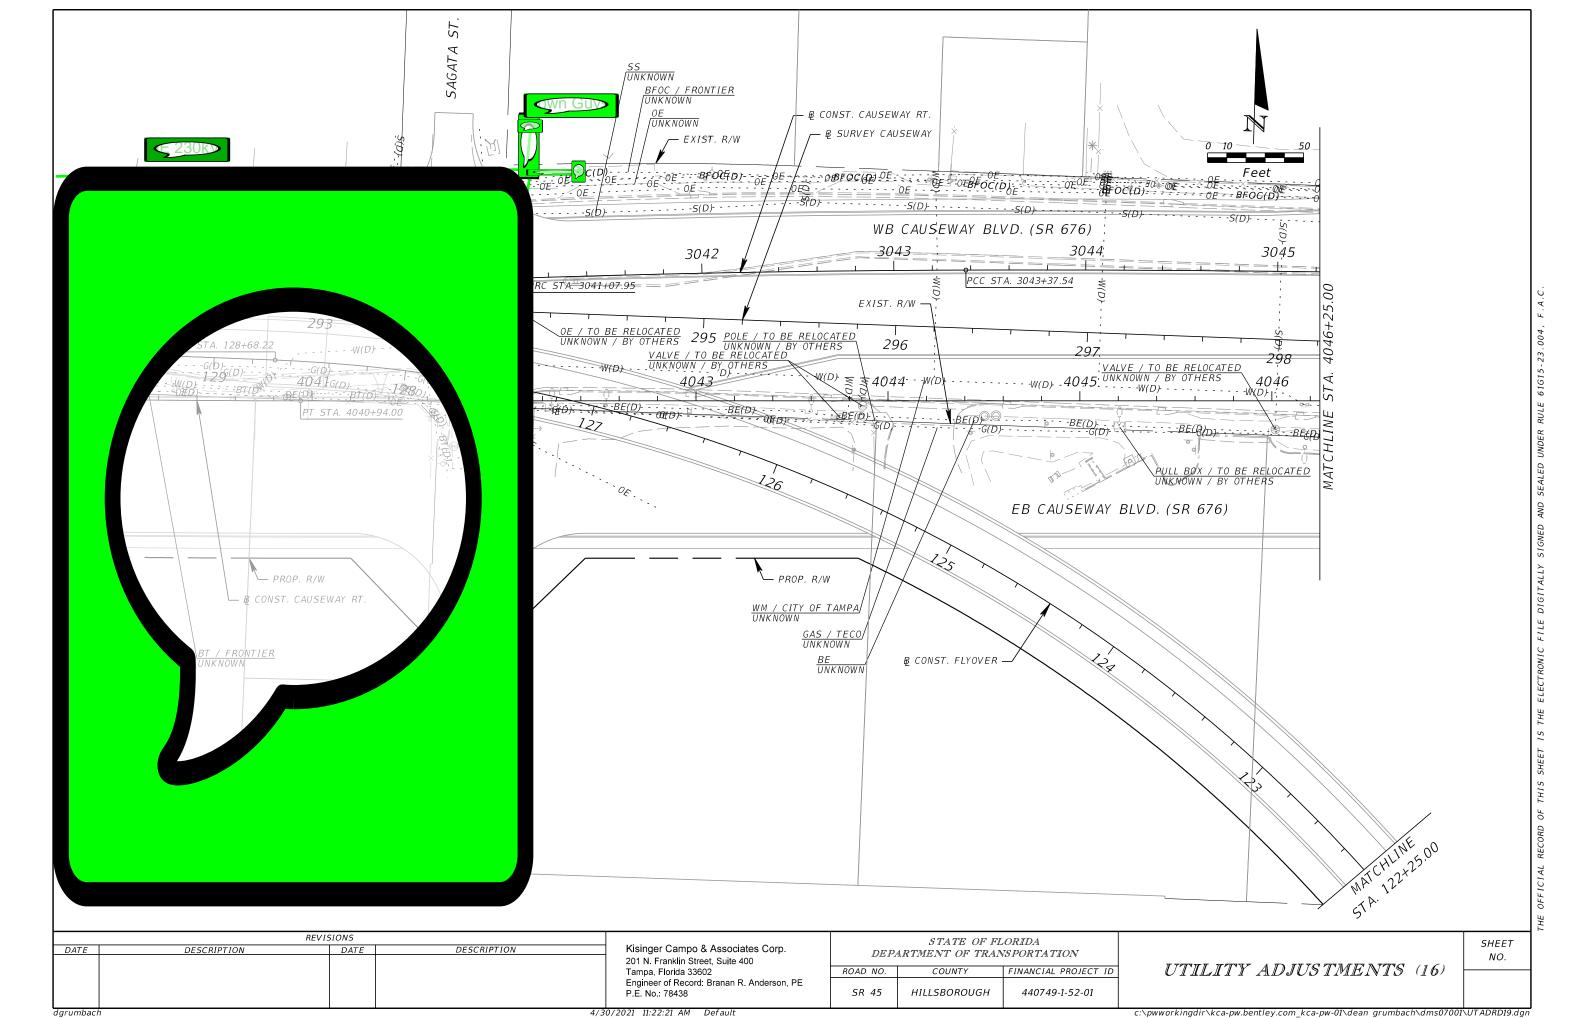

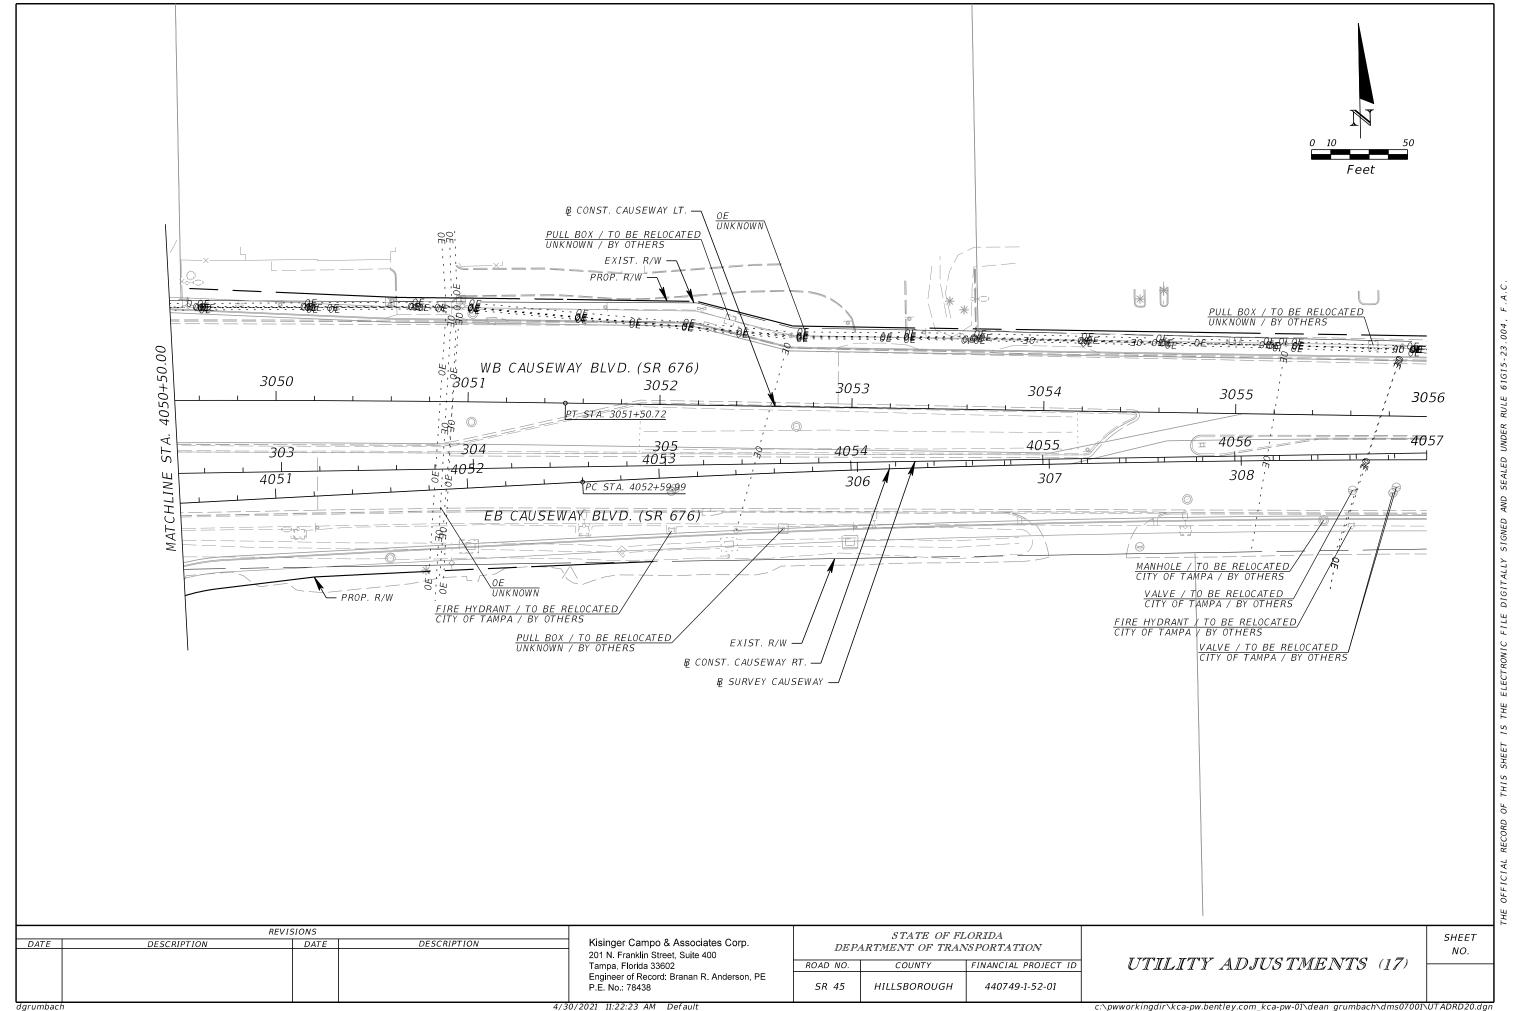

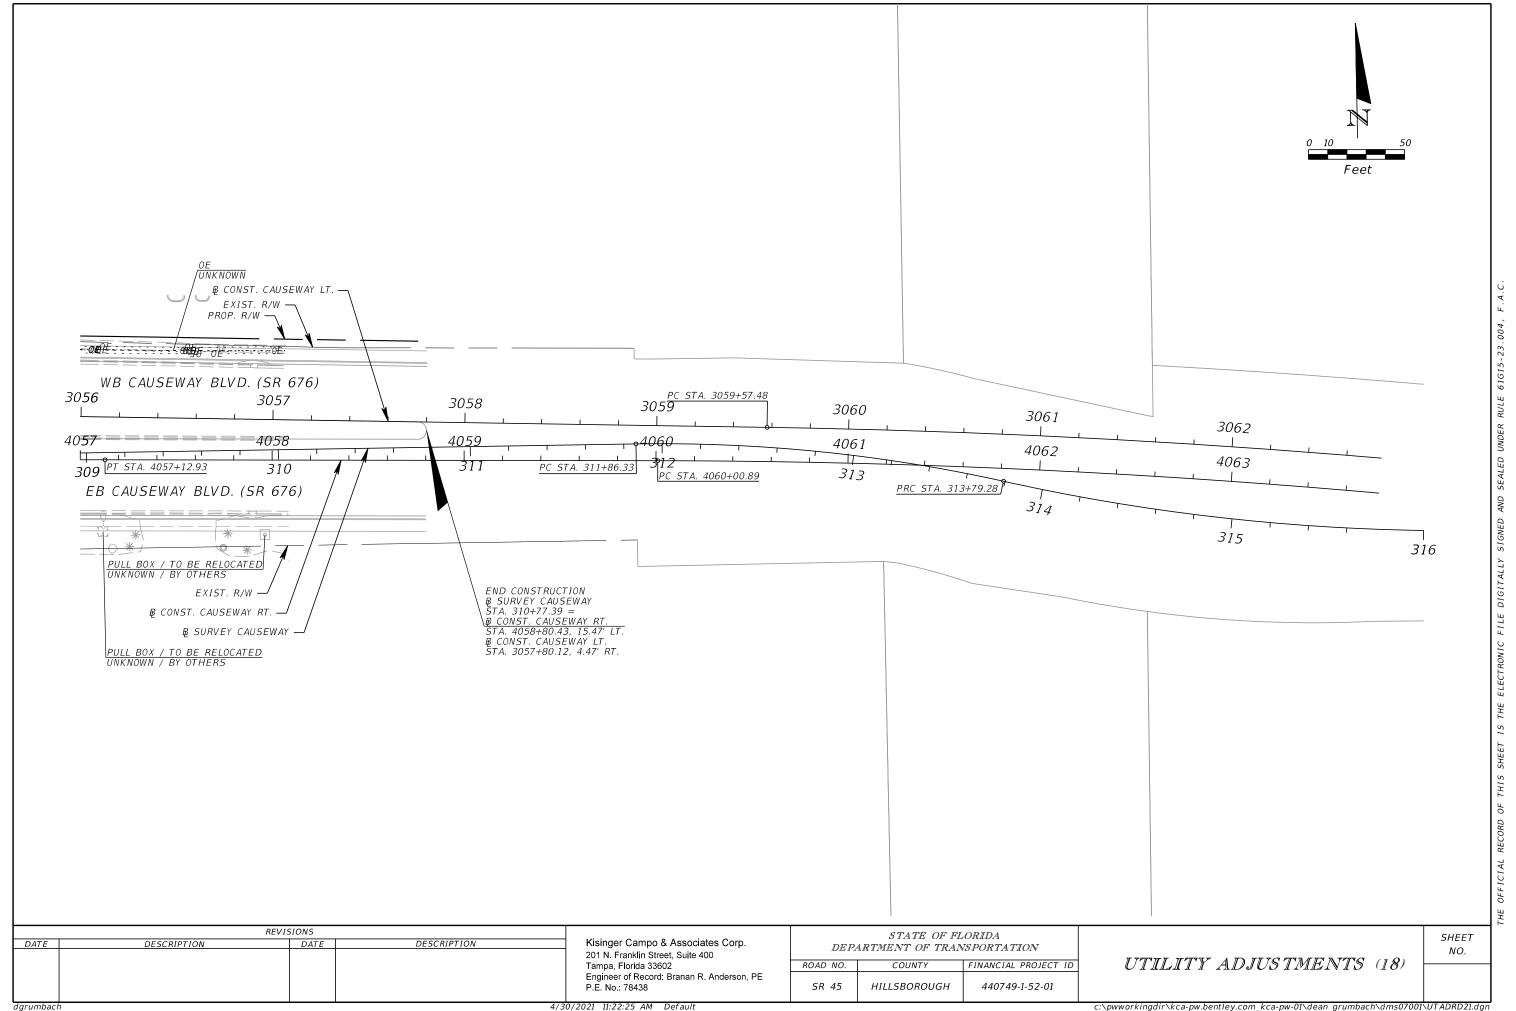

	Cre	w Memb	ers:		DW, TG			
	City	, State:	ate: Tampa, Florid					
	Ger	neral Loca	ation:	US 41				
NCE-	Coc	ordinate (Unit of Meas	ure: U	S Survey Fee			
		Abbrev	riations	Offset Mea	sured From:			
	N/A	= Not Appl	icable	EP= Edge of Pav	rement			
HOLE"	NAD	= North A	merican	BC = Back of Cu	rb			
	Datu	ım		BL = Baseline of	Survey			
	NAV	D = North	American	COORD = Surve	y Coordinates			
	Vert	ical Datum		CL = Centerline				
	UNK	= Unknow	'n	HUB = Survey H	ub			
	COT	= City of T	ampa	RW = Right of W	/ay			
				ST = Swing Ties				
				X = "X" in Concr	ete			
	Hori	zontal:	NAD83/11					
	Vert	ical:	NAVD88	Ground	Utility			
ng		Е	asting	Elevation	Elevation			
4.90'		526413.67		7.51'	4.25'			
5.19'		526416.74'		7.48'	4.18'			
1.95'		526415.25'		7.48'	5.01'			
5.12'		526418.96'		7.36'	-1.44'			
1.11'		526321.06'		6.85'	1.31'			
1.38'		526417.02'		6.84'	3,40'			
1.47'		526418.97'		6.84'	4.421			
0.12'		526	526422.34' 6.83'		-3.23'			
0.56'		526	424.00'	6.49'	3.15'			
		_						
		Prepared L	by: EE	Date: 02/12/20	019			

Truck No.:			D-3/T-2		ter Springs, Flo		UTILITY ENG	INEERING &	SURVEY	- GROW, INSPIRE, M	AKE A DIFFERENCE-	Coordinate Unit of Meas	sure: U	S Survey Fe	
	U	Itility Type	e				y Material			Identif	fied By:	Abbreviations	Offset Mea	sured Fror	
BE = Buried B	Electrical	RW = Recla	imed Water		AC = Transite		FIBG = Fiberg	lass		HUB = Survey Hub		N/A = Not Applicable	EP= Edge of Pavement		
GM = Gas M	ain	SL = Street	Light		CI= Cast Iron		HDPE = High	Density Polyet	thylene Pipe	IRC = Iron Rod & Cap "ECHO TEST HOLE"		NAD = North American	BC = Back of Curb		
BT = Buried ⁻	Telephone	TS = Traffic	Signal		CP = Concrete f	Pipe	PE = Polyethy	PE = Polyethylene Pipe		NL = Nail & Disk "ECHO TEST HOLE"		Datum	BL = Baseline of	BL = Baseline of Survey	
OC = Fiber (Optic Cable	FL = Fuel Lir	ne		DBC = Direct Bu	DBC = Direct Buried Cable F				SLEEVE = Sleeve		NAVD = North American	COORD = Surve	y Coordinat	
NM = Water	r Main	GS = Gas Se	rvice		CMP = Corruga	:MP = Corrugated Metal Pipe S				X = "X" in Concrete		Vertical Datum	CL = Centerline		
SAN = Sanita	ry Sewer	WS = Water	r Service		CONC = Concre	te	VCP = Vitrifie	d Clay Pipe		Surfac	е Туре	UNK = Unknown	HUB = Survey H	ub	
STM = Storm	Sewer	UNK = Unkr	nown Utility		CPP = Corrugat	ed Plastic Pipe	PCCP = Prest	ressed Cylinde	er Concrete	ASPH = Asphalt		COT = City of Tampa	RW = Right of V	/ay	
CATV = Cable	e Television	BED = Burie	d Electrical C	Ouct	DCT = Duct		Pipe			CONC = Concrete			ST = Swing Ties		
FM = Force N	Main	BTD = Burie	d Telephone	Duct	DIP = Ductile Ire	on Pipe	RCP = Reinfo	rced Concrete	Pipe	NG = Natural Groun	d		X = "X" in Concr	ete	
Test Hole	Utility Type	Utility Material	Utility Size Outside Diameter	Utility Manual Depth	Cross Sectional View	***	Identified By	Surface Type	Surface Thickness inches	Apparent Utility Owner	Datums:	Horizontal: NAD83/11 Vertical: NAVD88	Constraint	Utility Elevati	
			inches	feet		Utility Direction			inches		Northing	Easting			
1-1	вт	PVC	2 - 4"	3.26'	00	<u></u>	IRC	NG	N/A	FRONTIER	1301204.90'	526413.67	7.51'	4.25'	
1-2	WM	CI	6"	3.30'		<u> </u>	IRC	NG	N/A	сот	1301205.19	526416.74'	7.48'	4.18'	
1-3	FOC/BT	PVC	4"	2.47'	0		IRC	NG	N/A	FRONTIER	1301204.95'	526415.25'	7.48'	5.01	
1-4	FOC	PE	12 - 1.5"	8.80'	08888c		IRC	NG	N/A	FRONTIER	1301205.12'	526418.96'	7.36'	-1.44	
1-5	CATV	PVC	2 - 2"	5.54'	00	\$	IRC	NG	N/A	SPECTRUM	1301181.11'	526321.06'	6.85'	1.31'	
1-6	вт	PVC	2 - 4"	3.44'		‡	IRC	NG	N/A	FRONTIER	1301811.38'	526417.02'	6.84'	3.40'	
1-7	FOC/BT	PVC	4"	2.42'	0	←	IRC	NG	N/A	FRONTIER	1301811.47	526418.97'	6.84'	4.42'	
1-8	WM	UNK	UNK	10.06'		*	IRC	NG	N/A	сот	1301810.12'	526422.34'	6.83'	-3.23	
1-9	FOC/BT	PVC	4"	3.34'	0	\$	IRC	NG	N/A	FRONTIER	1301810.56'	526424.00'	6.49'	3.15	
Notes:	1-8 - Unable	to visually ve	erify size and	matterial du	ue to depth and p	groundwater. Possi	ble 6 [™] cast iroi	n.				Prepared by: EE	Date: 02/12/2	019	
												Checked by: AB	Date: 02/12/		
ON	REVISION	S 4 <i>TE</i>		ESCRIPTION		Kisinger Can	npo & Associat	es Corn		STATE DEPARTMENT OF	OF FLORIDA		, 4		

Test Hole Data Report

ECHO UES, Inc. www.echoues.com

888.778.ECHO

SHEET

4/30/2021 11:22:27 AM Default

Tampa, Florida 33602
Engineer of Record: Branan R. Anderson, PE
P.E. No.: 78438

ROAD NO.

SR 45

COUNTY

HILLSBOROUGH

FINANCIAL PROJECT ID

440749-1-52-01

UTILITY ADJUSTMENTS (19)

Date:

dgrumbach

ECHO Project #:

Financial Project #:

12/04/2018

18-252

N/A

16514 N. Dale Mabry Hwy.

Tampa, Florida 33618

1511 E. SR434, Ste. 2001, #252

Date:		12	2/05/2018				Test Hel	e Data Repo	art.			Crew Members:		DW, TG
ECHO Pro	iect #:		18-252	16	5514 N. Dale Ma	ibry Hwy.			_	ECHO U	ES, Inc.	City, State:	Т	ampa, Florida
			N/A			Tampa, Florida 33618				-	General Location:	''	US 41	
Financial F	•			1511						888.778.ECHO				
Truck No.:			D-3/T-2	Win	ter Springs, Flo	1108 32700	UTILITY ENGINEERING & SURVEY		- GROW, INSPIRE, MA		Coordinate Unit of Meas		S Survey Feet	
		Itility Type				Utilit	y Material			Identifi	ed By:	Abbreviations		sured From:
BE = Buried		RW = Reclai			AC = Transite		FIBG = Fiberg			HUB = Survey Hub		N/A = Not Applicable	EP= Edge of Pav	
GM = Gas M		SL = Street I	_		CI= Cast Iron				hylene Pipe	IRC = Iron Rod & Cap			BC = Back of Cu	
BT = Buried		TS = Traffic			CP = Concrete P		PE = Polyethy			NL = Nail & Disk "ECH	IO TEST HOLE"	Datum	BL = Baseline of	
FOC = Fiber		FL = Fuel Lir GS = Gas Se			DBC = Direct Bu		PVC = Polyvin	iyi Chloride		SLEEVE = Sleeve X = "X" in Concrete		NAVD = North American Vertical Datum	COORD = Surve CL = Centerline	y Coordinates
WM = Wate SAN = Sanita		WS = Water			CMP = Corrugat CONC = Concret		STL = Steel VCP = Vitrifie	d Clay Dina		Surface	Tuno	UNK = Unknown	HUB = Survey H	ub
SAN = Sanita STM = Storn		UNK = Unkr			CPP = Corrugate		t		r Constato	ASPH = Asphalt	: туре	COT = City of Tampa	RW = Right of W	
CATV = Cabl			d Electrical D	ouct	DCT = Duct	ed Flastic Fipe	Pipe Presti	ressed Cylinde	r concrete	CONC = Concrete		cor – city or rampa	ST = Swing Ties	, uy
FM = Force I			d Telephone		DIP = Ductile Iro	on Pipe		rced Concrete	Pipe	NG = Natural Ground			X = "X" in Concr	ete
			Utility Size	Utility		Ņ			Surface			Horizontal: NAD83/11		
Test Hole	Utility Type	Utility	Outside	Manual	Cross	+	Identified By	Surface Type	Thickness	Apparent Utility	Datums:	Vertical: NAVD88		Utility
100011010	ounty type	Material	Diameter	Depth	Sectional View	¥↓¾ Utility Direction	raciiciica by	ouridee Type	inches	Owner	Northing	Easting	Elevation	Elevation
1-10	FOC	PE	inches 12 - 1.5"	feet 3.96'	000 0000 0000	A A	IRC	NG	N/A	FRONTIER	1302430.03	526421.52'	6.62'	2.66'
1-11	ВТ	PVC	2 - 4"	2.50'	000000	*	IRC	NG	N/A	FRONTIER	1302430.50	526424.77'	6.68'	4.18'
1-12	FOC/BT	PVC	4"	1.90'		<u> </u>	IRC	NG	N/A	FRONTIER	1302430.47'	526425.15'	6.69'	4.79'
						↓								
1-13	ВТ	DBC	2"	1.56'	0	\	IRC	NG	N/A	FRONTIER	1302430.15'	526428.11'	6.81'	5.25'
1-14	WM	DIP	6"	3.40"		<u> </u>	IRC	NG	N/A	СОТ	1302428.62	526446.38'	8.20'	4.80'
1-15	GM	STL	4"	3.00'		Ţ	IRC	NG	N/A	сот	1302488.18'	526318.06'	6.08'	3.08'
1-16	ВТ	PVC	4"	3.50'			IRC	NG	N/A	FRONTIER	1301205.22'	526417.96'	7.50'	4.00'
1-17	ВТ	DBC	2"	3.00'	0		IRC	NG	N/A	FRONTIER	1301810.09'	526422.72'	6.80'	3.80'
Notes:														
												Prepared by: EE	Date: 02/12/20	019
												Checked by: AB	Date: 02/12/	2019

REVISIONS STATE OF FLORIDA Kisinger Campo & Associates Corp. 201 N. Franklin Street, Suite 400 DESCRIPTION DATE DESCRIPTION DATE DEPARTMENT OF TRANSPORTATION Tampa, Florida 33602
Engineer of Record: Branan R. Anderson, PE
P.E. No.: 78438 ROAD NO. COUNTY SR 45 HILLSBOROUGH 440749-1-52-01

FINANCIAL PROJECT ID

UTILITY ADJUSTMENTS (20)

SHEET NO.

c:\pwworkingdir\kca-pw.bentley.com_kca-pw-01\dean grumbach\dms07001\UTADRD00.dgn

Date:		12	2/06/2018				Test Hol	e Data Repo	ort			Crew Members:		DW, TG, MAJ
ECHO Proj	iect #:		18-252	16	5514 N. Dale Ma	abry Hwy.				ECHO U	IES, Inc.	City, State:	Т	ampa, Florida
Financial F	•		N/A		Tampa, Florida	33618	≫⊩	(CH)		www.echoues.com				US 41
Truck No.:	•		D-3/T-2		L E. SR434, Ste.			888.778.ECHO		Coordinate Unit of Meas	ure:	JS Survey Feet		
Truck No		lailian Trome	,	Win	ter Springs, Flo	nida SE700		INEEKING &	SURVET	Identif				
BE = Buried I		Itility Type RW = Reclai			AC - Terreite	Utilit	y Material	-1		HUB = Survey Hub	іеа ву:		Abbreviations Offset Measured Fro	
GM = Gas M		SL = Street			AC = Transite CI= Cast Iron		FIBG = Fiberg		bulana Bina	IRC = Iron Rod & Cap	"ECHO TEST HOLE"	N/A = Not Applicable NAD = North American	EP= Edge of Par BC = Back of Cu	
BT = Buried		TS = Traffic	ŭ		CP = Concrete P	Pine	PE = Polyethy		.nyiene ripe	NL = Nail & Disk "ECI		Datum	BL = Baseline of	
FOC = Fiber		FL = Fuel Lir			DBC = Direct Bu		PVC = Polyvir			SLEEVE = Sleeve	HO TEST HOLE	NAVD = North American	COORD = Surve	
WM = Water		GS = Gas Se			CMP = Corrugat		STL = Steel	tyl Cilionae		X = "X" in Concrete		Vertical Datum	CL = Centerline	
SAN = Sanita		WS = Water			CONC = Concre		VCP = Vitrifie	d Clay Pine		Surfac	e Tyne	UNK = Unknown	HUB = Survey H	
STM = Storm		UNK = Unkr			CPP = Corrugate		1	ressed Cylinde	r Concrete	ASPH = Asphalt	c 19pc	COT = City of Tampa	RW = Right of V	
CATV = Cable			d Electrical D	ouct	DCT = Duct	ed Hastie Hipe	Pipe	resseu cyllilue	Concrete	CONC = Concrete		cor dicy or rumps	ST = Swing Ties	
FM = Force N			d Telephone		DIP = Ductile Iro	n Pine		rced Concrete	Pine	NG = Natural Ground	nl .		X = "X" in Conc	
1111-10100	- Traini	515 54116	Utility Size	Utility	Dir - Duccile ire	N N	rici – ricinio	Toda concrete		ivo - reaction di dani		Horizontal: NAD83/11	71 111 00110	I
Tost Hala	Litility Type	Utility	Outside	Manual	Cross	+	Identified Pu	Surface Type	Surface	Apparent Utility	Datums:	Vertical: NAVD88	Ground	Utility
rest noie	Utility Type	Material	Diameter	Depth	Sectional View	▼	Identified by	Surrace Type	Thickness inches	Owner	Northing		Elevation	Elevation
			inches	feet		Utility Direction			inches		Northing	Easting		
1-18	вт	PVC	2 - 4"	3.82'	00		IRC	NG	N/A	FRONTIER	1303091.15'	526425.13'	7.04'	3.22'
1-19	FOC/BT	PVC	4"	2.54'			IRC	NG	N/A	FRONTIER	1303091.17	526425.73	6.99'	4.45'
1-20	вт	LEAD	2 - 2"	3.00'	00	\$	IRC	NG	N/A	FRONTIER	1303091.09	526427.92'	6.86'	3.86'
1-21	FOC	UNK	12 - 1.5"	9.22'	888888	\^	IRC	NG	N/A	FRONTIER	1303091.01	526430.76'	6.58'	-2.64'
1-22	ВТ	LEAD	2 - 2"	2.00'	00	\$	IRC	NG	N/A	FRONTIER	1303695.15'	526432.46'	6.77'	4.77'
1-23	вт	PVC	2 - 4"	2.76'	00	\$	IRC	NG	N/A	FRONTIER	1303695.20'	526433.46'	6.70'	3.94'
1-24	ВТ	LEAD	2 - 2"	2.74'	00	\$	IRC	NG	N/A	FRONTIER	1304500.45'	526435.53'	7.28'	4.54'
Notes:	1-21 - Unable	e to visually v	erify size and	d material du	ue to depth and g	groundwater. Possil	bly 12 - 1.5" p	olyethylene pi	pes.					
												Prepared by: EE	Date: 02/12/2	019
												Checked by: AB	Date: 02/12/	2019

REVISIONS DESCRIPTION DESCRIPTION DATE

Kisinger Campo & Associates Corp. 201 N. Franklin Street, Suite 400 Tampa, Florida 33602 Engineer of Record: Branan R. Anderson, PE P.E. No.: 78438

STATE OF FLORIDA DEPARTMENT OF TRANSPORTATION ROAD NO. COUNTY FINANCIAL PROJECT ID SR 45 HILLSBOROUGH 440749-1-52-01

UTILITY ADJUSTMENTS (21)

SHEET NO.

APPENDIX C Utility Impact Table

Utility Name	Utility Description	Proposed Work in Utility Location	Conflict Location
Century Link	12-1/5" HDPE	Sidwalk installation	Eastern us 41 ROW throughout project extent
Century Link	12-1/5" HDPE	Bridge construction	Eastern us 41 ROW throughout project extent
Century Link	12-1/5" HDPE	Roadway change to at-grade	Eastern us 41 ROW throughout project extent
Century Link	12-1/5" HDPE	Roadway change to on MSE	Eastern us 41 ROW throughout project extent
Century Link	12-1/5" HDPE	Roadway milling and resurfacing	Eastern us 41 ROW throughout project extent
Century Link	12-1/5" HDPE	ROW change	Eastern us 41 ROW throughout project extent
COT Water	B1-2-07: 24" EMJ and ECJ	Roadway change to at-grade	South-bound lane of US 41 from southern project terminus to Delaney Creek
COT Water	B1-2-07: 24" EMJ and ECJ	Bridge construction	South-bound lane of US 41 at Delaney Creek Intersection
COT Water	B1-2-07: 24" EMJ and ECJ	Roadway change to on MSE	South-bound lane of US 41 from Delaney Creek to S 36th Ave
COT Water	B1-2-07: 24" EMJ and ECJ	Bridge construction	South-bound lane of US 41 at the S 36th Ave. intersection
COT Water	B1-2-07: 24" EMJ and ECJ	Roadway change to at-grade	South-bound lane of US 41 and S 36th Ave. intersection
COT Water	B1-2-07: 24" EMJ and ECJ	Roadway change to on MSE	South-bound lane of US 41 from S 36th Ave. to sta. 2032
COT Water	B1-2-07: 24" EMJ and ECJ	Bridge construction	South-bound lane of US 41 at the St. Paul St. intersection
COT Water	B1-2-07: 24" EMJ and ECJ	Roadway change to at-grade	South-bound lane of US 41 at the St. Paul St. intersection
COT Water	B1-2-07: 24" EMJ and ECJ	Roadway change to on MSE	South-bound lane of US 41 from St. Paul St. to S 30th Ave.
COT Water	B1-2-07: 24" EMJ and ECJ	Roadway change to at-grade	Approx. US 41 centerline from S 30th Ave to S 25th Ave.; east side of US 41
COT Water	B1-2-07: 24" EMJ and ECJ	Roadway milling and resurfacing	Approx. US 41 centerline from S 25th Ave. to nothern project terminus
COT Water	B1-2-07: 24" EMJ and ECJ	Bridge construction	US 41 and Delaney Creek intersection; west side of road
COT Water	C76-20-1: 2" EMJ	Roadway change to at-grade	US 41 western ROW from sta. 1005+60 to 1006+40 (Hartford St.)
COT Water	C76-20-1: 2" EMJ	Sidwalk installation	US 41 western ROW from sta. 1005+60 to 1006+40 (Hartford St.)
COT Water	C76-20-1: 2" EMJ	ROW change	US 41 western ROW from sta. 1005+60 to 1006+40 (Hartford St.)
COT Water	C76-20-1: 6" DIP	Roadway change to at-grade	Extension west from US 41 south-bound lane at sta. 1006+45 (Hartford St.)
COT Water	C76-20-1: 6" DIP	Sidwalk installation	Extension west from US 41 south-bound lane at sta. 1006+45 (Hartford St.)
COT Water	C76-20-1: 6" DIP	ROW change	Extension west from US 41 south-bound lane at sta. 1006+45 (Hartford St.)
COT Water	FC22-70: 8" ECJ	Roadway change to at-grade	US 41 and Austin St. intersection
COT Water	FC22-70: 8" ECJ	Sidwalk installation	US 41 and Austin St. intersection
COT Water	FC22-70: 8" ECJ	ROW change	US 41 and Austin St. intersection
COT Water	FC33-29: 12" ECJ	Roadway change to at-grade	US 41 and Austin St. intersection
COT Water	FC33-29: 12" ECJ	Sidwalk installation	US 41 and Austin St. intersection
COT Water	FC33-29: 12" ECJ	ROW change	US 41 and Austin St. intersection
COT Water	FC22-70: 8" ECJ	Roadway change to at-grade	US 41 and Austin St. intersection
COT Water	FC22-70: 8" ECJ	Sidwalk installation	US 41 and Austin St. intersection
COT Water	FC22-70: 8" ECJ	ROW change	US 41 and Austin St. intersection
COT Water	FC22-70: 6" ECJ	Roadway change to at-grade	Eastern ROW and north-bound lane of US 41 from sta. 1007 to 1017+40

COT Water	FC22-70: 6" ECJ	Sidwalk installation	Eastern ROW and north-bound lane of US 41 from sta. 1007 to 1017+40		
COT Water	FC22-70: 6" ECJ	ROW change	Eastern ROW and north-bound lane of US 41 from sta. 1007 to 1017+40		
COT Water	FC39-100: 8" ECJ	Roadway change to at-grade	US 41 and Raleigh St. intersection; west side of US 41		
COT Water	FC39-100: 8" ECJ	Roadway change to on MSE	US 41 and Raleigh St. intersection; west side of US 41		
COT Water	FC39-100: 8" ECJ	Sidwalk installation	US 41 and Raleigh St. intersection; west side of US 41		
COT Water	FC39-100: 8" ECJ	ROW change	US 41 and Raleigh St. intersection; west side of US 41		
COT Water	FC39-100: 8" ECJ	Curb returns increased for WB-62FL	US 41 and Raleigh St. intersection; west side of US 41		
COT Water	C5-1-29: 14-16" steel casing	Roadway change to at-grade	US 41 crossing at sta. 1020+80		
COT Water	C5-1-29: 14-16" steel casing	Roadway change to on MSE	US 41 crossing at sta. 1020+80		
COT Water	C5-1-29: 14-16" steel casing	Sidwalk installation	US 41 crossing at sta. 1020+80		
COT Water	C5-1-29: 14-16" steel casing	ROW change	US 41 crossing at sta. 1020+80		
COT Water	C5-1-29: 14-16" steel casing	Curb returns increased for WB-62FL	US 41 crossing at sta. 1020+80		
COT Water	F13-4-72: 4" DIP	Sidwalk installation	US 41 eastern ROW from sta. 1019+60 to 1022		
COT Water	F13-4-72: 4" DIP	Roadway change to on MSE	US 41 eastern ROW from sta. 1019+60 to 1022		
COT Water	A14-4-69: 6" DIP	Sidwalk installation	US 41 and Towaway Ave. in the eastern US 41 ROW		
COT Water	A14-4-69: 6" DIP	Roadway change to at-grade	US 41 and Towaway Ave. in the eastern US 41 ROW		
COT Water	A14-4-69: 6" DIP	Bridge construction	US 41 and Towaway Ave. in the eastern US 41 ROW		
COT Water	A15-1-04: 6" DIP	Sidwalk installation	US 41 western ROW at sta. 1014+80		
COT Water	A15-1-04: 6" DIP	Roadway change to at-grade	US 41 western ROW at sta. 1014+80		
COT Water	A15-1-04: 6" DIP	ROW change	US 41 western ROW at sta. 1014+80		
COT Water	A15-1-04: 6" DIP	Roadway milling and resurfacing	US 41 western ROW at sta. 1014+80		
COT Water	A14-3-52: 6" DIP/	Roadway change to at-grade	US 41 and Trenton St. intersection; east side of US 41		
	FC22-70: 6" ECJ	, 5			
COT Water	A14-3-52: 6" DIP/ FC22-70: 6" ECJ	Sidwalk installation	US 41 and Trenton St. intersection; east side of US 41		
COT Water	A14-3-52: 6" DIP/	ROW change	US 41 and Trenton St. intersection; east side of US 41		
COT Water	FC22-70: 6" ECJ	Sidwalk installation	LIC 44 avancing at the 1017+20		
	FC22-70: 6" ECJ FC22-70: 6" ECJ		US 41 crossing at sta. 1017+20		
COT Water		Roadway change to at-grade	US 41 crossing at sta. 1017+20		
COT Water	A15-1-04: 6" DIP	Bridge construction	US 41 crossing at sta. 1023+20		
COT Water	A15-1-04: 6" DIP	Roadway change to at-grade	US 41 crossing at sta. 1023+20		
COT Water	A15-1-04: 6" DIP	New roadway to properties	US 41 crossing at sta. 1023+20		
COT Water	FC36-54: 6" ECJ	New roadway to properties	US 41 eastern ROW from sta. 1023+20 to 1028		
COT Water	FC36-54: 6" ECJ	Sidwalk installation	US 41 eastern ROW from sta. 1023+20 to 1028		
COT Water	FC36-54: 6" ECJ	Roadway change to on MSE	US 41 eastern ROW from sta. 1023+20 to 1028		

COT Water	FC24-61: 2" ECJ	Roadway change to at-grade	US 41 and S 34th Ave. intersection; west side of US 41		
COT Water	FC24-61: 2" ECJ	Roadway milling and resurfacing	US 41 and S 34th Ave. intersection; west side of US 41		
COT Water	FC22-70: 8" ECJ	ROW change	US 41 crossing at St. Paul St.		
COT Water	FC22-70: 8" ECJ	Sidwalk installation	US 41 crossing at St. Paul St.		
COT Water	FC22-70: 8" ECJ	Roadway change to at-grade	US 41 crossing at St. Paul St.		
COT Water	FC22-70: 8" ECJ	Bridge construction	US 41 crossing at St. Paul St.		
COT Water	FC22-70: 8" ECJ	Roadway milling and resurfacing	US 41 crossing at St. Paul St.		
COT Water	C7-1-33: 8" ECJ	ROW change	US 41 crossing at St. Paul St.		
COT Water	C7-1-33: 8" ECJ	Sidwalk installation	US 41 crossing at St. Paul St.		
COT Water	C7-1-33: 8" ECJ	Roadway change to at-grade	US 41 crossing at St. Paul St.		
COT Water	C7-1-33: 8" ECJ	Bridge construction	US 41 crossing at St. Paul St.		
COT Water	A15-1-04: 6" DIP	Roadway milling and resurfacing	US 41 western ROW at sta. 1035+80		
COT Water	A15-1-04: 6" DIP	Sidwalk installation	US 41 western ROW at sta. 1035+80		
COT Water	A15-1-04: 6" DIP	Roadway change to at-grade	US 41 western ROW at sta. 1035+80		
COT Water	FC23-34: 2" ECJ	ROW change	US 41 and Trenton St. intersection; west side of US 41		
COT Water	FC23-34: 2" ECJ	Sidwalk installation	US 41 and Trenton St. intersection; west side of US 41		
COT Water	FC23-34: 2" ECJ	Roadway change to at-grade	US 41 and Trenton St. intersection; west side of US 41		
COTMeter	E9-2-48: 6" DIP/	DOW shares	LIC 44 and C 24st Avaintersection, west side of read		
COT Water	A15-1-04: 6" DIP	ROW change	US 41 and S 31st Ave intersection; west side of road		
COT Weton	E9-2-48: 6" DIP/	Sidwalk installation	LIC 44 and C 24st Avaintementing west side of read		
COT Water	A15-1-04: 6" DIP	Sidwaik installation	US 41 and S 31st Ave intersection; west side of road		
COT Water	E9-2-48: 6" DIP/	Deadway shange to at grade	LIC 41 and C 21st Ava interception, west side of road		
COT Water	A15-1-04: 6" DIP	Roadway change to at-grade	US 41 and S 31st Ave intersection; west side of road		
COTMeter	E9-2-48: 6" DIP/	Deadwey willing and accompaging	LIC 44 and C 24st Avaintementing west side of read		
COT Water	A15-1-04: 6" DIP	Roadway milling and resurfacing	US 41 and S 31st Ave intersection; west side of road		
COT Water	FC22-70: 6" ECJ	Sidwalk installation	US 41 north-bound lane from sta. 1040+20 to 1044		
COT Water	FC22-70: 6" ECJ	Roadway change to on MSE	US 41 north-bound lane from sta. 1040+20 to 1044		
COT Water	C3-3-09: 6" PVC	Roadway milling and resurfacing	US 41 and S 30th Ave intersection; west side of US 41		
COT Water	C3-3-09: 6" PVC	ROW change	US 41 and S 30th Ave intersection; west side of US 41		
COT Water	C3-3-09: 6" PVC	Sidwalk installation	US 41 and S 30th Ave intersection; west side of US 41		
COT Water	C3-3-09: 6" PVC	Roadway change to at-grade	US 41 and S 30th Ave intersection; west side of US 41		
COT Water	FC41-3: 8" ECJ	Sidwalk installation	US 41 and SR 676 intesection; south side of SR 676		
COT Water	FC41-3: 8" ECJ	Roadway change to at-grade	US 41 and SR 676 intesection; south side of SR 676		
COT Water	FC27-95: 6" ECJ	Roadway change to at-grade	US 41 western ROW from sta. 1050 to 1055		
COT Water	FC27-95: 6" ECJ	ROW change	US 41 western ROW from sta. 1050 to 1055		
	· · · · · · · · · · · · · · · · · · ·				

COT Water	FC27-95: 6" ECJ	Sidwalk installation	US 41 western ROW from sta. 1050 to 1055
COT Water	FC29-28: 2" ECJ	Roadway change to at-grade	US 41 eastern ROW from sta. 1051+50 to 11054+40
COT Water	FC29-28: 2" ECJ	ROW change	US 41 eastern ROW from sta. 1051+50 to 11054+40
COT Water	FC29-28: 2" ECJ	Sidwalk installation	US 41 eastern ROW from sta. 1051+50 to 11054+40
COT Water	E14-4-21/FC26-56: abandoned 2" ECJ	Roadway change to at-grade	US 41 south-bound lane from sta. 1060+40 to 1064+20
COT Water	E14-4-21/FC26-56: abandoned 2" ECJ	ROW change	US 41 south-bound lane from sta. 1060+40 to 1064+20
COT Water	E14-4-21/FC26-56: abandoned 2" ECJ	Sidwalk installation	US 41 south-bound lane from sta. 1060+40 to 1064+20
COT Water	FC23-83/A15-1-04: 6" ECJ	Sidwalk installation	US 41 eastern ROW from sta. 2060+500 to 2065
COT Water	FC23-B3/A15-1-04: 6" ECJ	Roadway milling and resurfacing	US 41 eastern ROW from sta. 2060+500 to 2065
COT Water	FC23-B3/A15-1-04: 6" ECJ	Roadway change to at-grade	US 41 eastern ROW from sta. 2060+500 to 2065
COT Water	FC23-B3/A15-1-04: 6" ECJ	ROW change	US 41 eastern ROW from sta. 2060+500 to 2065
COT Water	E14-4-17: 12" DIP	Roadway change to at-grade	US 41 and S 24th Ave. intersection; east sie of US 41
COT Water	E14-4-17: 12" DIP	Roadway milling and resurfacing	US 41 and S 24th Ave. intersection; east sie of US 41
COT Water	E14-4-17: 12" DIP	Sidwalk installation	US 41 and S 24th Ave. intersection; east sie of US 41
COT Water	FC42-41: 6" ECJ	ROW change	US 41 and S 23rd St intersection; west side of US 41
COT Water	FC42-41: 6" ECJ	Roadway change to at-grade	US 41 and S 23rd St intersection; west side of US 41
COT Water	FC42-41: 6" ECJ	Roadway milling and resurfacing	US 41 and S 23rd St intersection; west side of US 41
COT Water	FC42-41: 6" ECJ	Sidwalk installation	US 41 and S 23rd St intersection; west side of US 41
COT Water	FC22-35: 8" CAS	Sidwalk installation	Southern SR 676 ROW from the western project terminus to sta. 3019+20
COT Water	FC22-35: 8" CAS	ROW change	Southern SR 676 ROW from the western project terminus to sta. 3019+20
COT Water	FC22-35: 8" CAS	Roadway change to at-grade	Southern SR 676 ROW from the western project terminus to sta. 3019+20
COT Water	J0346: 12" PVC	Roadway change to at-grade	SR 676 southern ROW at sta. 3004
COT Water	J0346: 12" PVC	Sidwalk installation	SR 676 southern ROW at sta. 3004
COT Water	FC22-34: 8" ECJ	Roadway change to at-grade	SR 676 southern ROW from sta. 3019+20 to 3029
COT Water	FC22-34: 8" ECJ	Sidwalk installation	SR 676 southern ROW from sta. 3019+20 to 3029
COT Water	FC22-34: 8" ECJ	ROW change	SR 676 southern ROW from sta. 3019+20 to 3029
COT Water	C3-3-10: abandoned 8" DIP	Roadway change to at-grade	SR 676 southern ROW from sta. 3029 to 3039+80
COT Water	C3-3-10: abandoned 8" DIP	Sidwalk installation	SR 676 southern ROW from sta. 3029 to 3039+80
COT Water	C3-3-10: abandoned 8" DIP	ROW change	SR 676 southern ROW from sta. 3029 to 3039+80
COT Water	FC84-212-02/03/04/05/06: 12" DIP	Sidwalk installation	SR 676 east-bound lane from sta. 3039+80 to the eastern project terminus; Unnamed extensions cross SR 676 at sta. 3041+40, 3043+20, and 3044+10, and 3054+50; sta.

COT Water	FC84-212-02/03/04/05/06: 12" DIP	Roadway change to at-grade	SR 676 east-bound lane from sta. 3039+80 to the eastern project terminus; Unnamed extensions cross SR 676 at sta. 3041+40, 3043+20, and 3044+10, and 3054+50; sta.
COT Water	FC48-32: 6" ECJ	Roadway change to at-grade	SR 676 and Sagata St. intersection; south side of road
COT Water	FC48-32: 6" ECJ	Sidwalk installation	SR 676 and Sagata St. intersection; south side of road
COT Water	FC48-32: 6" ECJ	ROW change	SR 676 and Sagata St. intersection; south side of road
COT Water	FC55-01: 8" DIP	Roadway change to at-grade	SR 676 crossing at sta. 3057+60
COT Water	FC55-01: 8" DIP	Sidwalk installation	SR 676 crossing at sta. 3057+60
COT Water	FC55-01: 8" DIP	ROW change	SR 676 crossing at sta. 3057+60
TECO Gas	6" CS GM	Sidwalk installation	US 41 eastern ROW from southern project terminus to sta. 1007
TECO Gas	6" CS GM	Roadway change to at-grade	US 41 eastern ROW from southern project terminus to sta. 1007
TECO Gas	6" CS GM	ROW change	US 41 eastern ROW from southern project terminus to sta. 1007
TECO Gas	4" CS GM/retired OSS	Sidwalk installation	Crosess US 41 at Trenton St., continues north along the western ROW, and terminates
TECO Gas	4" CS GM/retired OSS	Roadway change to at-grade	Crosess US 41 at Trenton St., continues north along the western ROW, and terminates
TECO Gas	4" CS GM/retired OSS	ROW change	Crosess US 41 at Trenton St., continues north along the western ROW, and terminates
TECO Gas	4" CS GM/retired OSS	Bridge construction	Crosess US 41 at Trenton St., continues north along the western ROW, and terminates
TECO Gas	4" CS GM/retired OSS	Roadway change to on MSE	Crosess US 41 at Trenton St., continues north along the western ROW, and terminates
TECO Gas	2" CS GM/retired OSS	Roadway change to at-grade	Extension west from the US 41 western ROW at the north side of Towaway Ave.
TECO Gas	2" CS GM/retired OSS	Sidwalk installation	Extension west from the US 41 western ROW at the north side of Towaway Ave.
TECO Gas	2" CS GM	Roadway change to at-grade	Extension west from the US 41 western ROW at the north side of Towaway Ave.
TECO Gas	2" CS GM	Sidwalk installation	Extension west from the US 41 western ROW at the north side of Towaway Ave.
TECO Gas	2" CS GM	ROW change	Extension west from the US 41 western ROW at the north side of Towaway Ave.
Tampa Bay Pipeline	AA 6" CS	Bridge construction	Crosses US 41 along the north side of St. Paul St.
Tampa Bay Pipeline	AA 6" CS	ROW change	Crosses US 41 along the north side of St. Paul St.
Tampa Bay Pipeline	AA 6" CS	Sidwalk installation	Crosses US 41 along the north side of St. Paul St.
Tampa Bay Pipeline	AA 6" CS	Roadway change to at-grade	Crosses US 41 along the north side of St. Paul St.
Tampa Bay Pipeline	AA 6" CS	Roaday milling and resurfacing	Crosses US 41 along the north side of St. Paul St.
Tampa Bay Pipeline	AA 6" CS	ROW change	Along southern ROW of SR 676, extending west past the project limits and turn south at
Tampa Bay Pipeline	AA 6" CS	Sidwalk installation	Along southern ROW of SR 676, extending west past the project limits and turn south at
Tampa Bay Pipeline	AA 6" CS	Roadway change to at-grade	Along southern ROW of SR 676, extending west past the project limits and turn south at
COT Wastewater	10" DVC processized main	DOW shangs	Crosses SR 676 at Sagasta St. and continues east along the northern ROW, ending
COT Wastewater	10" PVC pressurized main	ROW change	outside the project's eastern terminus
COT Wastowater	10" DVC proceurized main	Sidwalk installation	Crosses SR 676 at Sagasta St. and continues east along the northern ROW, ending
COT Wastewater	10" PVC pressurized main	Siuwaik installation	outside the project's eastern terminus
COT Wastewater	10" PVC pressurized main	Roadway change to at-grade	Crosses SR 676 at Sagasta St. and continues east along the northern ROW, ending
COT wastewater	10 FVC pressurized main	Noduway change to at-grade	outside the project's eastern terminus

COT Wastewater	8" PVC gravity main	Bridge construction	Crosses US 41 at the CSX intersection; runs along the north side of the tracks
COT Wastewater	8" PVC gravity main	ROW change	Crosses US 41 at the CSX intersection; runs along the north side of the tracks
COT Wastewater	8" PVC gravity main	Sidwalk installation	Crosses US 41 at the CSX intersection; runs along the north side of the tracks
COT Wastewater	8" PVC gravity main	Roadway change to at-grade	Crosses US 41 at the CSX intersection; runs along the north side of the tracks
COT Wastewater	8" PVC gravity main	Roaday milling and resurfacing	Crosses US 41 at the CSX intersection; runs along the north side of the tracks
Zayo	(3) 1-1/4" HDPE ducts E/W 144ct FOC	ROW change	Along the northern SR 676 ROW from the eastern project terminus to US 41, and the eastern US 41 ROW from SR 676 through the northern project terminus
Zayo	(3) 1-1/4" HDPE ducts E/W 144ct FOC	Sidwalk installation	Along the northern SR 676 ROW from the eastern project terminus to US 41, and the eastern US 41 ROW from SR 676 through the northern project terminus
Zayo	(3) 1-1/4" HDPE ducts E/W 144ct FOC	Roadway change to at-grade	Along the northern SR 676 ROW from the eastern project terminus to US 41, and the eastern US 41 ROW from SR 676 through the northern project terminus
Zayo	(3) 1-1/4" HDPE ducts E/W 144ct FOC	Roaday milling and resurfacing	Along the northern SR 676 ROW from the eastern project terminus to US 41, and the eastern US 41 ROW from SR 676 through the northern project terminus
Frontier	3 buried cables (600,200,100)	ROW change	US 41 eastern ROW from the southern project terminus to Trenton St.
Frontier	3 buried cables (600,200,100)	Sidwalk installation	US 41 eastern ROW from the southern project terminus to Trenton St.
Frontier	3 buried cables (600,200,100)	Roadway change to at-grade	US 41 eastern ROW from the southern project terminus to Trenton St.
Frontier	3 buried cables (600,600,600)	ROW change	US 41 eastern ROW from sta. 1018 to 1022+80
Frontier	3 buried cables (600,600,600)	Sidwalk installation	US 41 eastern ROW from sta. 1018 to 1022+80
Frontier	3 buried cables (600,600,600)	Roadway change to on MSE	US 41 eastern ROW from sta. 1018 to 1022+80
Frontier	3 buried cables (600,600,600)	Bridge construction	US 41 eastern ROW from sta. 1018 to 1022+80
Frontier	3 buried cables (600,600,FOC)	Bridge construction	US 41 eastern ROW from sta. 1032+20 to 1039+50
Frontier	3 buried cables (600,600,FOC)	Sidwalk installation	US 41 eastern ROW from sta. 1032+20 to 1039+50
Frontier	3 buried cables (600,600,FOC)	Roadway change to on MSE	US 41 eastern ROW from sta. 1032+20 to 1039+50
Frontier	3 buried cables (600,600,FOC)	New roadway to properties	US 41 eastern ROW from sta. 1032+20 to 1039+50
Frontier	3 buried cables (600,600,FOC)	ROW change	US 41 eastern ROW from sta. 1032+20 to 1039+50
Frontier	3 buried cables (600,600,FOC)	ROW change	Extention west from the US 41 western ROW at S 31st Ave
Frontier	3 buried cables (600,600,FOC)	Roaday milling and resurfacing	Extention west from the US 41 western ROW at S 31st Ave
Frontier	3 buried cables (600,600,FOC)	Sidwalk installation	Extention west from the US 41 western ROW at S 31st Ave
Frontier	5 buried cables (600,600,600,200,100)	Sidwalk installation	US 41 eastern ROW from sta. 1010+70 to 1018
Frontier	5 buried cables (600,600,600,200,100)	Roadway change to at-grade	US 41 eastern ROW from sta. 1010+70 to 1018
Frontier	5 buried cables (100,200,600,600,FOC)	New roadway to properties	Eastern US 41 ROW from sta. 1022+80 to 1032+20

Frontier	5 buried cables (100,200,600,600,FOC)	Bridge construction	Eastern US 41 ROW from sta. 1022+80 to 1032+20
Frontier	5 buried cables (100,200,600,600,FOC)	ROW change	Eastern US 41 ROW from sta. 1022+80 to 1032+20
Frontier	5 buried cables (100,200,600,600,FOC)	Roadway change to on MSE	Eastern US 41 ROW from sta. 1022+80 to 1032+20
Frontier	5 buried cables (100,200,600,600,FOC)	Sidwalk installation	Eastern US 41 ROW from sta. 1022+80 to 1032+20
Frontier	1 buried cable (unknow size or type)	Sidwalk installation	Crosses SR 676 at sta. 3009+90
Frontier	1 buried cable (unknow size or type)	Roadway change to at-grade	Crosses SR 676 at sta. 3009+90
Frontier	1 buried cable (unknow size or type)	ROW change	Crosses SR 676 at sta. 3009+90
Frontier	10" steel casing with copper and fiber cables	ROW change	Crosses US 41 at sta. 1039+50 (S 31st Ave.)
Frontier	10" steel casing with copper and fiber cables	Roadway change to on MSE	Crosses US 41 at sta. 1039+50 (S 31st Ave.)
Frontier	10" steel casing with copper and fiber cables	Sidwalk installation	Crosses US 41 at sta. 1039+50 (S 31st Ave.)
Frontier	10" steel casing with copper and fiber cables	Roaday milling and resurfacing	Crosses US 41 at sta. 1039+50 (S 31st Ave.)
Frontier	3-4" conduits	Roadway change to on MSE	US 41 eastern ROW from sta. 1043+60 (S 30th Ave) to 1046+60 (SR 676)
Frontier	3-4" conduits	Roadway change to at-grade	US 41 eastern ROW from sta. 1043+60 (S 30th Ave) to 1046+60 (SR 676)
Frontier	3-4" conduits	Sidwalk installation	US 41 eastern ROW from sta. 1043+60 (S 30th Ave) to 1046+60 (SR 676)
Frontier	3-4" conduits	Roadway change to at-grade	Western US 41 ROW from sta. 1050+50 (El Camino Blanco Blvd.) to 1067+40 (project
Frontier	3-4" conduits	Sidwalk installation	Western US 41 ROW from sta. 1050+50 (El Camino Blanco Blvd.) to 1067+40 (project
Frontier	3-4" conduits	ROW change	Western US 41 ROW from sta. 1050+50 (El Camino Blanco Blvd.) to 1067+40 (project
Frontier	3-4" conduits	Roaday milling and resurfacing	Western US 41 ROW from sta. 1050+50 (El Camino Blanco Blvd.) to 1067+40 (project
Frontier	3-4" conduits	Roadway change to at-grade	US 41 eastern ROW from sta. 1050+50 (El Camino Blanco Blvd.) to 1060 +20 (S 24th
Frontier	3-4" conduits	Sidwalk installation	US 41 eastern ROW from sta. 1050+50 (El Camino Blanco Blvd.) to 1060 +20 (S 24th
Frontier	3-4" conduits	ROW change	US 41 eastern ROW from sta. 1050+50 (El Camino Blanco Blvd.) to 1060 +20 (S 24th
Frontier	3-4" conduits	Roaday milling and resurfacing	US 41 eastern ROW from sta. 1050+50 (El Camino Blanco Blvd.) to 1060 +20 (S 24th
Frontier	3-4" conduits	Roadway change to at-grade	Cross US 41 at sta. 1046+60 (SR 676 intersection, south side)
Frontier	3-4" conduits	Sidwalk installation	Cross US 41 at sta. 1046+60 (SR 676 intersection, south side)

Frontier	3-4" conduits	Roadway change to at-grade	Southern SR 676 ROW from sta. 3034+20 (S 47th St.) to 3040+60 (Sagata St.)
Frontier	3-4" conduits	Sidwalk installation	Southern SR 676 ROW from sta. 3034+20 (S 47th St.) to 3040+60 (Sagata St.)
Frontier	3-4" conduits	ROW change	Southern SR 676 ROW from sta. 3034+20 (S 47th St.) to 3040+60 (Sagata St.)
Frontier	6-4" conduits	Sidwalk installation	Eastern US 41 ROW from sta. 1046+60 (SR 676 intersection, south side) to 1050+50 (
Frontier	6-4" conduits	Roadway change to at-grade	Eastern US 41 ROW from sta. 1046+60 (SR 676 intersection, south side) to 1050+50 (
Frontier	6-4" conduits	ROW change	SR 676 southern ROW from sta. 3047+50 (US 41, east side) to 3057+50 (project easter
Frontier	6-4" conduits	Sidwalk installation	SR 676 southern ROW from sta. 3047+50 (US 41, east side) to 3057+50 (project easter
Frontier	6-4" conduits	Roadway change to at-grade	SR 676 southern ROW from sta. 3047+50 (US 41, east side) to 3057+50 (project easter
Frontier	6-4" conduits	Roaday milling and resurfacing	SR 676 southern ROW from sta. 3047+50 (US 41, east side) to 3057+50 (project easter
Frontier	6-4" conduits	ROW change	Crosses SR 676 at sta. 3057+50 (project eastern terminus)
Frontier	6-4" conduits	Sidwalk installation	Crosses SR 676 at sta. 3057+50 (project eastern terminus)
Frontier	6-4" conduits	Roadway change to at-grade	Crosses SR 676 at sta. 3057+50 (project eastern terminus)
Frontier	2-4" conduits	ROW change	Northern SR 676 ROW from sta. 3049+20 to 3051+80
Frontier	2-4" conduits	Sidwalk installation	Northern SR 676 ROW from sta. 3049+20 to 3051+80
Frontier	2-4" conduits	Roadway change to at-grade	Northern SR 676 ROW from sta. 3049+20 to 3051+80
Frontier	2-4" conduits	ROW change	Extension west from the western US 41 ROW at sta. 1050+50 (El Camino Blanco Blv
Frontier	2-4" conduits	Sidwalk installation	Extension west from the western US 41 ROW at sta. 1050+50 (El Camino Blanco Blvd
Frontier	2-4" conduits	Roadway change to at-grade	Extension west from the western US 41 ROW at sta. 1050+50 (El Camino Blanco Blvo
Frontier	4-4" conduits	ROW change	Southern SR 676 ROW from the western project terminus to sta. 3034+20 (S 47th S
Frontier	4-4" conduits	Sidwalk installation	Southern SR 676 ROW from the western project terminus to sta. 3034+20 (S 47th S
Frontier	4-4" conduits	Roadway change to at-grade	Southern SR 676 ROW from the western project terminus to sta. 3034+20 (S 47th S
Frontier	4-4" conduits	ROW change	Crosses SR 676 at sta. 3050+30
Frontier	4-4" conduits	Sidwalk installation	Crosses SR 676 at sta. 3050+30
Frontier	4-4" conduits	Roadway change to at-grade	Crosses SR 676 at sta. 3050+30
Frontier	Buried FOC	ROW change	Crosses SR 676 at sta. 3017+60
Frontier	Buried FOC	Sidwalk installation	Crosses SR 676 at sta. 3017+60
Frontier	Buried FOC	Roadway change to at-grade	Crosses SR 676 at sta. 3017+60
Frontier	Buried FOC	ROW change	Extension east from the eastern US 41 ROW at sta. 1051+50 (S 27th Ave.)
Frontier	Buried FOC	Sidwalk installation	Extension east from the eastern US 41 ROW at sta. 1051+50 (S 27th Ave.)
Frontier	Buried FOC	Roadway change to at-grade	Extension east from the eastern US 41 ROW at sta. 1051+50 (S 27th Ave.)
Frontier	24" steel casing with 16-4" conduits	ROW change	Crosses SR 676 at sta. 3034+20 (S 47th St.)
Frontier	24" steel casing with 16-4" conduits	Sidwalk installation	Crosses SR 676 at sta. 3034+20 (S 47th St.)

Frontier	24" steel casing with 16-4" conduits	Roadway change to at-grade	Crosses SR 676 at sta. 3034+20 (S 47th St.)
Frontier	8-4" conduits	ROW change	Extension west from the US 41 western ROW at sta. 1050+50 (El Camino Blanco Blvd.)
Frontier	8-4" conduits	Sidwalk installation	Extension west from the US 41 western ROW at sta. 1050+50 (El Camino Blanco Blvd.)
Frontier	8-4" conduits	Roadway change to at-grade	Extension west from the US 41 western ROW at sta. 1050+50 (El Camino Blanco Blvd.)
illsborough County Traff	4" traffic system conduits	ROW change	SR 676 northern ROW from sta. 3046 (US 41, west side) through the eastern project
illsborough County Traff	4" traffic system conduits	Sidwalk installation	SR 676 northern ROW from sta. 3046 (US 41, west side) through the eastern project
illsborough County Traff	4" traffic system conduits	Roadway change to at-grade	SR 676 northern ROW from sta. 3046 (US 41, west side) through the eastern project
illsborough County Traff	2" traffic system conduits	ROW change	US 41 western ROW from sta. 1049 (SR 676, north side) through the northern project
illsborough County Traff	2" traffic system conduits	Sidwalk installation	US 41 western ROW from sta. 1049 (SR 676, north side) through the northern project
illsborough County Traff	2" traffic system conduits	Roadway change to at-grade	US 41 western ROW from sta. 1049 (SR 676, north side) through the northern project
illsborough County Traff	2" traffic system conduits	Roaday milling and resurfacing	US 41 western ROW from sta. 1049 (SR 676, north side) through the northern project
se Networks dba Charte	Buried FOC	ROW change	Crosses US 41 at sta. 1007+50 (near Hartford St.).
se Networks dba Charte	Buried FOC	Sidwalk installation	Crosses US 41 at sta. 1007+50 (near Hartford St.).
se Networks dba Charte	Buried FOC	Roadway change to at-grade	Crosses US 41 at sta. 1007+50 (near Hartford St.).
se Networks dba Charte	Buried FOC	ROW change	Crosses US 41 at sta. 1051+30 (S 27th Ave)
se Networks dba Charte	Buried FOC	Sidwalk installation	Crosses US 41 at sta. 1051+30 (S 27th Ave)
se Networks dba Charte	Buried FOC	Roadway change to at-grade	Crosses US 41 at sta. 1051+30 (S 27th Ave)
se Networks dba Charte	Buried CATV	ROW change	Crosses US 41 at sta. 1017+15 (near Delaney Creek)
se Networks dba Charte	Buried CATV	Sidwalk installation	Crosses US 41 at sta. 1017+15 (near Delaney Creek)
se Networks dba Charte	Buried CATV	Roadway change to at-grade	Crosses US 41 at sta. 1017+15 (near Delaney Creek)
se Networks dba Charte	Buried CATV	Roadway change to on MSE	Crosses US 41 at sta. 1035+80 (between St. Paul St. and S 31st Ave.).
se Networks dba Charte	Buried CATV	Roaday milling and resurfacing	Crosses US 41 at sta. 1035+80 (between St. Paul St. and S 31st Ave.).
se Networks dba Charte	Buried CATV	Sidwalk installation	Crosses US 41 at sta. 1035+80 (between St. Paul St. and S 31st Ave.).
se Networks dba Charte	Buried CATV	ROW change	Crosses US 41 at sta. 1035+80 (between St. Paul St. and S 31st Ave.).
se Networks dba Charte	Buried CATV	Roadway change to at-grade	Crosses US 41 at sta. 1035+80 (between St. Paul St. and S 31st Ave.).
se Networks dba Charte	Buried CATV	New roadway to properties	Crosses US 41 at sta. 1035+80 (between St. Paul St. and S 31st Ave.).
se Networks dba Charte	Buried CATV	ROW change	Crosses SR 676 at sta. 3027 (S 45th St.)
se Networks dba Charte	Buried CATV	Sidwalk installation	Crosses SR 676 at sta. 3027 (S 45th St.)
se Networks dba Charte	Buried CATV	Roadway change to at-grade	Crosses SR 676 at sta. 3027 (S 45th St.)
se Networks dba Charte	Buried CATV	ROW change	SR 676 northern ROW from sta. 3027 (S 45th St.) to 3039 (near Sagata St.)
se Networks dba Charte	Buried CATV	Sidwalk installation	SR 676 northern ROW from sta. 3027 (S 45th St.) to 3039 (near Sagata St.)
se Networks dba Charte	Buried CATV	Roadway change to at-grade	SR 676 northern ROW from sta. 3027 (S 45th St.) to 3039 (near Sagata St.)
Frontier	(1) Aerial cable	Sidwalk installation	Extention east from the US 41 eastern ROW at sta. 1010+70 (Trenton St.)
Frontier	(1) Aerial cable	ROW change	Extention east from the US 41 eastern ROW at sta. 1010+70 (Trenton St.)

Frontier	(1) Aerial cable	Roadway change to at-grade	Extention east from the US 41 eastern ROW at sta. 1010+70 (Trenton St.)
Frontier	(1) Aerial cable	Sidwalk installation	Extention east from the US 41 eastern ROW at sta. 1060+70 (S 24th Ave.)
Frontier	(1) Aerial cable	Roaday milling and resurfacing	Extention east from the US 41 eastern ROW at sta. 1060+70 (S 24th Ave.)
Frontier	(1) Aerial cable	Sidwalk installation	Extention east from the US 41 eastern ROW at sta. 11064+70 (S 23rd Ave.)
Frontier	(1) Aerial cable	Roaday milling and resurfacing	Extention east from the US 41 eastern ROW at sta. 11064+70 (S 23rd Ave.)
Frontier	(1) Aerial cable	Sidwalk installation	Extention west from the US 41 western ROW at sta. 1018+60 (Raleigh St.)
Frontier	(1) Aerial cable	ROW change	Extention west from the US 41 western ROW at sta. 1018+60 (Raleigh St.)
Frontier	(1) Aerial cable	Roadway change to at-grade	Extention west from the US 41 western ROW at sta. 1018+60 (Raleigh St.)
Frontier	(1) Aerial cable	Bridge construction	Extention west from the US 41 western ROW at sta. 1018+60 (Raleigh St.)
Frontier	(1) Aerial cable	Sidwalk installation	Crosses US 41 at sta. 1022+80 (Towaway Ave.)
Frontier	(1) Aerial cable	ROW change	Crosses US 41 at sta. 1022+80 (Towaway Ave.)
Frontier	(1) Aerial cable	Roadway change to at-grade	Crosses US 41 at sta. 1022+80 (Towaway Ave.)
Frontier	(1) Aerial cable	Bridge construction	Crosses US 41 at sta. 1022+80 (Towaway Ave.)
Frontier	(1) Aerial cable	Roadway change to on MSE	Crosses US 41 at sta. 1022+80 (Towaway Ave.)
Frontier	(1) Aerial cable	Sidwalk installation	Crosses US 41 at sta. 2053+70 (N of S 27th Ave)
Frontier	(1) Aerial cable	ROW change	Crosses US 41 at sta. 2053+70 (N of S 27th Ave)
Frontier	(1) Aerial cable	Roadway change to at-grade	Crosses US 41 at sta. 2053+70 (N of S 27th Ave)
Frontier	(1) Aerial cable	Sidwalk installation	Crosses US 41 at sta. 1064+70 (S 23rd Ave.)
Frontier	(1) Aerial cable	ROW change	Crosses US 41 at sta. 1064+70 (S 23rd Ave.)
Frontier	(1) Aerial cable	Roadway change to at-grade	Crosses US 41 at sta. 1064+70 (S 23rd Ave.)
Frontier	(1) Aerial cable	Roaday milling and resurfacing	Crosses US 41 at sta. 1064+70 (S 23rd Ave.)
Frontier	(1) Aerial cable	Sidwalk installation	US 41 western ROW from sta. 1050+50 (El Camino Blanco Blvd.) to 1053+70
Frontier	(1) Aerial cable	ROW change	US 41 western ROW from sta. 1050+50 (El Camino Blanco Blvd.) to 1053+70
Frontier	(1) Aerial cable	Roadway change to at-grade	US 41 western ROW from sta. 1050+50 (El Camino Blanco Blvd.) to 1053+70
Frontier	(1) Aerial cable	Sidwalk installation	US 41 western ROW from sta. 1060+70 (S 24th Ave.) to 1064+70 (S 23rd Ave.)
Frontier	(1) Aerial cable	ROW change	US 41 western ROW from sta. 1060+70 (S 24th Ave.) to 1064+70 (S 23rd Ave.)
Frontier	(1) Aerial cable	Roadway change to at-grade	US 41 western ROW from sta. 1060+70 (S 24th Ave.) to 1064+70 (S 23rd Ave.)
Frontier	(1) Aerial cable	Roaday milling and resurfacing	Crosses S 24th Ave. at the US 41 intersection (east side of US 41).
Frontier	(1) Aerial cable	Sidwalk installation	Crosses S 24th Ave. at the US 41 intersection (east side of US 41).
Frontier	(1) Aerial cable	Roadway change to at-grade	Crosses SR 676 at sta.3027+30 (S 45th St.)
Frontier	(1) Aerial cable	Sidwalk installation	Crosses SR 676 at sta.3027+30 (S 45th St.)
Frontier	(1) Aerial cable	ROW change	Crosses SR 676 at sta.3027+30 (S 45th St.)
Frontier	(1) Aerial cable	Roadway change to at-grade	Crosses SR 676 at sta.3034+20 (S 47th St.)
Frontier	(1) Aerial cable	Sidwalk installation	Crosses SR 676 at sta.3034+20 (S 47th St.)
Frontier	(1) Aerial cable	ROW change	Crosses SR 676 at sta.3034+20 (S 47th St.)

Frontier	(1) Aerial cable	Roadway change to at-grade	Crosses SR 676 at sta.3037
Frontier	(1) Aerial cable	Sidwalk installation	Crosses SR 676 at sta.3037
Frontier	(1) Aerial cable	ROW change	Crosses SR 676 at sta.3037
Frontier	(1) Aerial cable	Roadway change to at-grade	SR 676 southern ROW from sta. 3022+60 to 3042+90
Frontier	(1) Aerial cable	Sidwalk installation	SR 676 southern ROW from sta. 3022+60 to 3042+90
Frontier	(1) Aerial cable	ROW change	SR 676 southern ROW from sta. 3022+60 to 3042+90
Frontier	(3) Aerial cables	Roadway change to at-grade	Crosses US 41 at sta. 1053+70
Frontier	(3) Aerial cables	Sidwalk installation	Crosses US 41 at sta. 1033+70 Crosses US 41 at sta. 1053+70
	(3) Aerial cables		Crosses US 41 at sta. 1053+70 Crosses US 41 at sta. 1053+70
Frontier		ROW change	
Frontier	(4) Aerial cables	Roadway change to at-grade	Eastern US 41 ROW from sta. 1053+70 to 1060+70 (S 24th Ave.).
Frontier	(4) Aerial cables	Sidwalk installation	Eastern US 41 ROW from sta. 1053+70 to 1060+70 (S 24th Ave.).
Frontier	(4) Aerial cables	ROW change	Eastern US 41 ROW from sta. 1053+70 to 1060+70 (S 24th Ave.).
Frontier	(4) Aerial cables	Roaday milling and resurfacing	Eastern US 41 ROW from sta. 1053+70 to 1060+70 (S 24th Ave.).
Frontier	(4) Aerial cables	Roadway change to at-grade	US 41 eastern ROW from sta. 1060+70 (S 24th Ave.) to the northern project terminus
Frontier	(4) Aerial cables	Roaday milling and resurfacing	US 41 eastern ROW from sta. 1060+70 (S 24th Ave.) to the northern project terminus
Frontier	(4) Aerial cables	ROW change	US 41 eastern ROW from sta. 1060+70 (S 24th Ave.) to the northern project terminus
Frontier	Overhead guy wires	Roadway change to at-grade	Western US 41 ROW from sta. 1017+40 (Raleigh St.) to 1022+80 (Towaway Ave.)
Frontier	Overhead guy wires	Sidwalk installation	Western US 41 ROW from sta. 1017+40 (Raleigh St.) to 1022+80 (Towaway Ave.)
Frontier	Overhead guy wires	Sidwalk installation	SR 676 southern ROW at 3040+40 (Sagata St.)
Frontier	Overhead guy wires	ROW change	SR 676 southern ROW at 3040+40 (Sagata St.)
Frontier	Overhead guy wires	Roadway change to at-grade	SR 676 southern ROW at 3040+40 (Sagata St.)
illsborough County Traff	Buried fiber bundle cables	Roadway change to at-grade	SR 676 northern ROW from the US 41 intersection (east side) through the eastern
illsborough County Traff	Buried fiber bundle cables	Sidwalk installation	SR 676 northern ROW from the US 41 intersection (east side) through the eastern
illsborough County Traff	Buried fiber bundle cables	ROW change	SR 676 northern ROW from the US 41 intersection (east side) through the eastern
illsborough County Traff	Buried copper cables	Roadway change to at-grade	Crosse US 41 at the SR 676 intersection (north side)
illsborough County Traff	Buried copper cables	Sidwalk installation	Crosse US 41 at the SR 676 intersection (north side)
se Networks dba Charte	Aerial CATV and FOC	Sidwalk installation	Northern US 41 ROW from the southern project terminus through the northern project
	Aerial CATV and FOC	ROW change	Northern US 41 ROW from the southern project terminus through the northern project
	Aerial CATV and FOC	Roadway change to at-grade	Northern US 41 ROW from the southern project terminus through the northern project
	Aerial CATV and FOC	Bridge construction	Northern US 41 ROW from the southern project terminus through the northern project
	Aerial CATV and FOC	Roadway change to on MSE	Northern US 41 ROW from the southern project terminus through the northern project
	Aerial CATV and FOC	Roaday milling and resurfacing	Northern US 41 ROW from the southern project terminus through the northern project
	Aerial CATV and FOC	Roadway change to at-grade	Crosses US 41 at sta. 1052 (S 27th Ave.)
	Aerial CATV and FOC	Sidwalk installation	Crosses US 41 at sta. 1052 (S 27th Ave.)

Aerial CATV and FOC	Roadway change to at-grade	SR 676 northern ROW from sta. 3046+60 (US 41, west side) to 3049+20
Aerial CATV and FOC	Sidwalk installation	SR 676 northern ROW from sta. 3046+60 (US 41, west side) to 3049+20
Aerial CATV and FOC	ROW change	SR 676 northern ROW from sta. 3046+60 (US 41, west side) to 3049+20